

DCR PHOENIX HOMES

LOT #3-59  
WHITE TAIL RIDGE 3  
MODEL TYPE: SPRINGFIELD

MOUNTING HEIGHT - 96



42" H UPPERS @ 18" ABOVE COUNTER

CROWN MOULDING


LIGHT VALANCE

- KITCHEN
- CABINETS -
- HARDWARE -
- STANDARD WHITE INTERIOR
- METAL DRAWER BOX
- 3 PCS - 5/8" KICK - FIN. BOTH ENDS
- 2 PCS - 90 DEG. CORNER MOULD
- 1 PCS - T-MOULD
- 4 PCS - FLAT MOULDING

~~DUMMY DOORS & FLUSH KICK  
ON BACK & SIDES OF ISLAND~~

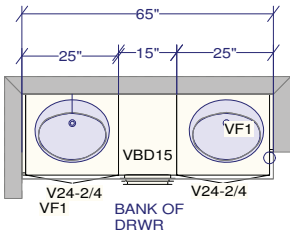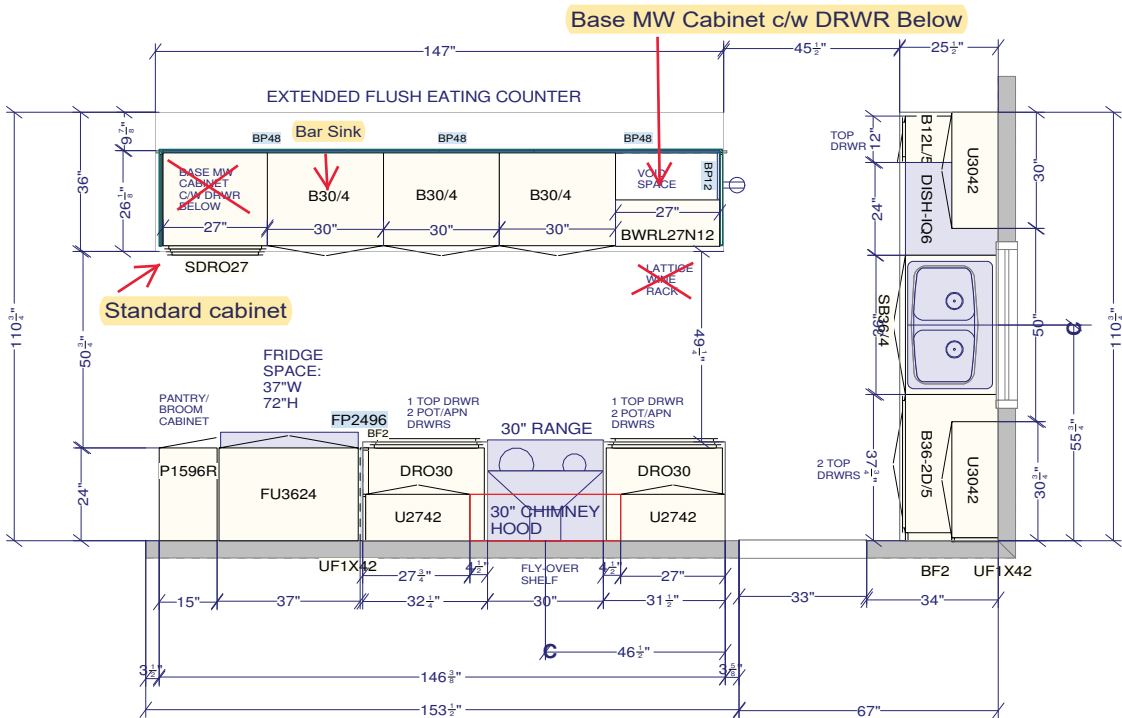

ENSUITE

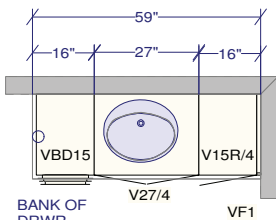

MAIN BATH


All dimensions size designations given are subject to verification on job site and adjustment to fit job conditions.



This is an original design and must not be released or copied unless applicable fee has been paid or job order placed.

Designed: 2022-08-08  
Printed: 2022-08-16

DS  
JY  
DS  
GW

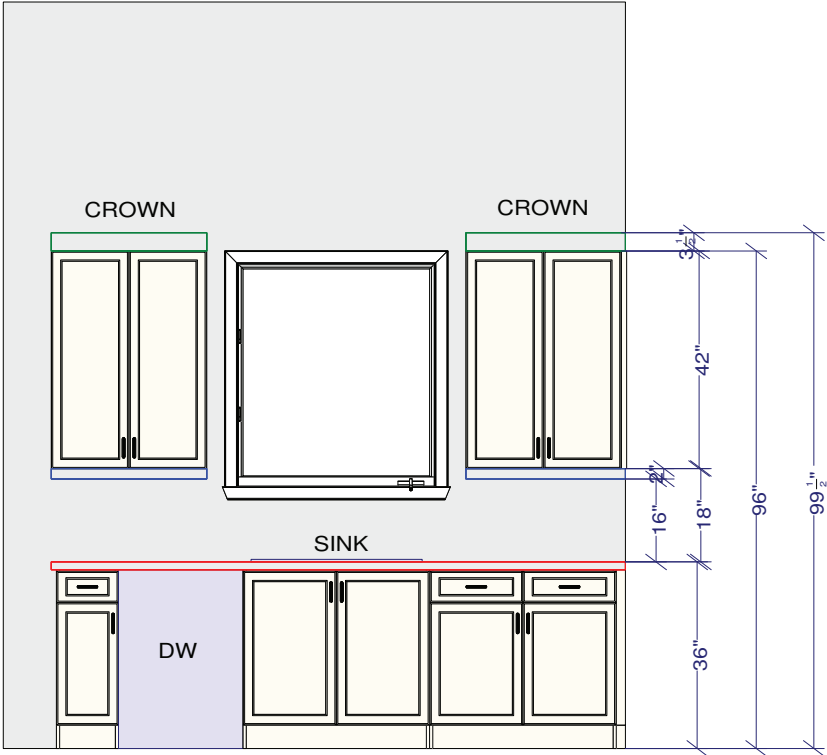




CUSTOMER APPROVAL


I have reviewed these drawings and understand the details of the design and the CARTIER KITCHENS specifications.

Signature \_\_\_\_\_

Date \_\_\_\_\_

SINK WALL ELEVATION

All dimensions ,size designations given are subject to verification on job site and adjustment to fit job conditions.		This is an original design and must not be released or copied unless applicable fee has been paid or job order placed.	Designed: 2022-08-08 Printed: 2022-08-16		
					
DCR #3-59 White Tail Ridge 3 - Springfield .kit			EI 2	Drawing #: 1	No Scale.

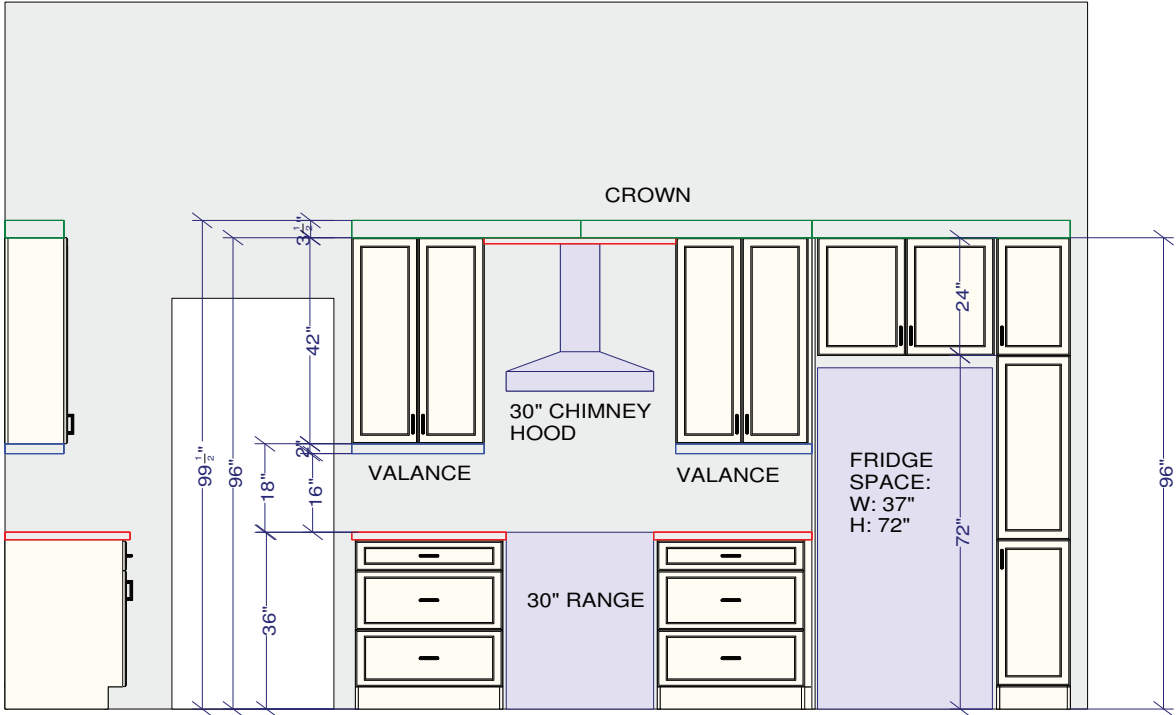




RANGE WALL ELEVATION

**CUSTOMER APPROVAL**


I have reviewed these drawings and understand the details of the design and the CARTIER KITCHENS specifications.

Signature \_\_\_\_\_

Date \_\_\_\_\_

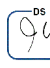All dimensions ,size designations given are subject to verification on job site and adjustment to fit job conditions.		This is an original design and must not be released or copied unless applicable fee has been paid or job order placed.	Designed: 2022-08-08 Printed: 2022-08-16	
				
DCR #3-59 White Tail Ridge 3 - Springfield .kit		EI 1	Drawing #:	No Scale.

standard base cabinet

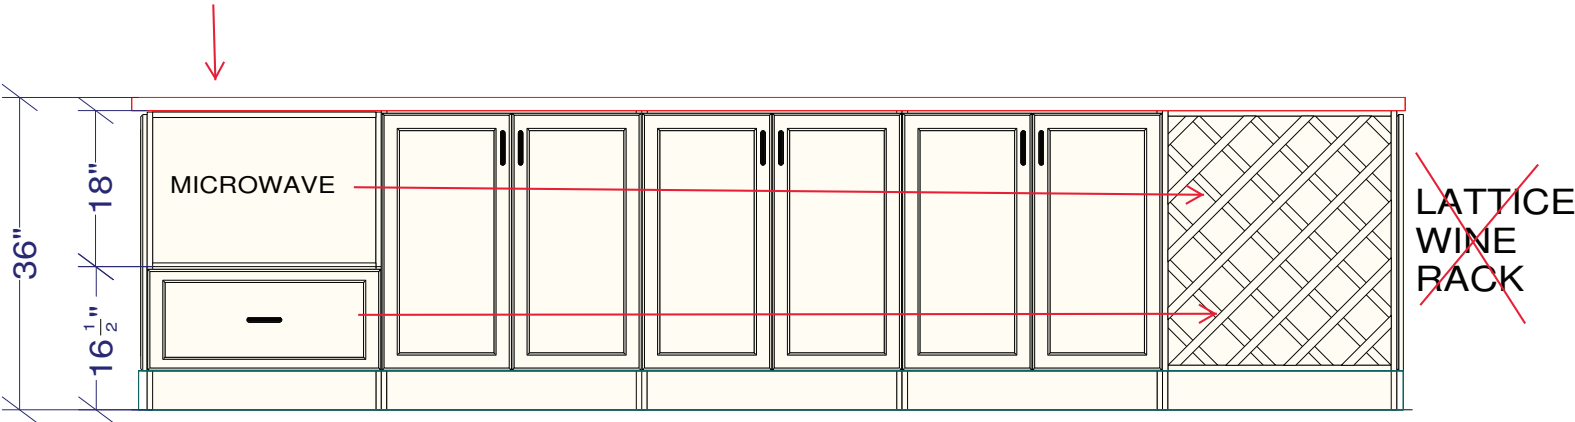

ISLAND ELEVATION

CUSTOMER APPROVAL

I have reviewed these drawings and understand the details of the design and the CARTIER KITCHENS specifications.

Signature \_\_\_\_\_

Date \_\_\_\_\_

All dimensions ,size designations given are subject to verification on job site and adjustment to fit job conditions.



This is an original design and must not be released or copied unless applicable fee has been paid or job order placed.

Designed: 2022-08-08  
Printed: 2022-08-16

DS  
JY


DS  
GW

DCR #3-59 White Tail Ridge 3 - Springfield .kit

EI 3

Drawing #: 1

No Scale.

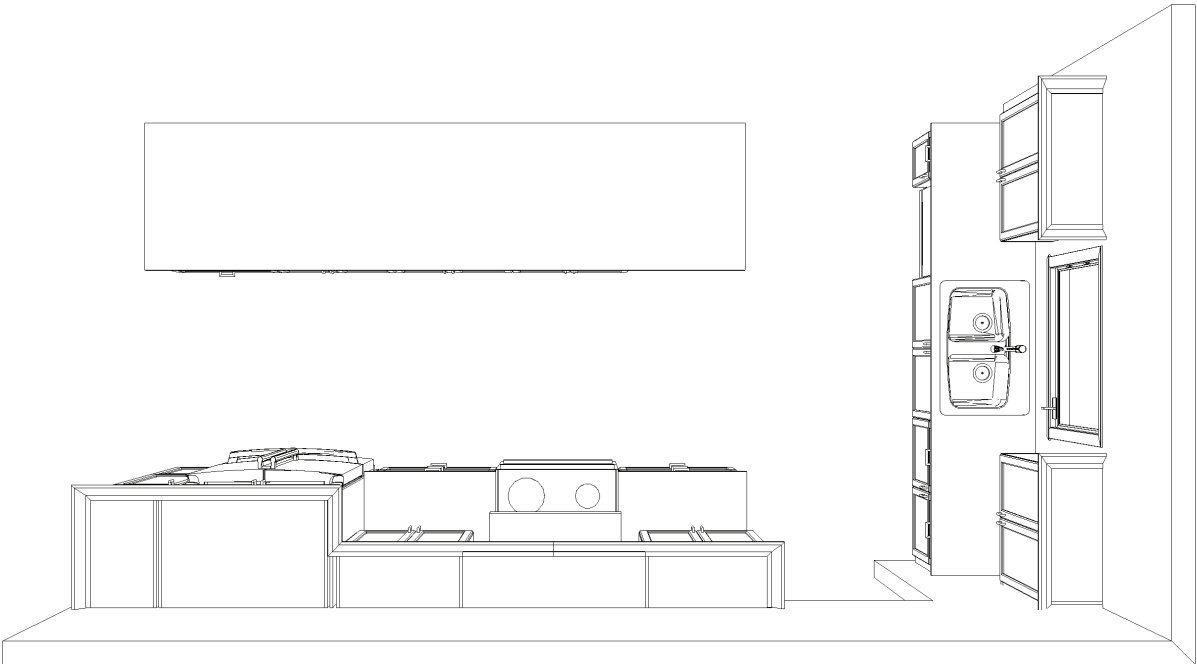

KITCHEN - TOP VIEW

CUSTOMER APPROVAL

I have reviewed these drawings and understand the details of the design and the CARTIER KITCHENS specifications.

Signature \_\_\_\_\_

Date \_\_\_\_\_


Note: This drawing is an artistic interpretation of the general appearance of the design. It is not meant to be an exact rendition.



Designed: 2022-08-08  
Printed: 2022-08-16

DS  
ly

DS  
Gw

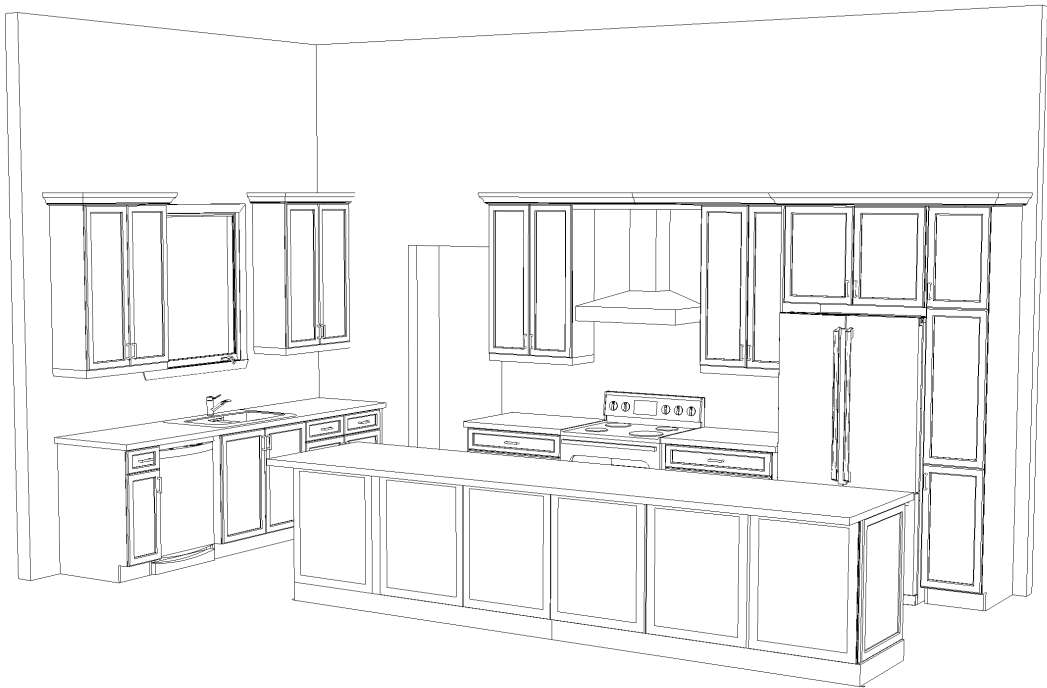

KITCHEN - 3D VIEW #1

**CUSTOMER APPROVAL**

I have reviewed these drawings and understand the details of the design and the CARTIER KITCHENS specifications.

Signature\_\_\_\_\_

Date \_\_\_\_\_

Note: This drawing is an artistic interpretation of the general appearance of the design. It is not meant to be an exact rendition.



Designed: 2022-08-08  
Printed: 2022-08-16

DS  
[Signature]

DS  
[Signature]



KITCHEN - 3D VIEW #2

**CUSTOMER APPROVAL**


I have reviewed these drawings and understand the details of the design and the CARTIER KITCHENS specifications.

Signature \_\_\_\_\_

Date \_\_\_\_\_

Note: This drawing is an artistic interpretation of the general appearance of the design. It is not meant to be an exact rendition.		Designed: 2022-08-08	
		Printed: 2022-08-16	
			
DCR #3-59 White Tail Ridge 3 - Springfield .kit		All	Drawing #: 1

DCR #3-59 White Tail Ridge 3 - Springfield .kit	All	Drawing #: 1
---	-----	--------------

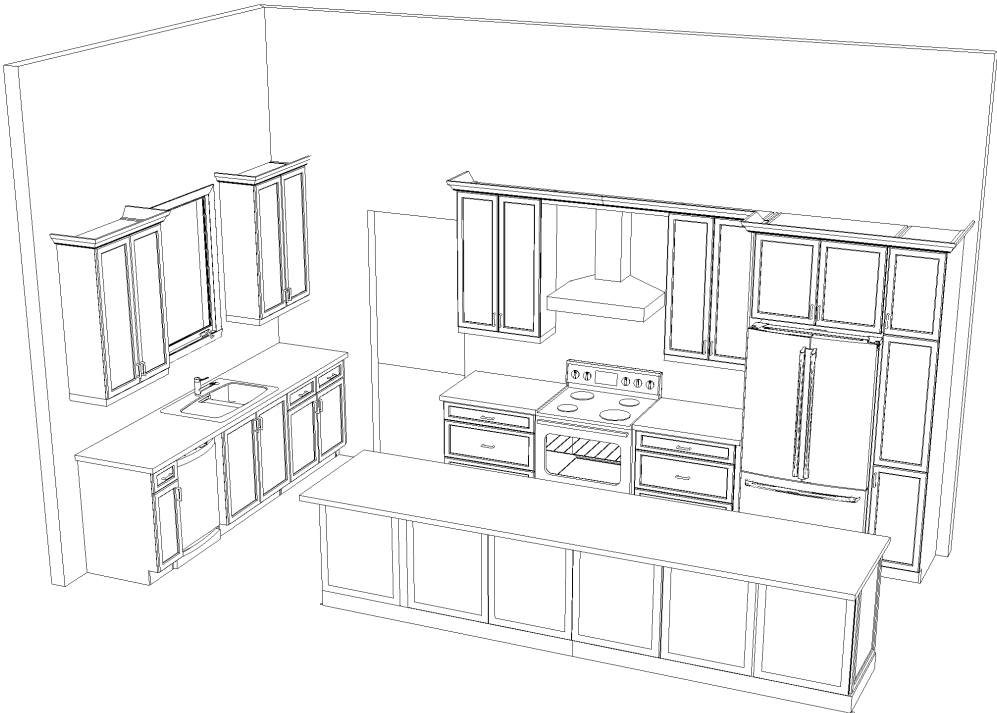

KITCHEN - 3D VIEW #3

CUSTOMER APPROVAL

I have reviewed these drawings and understand the details of the design and the CARTIER KITCHENS specifications.

Signature \_\_\_\_\_

Date \_\_\_\_\_

Note: This drawing is an artistic interpretation of the general appearance of the design. It is not meant to be an exact rendition.



Designed: 2022-08-08  
Printed: 2022-08-16

