

DCR PHOENIX HOMES

LOT #345 PATHWAYS 2
KLONDIKE (Gargae Right)
BASEMENT APARTMENT - 1 BDRM

KITCHEN / VANITIES



MOUNTING HEIGHT - 87

PLUS 2" FILLER TO BULKHEAD

33"H UPPERS INSTALLED
AT 18" ABOVE COUNTER

14" D. UPPER CABINETS
ON RANGE WALL

- LINE - 2
COMO MELAMINE - OLMO AMBIANCE
HARDWARE -
STANDARD WHITE INTERIOR
SOFT CLOSE DOORS & DRAWERS
4 PCS - 5/8" KICK - FIN. BOTH ENDS
1 PCS - 90 DEG. CORNER MOULD
1 PCS - T-MOULD
4 PCS - FLAT MOULD

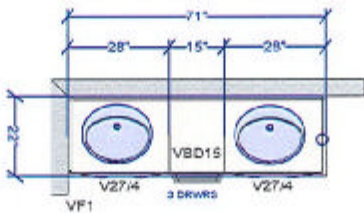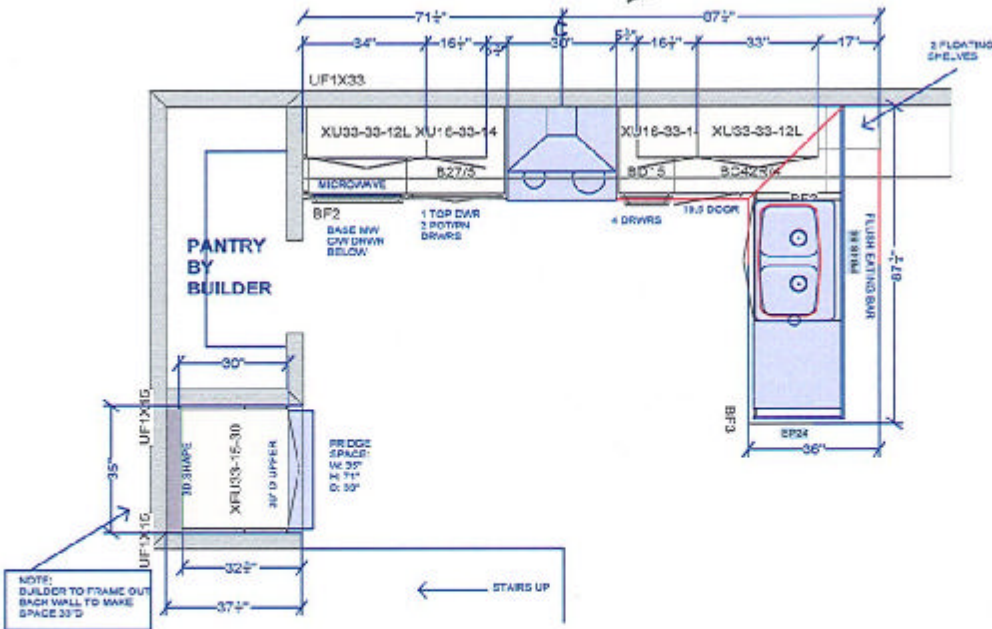


ENSUITE

~~LINE 4 - SOHO MDF - CUSTOM COLOUR - DELETE~~
~~BENJAMIN MOORE #HC189 CHROME GREEN~~
~~HW - RICHELIEU - BP873192900 (HORIZONTAL)~~

CUSTOMER APPROVAL I have reviewed these drawings and understand the details of the design and the Carter Kitchens specifications. Signature _____ Date _____	All dimensions & size designations given are subject to verification on job site and adjustment to fit job conditions.	This is an original design and must not be released or copied unless applicable fee has been paid or job order placed. <i>Carter Kitchens</i>	Designed: 7/6/2022 Printed: 7/6/2022
	DCR #345 PWYS2 - Klondike Bsmt Bdrm Apt	All	Drawing # 1 No Scale.

DS
CK
DS
EL

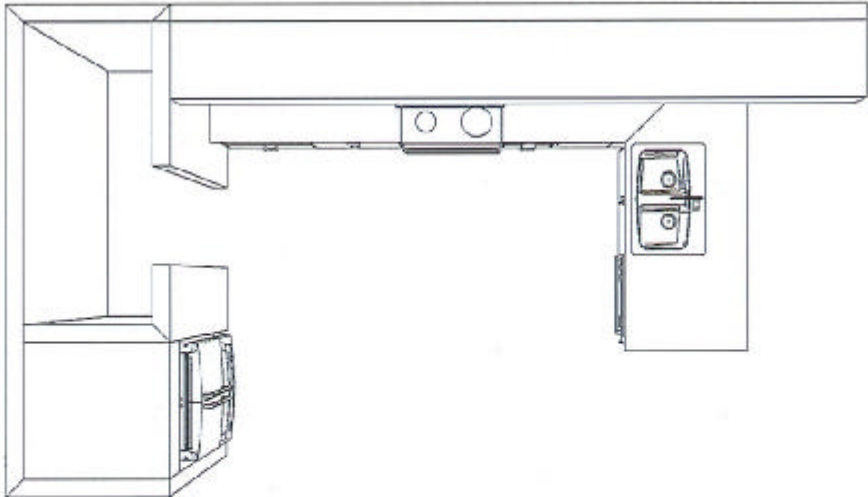

BASEMENT KITCHEN - TOP VIEW

CUSTOMER APPROVAL

I have reviewed these drawings and understand the details of the design and the Cartier Kitchens specifications

Signature _____

Date _____

Note: This drawing is an artistic interpretation of the general appearance of the design. It is not meant to be an exact rendition.




Designed: 7/6/2022
Printed: 7/6/2022

DS

Cl

DS

El

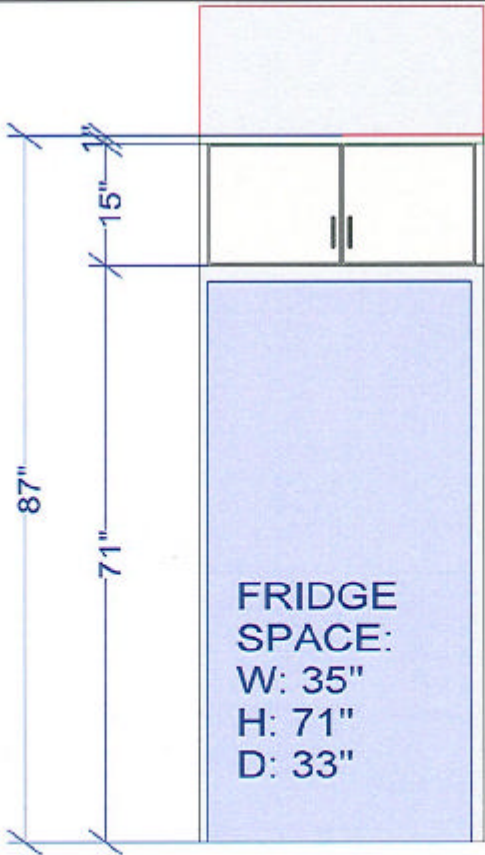

BASEMENT KITCHEN - FRIDGE WALL ELEVATION

CUSTOMER APPROVAL
I have viewed this drawing and understand the details of the design and the Cartier Kitchens specifications.

Signature _____
Date _____

All dimensions & size designations given are subject to verification on job site and adjustment to fit job conditions.


Cartier
KITCHENS

This is an original design and must not be released or copied unless applicable fee has been paid or job order placed.

Designed: 7/5/2022
Printed: 7/5/2022

DS
Cl


DS
El

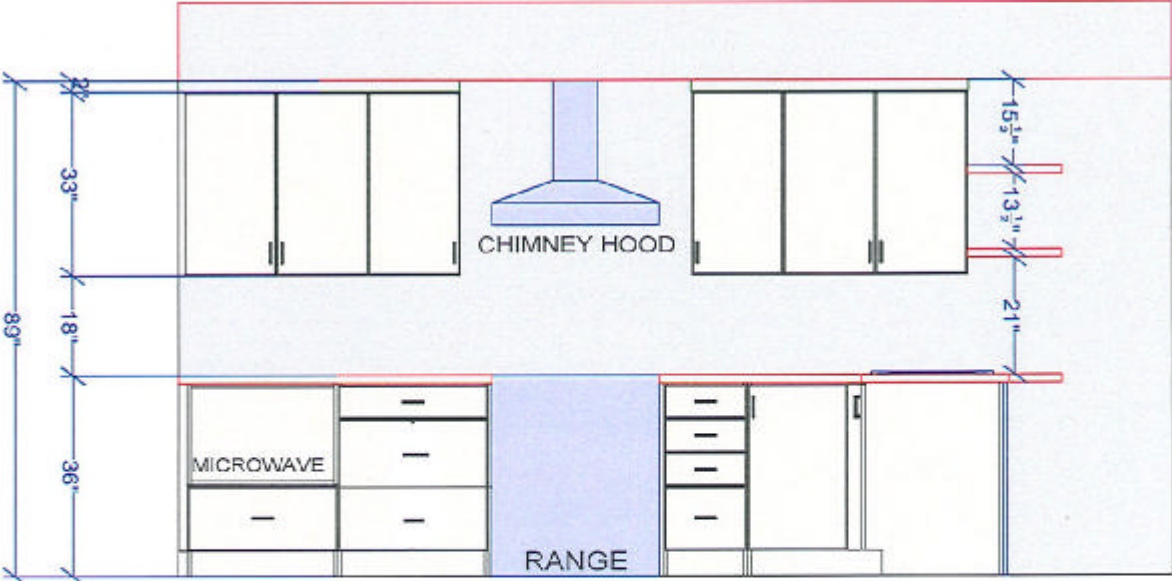

BASEMENT KITCHEN - RANGE WALL ELEVATION

CUSTOMER APPROVAL I have reviewed these drawings and understand the details of the design and the Cartier Kitchens specifications. Signature: _____ Date: _____	All dimensions and size designations given are subject to verification on job site and adjustment to fit job conditions.		This is an original design and must not be released or copied unless applicable fee has been paid or job order placed.	Designed: 7/6/2022 Printed: 7/6/2022
				DCR #345 PWYS2 - Klondike Bsmt 1 Bdrm Apt

DS DS
Ck El

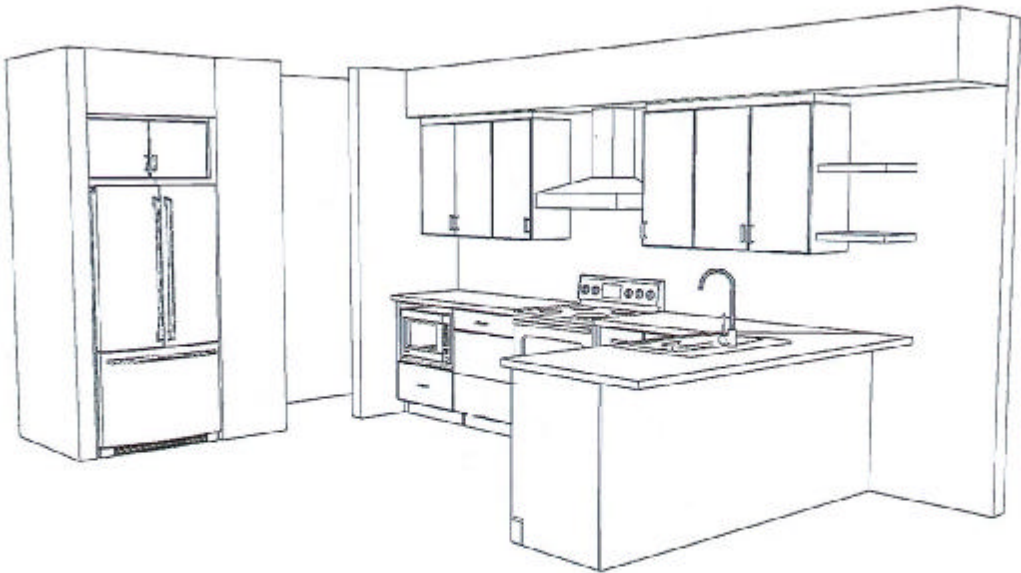

BASEMENT KITCHEN - 3D VIEW #1

CUSTOMER APPROVAL

have reviewed these drawings and understand the details of the design and the Cartier Kitchens specifications

Signature _____

Date _____

Note: This drawing is an artistic interpretation of the general appearance of the design. It is not meant to be an exact rendition.



Designed: 7/6/2022
Printed: 7/6/2022

DCR #345 PWYS2 - Klor'dike Bsmt | Bdrm Apt

All


Drawing #: 1

DS

Cl

DS

El

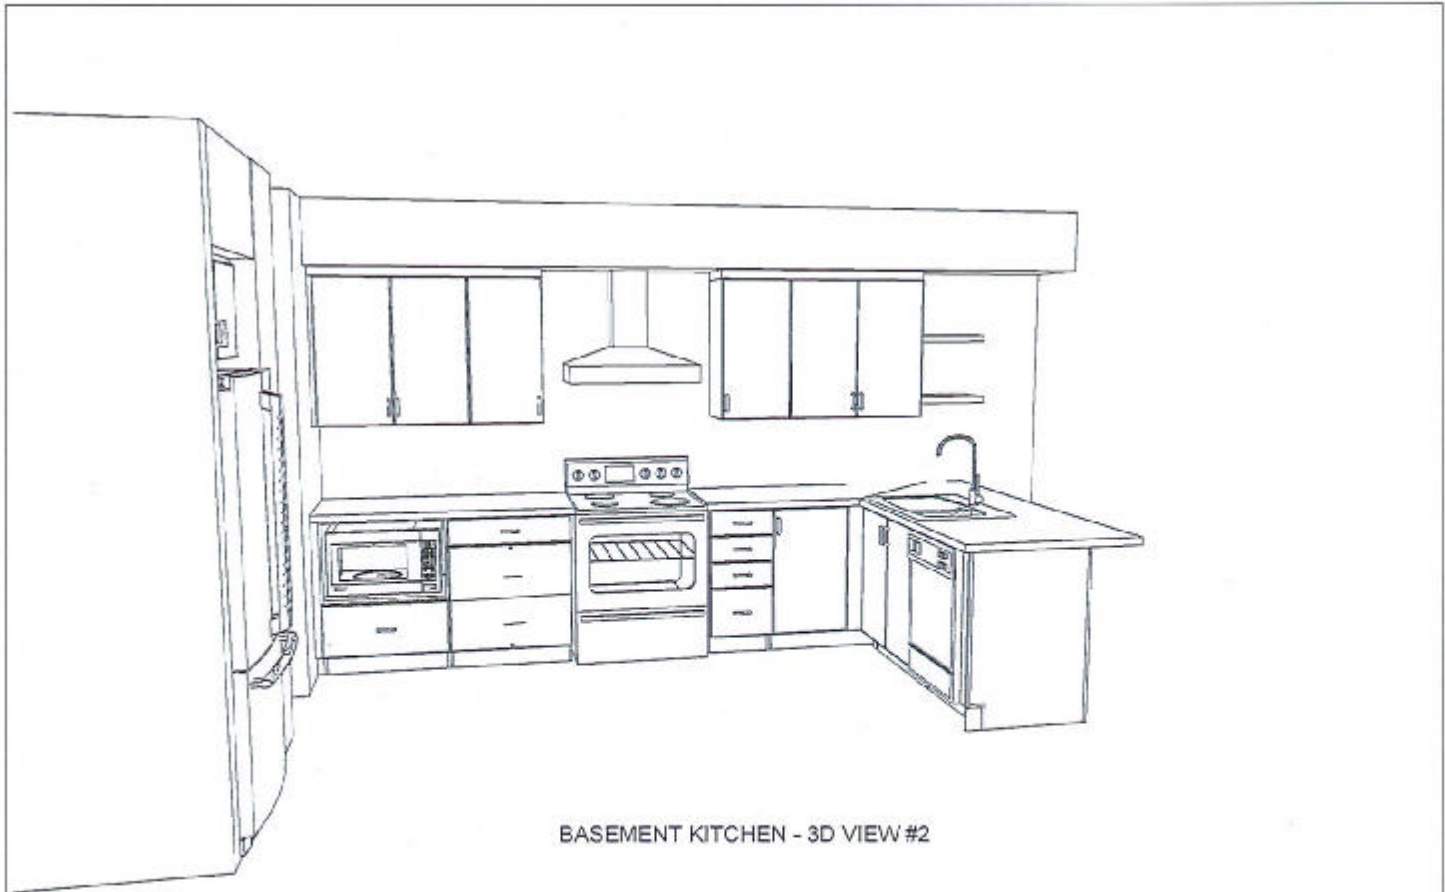

BASEMENT KITCHEN - 3D VIEW #2

CUSTOMER APPROVAL I have reviewed these drawings and understand the details of the design and the Carter Kitchens specifications. Signature _____ Date _____


Note: This drawing is an artistic interpretation of the general appearance of the design. It is not meant to be an exact rendition.		Designed: 7/5/2022 Printed: 7/5/2022
		DCR #345 PWYS2 - Klondike Bsmt ! Bdrm Apt All Drawing #: 1

DS

Cl

DS

El

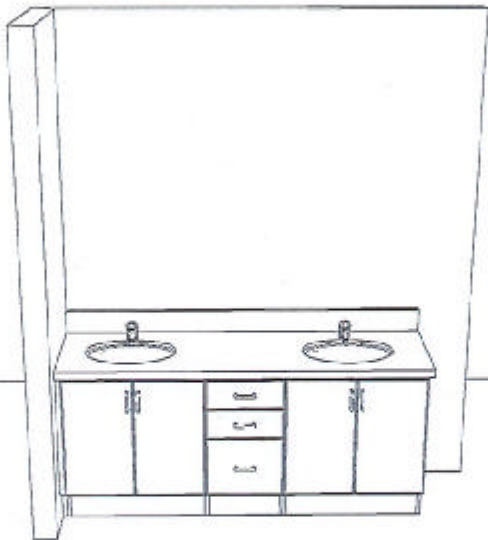

BASEMENT BATH - 3D VIEW #1

CUSTOMER APPROVAL I have reviewed these drawings and understand the details of the design and the Carter Kitchen specifications. Signature _____ Date _____
--

Note: This drawing is an artistic interpretation of the general appearance of the design. It is not meant to be an exact rendition.		Designed: 7/6/2022 Printed: 7/6/2022
		DCR #345 PWYS2 - Klondike Bsmt ! Bdrm Apt All Drawing #: 1

DS

Cl

DS

El