

DCR PHOENIX HOMES

LOT # 3-51
WHITE TAIL RIDGE 3
MODEL - ANNAPOLIS (509)

KITCHEN


MOUNTING HEIGHT - 96

42"H UPPERS @18" ABOVE COUNTER

- CABINETS -
HARDWARE -
STANDARD WHITE INTERIOR
METAL DRAWER BOX
4 PCS - 5/8" KICK - FIN. BOTH ENDS
5 PCS - FLAT SHOE MOULDING
2 PCS - 90 DEG. CORNER MOULD
1 PCS - T-MOULD

~~LIGHT VALANCE~~

NOTE:
DOORWAY
MOVED 8"
TO MAKE SPACE
FOR FRIDGE/FREEZER

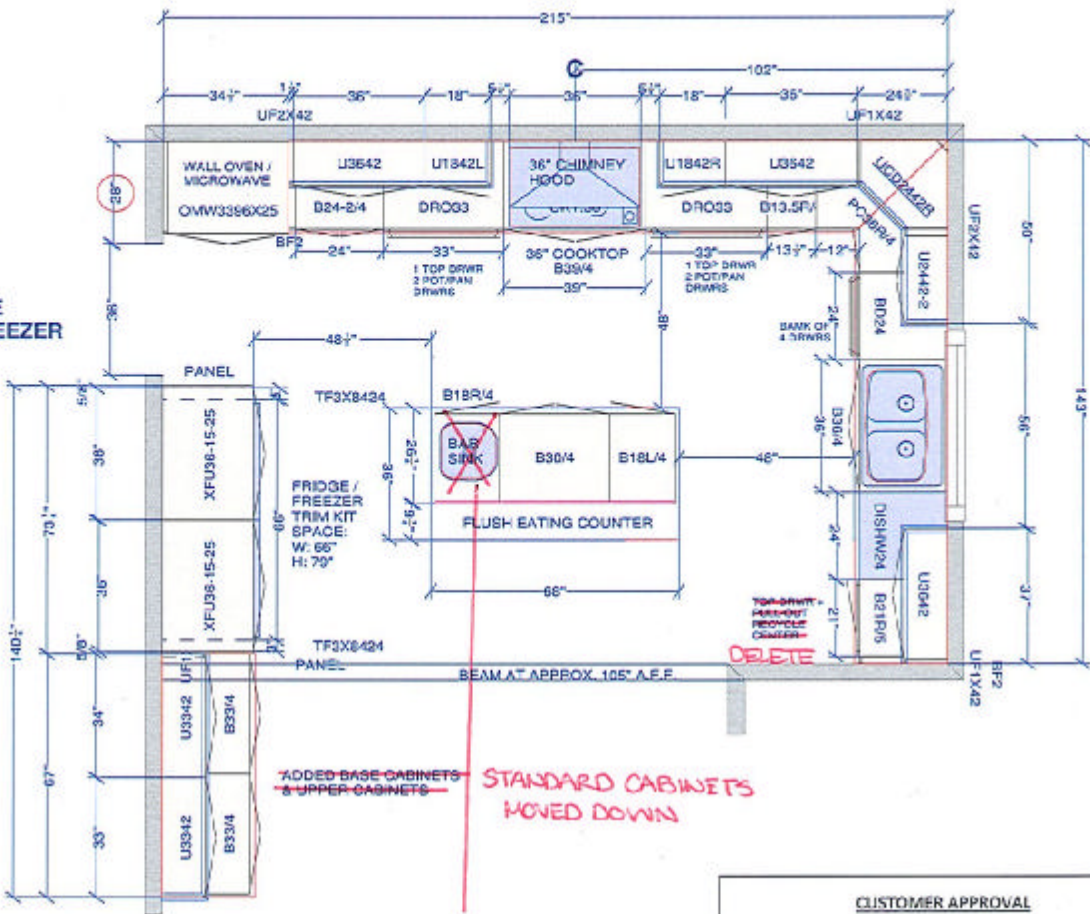

CUSTOMER APPROVAL

I have reviewed these drawings and understand the details of the design and the CARTIER KITCHENS specifications.

Signature _____

Date _____

All dimensions, size designations given are subject to verification on job site and adjustment to fit job conditions.



This is an original design and must not be released or copied unless applicable fee has been paid or job order placed.


Designed: 2022-07-15
Printed: 2022-07-15

DCR - #3-61 White Tail Ridge 3 - Annapolis Kitchen .kit

All

Drawing #: 1 No Scale.

DS DS

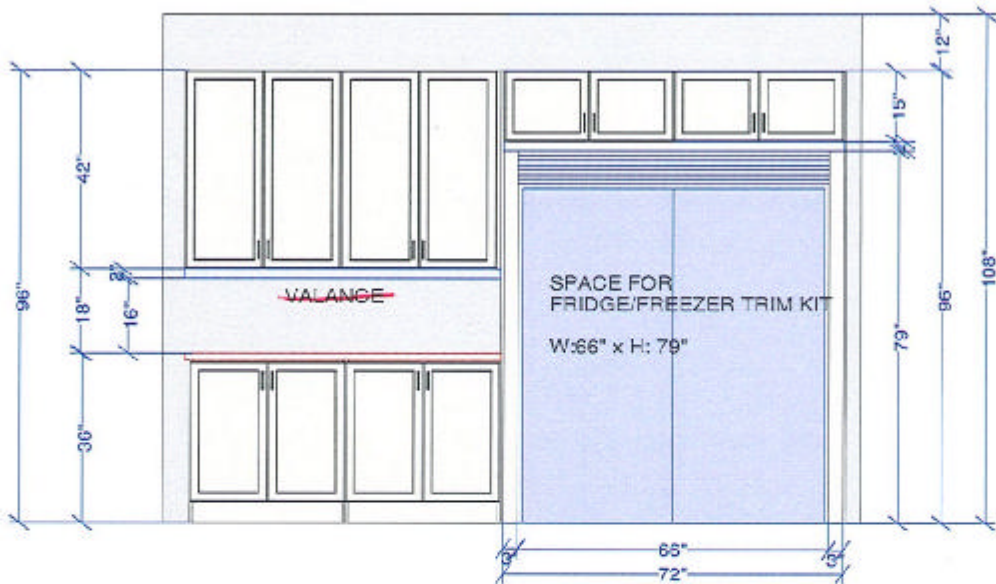

CUSTOMER APPROVAL

I have reviewed these drawings and understand the details of the design and the CARTIER KITCHENS specifications.

Signature _____

Date _____

FRIDGE/FREEZER WALL ELEVATION


All dimensions, size designations given are subject to verification on job site and adjustment to fit job conditions.



This is an original design and must not be released or copied unless applicable fee has been paid or job order placed.

Designed: 2022-07-15
Printed: 2022-07-15

DS DS

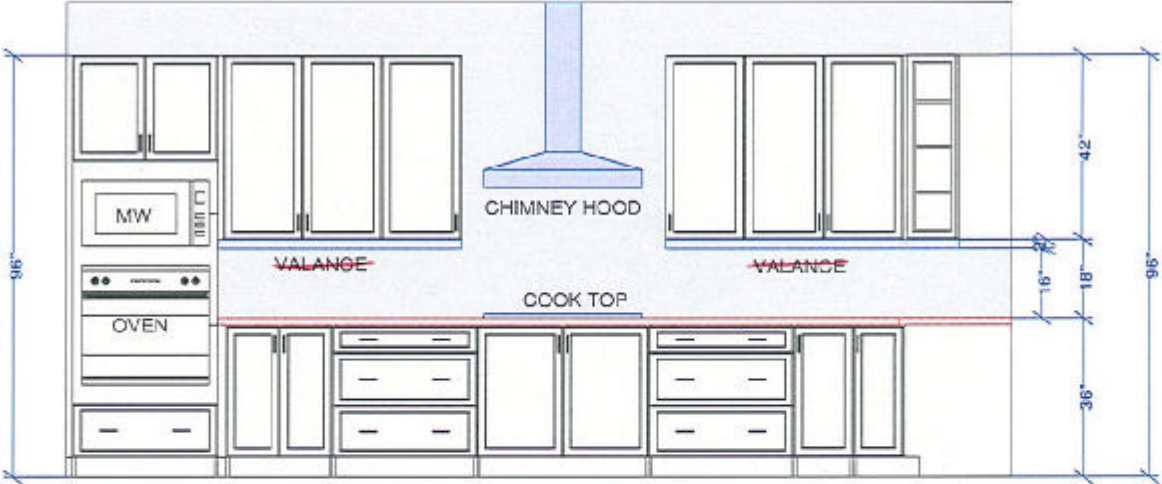

COOKTOP WALL ELEVATION

CUSTOMER APPROVAL

I have reviewed these drawings and understand the details of the design and the CARTIER 1070-HRS specifications.

Signature _____

Date _____


All dimensions ,size designations given are subject to verification on job site and adjustment to fit job conditions.



This is an original design and must not be released or copied unless applicable fee has been paid or job order placed.

Designed: 2022-07-15
Printed: 2022-07-15

DS DS

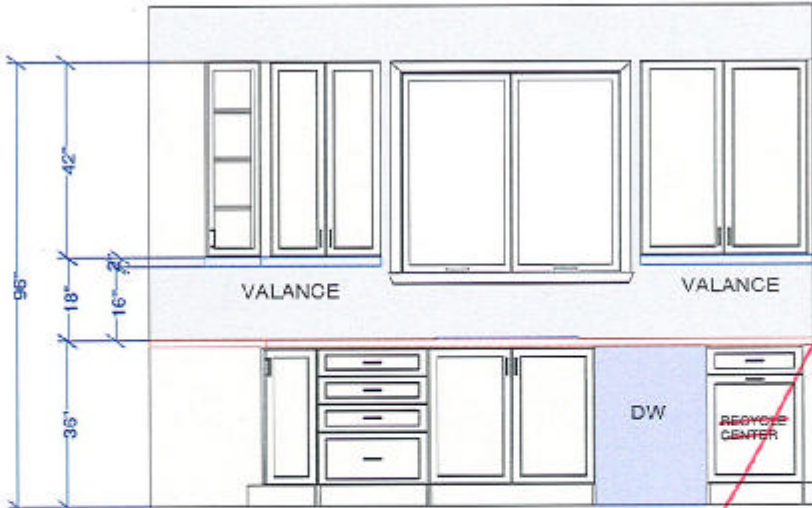

CUSTOMER APPROVAL

I have reviewed these drawings and understand the details of the design and the CARTIER KITCHENS specifications.

Signature _____


Date _____

SINK WALL ELEVATION

All dimensions ,size designations given are subject to verification on job site and adjustment to fit job conditions.		This is an original design and must not be released or copied unless applicable fee has been paid or job order placed.	Designed: 2022-07-15 Printed: 2022-07-15
DCR - #3-61 White Tail Ridge 3 - Annapolis Kitchen .klt	El 2	Drawing #: 1 No Scale.	

DS DS



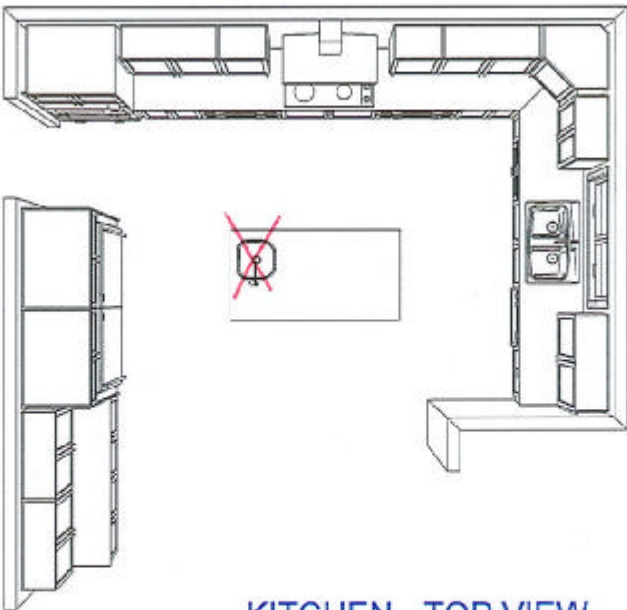

KITCHEN - TOP VIEW

CUSTOMER APPROVAL

I have reviewed these drawings and understand the details of the design and the CARTIER KITCHENS specifications.


Signature _____

Date _____

Note: This drawing is an artistic interpretation of the general appearance of the design. It is not meant to be an exact rendition.		Designed: 2022-07-15
		Printed: 2022-07-15
DCR - #3-61 White Tail Ridge 3 - Annapolis Kitchen		Drawing #: 1

DS



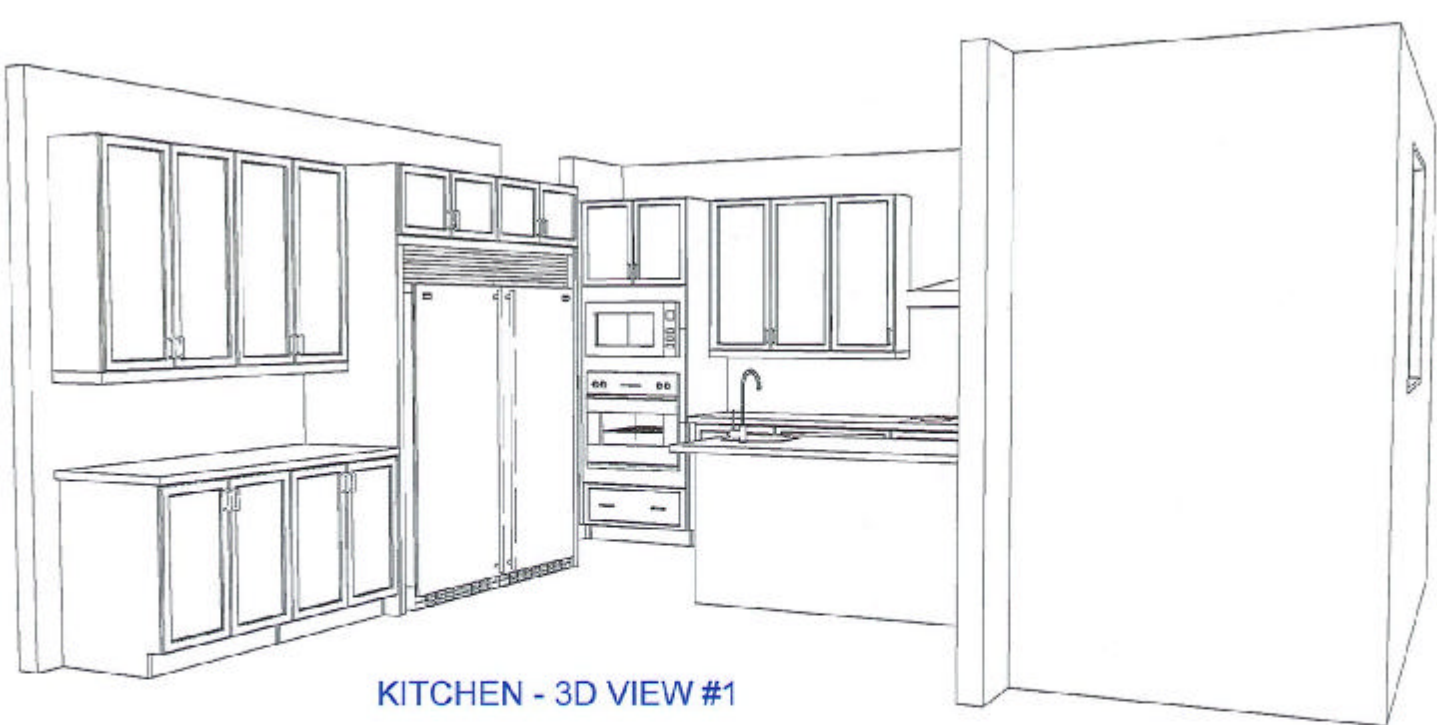

KITCHEN - 3D VIEW #1

CUSTOMER APPROVAL

I have reviewed these drawings and understand the details of the design and the CARTIER KITCHENS specifications.

Signature _____

Date _____

Note: This drawing is an artistic interpretation of the general appearance of the design. It is not meant to be an exact rendition.



Designed: 2022-07-15
Printed: 2022-07-15

DCR - #3-61 White Tail Ridge 3 - Annapolis Kitchen

All


Drawing #: 1

DS



DS



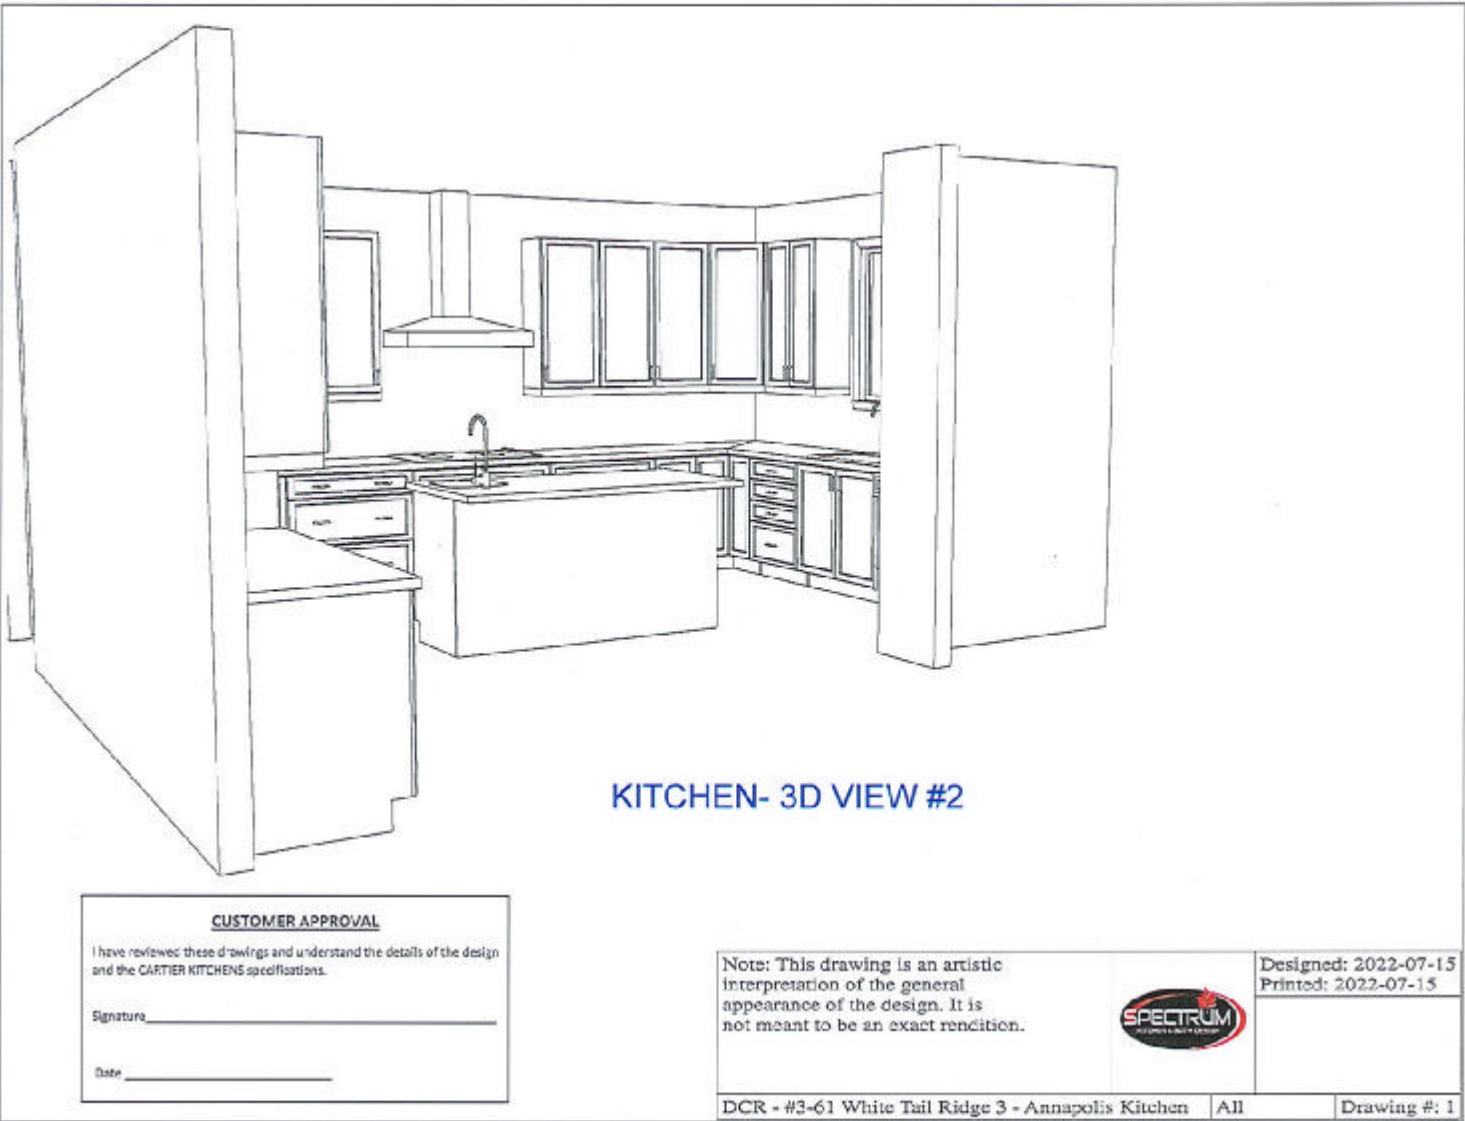


KITCHEN- 3D VIEW #2

CUSTOMER APPROVAL	
I have reviewed these drawings and understand the details of the design and the CARTIER KITCHENS specifications.	
Signature _____	
Date _____	

Note: This drawing is an artistic interpretation of the general appearance of the design. It is not meant to be an exact rendition.		Designed: 2022-07-15
		Printed: 2022-07-15
DCR - #3-61 White Tail Ridge 3 - Annapolis Kitchen		Drawing #: 1

DS DS



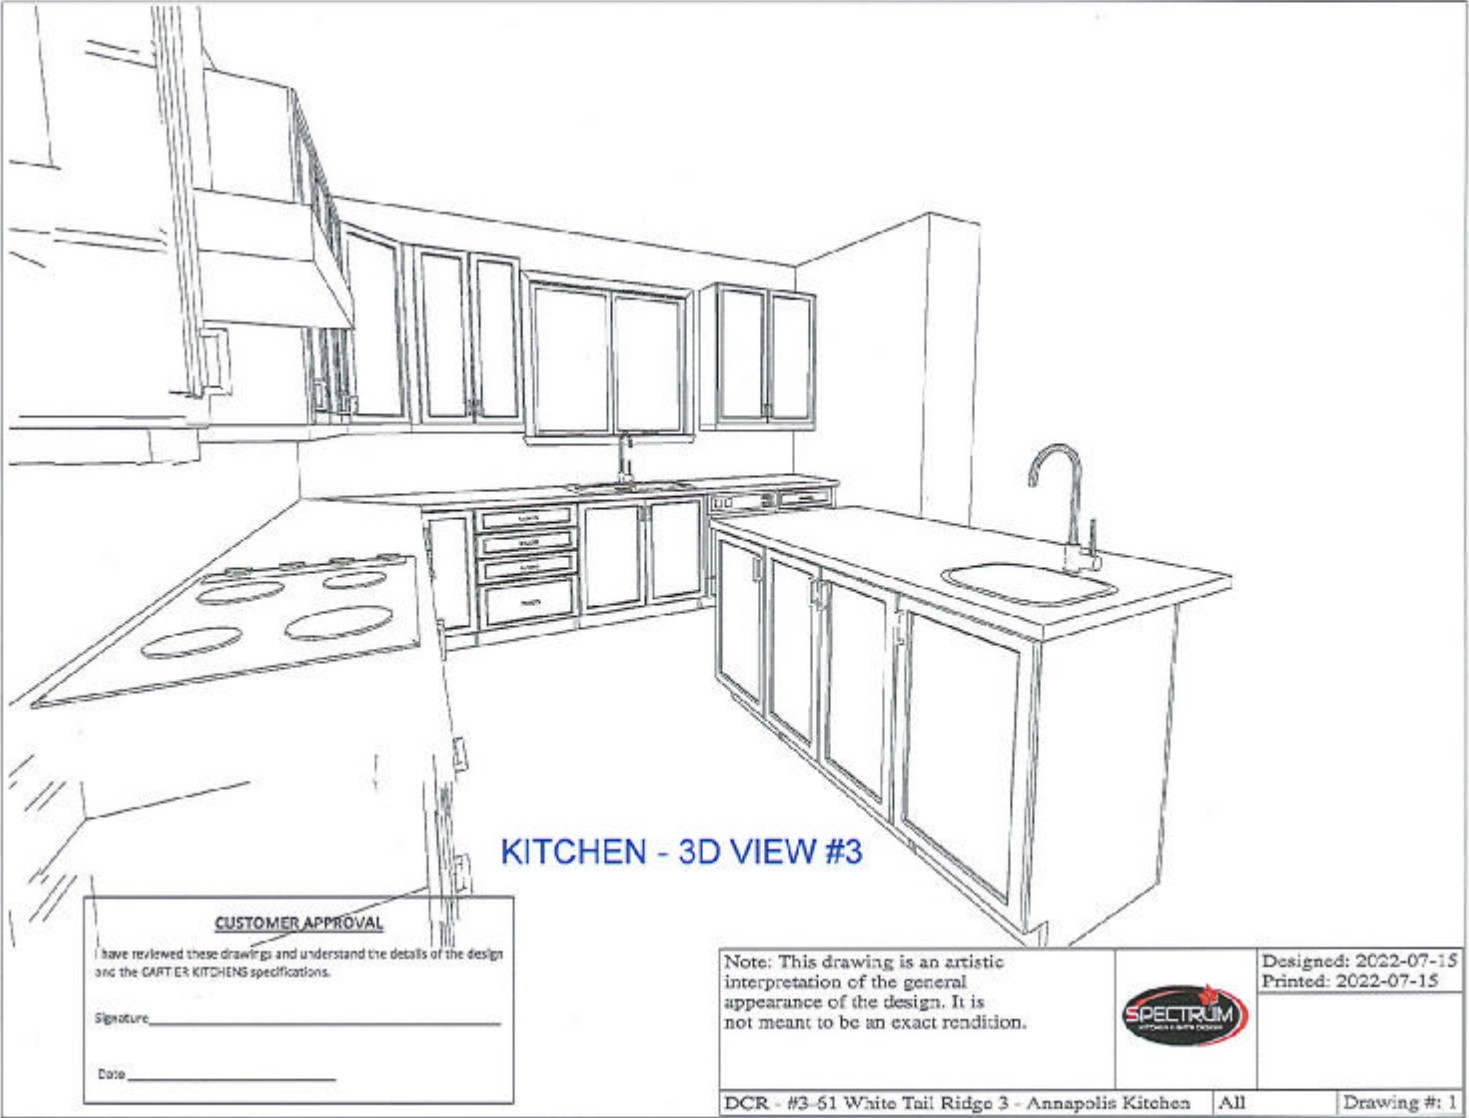

KITCHEN - 3D VIEW #3

CUSTOMER APPROVAL

I have reviewed these drawings and understand the details of the design and the CARTIER KITCHENS specifications.

Signature _____

Date _____

Note: This drawing is an artistic interpretation of the general appearance of the design. It is not meant to be an exact rendition.




Designed: 2022-07-15
Printed: 2022-07-15

DCR - #3-51 White Tail Ridge 3 - Annapolis Kitchen | All | Drawing #: 1

DS DS

A handwritten signature in blue ink, appearing to be "S. J. [unclear]".

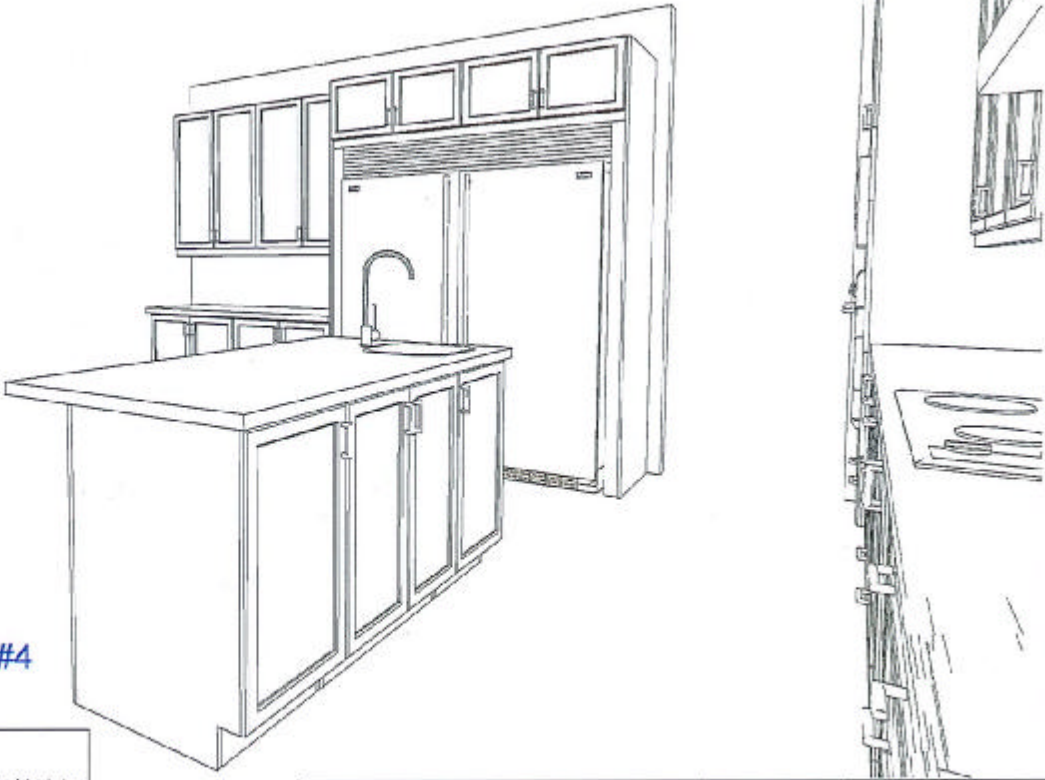

KITCHEN - 3D VIEW #4

CUSTOMER APPROVAL

I have reviewed these drawings and understand the details of the design and the CARTIER KITCHENS specifications.

Signature _____

Date _____

Note: This drawing is an artistic interpretation of the general appearance of the design. It is not meant to be an exact rendition.



Designed: 2022-07-15
Printed: 2022-07-15

DCR - #3-51 White Tail Ridge 3 - Annapolis Kitchen All Drawing #: 1

DS



DS

