


City of Ottawa
Building Services Branch
AUG 10 2022
Building Code Reviewed

101 Centrepointe Dr.
City of Ottawa
JUL 06 2022
BCSB
SITE
COPY

Heat Loss			
Room Name	Htg cfm	C/g cfm	Htg btu
BASEMENT	319	43	0
BATH	27	20	0
BATH 2	7	7	0
BED 2	137	174	0
BED 4	98	142	0
BEDROOM 3	46	33	0
BREAKFAST	106	131	0
DINING	44	29	0
ENSUITE	63	32	0
FAMILY	83	133	0
HALL	174	144	0
KITCHEN	13	5	0
LAUNDRY	45	304	0
LIVING	35	16	0
M. BDRM	267	192	0
PANTRY	53	37	0
PWDR	4	6	184
SITTING	11	7	0
STUDY	66	121	0
W.C. 2	32	17	0
W.C.	9	2	374
	14	5	607
	1653	1600	1165

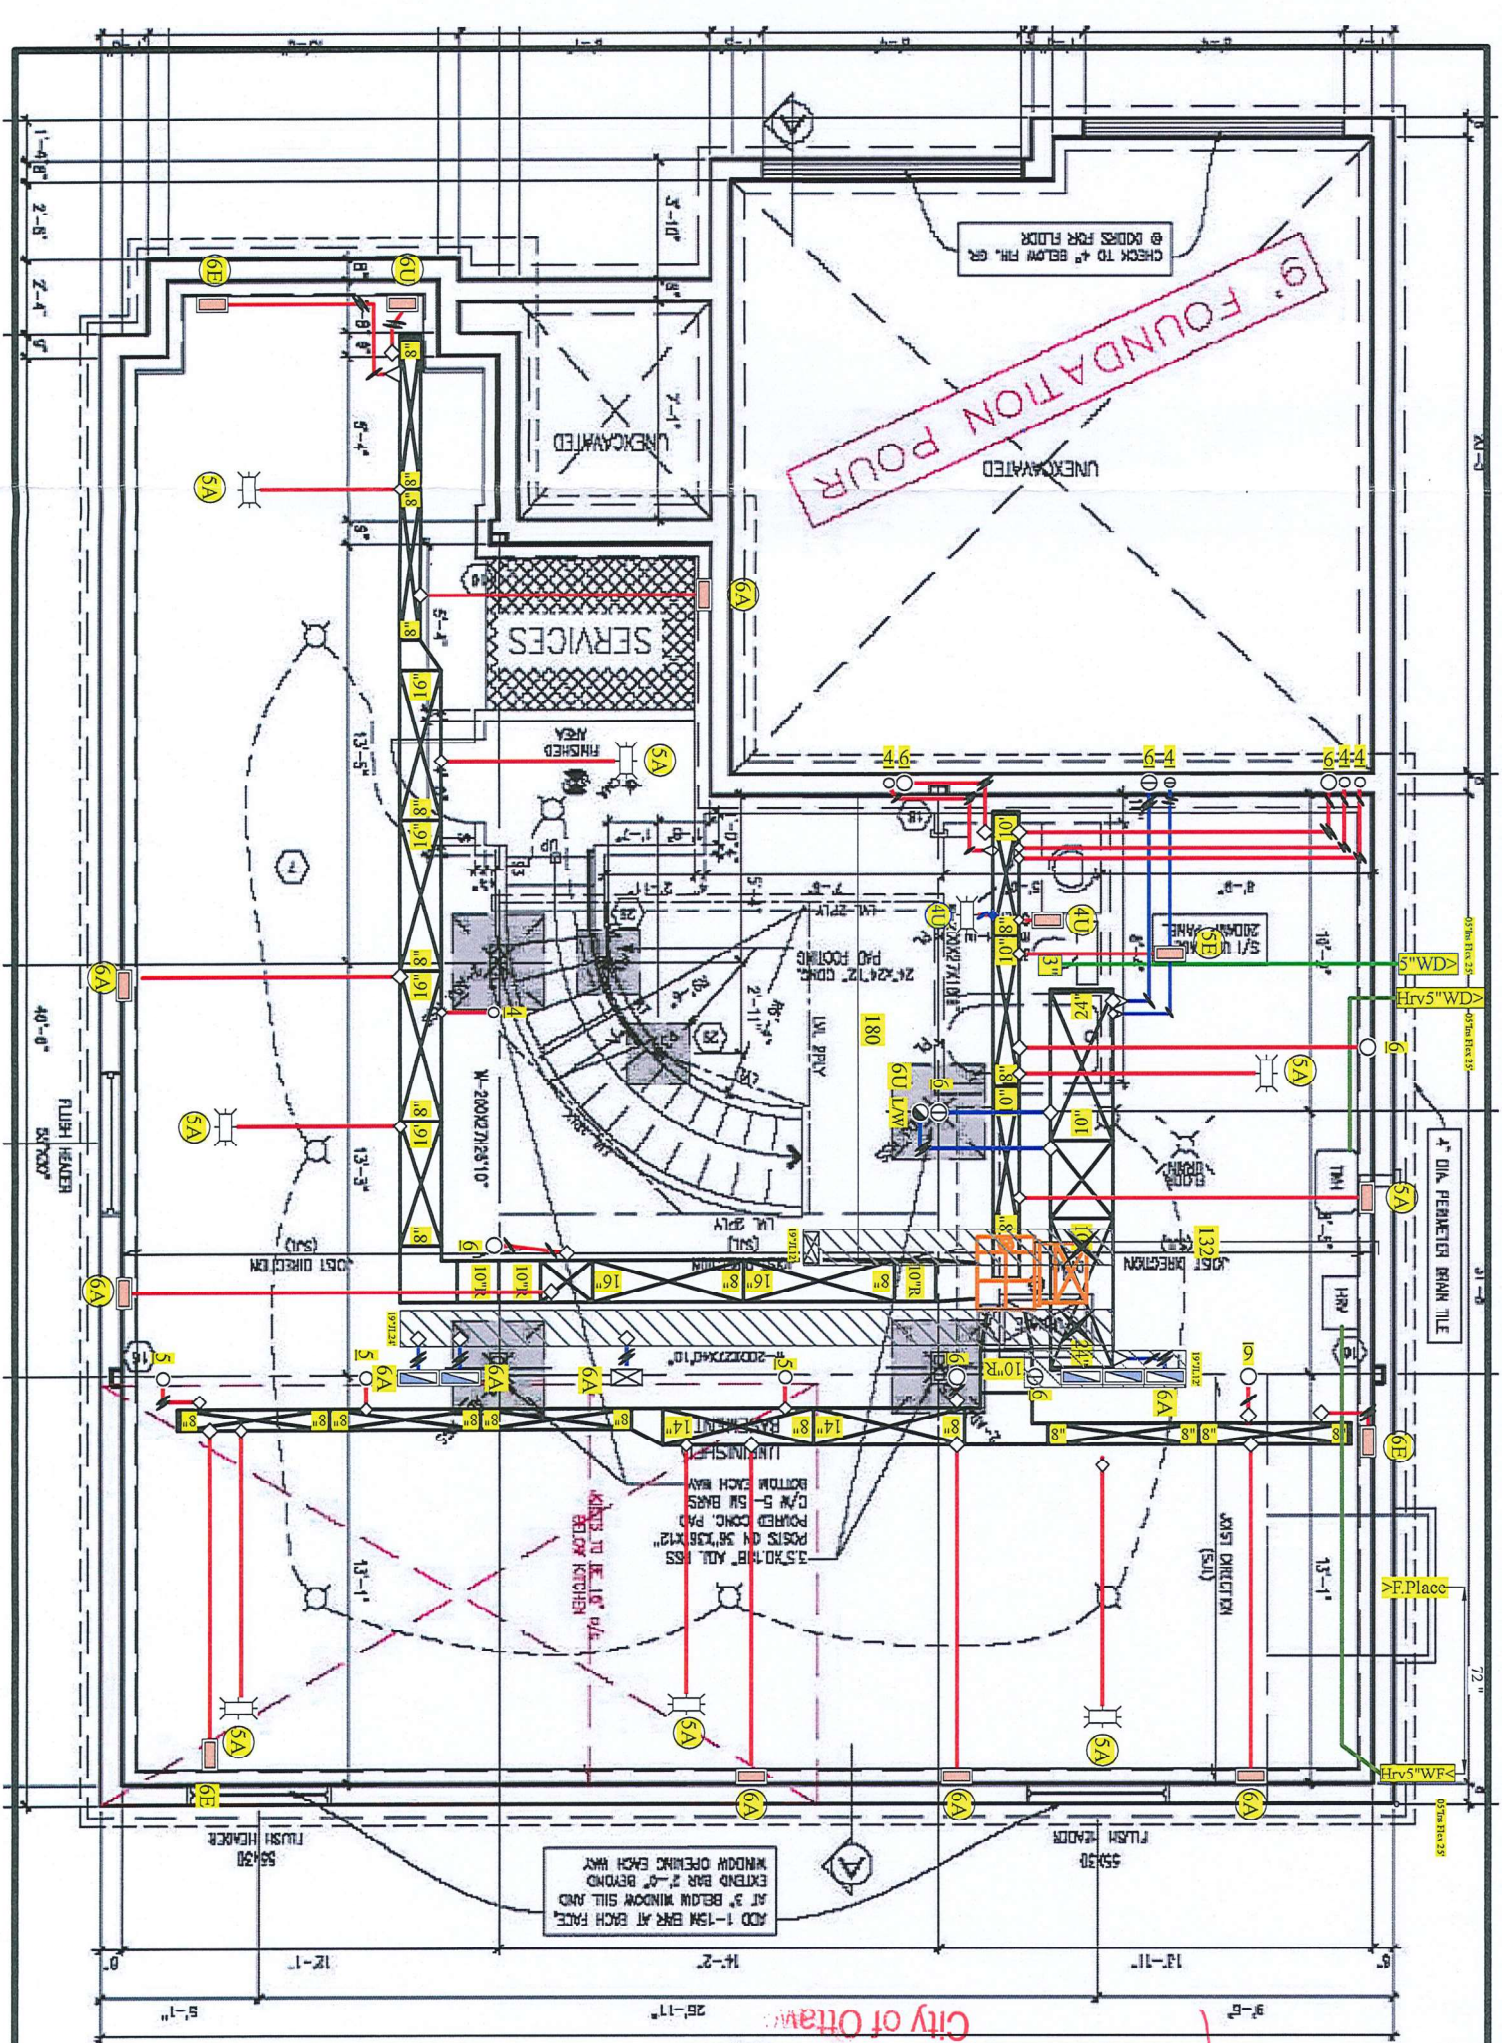


1" = 50.8x21.46mm
4 Panel 20x20 AK Cheasapeake 508-4Bed

City of Ottawa
Building Services Branch
Aug 6 2022
Building Code Reviewed

City of Ottawa
JUL 0 6 2022
BCSB
101 Centrepointe Dr.

Room Name	Htg cfm	Clg cfm	Htg btu
Basement	319	43	0
BATH	27	20	0
BATH 2	7	7	0
BED 2	137	174	0
BED 4	98	142	0
Bedroom 3	46	33	0
Breakfast	106	131	0
DINING	44	29	0
ENsuite	63	32	0
FAMILY	83	133	0
FOYER	174	144	0
HALL	13	5	0
KITCHEN	45	304	0
LANDRY	35	16	0
LIVING	267	192	0
M. BDRM	53	37	0
PANTRY	4	6	184
PWDR	11	7	0
SITTING	66	121	0
STUDY	32	17	0
W.C. 2	9	2	374
WIC	14	5	607
	1653	1600	1165

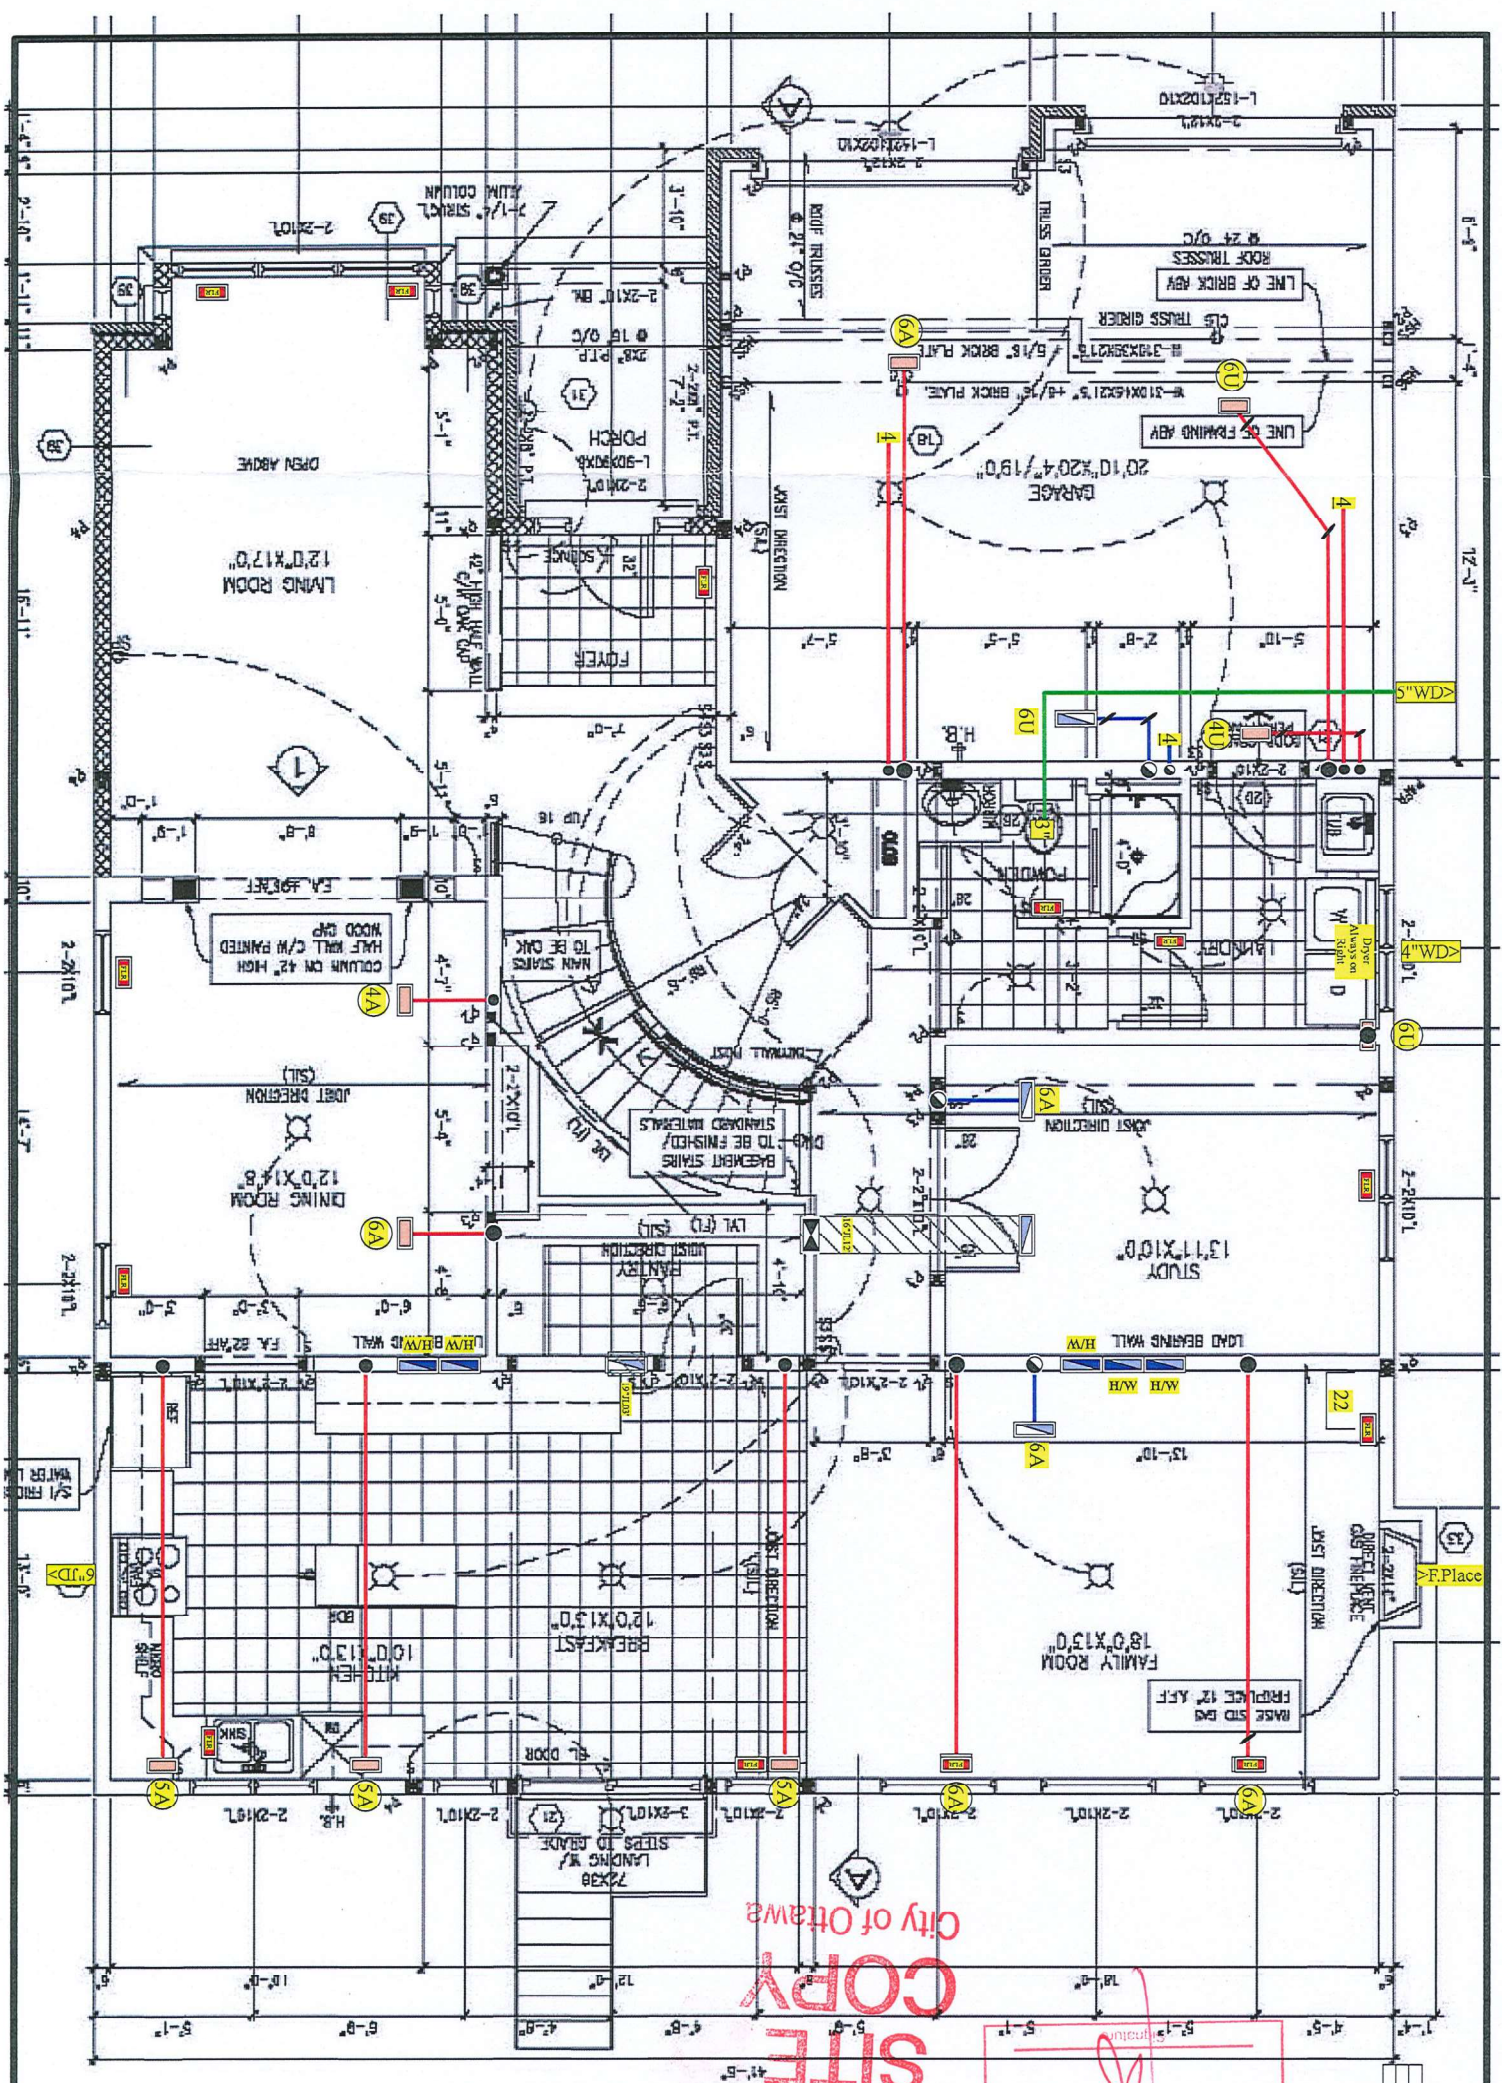

Heart Loss				
Room Name	Hg cm	C/g cm	Hg bit	
BASEMENT	319	43	0	
BATH	27	20	0	
BATH 2	7	7	0	
BED 2	137	174	0	
BED 4	98	142	0	
BEDROOM 3	46	33	0	
BREAKFAST	106	131	0	
DINING	44	29	0	
ENSUITE	63	32	0	
FAMILY	83	133	0	
FOYER	174	144	0	
HALL	13	5	0	
KITCHEN	45	304	0	
LAUNDRY	35	16	0	
LIVING	267	192	0	
M. BDRM	53	37	0	
PANTRY	4	6	184	
PWDR	11	7	0	
SITTING	66	121	0	
STUDY	32	17	0	
W.C. 2	9	2	374	
WIC	14	5	607	
	1653	1600	1165	

STUD WALL REINFORCEMENT FOR FLOOR
BARS IN MAIN BATHROOM
REINFORCEMENT OF STUD WALLS SHALL BE IN
ADVANCE TO WATER CLOSET AND SHOWER
AND BATHROOM CEILING TO 805.05.23. 3B
2023.12.13(X) AND DETAILS PROVIDED

Building Services Branch

AUG 10 2022

~~Building Code Reviewed~~

Signature

City of Ottawa

STREET COPY

City of Ottawa
JUL 06 2022
BCSB
Centrepointe