

REVISED 10/11/2022


DCR PHOENIX HOMES

LOT #3-54
WHITE TAIL RIDGE 3
MODEL - RUTHERFORD (517)

KITCHEN
MOUNTING HEIGHT - 84

- CABINETS -
- HARDWARE -
- STANDARD WHITE INTERIOR
- METAL DRAWER BOX
- 4 PCS - 5/8" KICK - FIN. BOTH ENDS
- 1 PCS - 90 DEG. CORNER MOULD
- 1 PCS - T-MOULD
- 4 PCS - FLAT MOULD

ADD APPROX. 24"
TO LENGTH OF KITCHEN
& ACCOMMODATE FOR PREP SINK

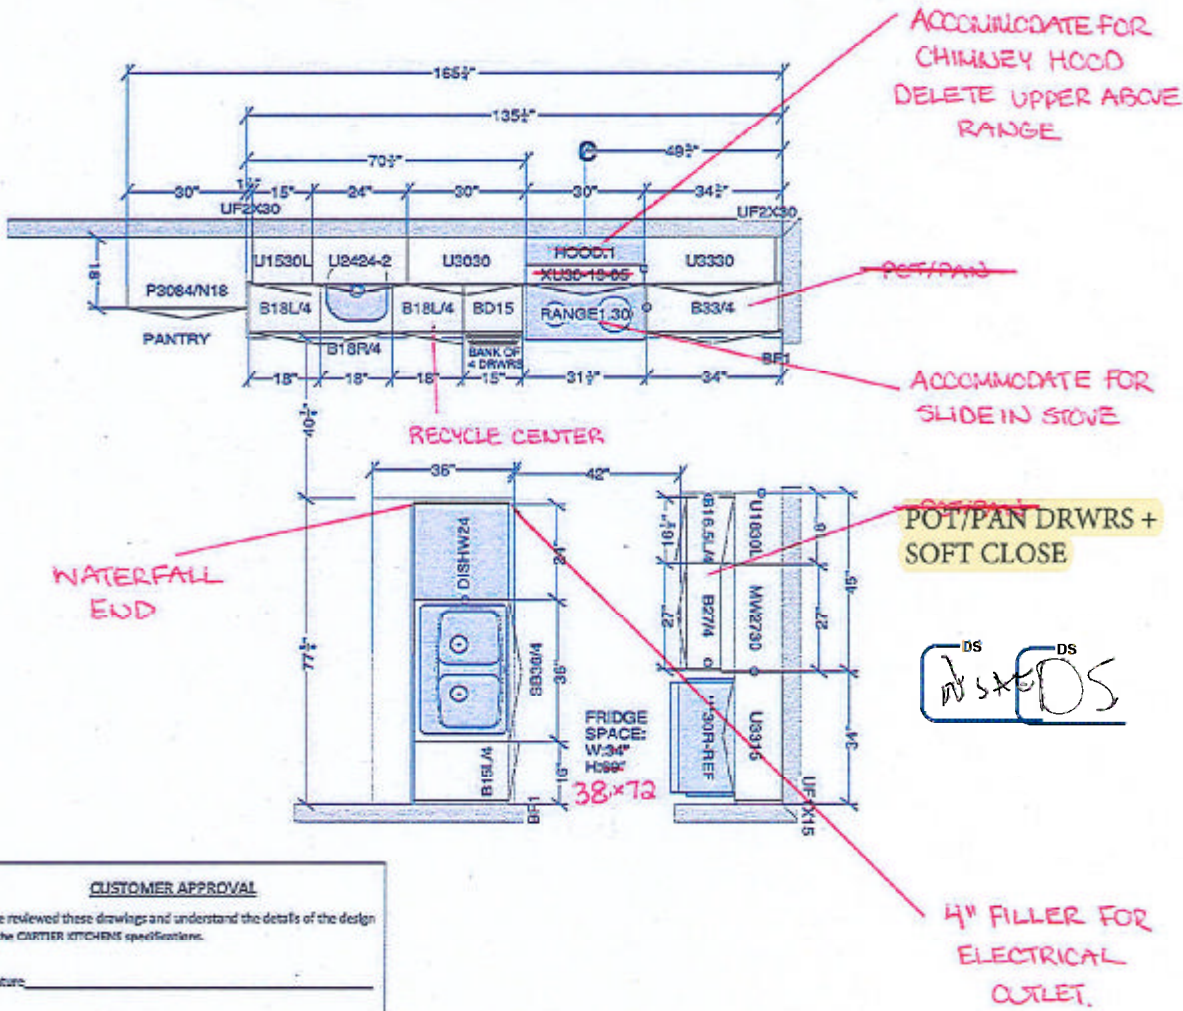

CUSTOMER APPROVAL

I have reviewed these drawings and understand the details of the design and the CARTIER KITCHENS specifications.

Signature: _____

Date: _____

All dimensions size designations given are subject to verification on job site and adjustment to fit job conditions.



This is an original design and must not be released or copied unless applicable fee has been paid or job order placed.


Designed: 2022-07-22
Printed: 2022-07-27

3-54 White Tail Ridge 3 - Rutherford .jdt

All


Drawing #: 1 No Scale.

DS DS
DS DS

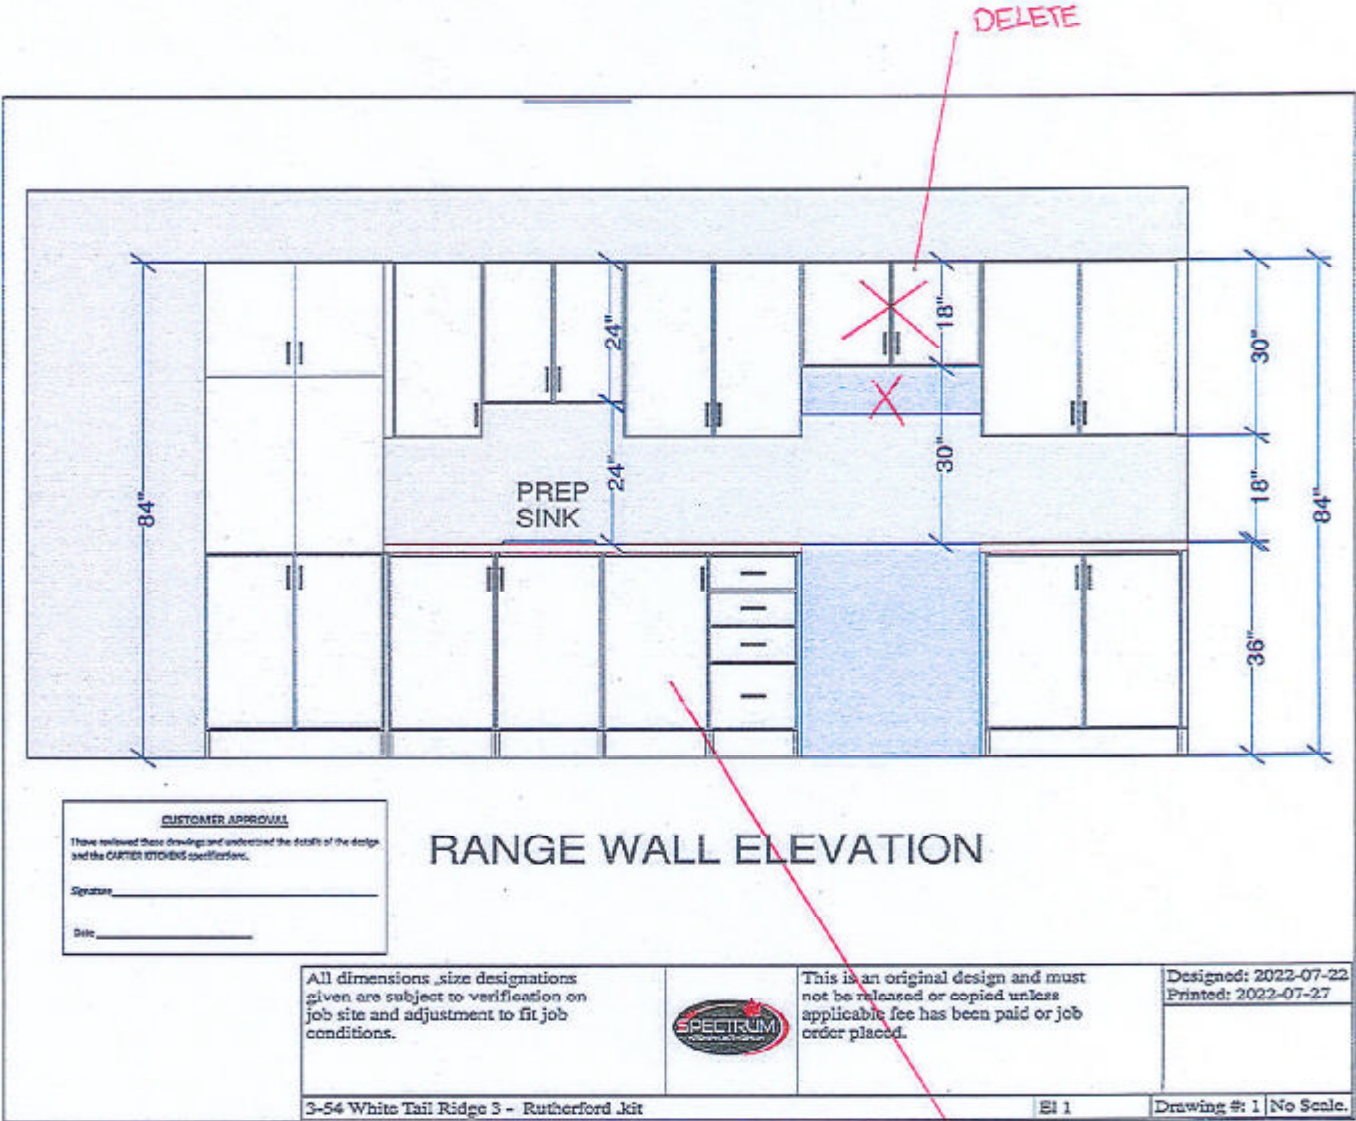

DS DS
DS Mike

WATERFALL
END

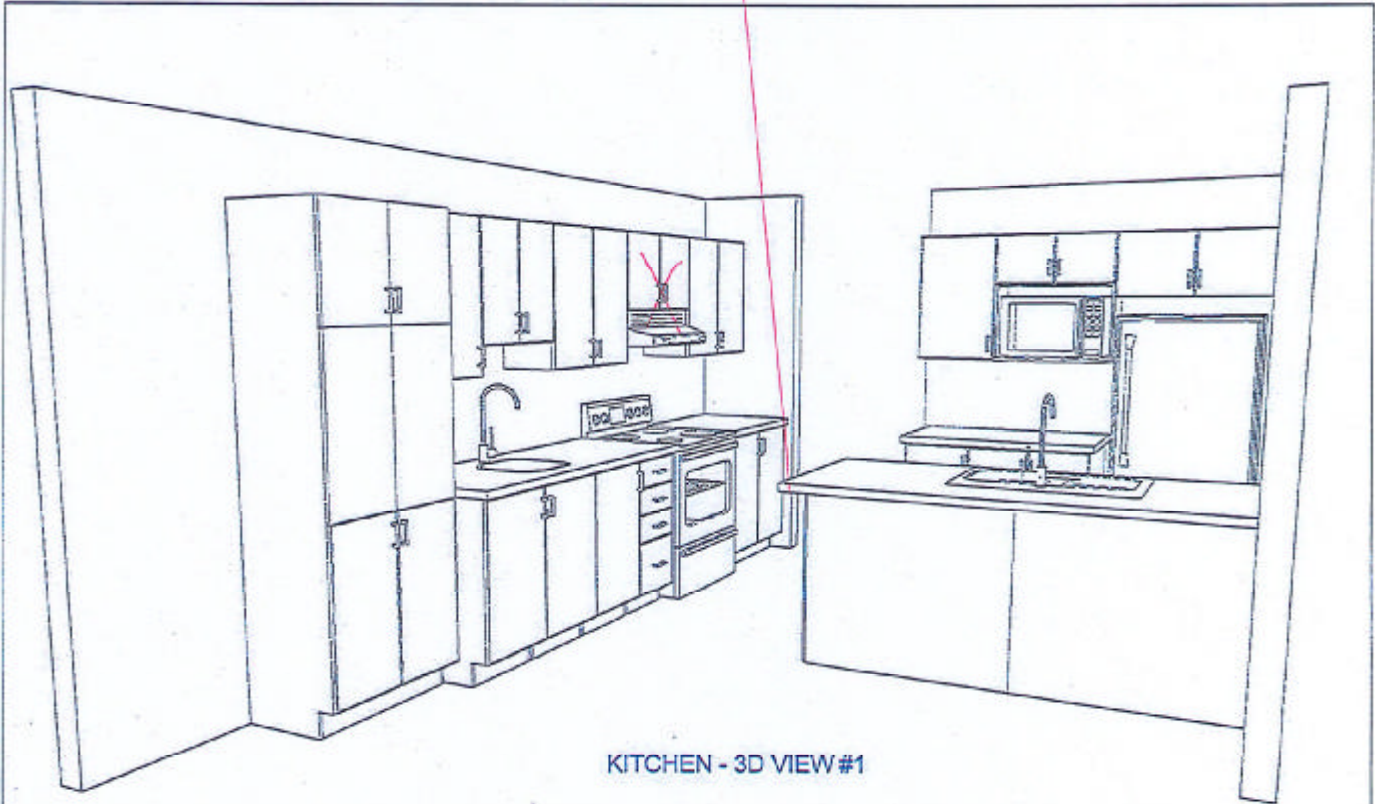

KITCHEN - 3D VIEW #1

CUSTOMER APPROVAL	
I have reviewed these drawings and understand the details of the design and the CARTIER KITCHENS specifications.	
Signature _____	
Date _____	

Note: This drawing is an artistic interpretation of the general appearance of the design. It is not meant to be an exact rendition.



Designed: 2022-07-22
Printed: 2022-07-22

DS DS
D\$ n\$ x\$