
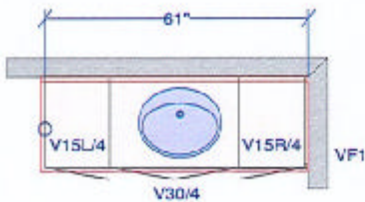


DCR PHOENIX HOMES


MODEL - WINCHESTER (43-4)
KITCHEN
MOUNTING HEIGHT - 84

- LINE - 1 & 2
HARDWARE - STD & 1ST UPGRADE
STANDARD WHITE INTERIOR
METAL DRAWER BOX
4 PCS - 5/8" KICK - FIN. BOTH ENDS
2 PCS - LOOSE FILLER - 6 x 96
2 PCS - 90 DEG. CORNER MOULD
1 PCS - T-MOULD


42" H UPPERS + FLAT PANEL TO CEILING

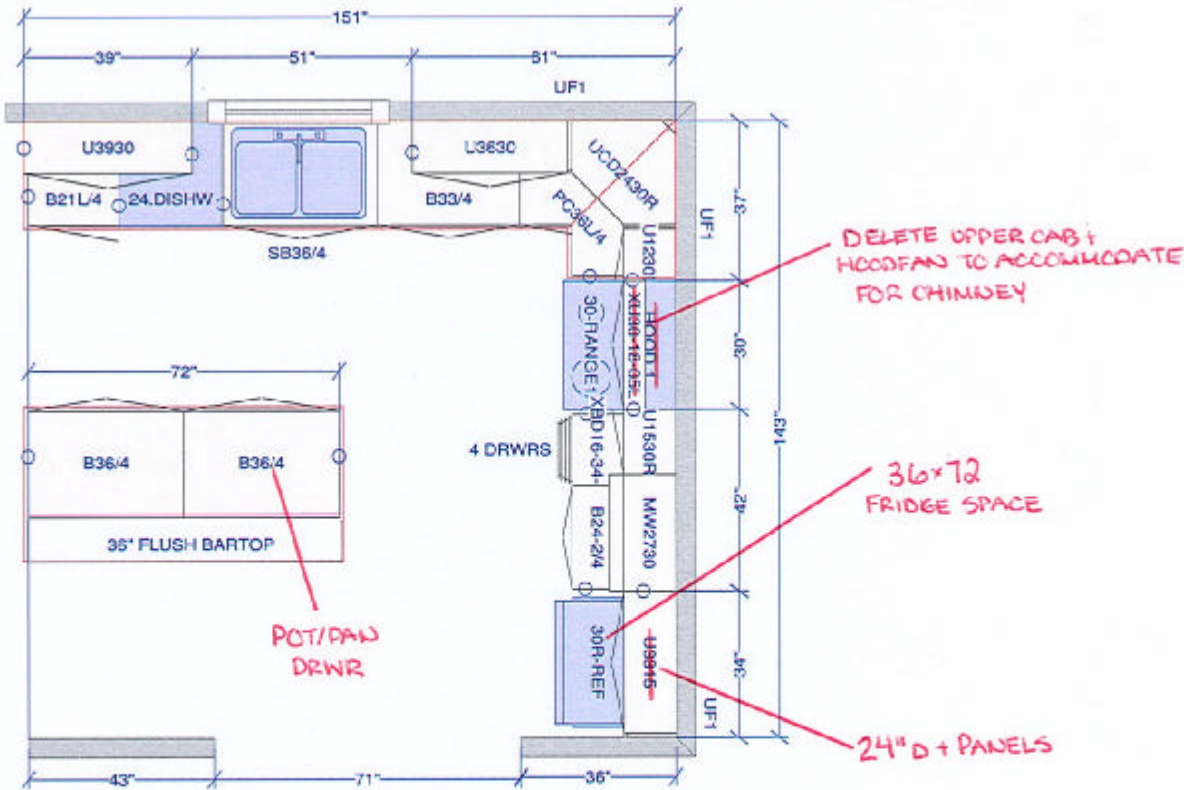

POWDER

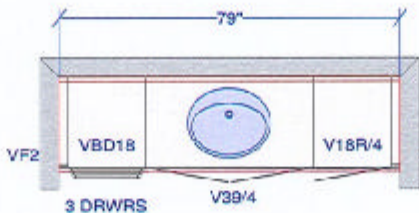

MAIN BATH

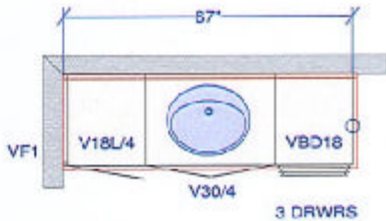

ENSUITE

All dimensions, size designations given are subject to verification on job site and adjustment to fit job conditions.

Cartier Kitchens Ottawa

43-4 Winchester.kit




This is an original design and must not be released or copied unless applicable fee has been paid or job order placed.

Drawn by: Lori Di Saverio, B.I.D.
Cartier Kitchens Ottawa

Designed: 17/07/2013
Printed: 13/10/2014


All

Drawing #: 1 No Scale.

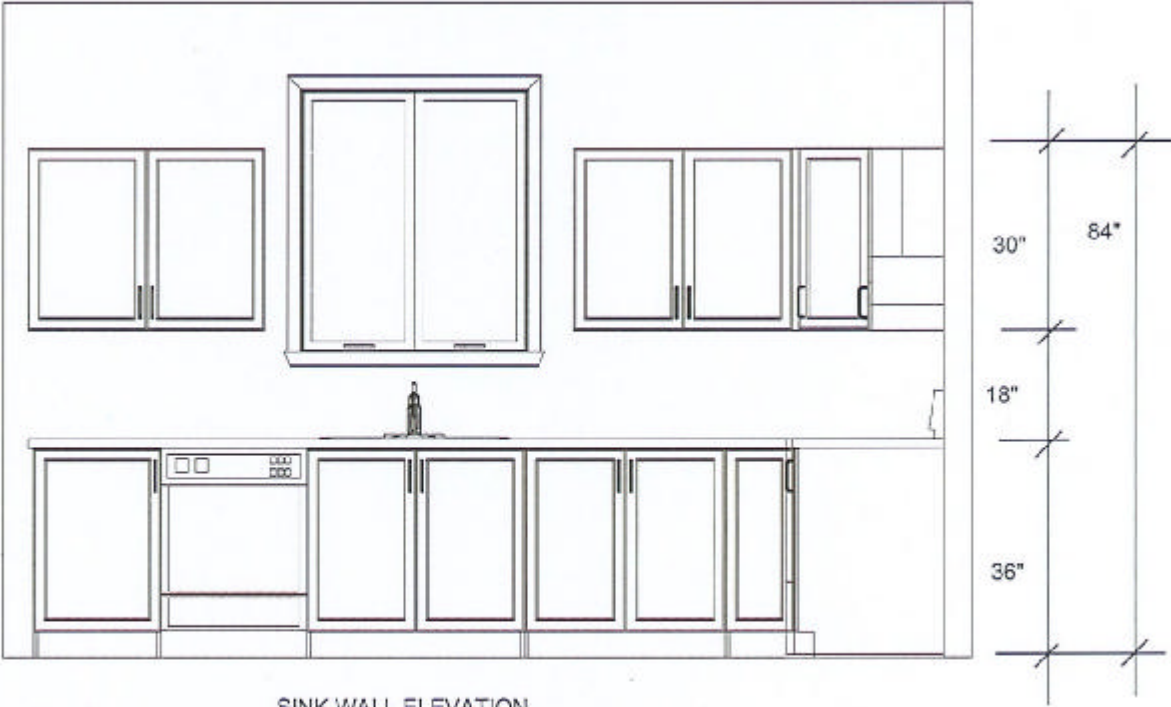


SINK WALL ELEVATION

Note: This drawing is an artistic interpretation of the general appearance of the design. It is not meant to be an exact rendition.		Designed: 17/07/2013
		Printed: 27/03/2014
Drawn By: Lori D Saverio, B.I.D. Cartier Kitchens Ottawa 43-4 Winchester.kit		All Drawing #: 1

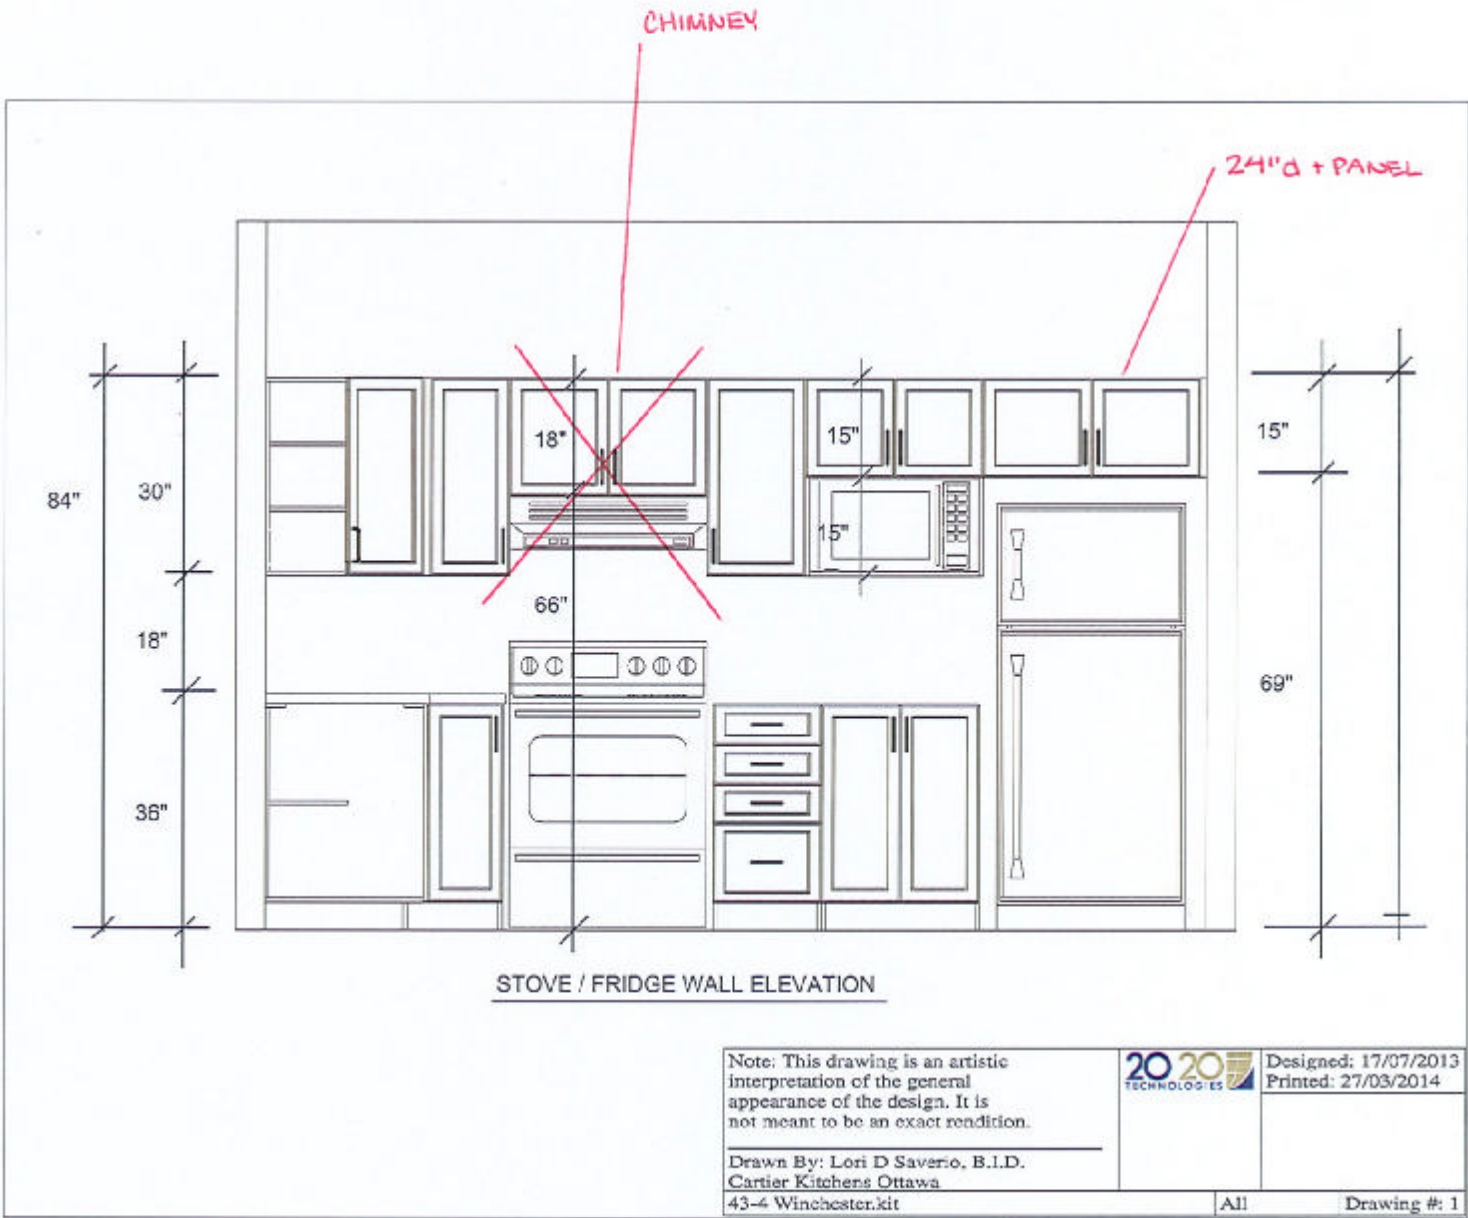



FLAT PANEL
TO CEILING

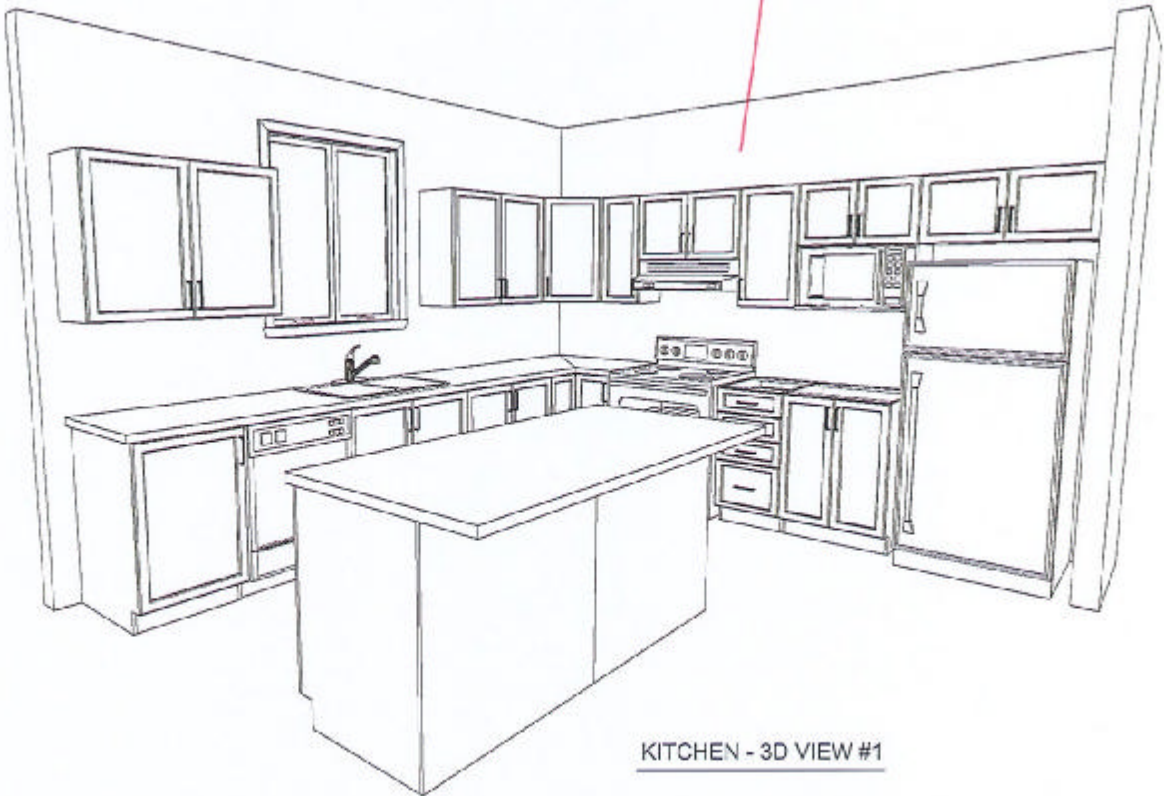

KITCHEN - 3D VIEW #1

Note: This drawing is an artistic interpretation of the general appearance of the design. It is not meant to be an exact rendition. Drawn By: Lori D Saverio, B.I.D. Cartier Kitchens Ottawa 43-4 Winchester.kit		Designed: 17/07/2013 Printed: 27/03/2014
		All Drawing #: 1

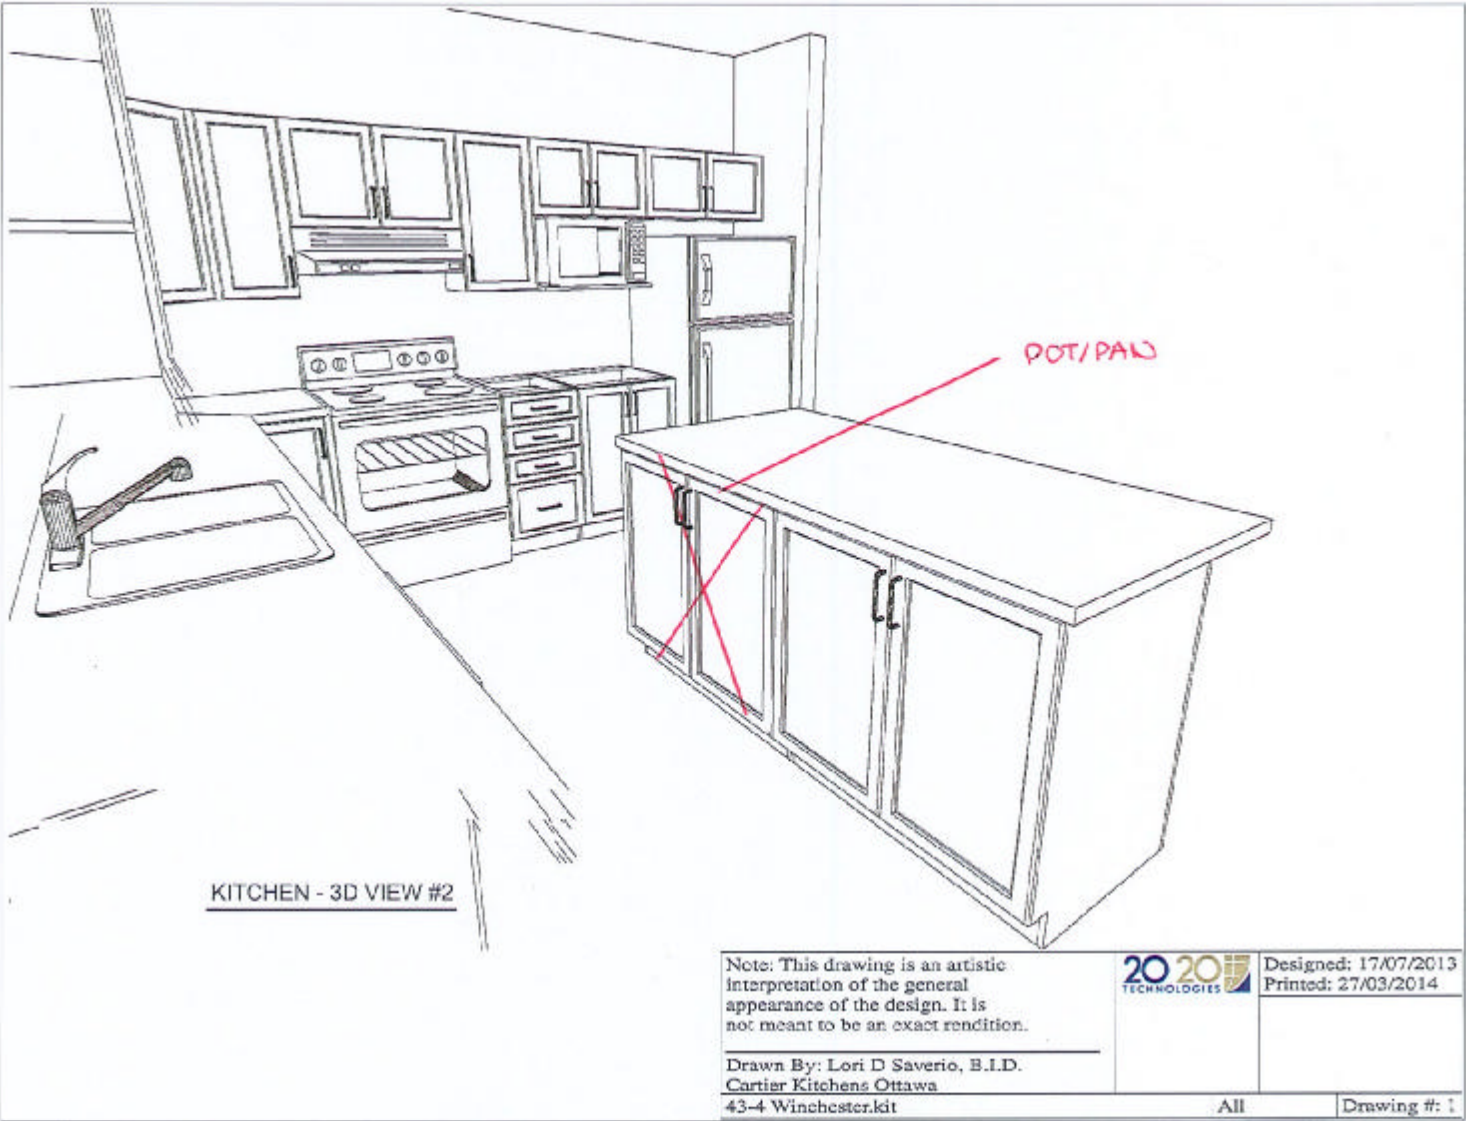

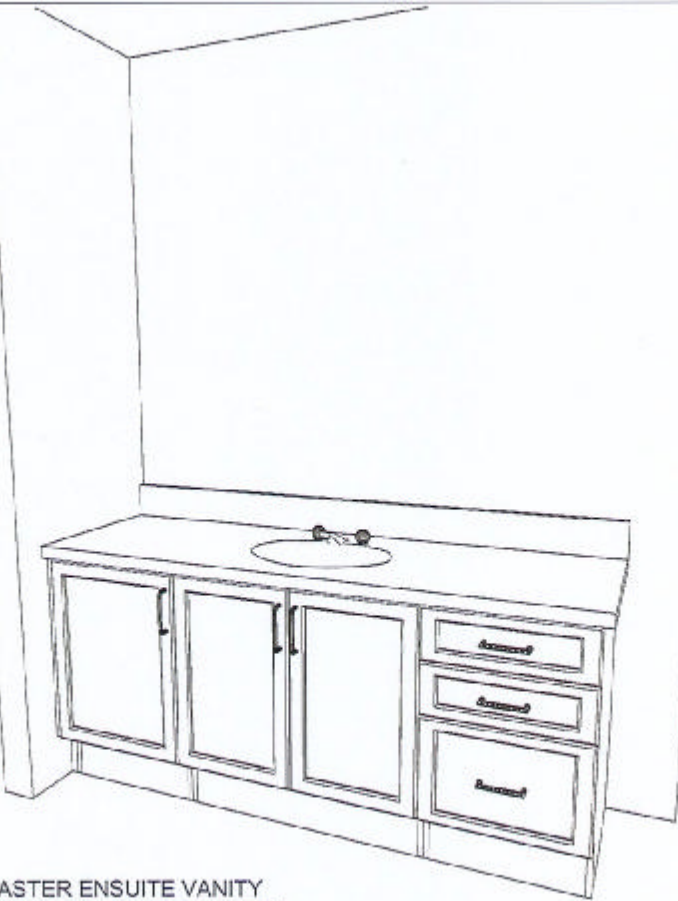

MASTER ENSUITE VANITY

Note: This drawing is an artistic interpretation of the general appearance of the design. It is not meant to be an exact rendition.


Drawn By: Lori D Saverio, B.I.D.
Cartier Kitchens Ottawa
43-4 Winchester.kit



Designed: 17/07/2013
Printed: 27/03/2014

All

Drawing #: 1

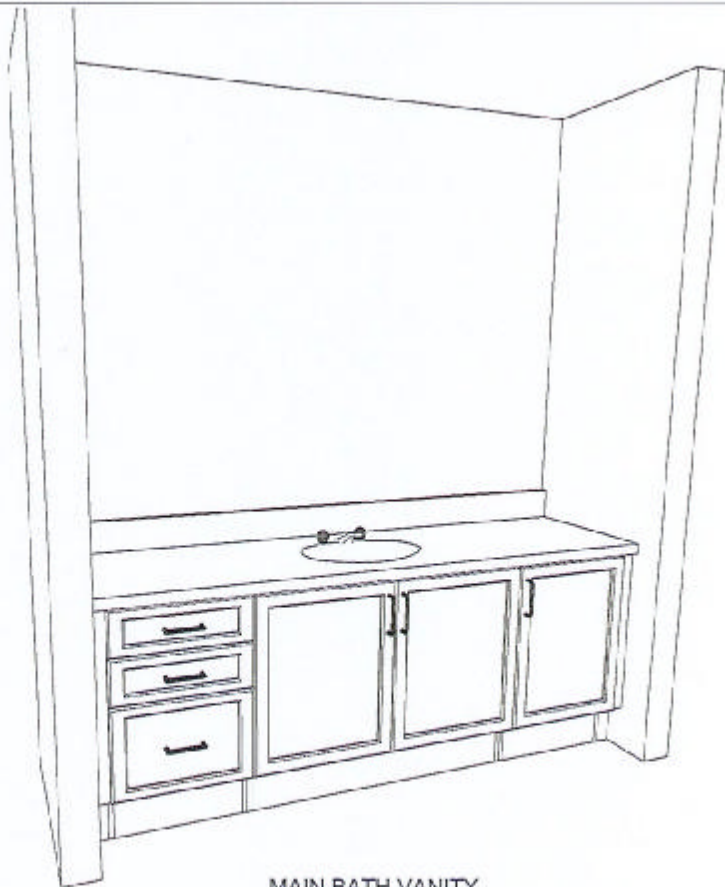

MAIN BATH VANITY

Note: This drawing is an artistic interpretation of the general appearance of the design. It is not meant to be an exact rendition. Drawn By: Lori D Saverio, B.L.D. Cartier Kitchens Ottawa 43-4 Winchester.kit		Designed: 17/07/2013 Printed: 27/03/2014
		All Drawing #: 1



POWDER ROOM VANITY

Note: This drawing is an artistic interpretation of the general appearance of the design. It is not meant to be an exact rendition. Drawn By: Lori D Saverio, B.I.D. Cartier Kitchens Ottawa 43-4 Winchester.kit		Designed: 17/07/2013 Printed: 27/03/2014
		All Drawing #: 1