


DCR PHOENIX HOMES

LOT #3-93
DIAMONDVIEW ESTATES 3
NEWINGTON
CHEF'S KITCHEN
GARAGE RIGHT
MOUNTING HEIGHT: 96

42"H UPPERS @ 18" ABOVE COUNTER
CROWN MOULDING
LIGHT VALANCE

- CABINETS -
HARDWARE -
STANDARD WHITE INTERIOR
METAL DRAWER BOX
4 PCS - 5/8" KICK - FIN. BOTH ENDS
2 PCS - 90 DEG. CORNER MOULD
1 PCS - T-MOULD
5 PCS - FLAT MOULDING

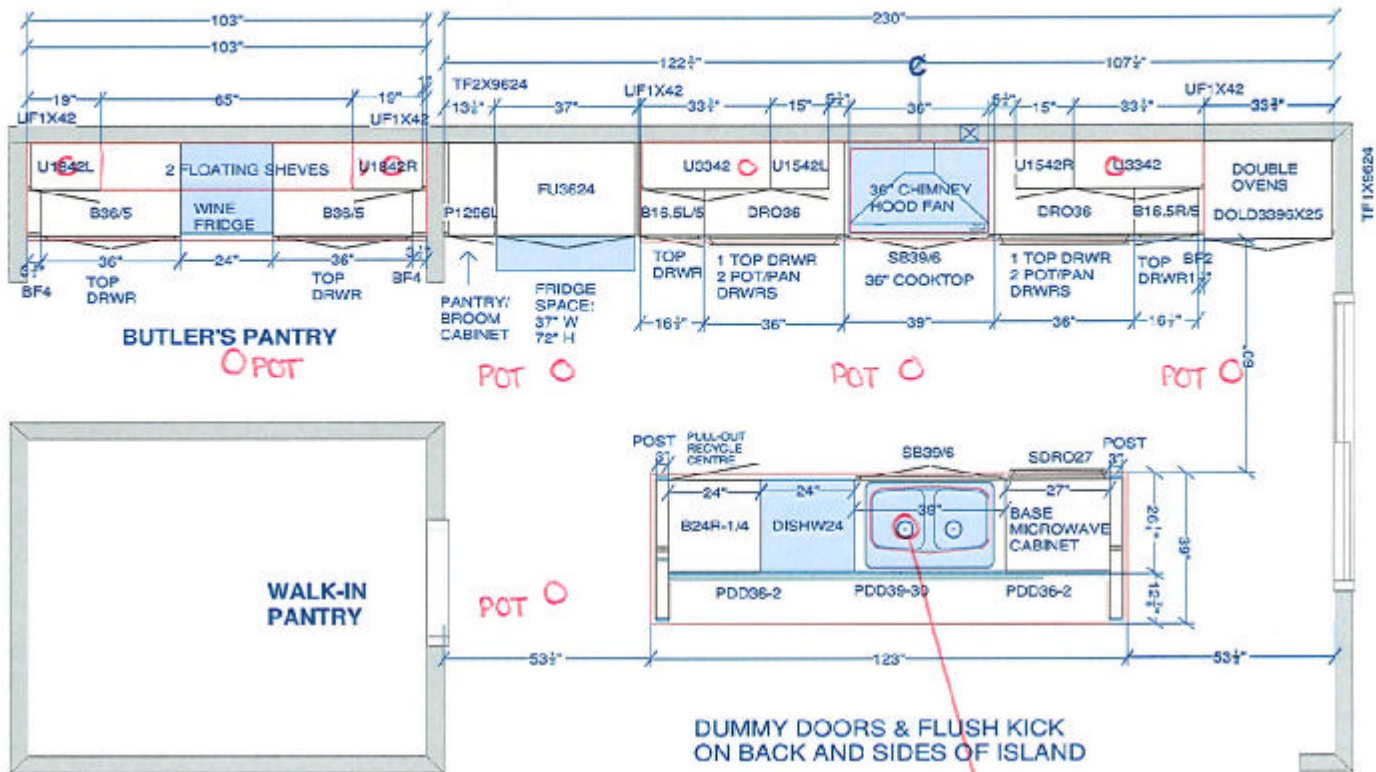

CUSTOMER APPROVAL

I have reviewed these drawings and understand the details of the design and the CARTIER KITCHENS specifications.

Signature: _____


Date: _____


* COLOUR OF CROWN MOULDING TO MATCH CABINET COLOUR BELOW

CAPPED LIGHT CENTERED

All dimensions size designations given are subject to verification on job site and adjustment to fit job conditions.		This is an original design and must not be released or copied unless applicable fee has been paid or job order placed.	Designed: 2022-10-12 Printed: 2022-10-12
DCR #3-93 Diamondview 3 - Newington - Chef's Kitchen.kit			Drawing #: 1 No Scale.

DS
RLB
DS
RPD

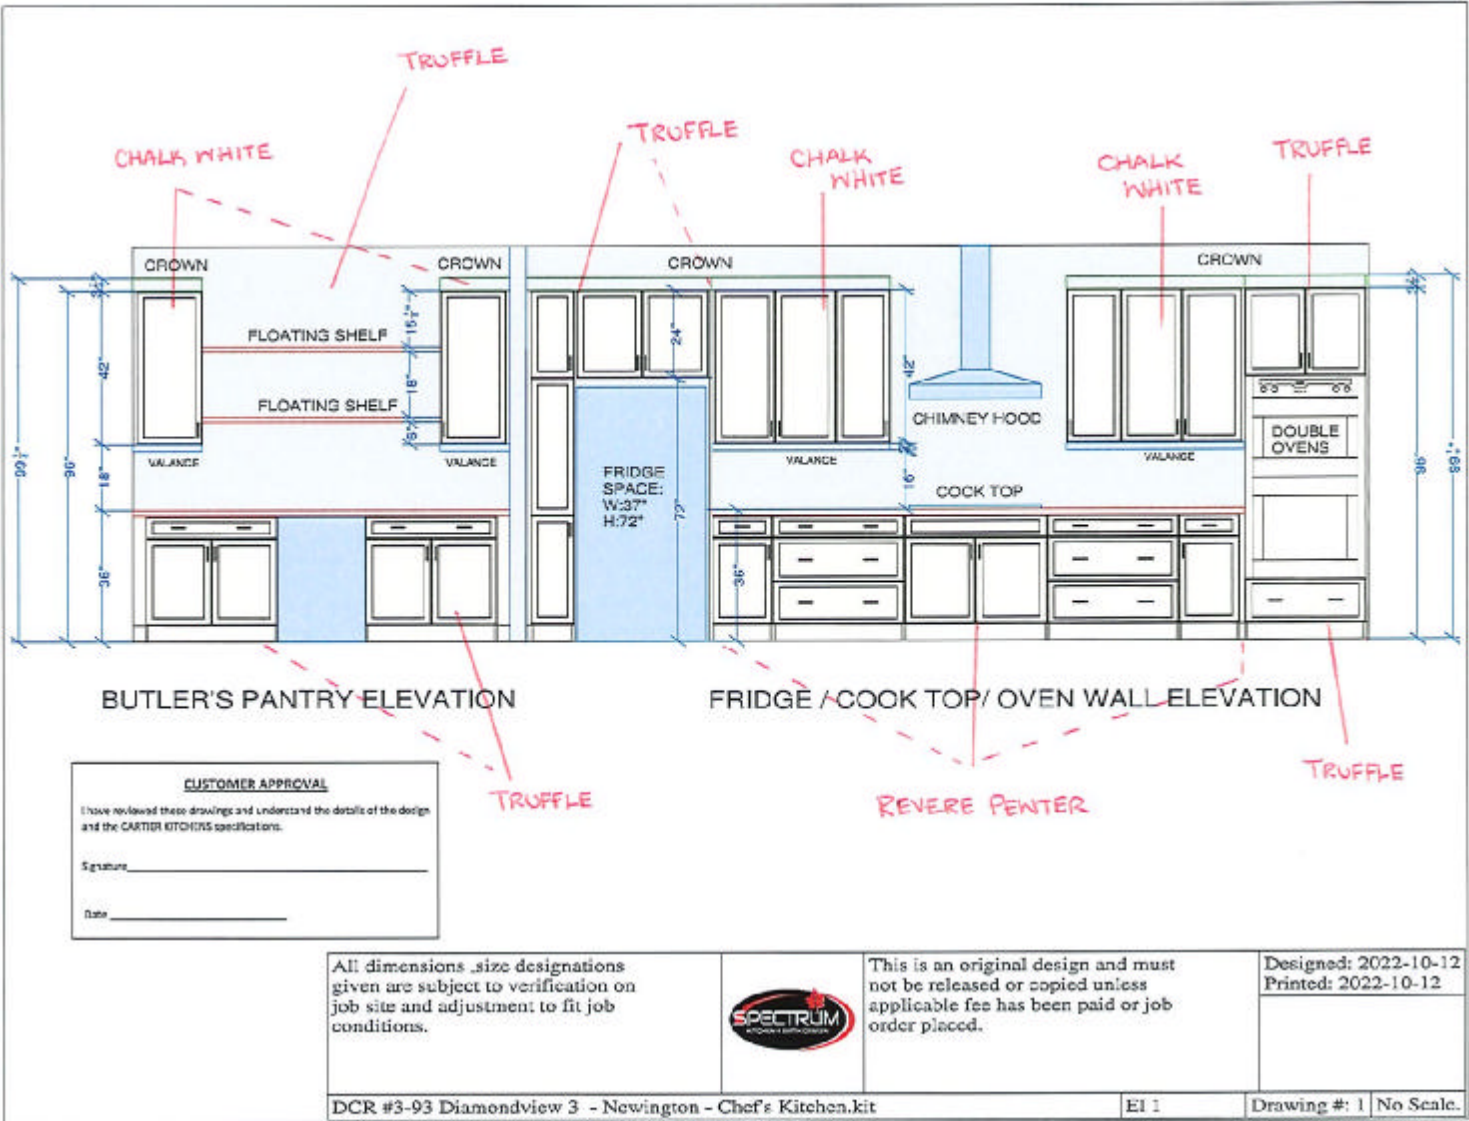

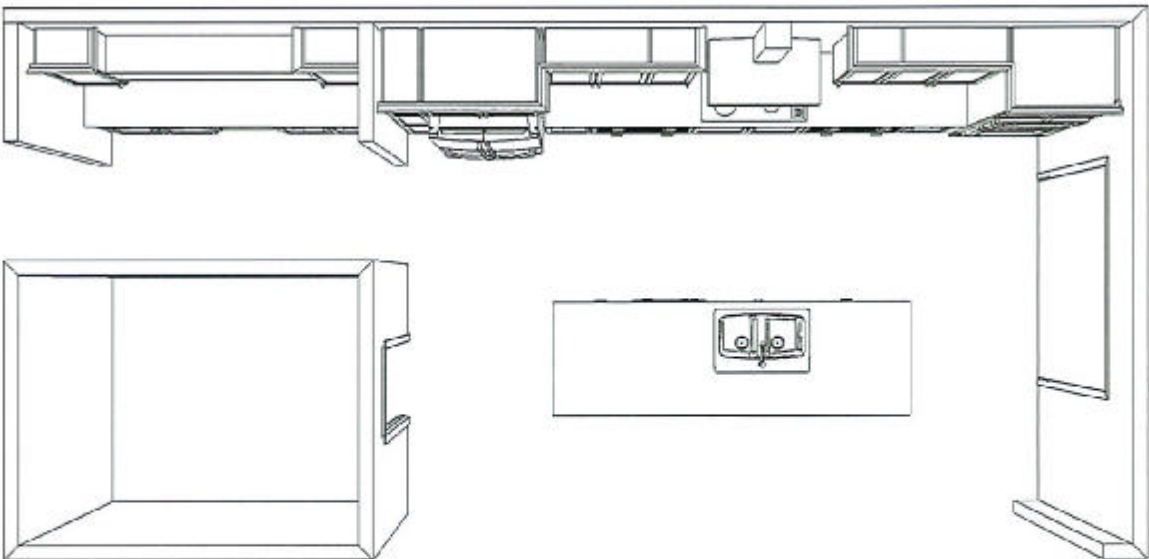

KITCHEN - TOP VIEW

CUSTOMER APPROVAL

I have reviewed these drawings and understand the details of the design and the CARTIER KITCHENS specifications.

Signature_____

Date_____


Note: This drawing is an artistic interpretation of the general appearance of the design. It is not meant to be an exact rendition.		Designed: 2022-10-12
		Printed: 2022-10-12
DCR #3-93 Diamondview 3 - Newington - Chef's	All	Drawing #: 1

DS

RLB

DS

RPD

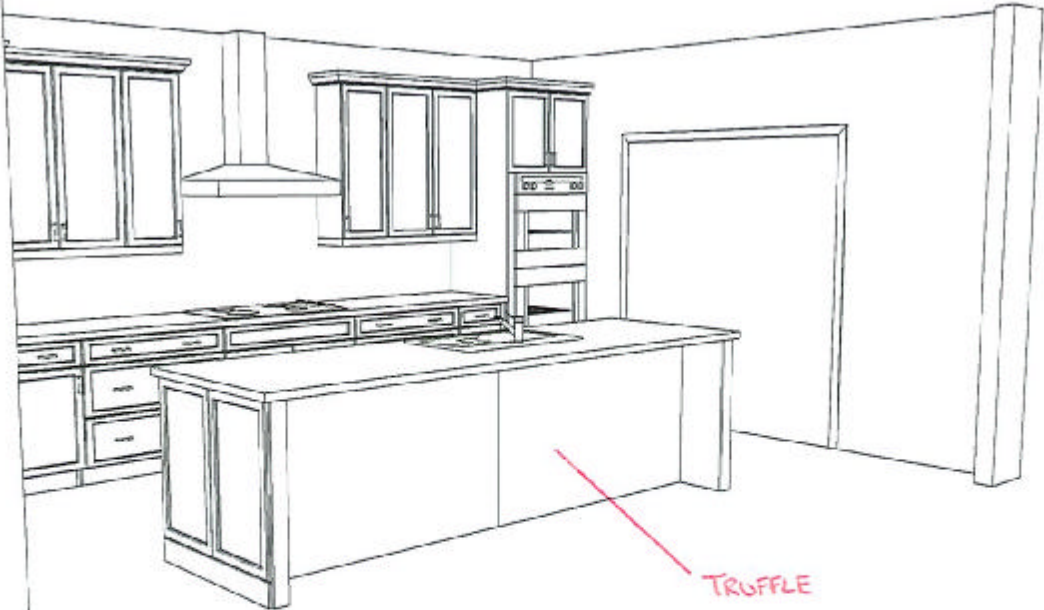

KITCHEN - ISLAND WITH DUMMY DOORS & FLUSH KICK ON SIDES ONLY

CUSTOMER APPROVAL	
I have reviewed these drawings and understand the details of the design and the CARTIER KITCHENS specifications.	
Signature: _____	
Date: _____	

Note: This drawing is an artistic interpretation of the general appearance of the design. It is not meant to be an exact rendition.



Designed: 2022-10-16
Printed: 2022-10-16



KITCHEN - ISLAND WITH DUMMY DOORS & FLUSH KICK ON SIDES ONLY

CUSTOMER APPROVAL

I have reviewed these drawings and understand the details of the design and the CARTIER KITCHENS specifications.

Signature _____

Date _____

Note: This drawing is an artistic interpretation of the general appearance of the design. It is not meant to be an exact rendition.




Designed: 2022-10-16
Printed: 2022-10-16

DCR #3-93 DV 3 - Kitchen - dummy doors side

All


Drawing #: 1

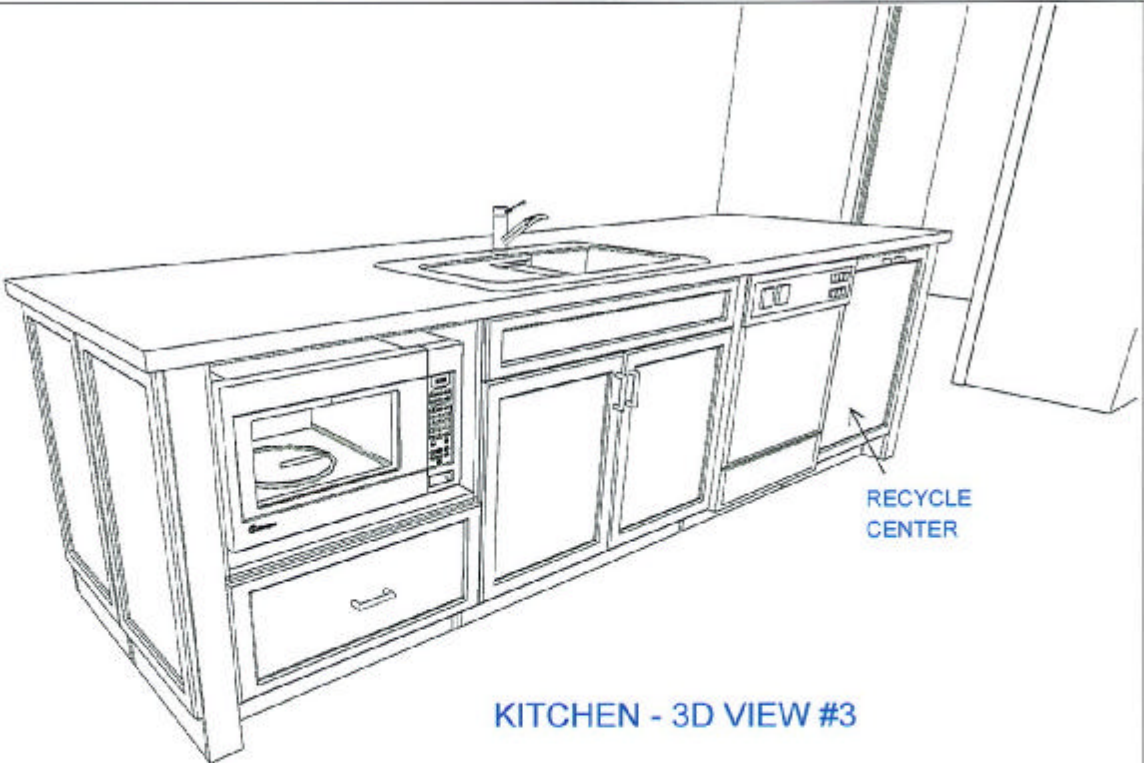

CUSTOMER APPROVAL	
I have reviewed these drawings and understand the details of the design and the CARTIER KITCHENS specifications.	
Signature _____	
Date _____	

Note: This drawing is an artistic interpretation of the general appearance of the design. It is not meant to be an exact rendition.		Designed: 2022-10-11
		Printed: 2022-10-11
DCR #3-93 Diamondview 3 - Newington - Chef's	All	Drawing #: 1

DS RLB	DS RPD
-----------	-----------

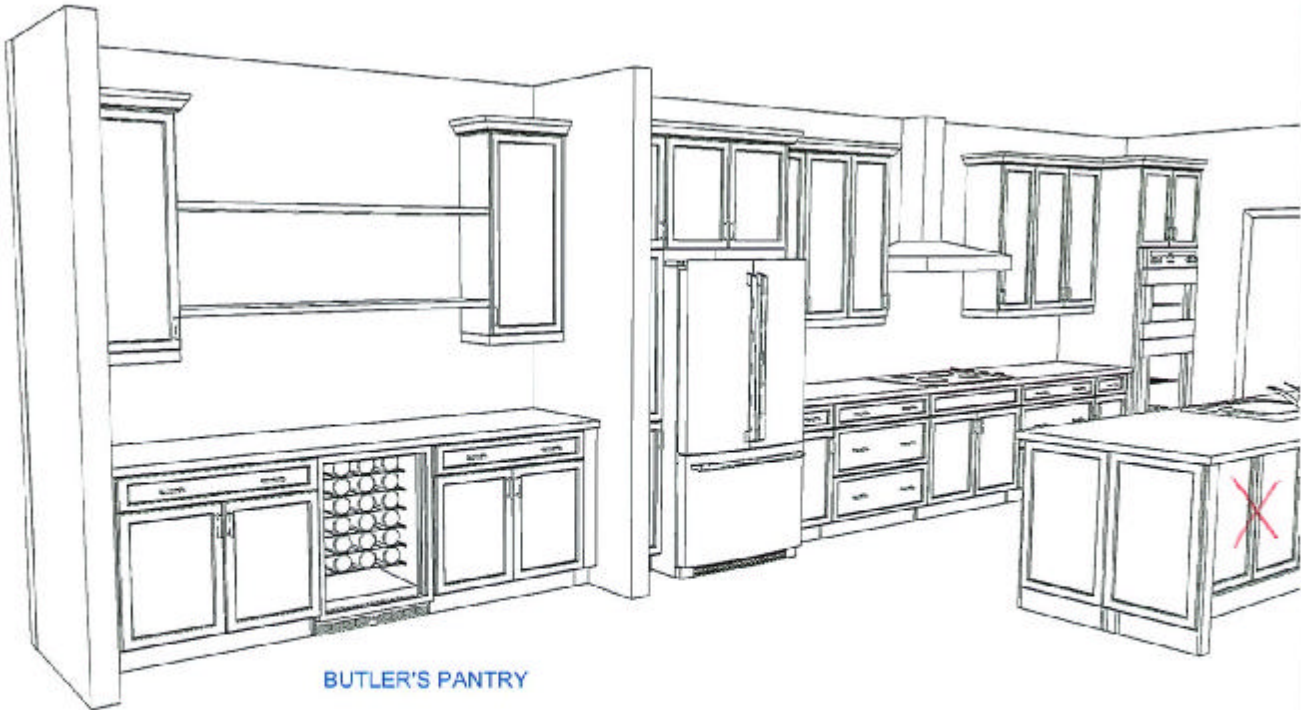

BUTLER'S PANTRY

KITCHEN - 3D VIEW #4

CUSTOMER APPROVAL

I have reviewed these drawings and understand the details of the design and the CARTIER KITCHENS specifications.

Signature _____

Date _____

Note: This drawing is an artistic interpretation of the general appearance of the design. It is not meant to be an exact rendition.		Designed: 2022-10-12
		Printed: 2022-10-12
DCR #3-93 Diamondview 3 - Newington - Chef's		Drawing #: 1

DS

RLB

DS

RPD