


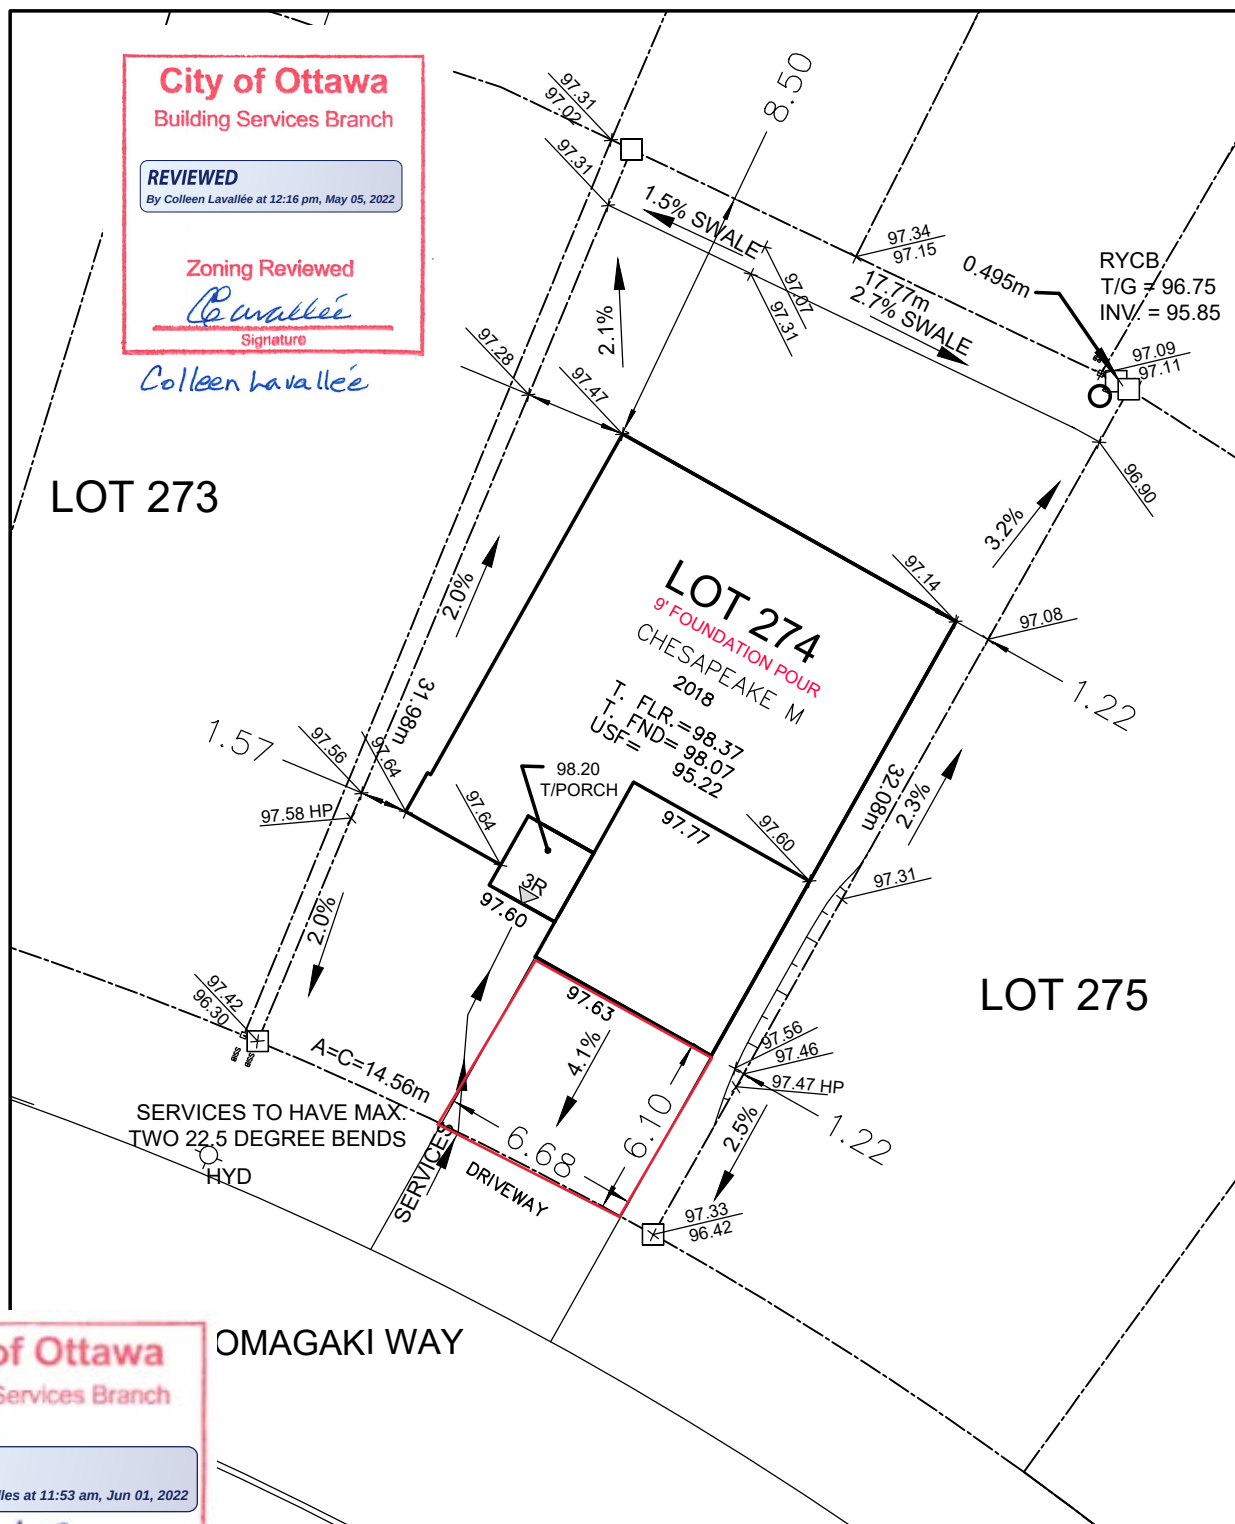

PLANS TO BE READ WITH MASTER FOOTPRINT

City of Ottawa
Building Services Branch

REVIEWED

By Bia Pinheiro Salles at 11:53 am, Jun 01, 2022

Building Code Reviewed

Signature

Owner/Applicant

DCR/PHOENIX HOMES

Telephone # 723-9227

Plan # 4M- 1618

```
Project name:PATHWAYS
```

Civic Address: 910 OMAGAKI WA



LOT
274

SITE/GRADING PLAN

PATHWAYS PHASE 2

INDIVIDUAL LOT GRADING REVIEW SUMMARY FOR SITED HOUSE AS COMPARED WITH OVERALL SUBDIVISION PLAN

Bldg. Ht. _____m

Lot coverage_____%

Scale 1:250

Sod Area _____ m²

Asphalt Area _____ m²

NOTE: THIS PLAN IS NOT A SURVEY PLAN OR SUBDIVISION
PLAN WITHIN THE MEANING OF PLANNING ACT.

CHECKED/APPROVED BY: T.L.MAK ENG.