



DCR PHOENIX HOMES

MODEL - ANNAPOLIS (509)
VANITIES


LINE - 1 & 2
HARDWARE - STD & 1ST UPGRADE
STANDARD WHITE INTERIOR
METAL DRAWER BOX
5/8" TOE KICK

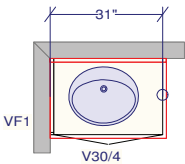


~~POWDER~~
Bedroom 5 Ensuite

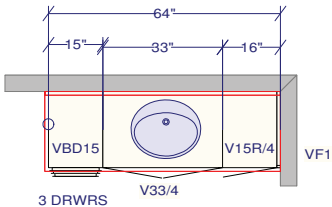



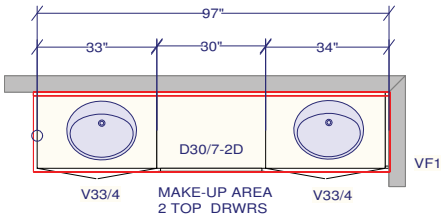

ENSUITE #2

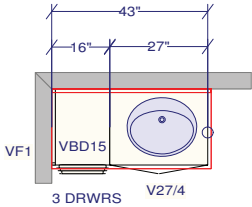


MASTER ENSUITE



SHARED BATH
BDRM 3 & 4

All dimensions ,size designations given are subject to verification on job site and adjustment to fit job conditions.		This is an original design and must not be released or copied unless applicable fee has been paid or job order placed.	Designed: 2014-03-24 Printed: 2014-06-16		
				 	
			509 Annapolis Van.kit		
		All	Drawing #:	1	No Scale.

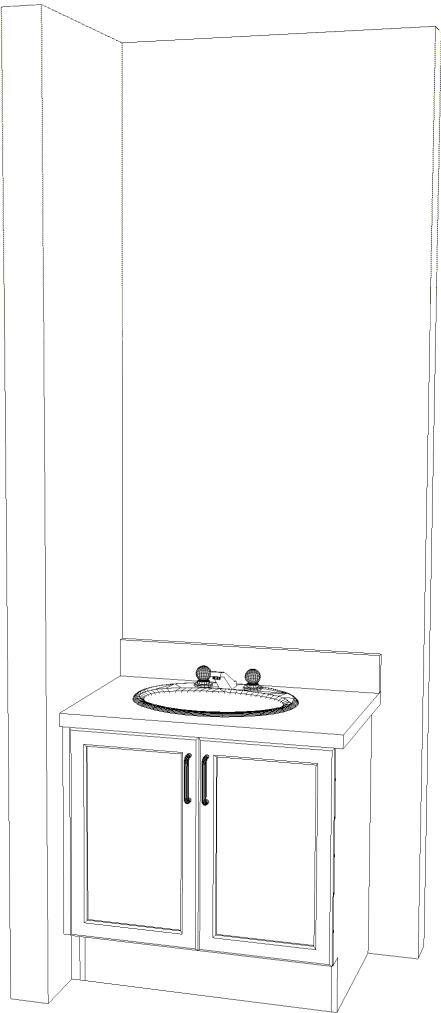

Bedroom 5 Ensuite

~~POWDER~~
509 ANNAPOLIS

Note: This drawing is an artistic interpretation of the general appearance of the design. It is not meant to be an exact rendition.		Designed: 2014-03-24 Printed: 2014-06-16	
			
509 Annapolis Van.kit	All	Drawing #: 1	



SECOND ENSUITE
509 ANNAPOLIS

Note: This drawing is an artistic interpretation of the general appearance of the design. It is not meant to be an exact rendition.

2020
TECHNOLOGIES

DS

ker


Designed: 2014-03-24
Printed: 2014-06-16

DS

HR


DS

AR

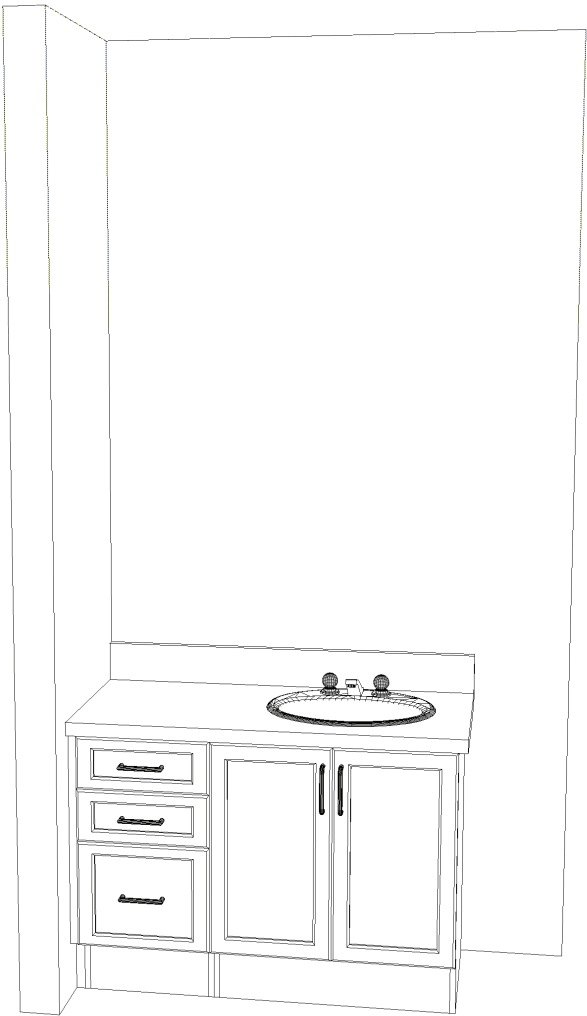

SHARED BATHROOM
509 ANNAPOLIS

Note: This drawing is an artistic interpretation of the general appearance of the design. It is not meant to be an exact rendition.		Designed: 2014-03-24	
		Printed: 2014-06-16	
509 Annapolis Van.kit			
		All	Drawing #: 1

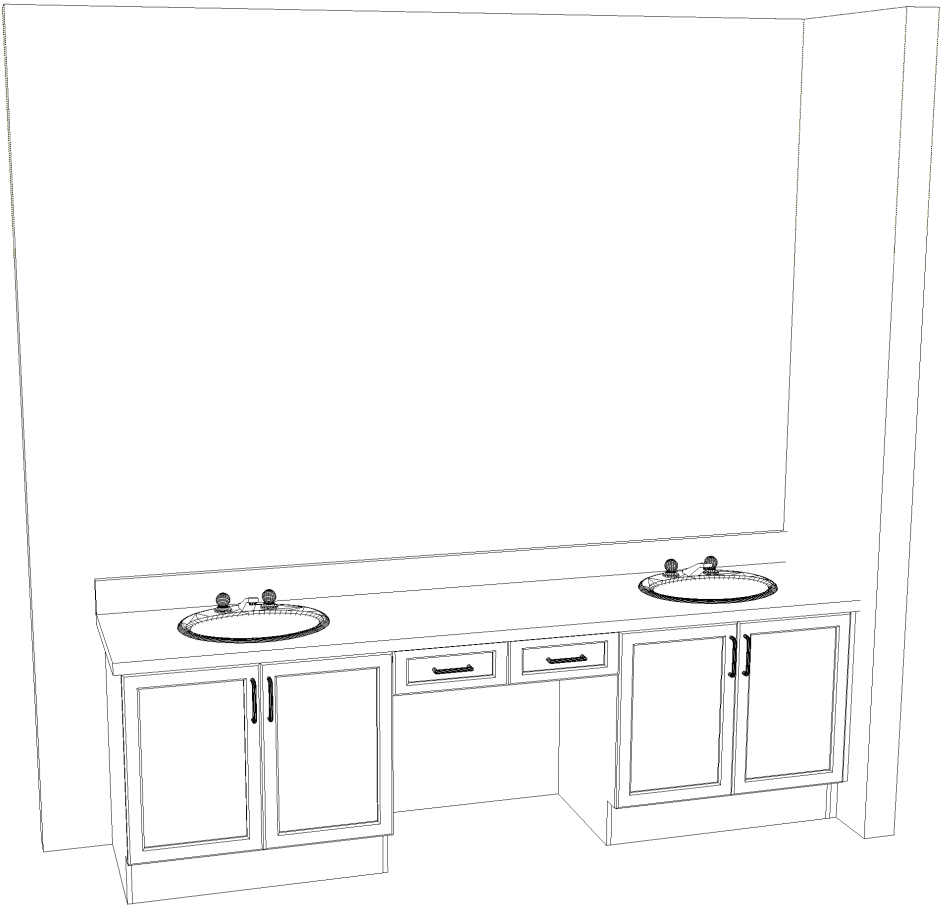

ENSUITE
509 ANNAPOLIS

Note: This drawing is an artistic interpretation of the general appearance of the design. It is not meant to be an exact rendition.		Designed: 2014-03-24	
		Printed: 2014-06-16	
509 Annapolis Van.kit			
		All	Drawing #: 1