

DCR PHOENIX HOMES

MODEL - RUTHERFORD (517)

ALTERNATE KITCHEN

MOUNTING HEIGHT - 84

LINE-

HARDWARE -

STANDARD WHITE INTERIOR

METAL DRAWER BOX


4 PCS - 5/8" KICK - FIN. BOTH ENDS

2 PCS - LOOSE FILLER - 6 x 96

1 PCS - 90 DEG. CORNER MOULD

1 PCS - T-MOULD

5 PCS - FLAT MOULD

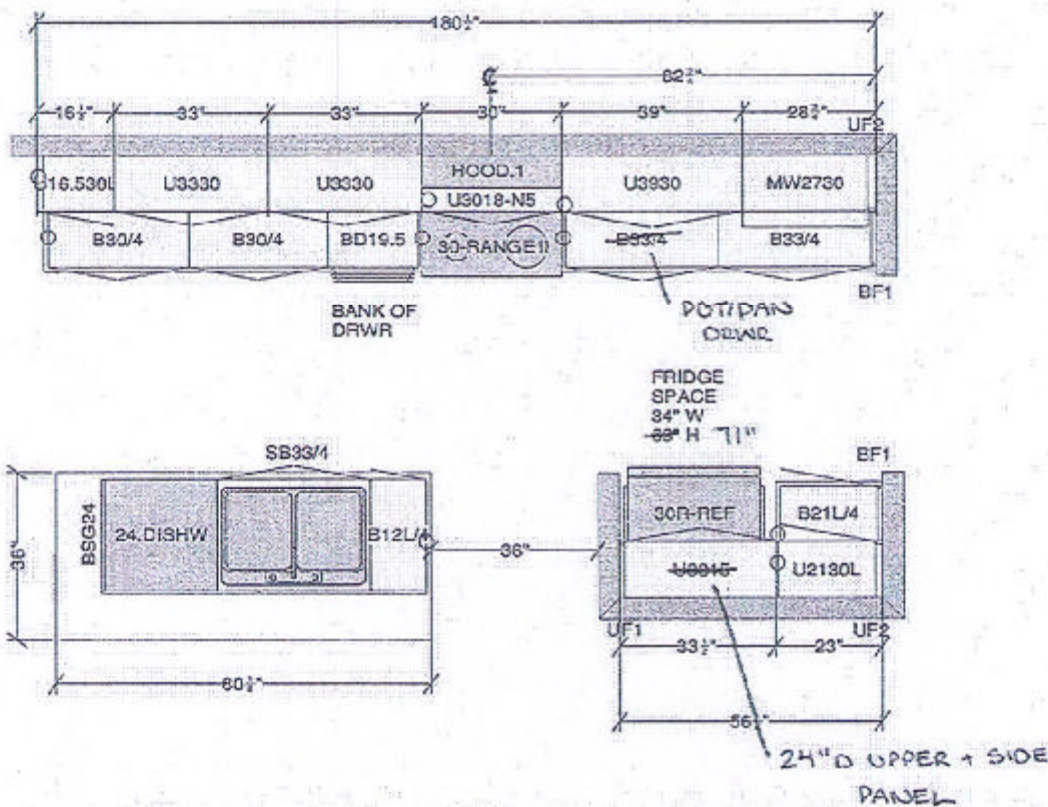

*ND *9L + JS

All dimensions, size designations given are subject to verification on job site and adjustment to fit job conditions.




Spectrum Kitchen Bath Design
430 Hazeldenn Rd. Unit 2
P:613-521-6966
F:613-521-1617
Drawn by: Miriam

Designed: 4/19/2016
Printed: 4/19/2016

517 Rutherford ALT

All

Drawing #: 1 No Scale

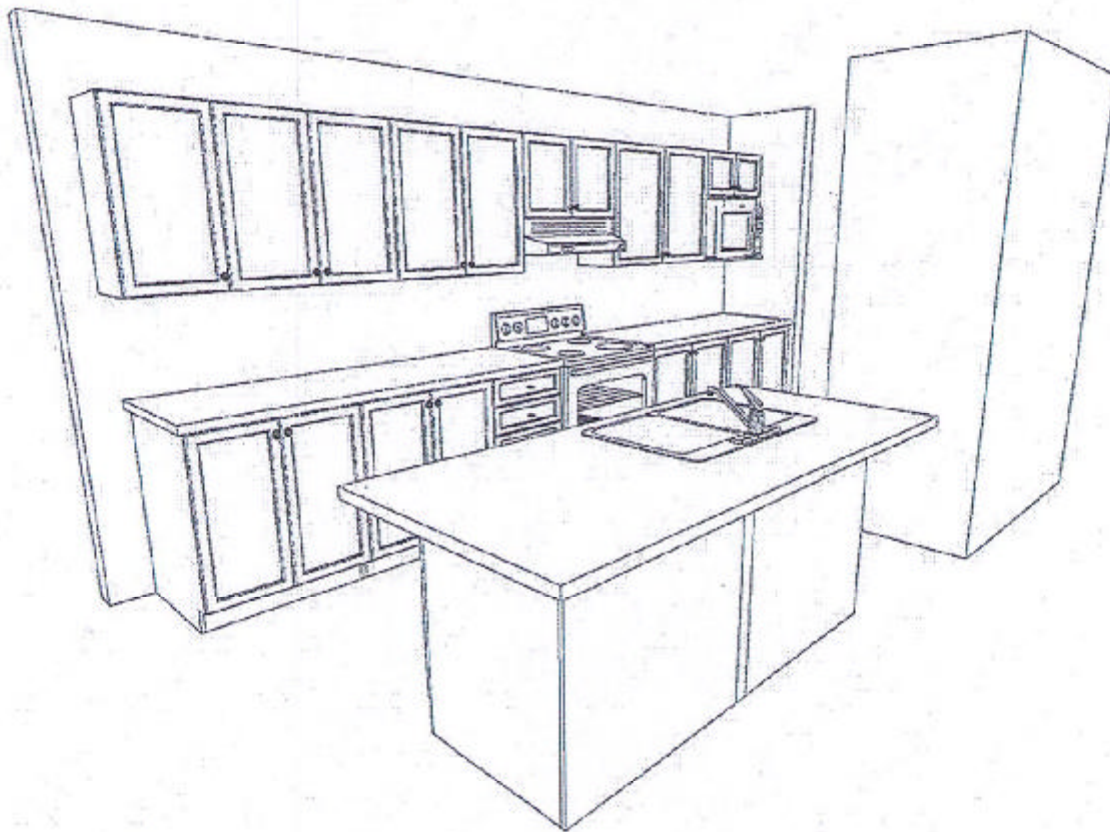

DCR PHOENIX 517 RUTHERFORD ALT
3D KITCHEN VIEW #1

Note: This drawing is an artistic interpretation of the general appearance of the design. It is not meant to be an exact rendition.

2020
TECHNOLOGIES




Designed: 4/19/2016
Printed: 4/19/2016

517 Rutherford ALT

Alt

Drawing #: 1

* NO * 9E * JS

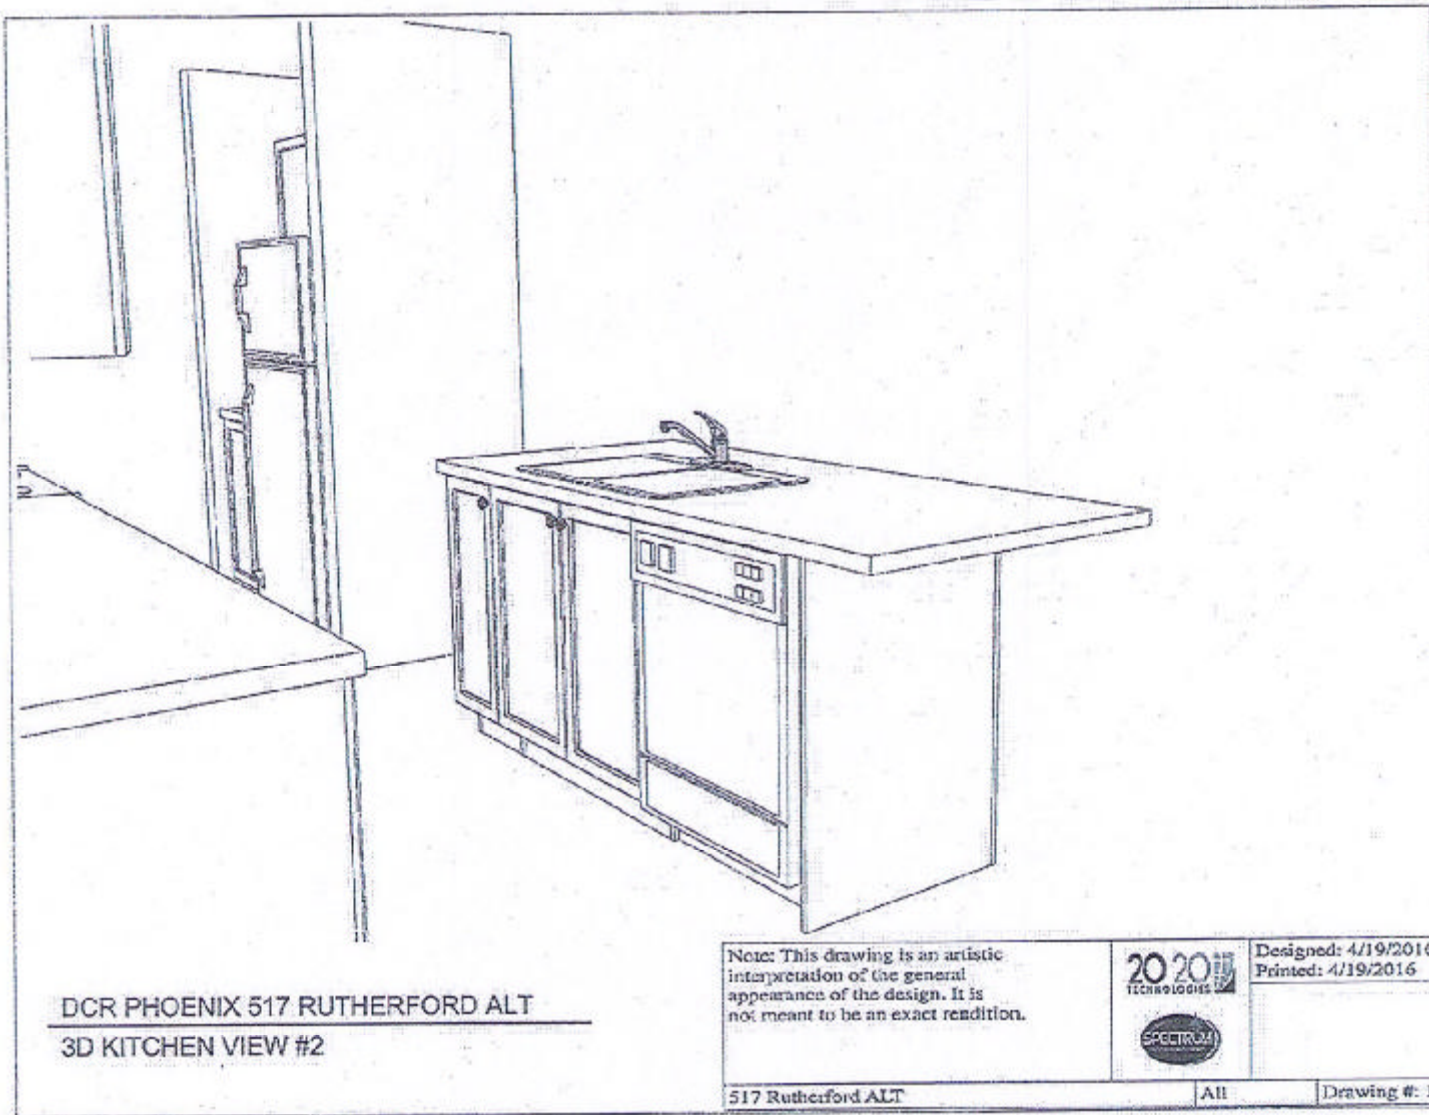

DCR PHOENIX 517 RUTHERFORD ALT
3D KITCHEN VIEW #2

Note: This drawing is an artistic interpretation of the general appearance of the design. It is not meant to be an exact rendition.

2020
TECHNOLOGIES




Designed: 4/19/2016
Printed: 4/19/2016

517 Rutherford ALT

All

Drawing #: 1

+ ND * 4E * IS

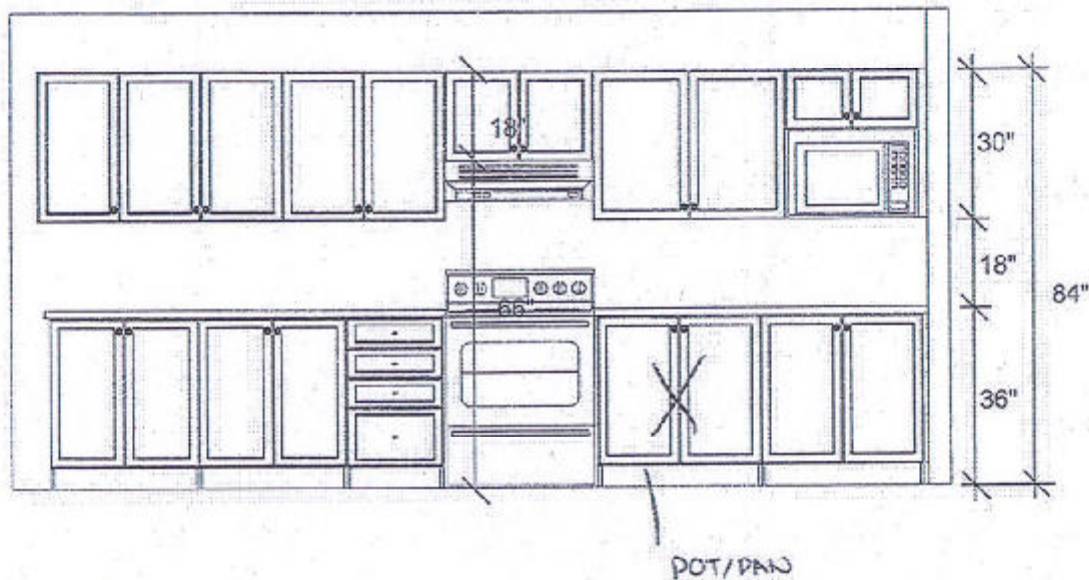

DCR PHOENIX 517 RUTHERFORD ALT
STOVE WALL ELEVATION

Note: This drawing is an artistic interpretation of the general appearance of the design. It is not meant to be an exact rendition.

2020
Technologies

Designed: 4/19/2016
Printed: 4/19/2016




517 Rutherford ALT

All

Drawing #: 1

*ND *GL T IS

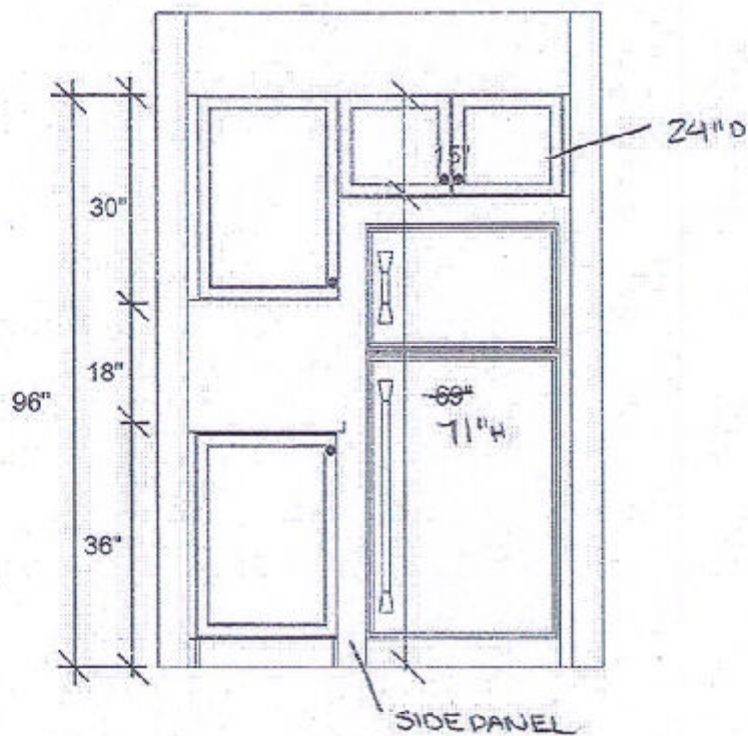

DCR PHOENIX 517 RUTHERFORD ALT
FRIDGE WALL ELEVATION

Note: This drawing is an artistic interpretation of the general appearance of the design. It is not meant to be an exact readidion.

2020
TECHNOLOGIES

Designed: 4/19/2016
Printed: 4/19/2016


SPECTRA

517 Rutherford ALT

Alt

Drawing #: 1

* NO * 96 * 15

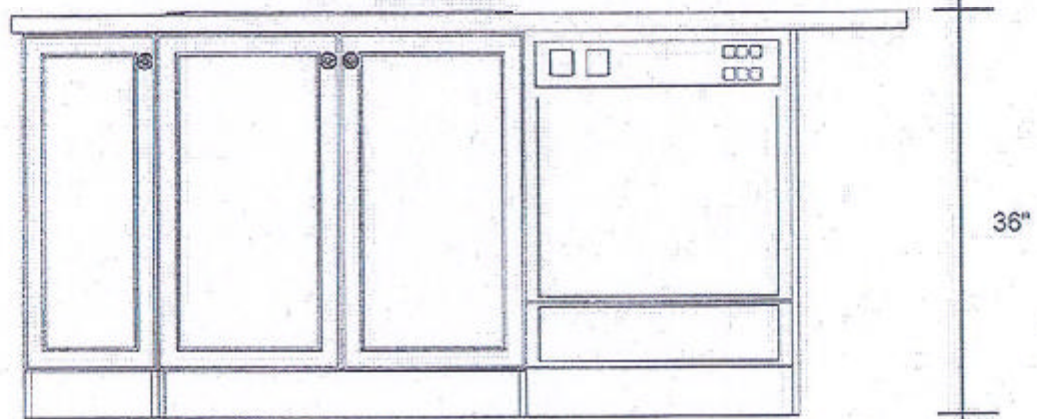

DCR PHOENIX 517 RUTHERFORD ALT
ISLAND ELEVATION

Note: This drawing is an artistic interpretation of the general appearance of the design. It is not meant to be an exact rendition.

2020
TECHNOLOGIES



Designed: 4/19/2016
Printed: 4/19/2016

517 Rutherford ALT

Alt

Drawing #: 1

*ND *9K *IS