

REVISED: JUNE 2-23

LOT #3-154  
WHITE TAIL RIDGE 3  
CHESAPEAKE (508) Left

KITCHEN

MOUNTING HT: ~~84~~ 86"

30"H UPPERS @ 20" ABOVE COUNTER

LIGHT VALANCE

CABINETS -

HARDWARE -

STD WHITE INTERIORS


METAL DRWR BOX

3 PCS - 5/8" KICK

4 PCS - FLAT SHOE MOULDING

2 PCS - C MOULD

1 PC - T MOULD

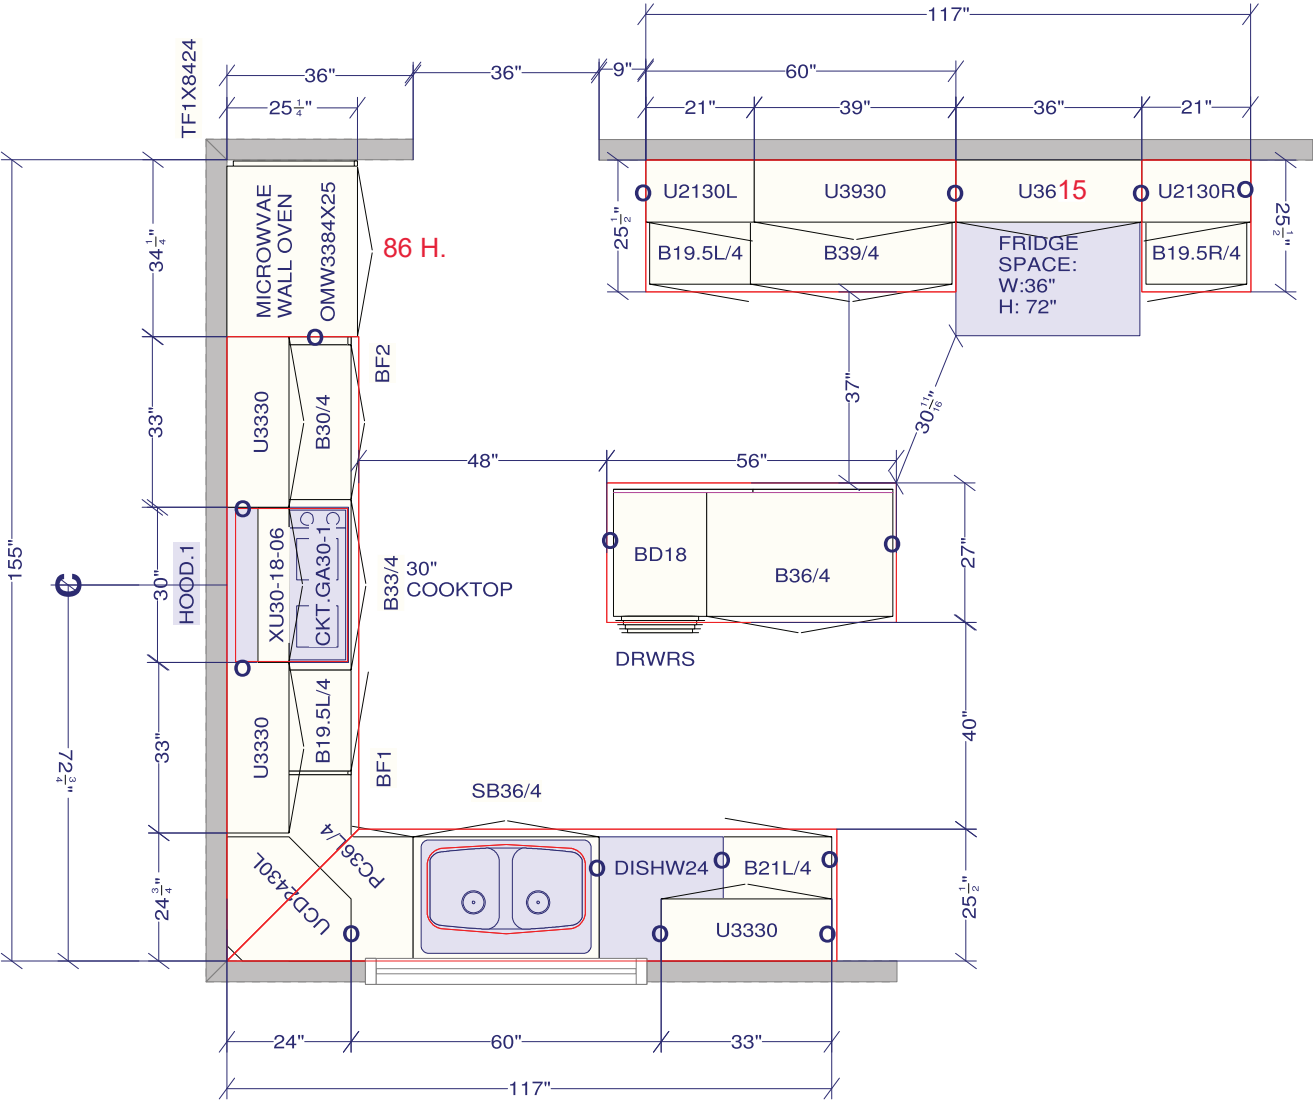

CUSTOMER APPROVAL

I have reviewed these drawings and understand the details of the design and the CARTIER KITCHENS specifications.

Signature \_\_\_\_\_

Date \_\_\_\_\_


All dimensions \_size designations given are subject to verification on job site and adjustment to fit job conditions.



This is an original design and must not be released or copied unless applicable fee has been paid or job order placed.

Designed: 2022-04-26  
Printed: 2022-04-27



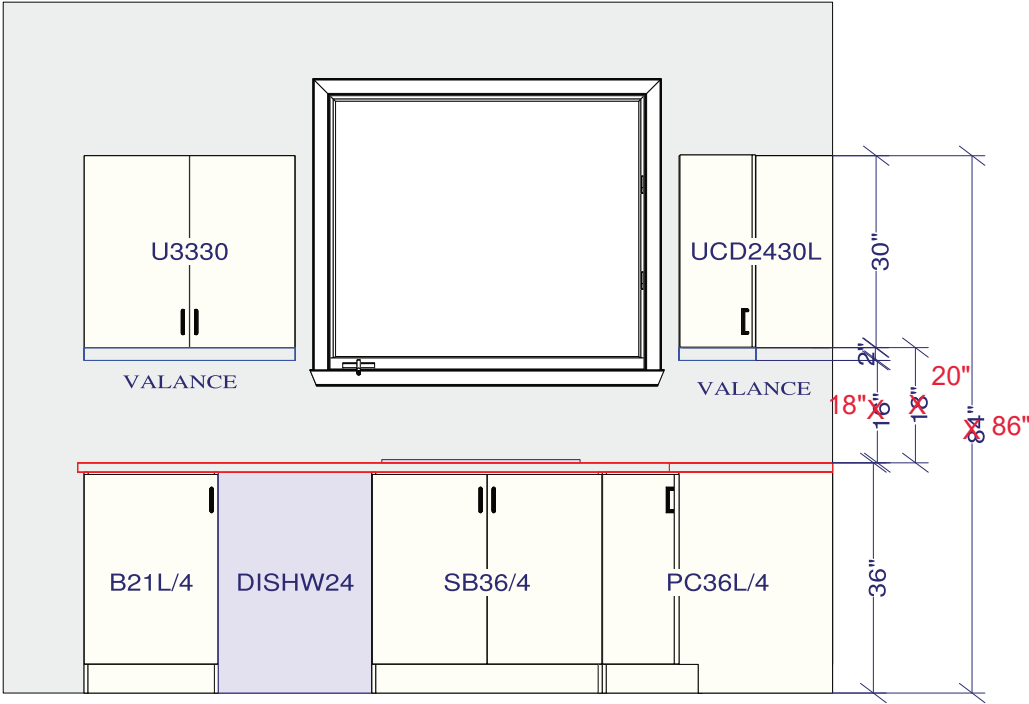

**CUSTOMER APPROVAL**

I have reviewed these drawings and understand the details of the design and the CARTIER KITCHENS specifications.

Signature \_\_\_\_\_

Date \_\_\_\_\_

**SINK WALL ELEVATION**

**REVISED: JUNE 2-23**


All dimensions \_size designations given are subject to verification on job site and adjustment to fit job conditions.



This is an original design and must not be released or copied unless applicable fee has been paid or job order placed.

Designed: 2022-04-26  
Printed: 2022-04-27

DS MJK DS JK

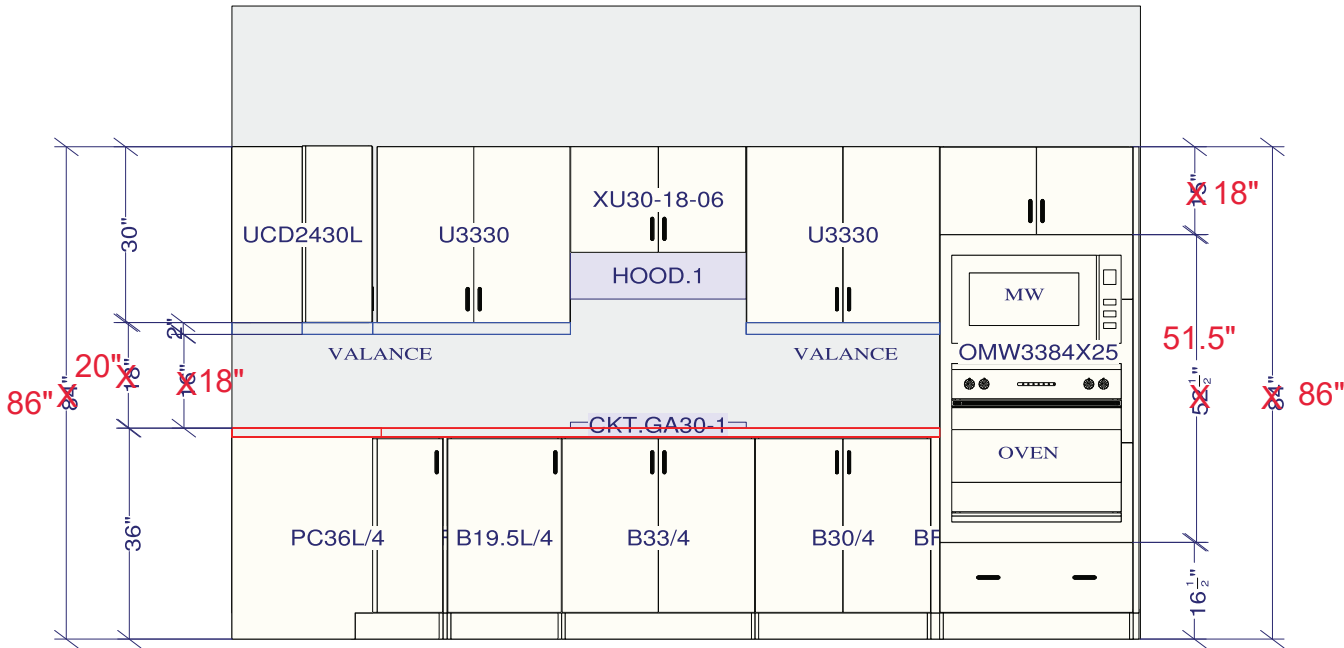

# COOKTOP / OVEN WALL ELEVATION

REVISED: JUNE 2- 23

**CUSTOMER APPROVAL**

I have reviewed these drawings and understand the details of the design and the CARTIER KITCHENS specifications.

Signature \_\_\_\_\_

Date \_\_\_\_\_


All dimensions \_size designations given are subject to verification on job site and adjustment to fit job conditions.



This is an original design and must not be released or copied unless applicable fee has been paid or job order placed.

Designed: 2022-04-26  
Printed: 2022-04-27

DS  
MJE  
DS  
gk

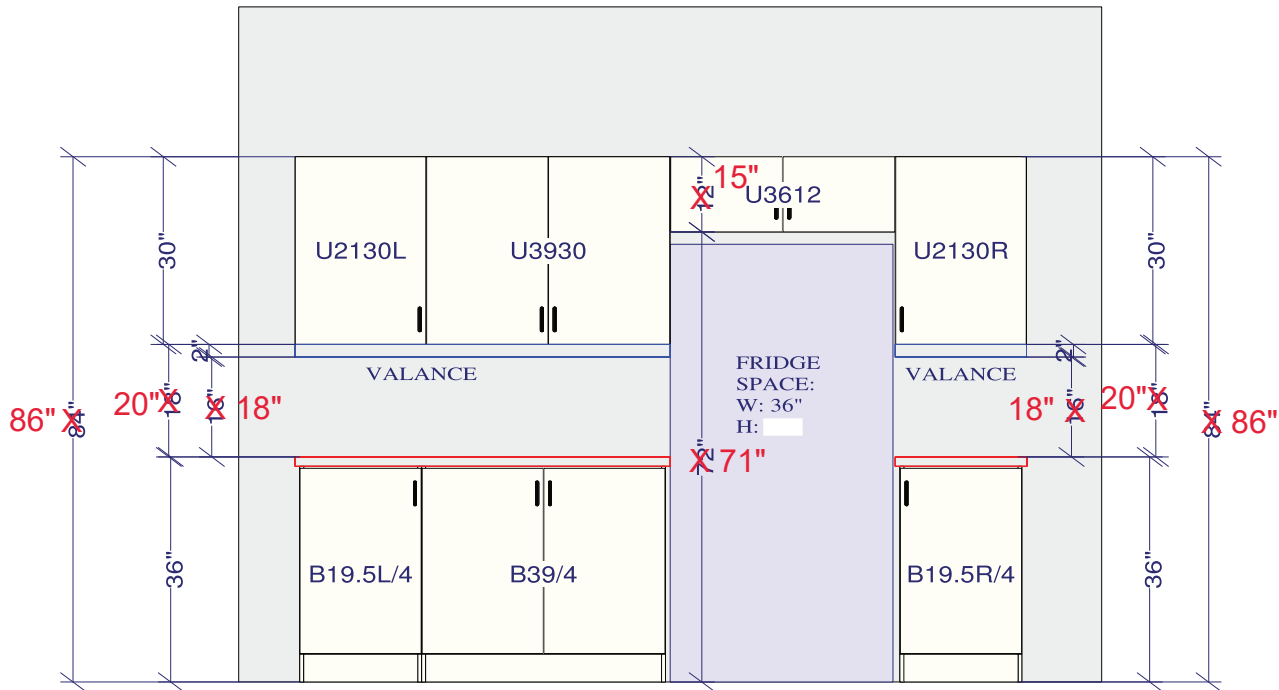

**CUSTOMER APPROVAL**

I have reviewed these drawings and understand the details of the design and the CARTIER KITCHENS specifications.

Signature \_\_\_\_\_

Date \_\_\_\_\_

**FRIDGE WALL ELEVATION**

**REVISED: JUNE 2-23**

All dimensions ,size designations given are subject to verification on job site and adjustment to fit job conditions.



This is an original design and must not be released or copied unless applicable fee has been paid or job order placed.

Designed: 2022-04-26  
Printed: 2022-04-27


DS  
MJE  
DS  
gk

DCR - #154 WTR3 - 508 CHESAPEAKE - KITCHEN (Left).kit

EI 1

Drawing #: 1

No Scale.

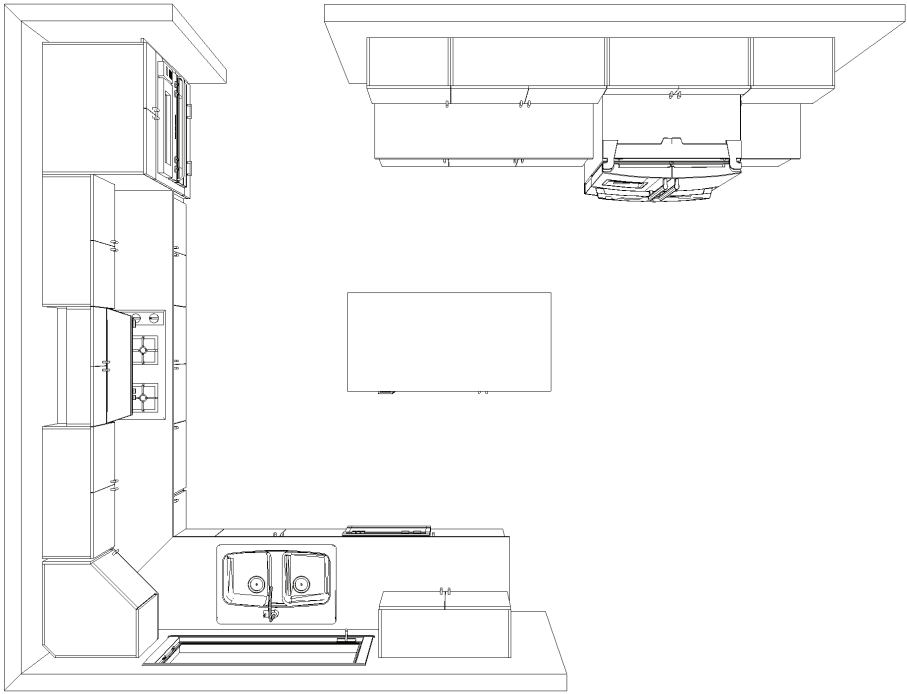

KITCHEN -TOP VIEW


CUSTOMER APPROVAL

I have reviewed these drawings and understand the details of the design and the CARTIER KITCHENS specifications.


Signature \_\_\_\_\_


Date \_\_\_\_\_


Note: This drawing is an artistic interpretation of the general appearance of the design. It is not meant to be an exact rendition.



Designed: 2022-04-26  
Printed: 2022-04-27

DS  


DS  

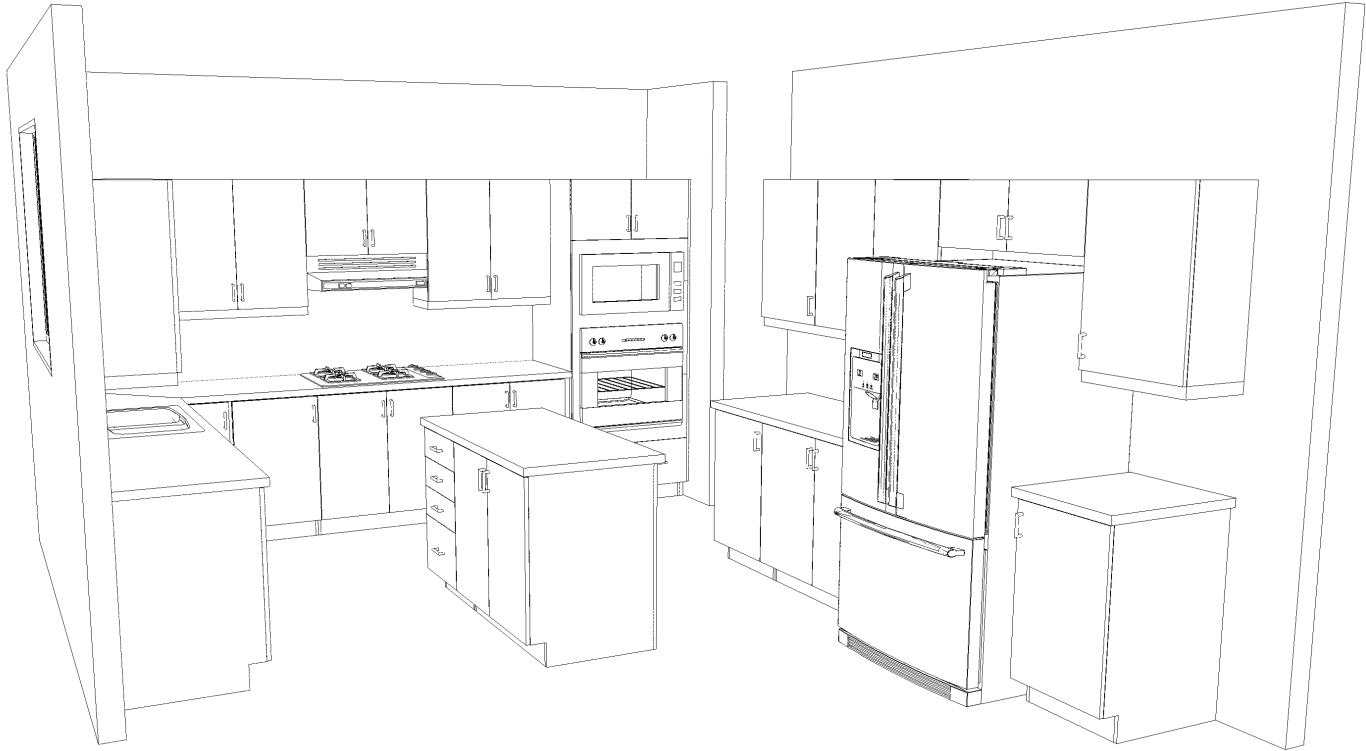


KITCHEN - 3D VIEW #1

**CUSTOMER APPROVAL**

I have reviewed these drawings and understand the details of the design and the CARTIER KITCHENS specifications.

Signature \_\_\_\_\_

Date \_\_\_\_\_

Note: This drawing is an artistic interpretation of the general appearance of the design. It is not meant to be an exact rendition.



Designed: 2022-04-26  
Printed: 2022-04-27

DS  
MJK  
DS  
JK



KITCHEN - 3D VIEW #2


**CUSTOMER APPROVAL**

I have reviewed these drawings and understand the details of the design and the CARTIER KITCHENS specifications.

Signature \_\_\_\_\_

Date \_\_\_\_\_

Note: This drawing is an artistic interpretation of the general appearance of the design. It is not meant to be an exact rendition.

	Designed: 2022-04-26 Printed: 2022-04-27	
	