


City of Ottawa
Building Services Branch

REVIEWED
By D. Bordage at 10:19 am, Sep 23, 2022

Building Code Reviewed

[Signature]
Signature

D. BORDAGE

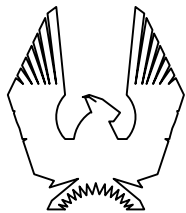

279


2	DIMS & NOTES SHOWING 10" RUNS	20/07/22	CB
1	FIN. BSMT/2ND FLOOR LAUNDRY/9' 2ND FLOOR	12/07/22	CB
No.	Description	dd/mm/yy	By
REVISIONS			

footprint:	512
drawn by:	1V
date:	JULY 2007
scale:	3/16"=1'-0"


sheet no:

$$\frac{1}{4}$$

2 scale: $3/16" = 1' - 0"$

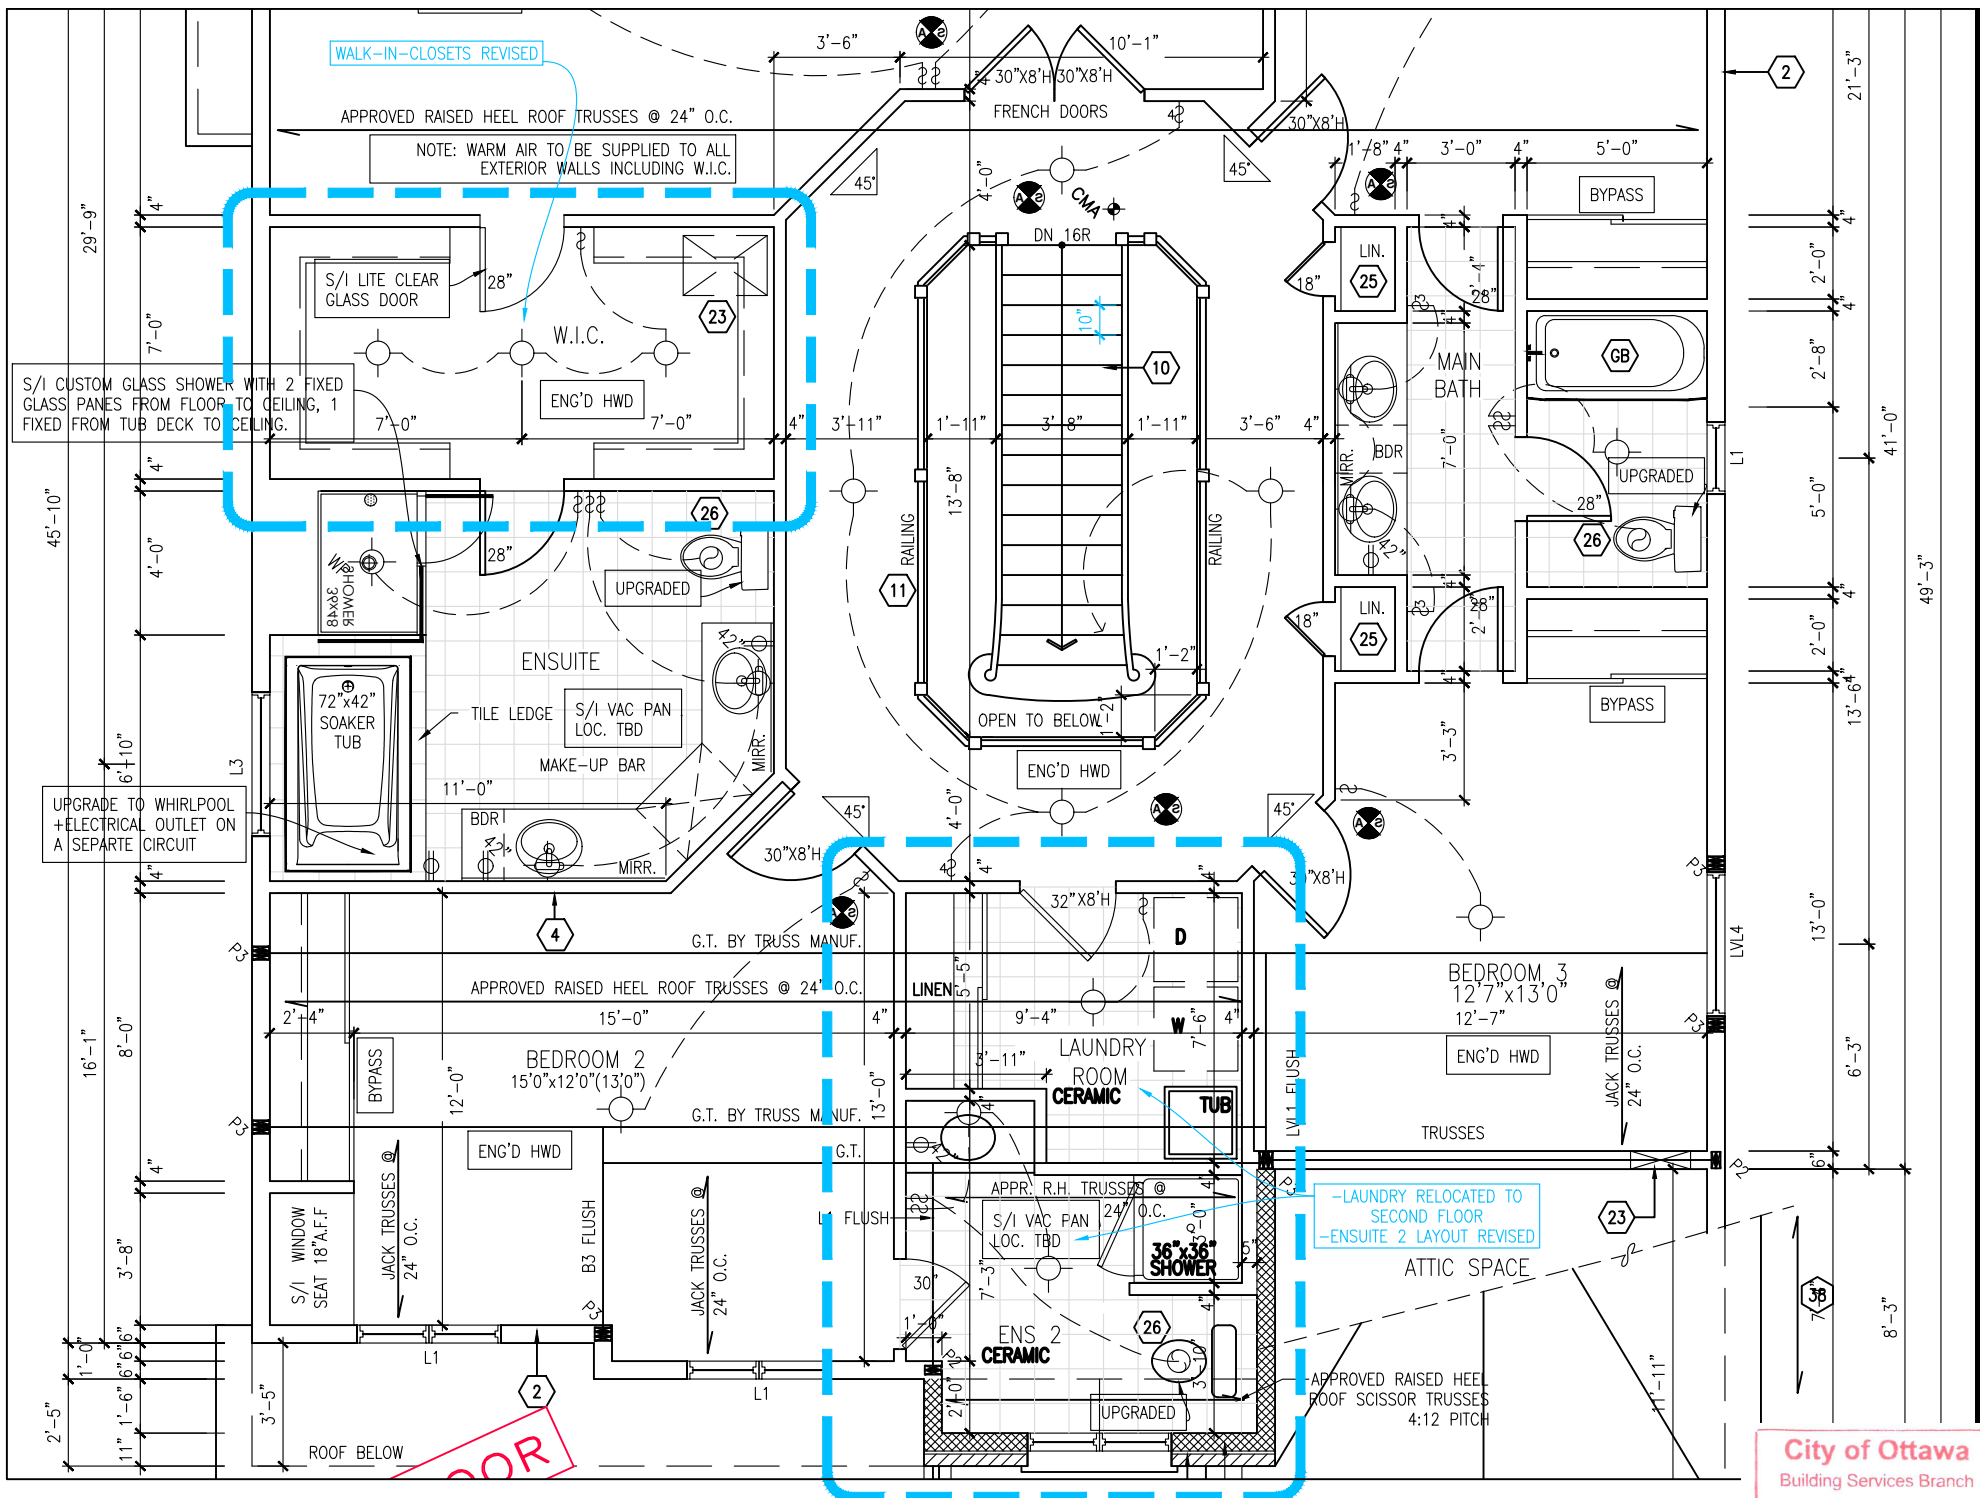

2 scale: $3/16" = 1'-0"$

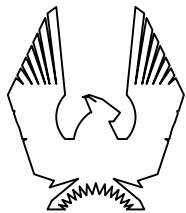

PHOENIX HOMES

SITE: PATHWAYS

LOT NUMBER:

CIVIC ADDRESS:
658 MIIKANA ROAD


279

2		XX/XX/XX	CB
1	FIN. BSMT/2ND FLOOR LAUNDRY/9' 2ND FLOOR	12/07/22	CB
No.	Description	dd/mm/yy	By
REVISIONS			

footprint:	512
drawn by:	1V
date:	JULY 2007
scale:	3/16"=1'-0"

sheet no:

$$\frac{2}{4}$$

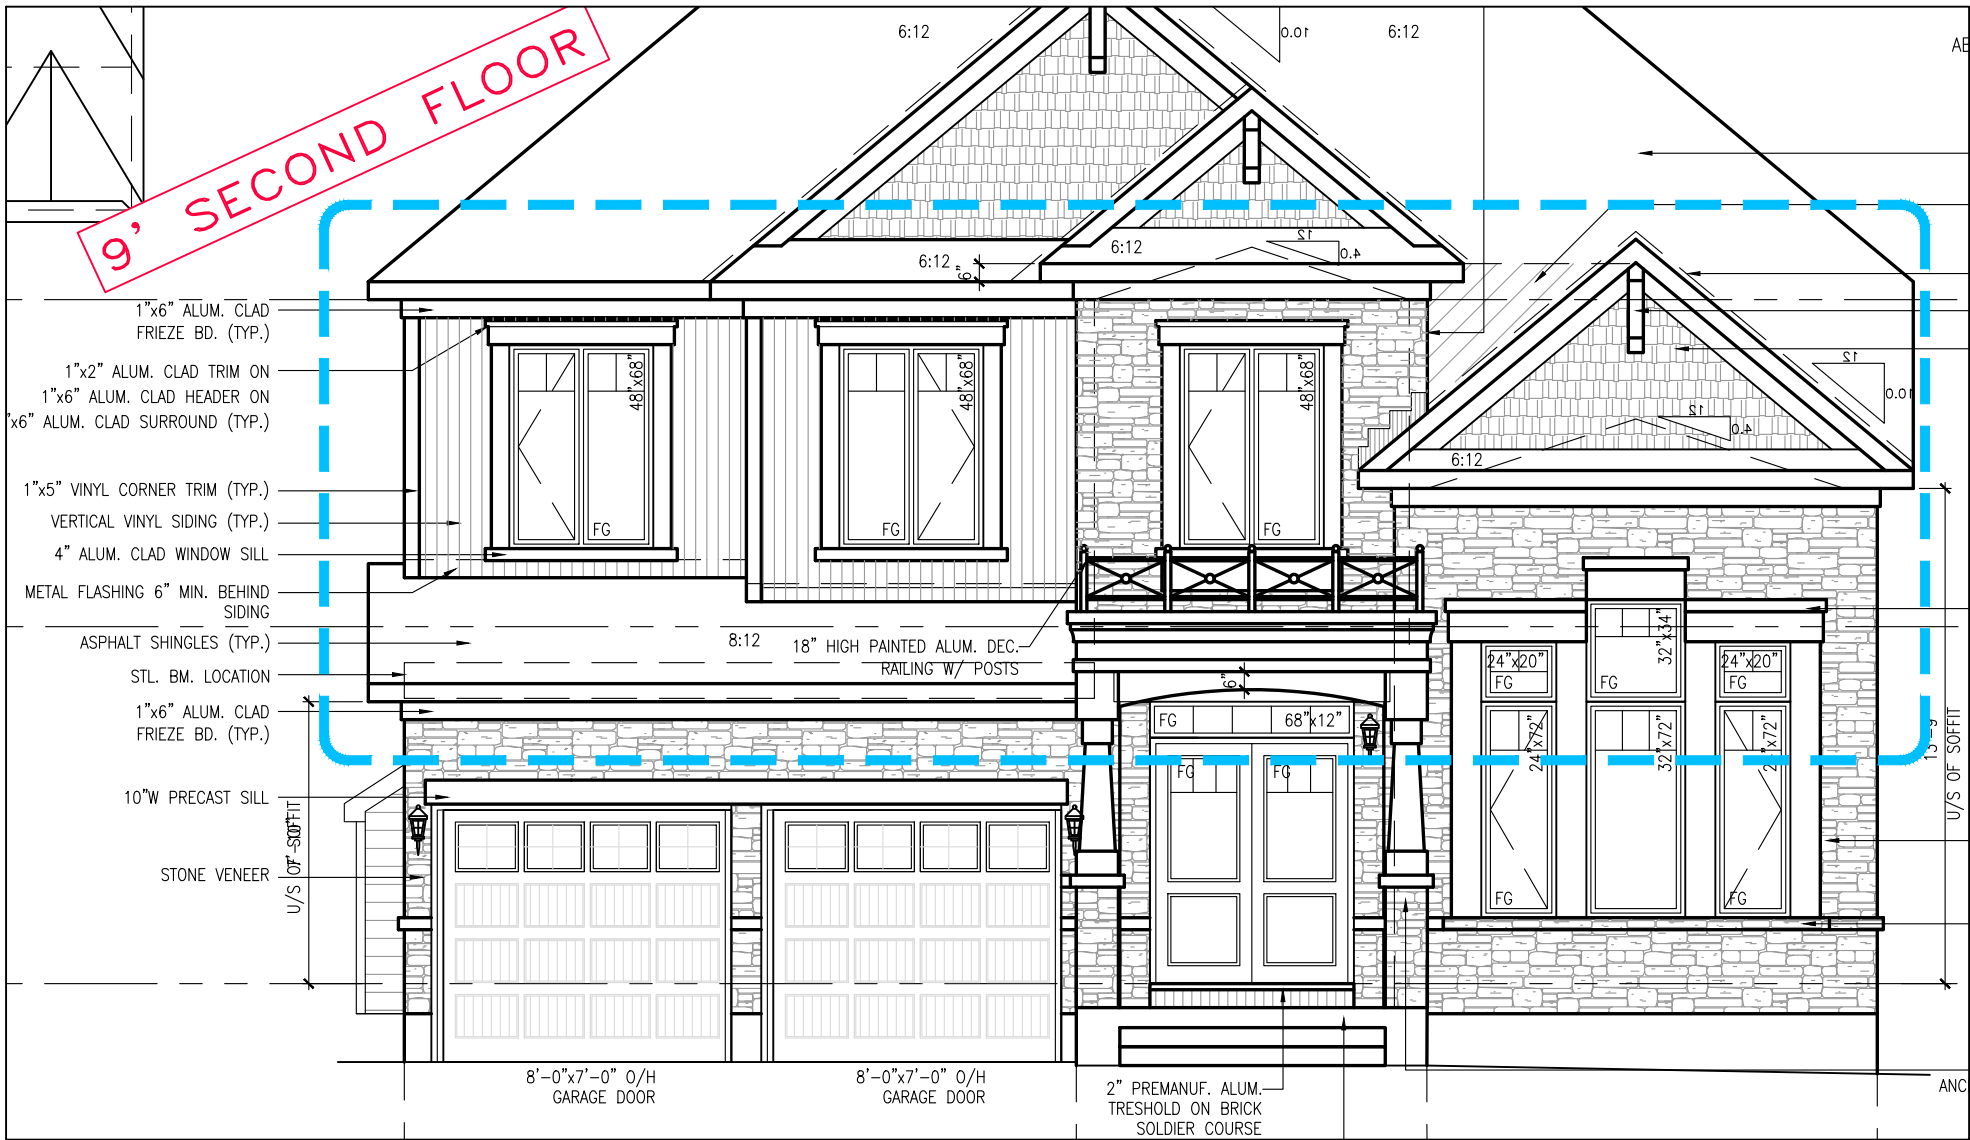


1 PARTIAL FRONT ELEVATION
3 scale: 3/16"=1'-0"


City of Ottawa
Building Services Branch

REVIEWED
By D.Bordage at 10:19 am, Sep 23, 2022

Building Code Reviewed
D. Bordage
Signature
D. BORDAGE

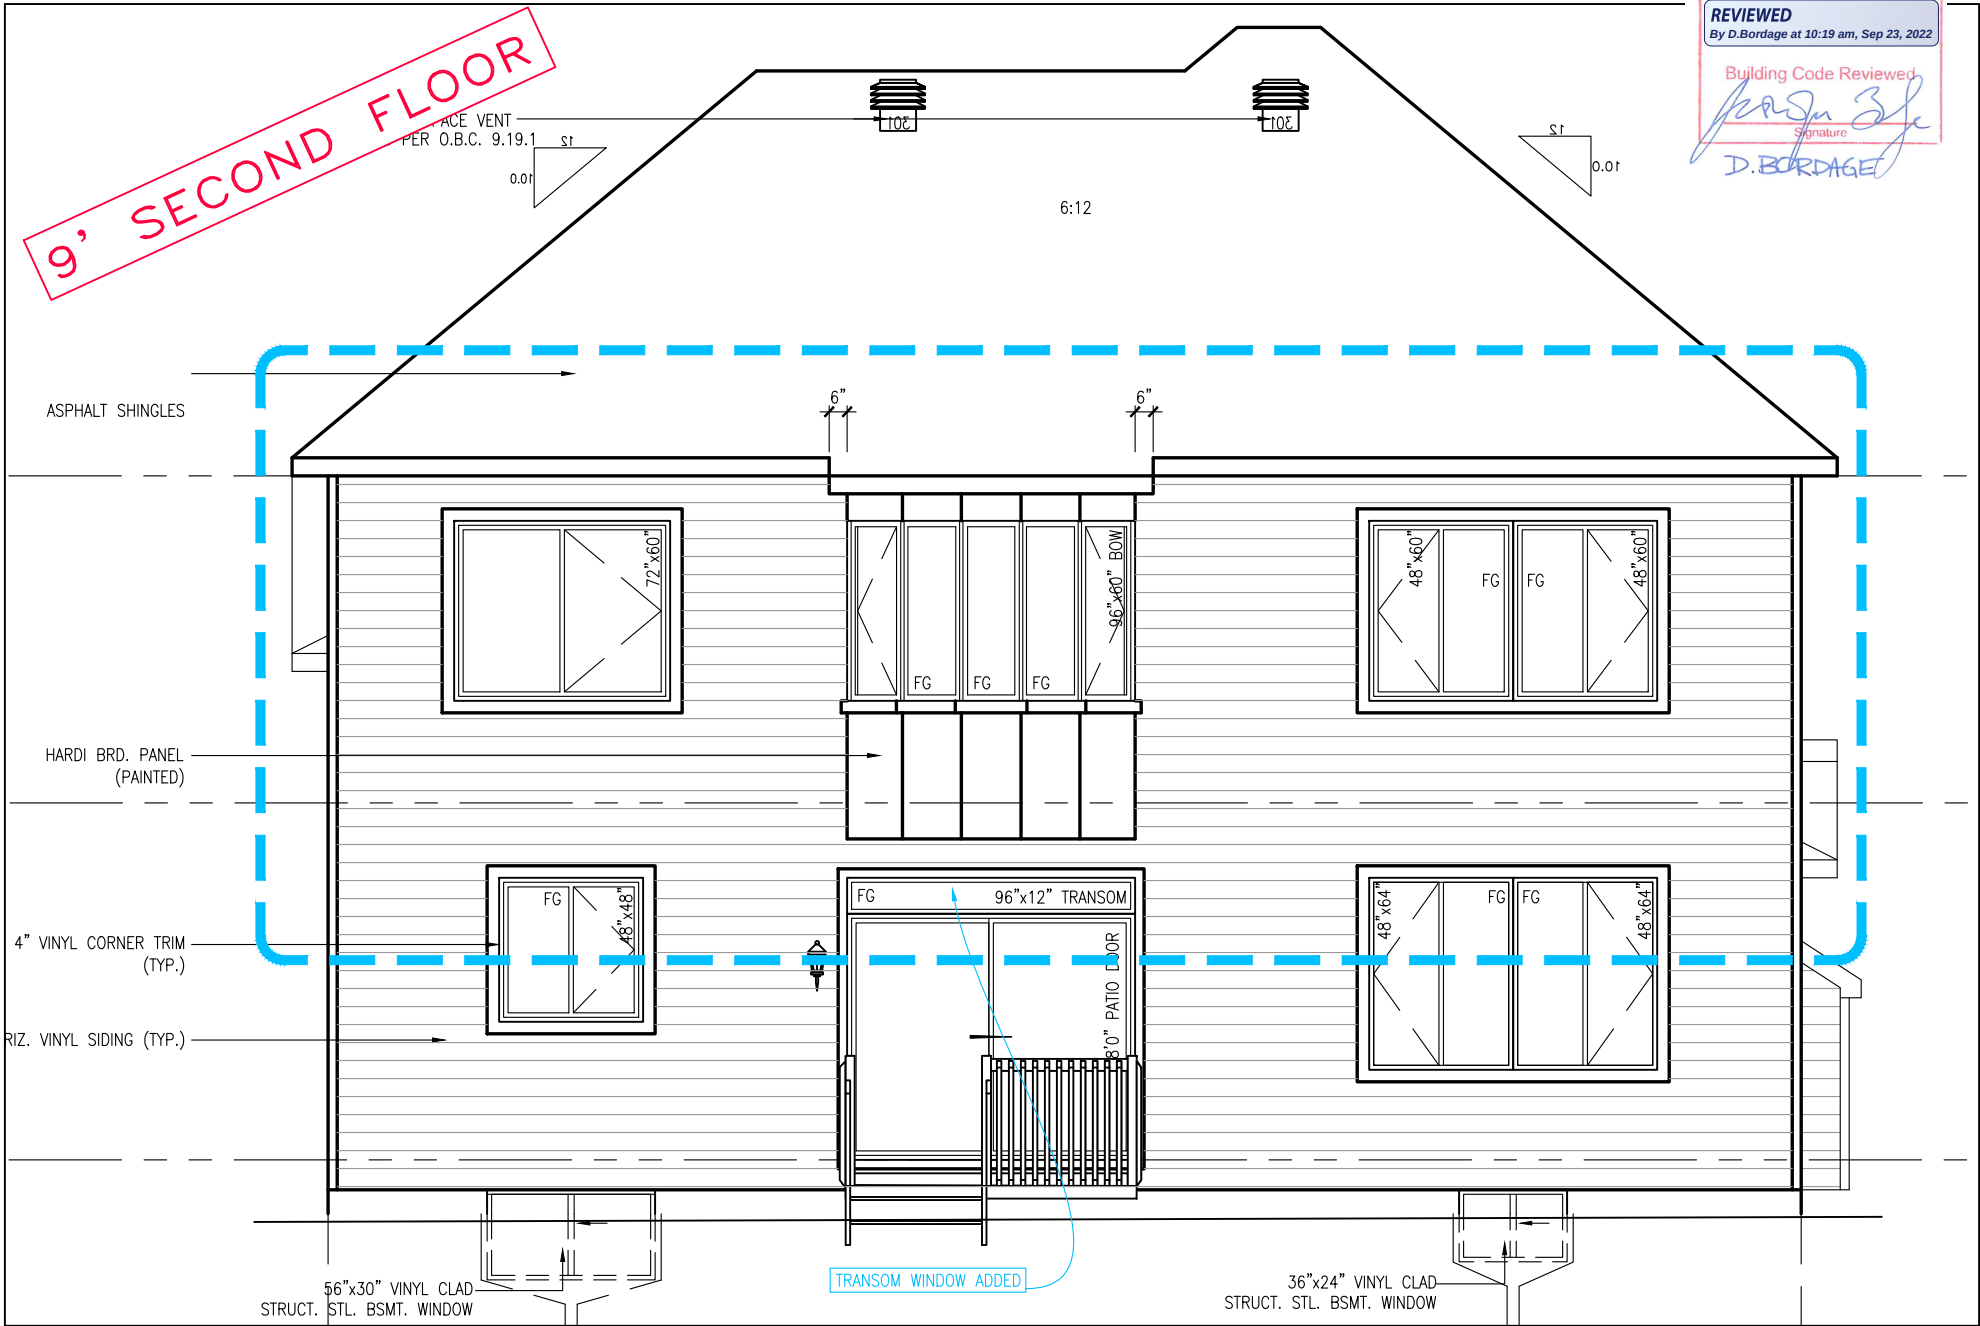

2 PARTIAL REAR ELEVATION
3 scale: 3/16"=1'-0"

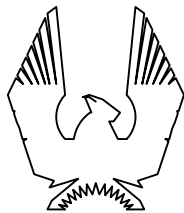

PHOENIX HOMES

PLATINA-2007

SITE: PATHWAYS

LOT NUMBER:

CIVIC ADDRESS:
658 MIIKANA ROAD

279

2

1

FIN. BSMT/2ND FLOOR LAUNDRY/9' 2ND FLOOR

XX/XX/XX

CB

12/07/22

CB

No. Description
REVISIONS

dd/mm/yy
By

footprint: 512

drawn by: 1V

date: JULY 2007

scale: 3/16"=1'-0"


sheet no:

3


4

4) scale: $3/16" = 1' - 0"$

Building Code Reviewed
Signature
D. BORDAGE

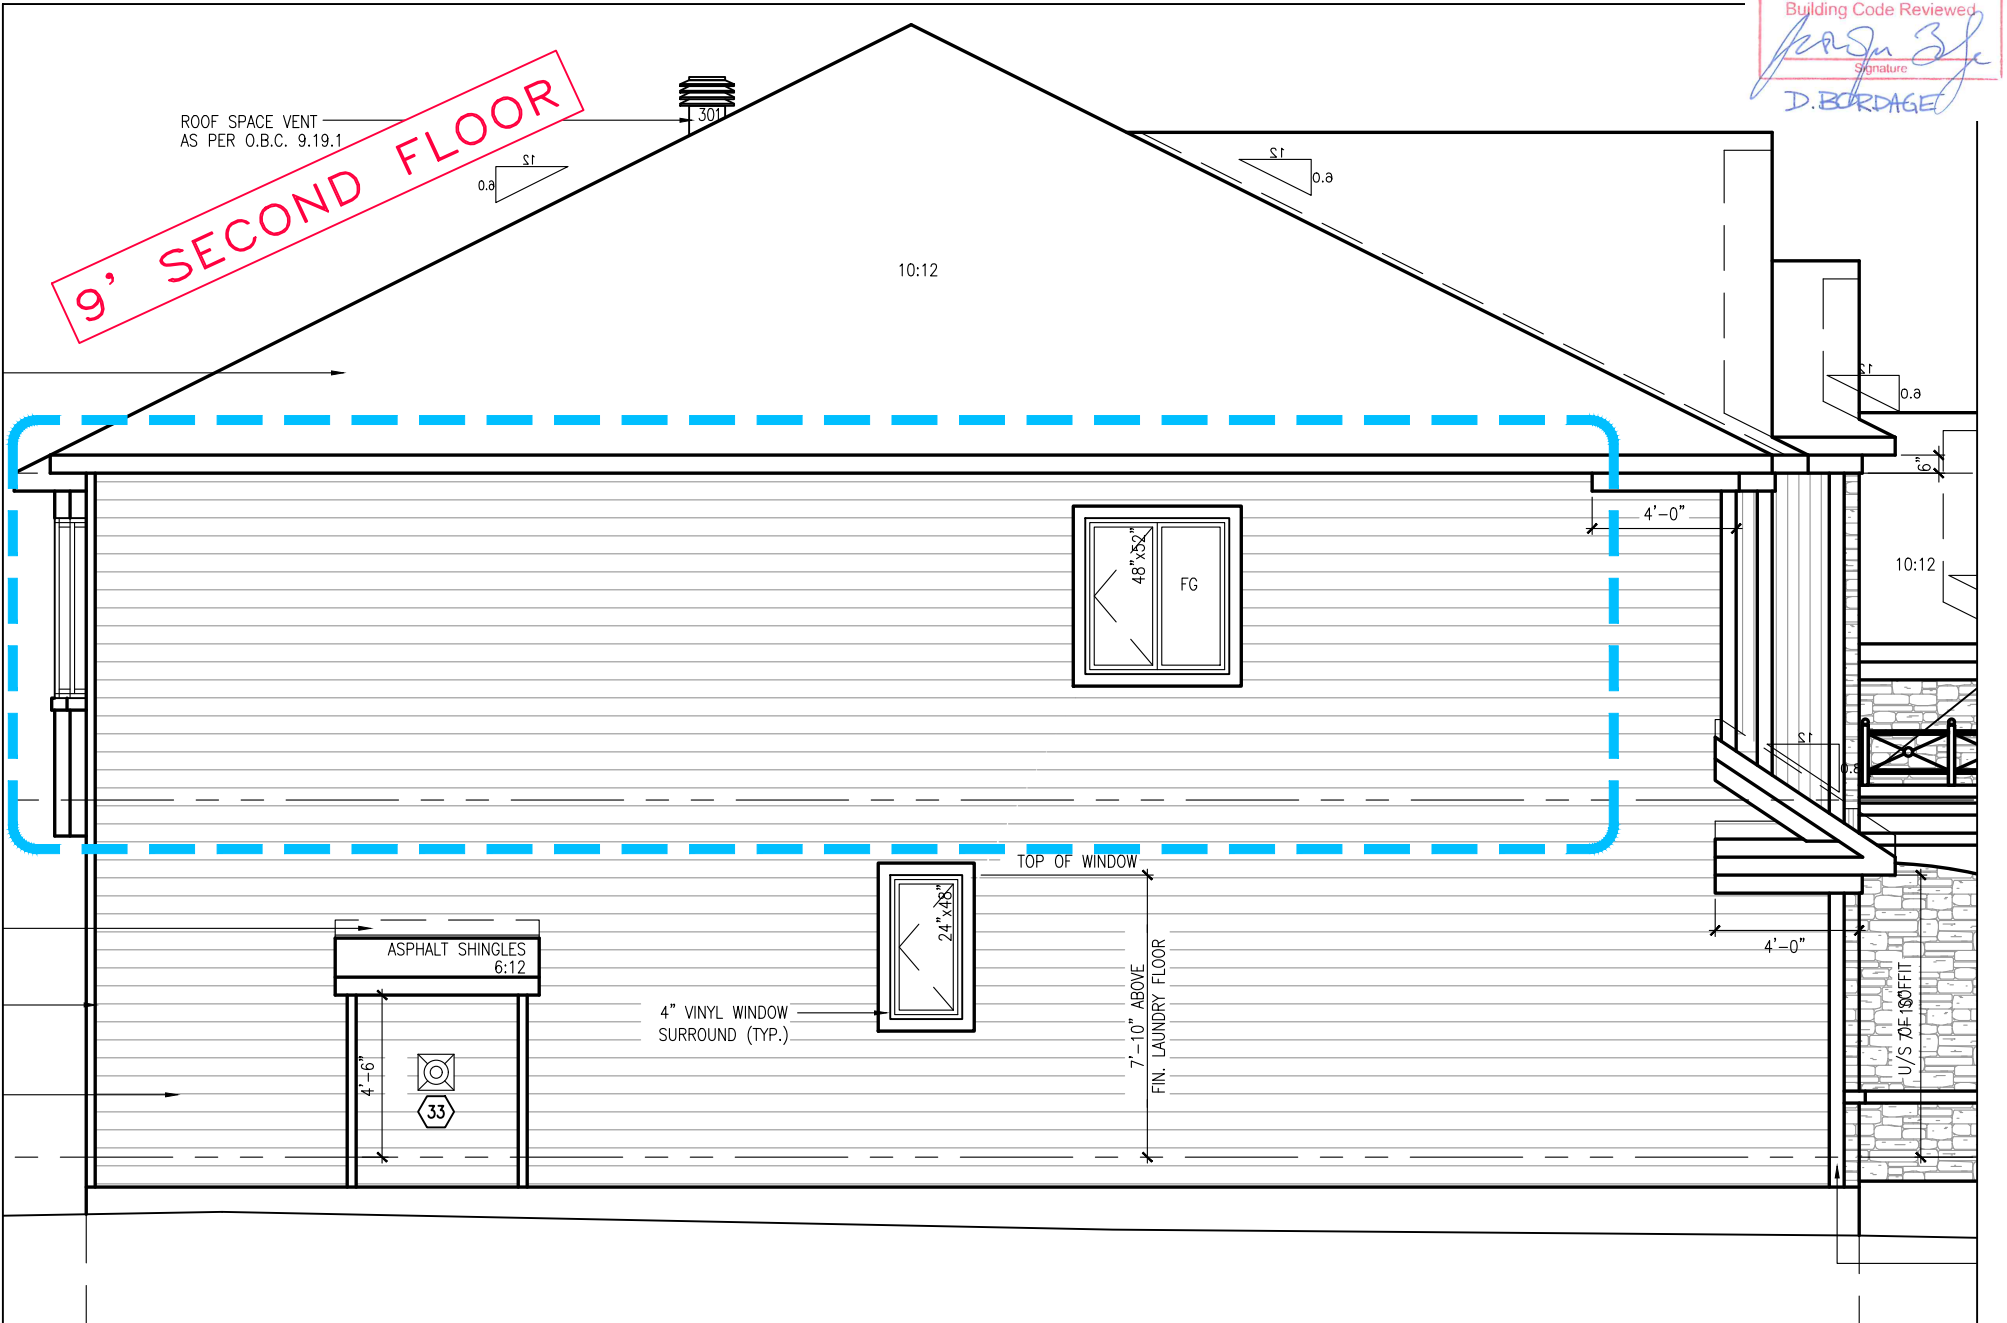

4 scale: $3/16" = 1'-0"$

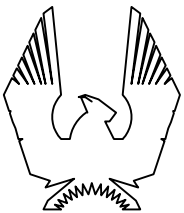

PLATINA-2007

SITE: PATHWAYS

LOT NUMBER:

CIVIC ADDRESS:
658 MIIKANA ROAD

279

2		XX/XX/XX	CB
1	FIN. BSMT/2ND FLOOR LAUNDRY/9' 2ND FLOOR	12/07/22	CB
No.	Description	dd/mm/yy	By
REVISIONS			

footprint:	512
drawn by:	1V
date:	JULY 2007
scale:	3/16"=1'-0"

sheet no:

1

4