

REVISED 22NOV2023

DCR PHOENIX HOMES

LOT #3-64

WHITE TAIL RIDGE

NEWINGTON

OPTIONAL CHEF'S KITCHEN



| 1:34 PM EST

NOTE: ITEMS
REMOVE ARE
CROSSED OFF

MOUNTING HEIGHT: 96

42" UPPERS @18" ABOVE COUNTER

CROWIN MOULDING - SHAKER STYLE



ad by:


[Signature]

'B68548E...

DocuSigned by:

[Signature]

0EBAB2E7B68548E...

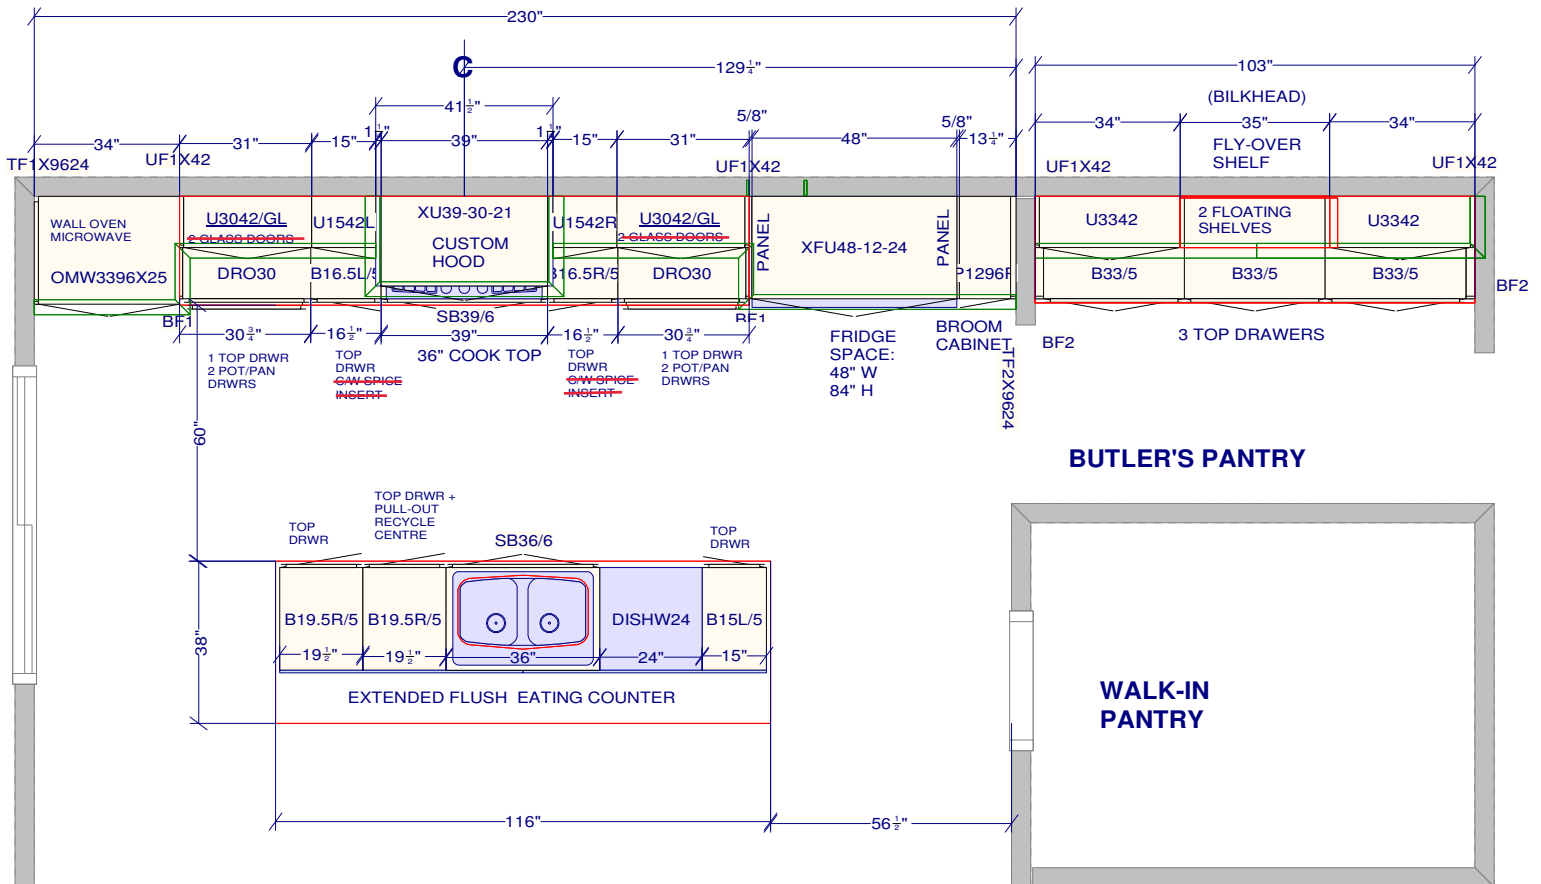

BUTLER'S PANTRY

WALK-IN
PANTRY

CUSTOMER APPROVAL

I have reviewed these drawings and understand the details of the design and the CARTIER KITCHENS specifications.

Signature _____

Date _____

All dimensions, size designations given are subject to verification on job site and adjustment to fit job conditions.



This is an original design and must not be released or copied unless applicable fee has been paid or job order placed.

Designed: 2023-10-13
Printed: 2023-10-13

DocuSigned by:
0EBAB2E7B68548E...

DocuSigned by:
D6F9128ECDB9453...

DocuSigned by:
0EBAB2E7B68548E...

DocuSigned by:
0EBAB2E7B68548E...

11/24/2023 | 1:34 PM EST

CROWN MOULDING

BULKHEAD

CROWN MOULDING

CROWN MOULDING

CROWN MOULDING

MW

OVEN

36" COOKTOP

FRIDGE
SPACE:
W: 48"
H: 84"

FLY-OVER
SHELF

2 FLOATING
SHELVES

OVEN / COOKTOP / FRIDGE WALL ELEVATION

BUTLER'S PANTRY ELEVATION

CUSTOMER APPROVAL

I have reviewed these drawings and understand the details of the design and the CARTIER KITCHENS specifications.

Signature _____

Date _____

All dimensions & size designations given are subject to verification on job site and adjustment to fit job conditions.



This is an original design and must not be released or copied unless applicable fee has been paid or job order placed.

Designed: 2023-10-13
Printed: 2023-10-13