


LOT #133
SITE - WHITE TAIL RIDGE
MODEL - ANNAPOLIS (509)

KITCHEN

MOUNTING HEIGHT - 84

REVISED: Feb 13-24

AS PER SITE MEASURE

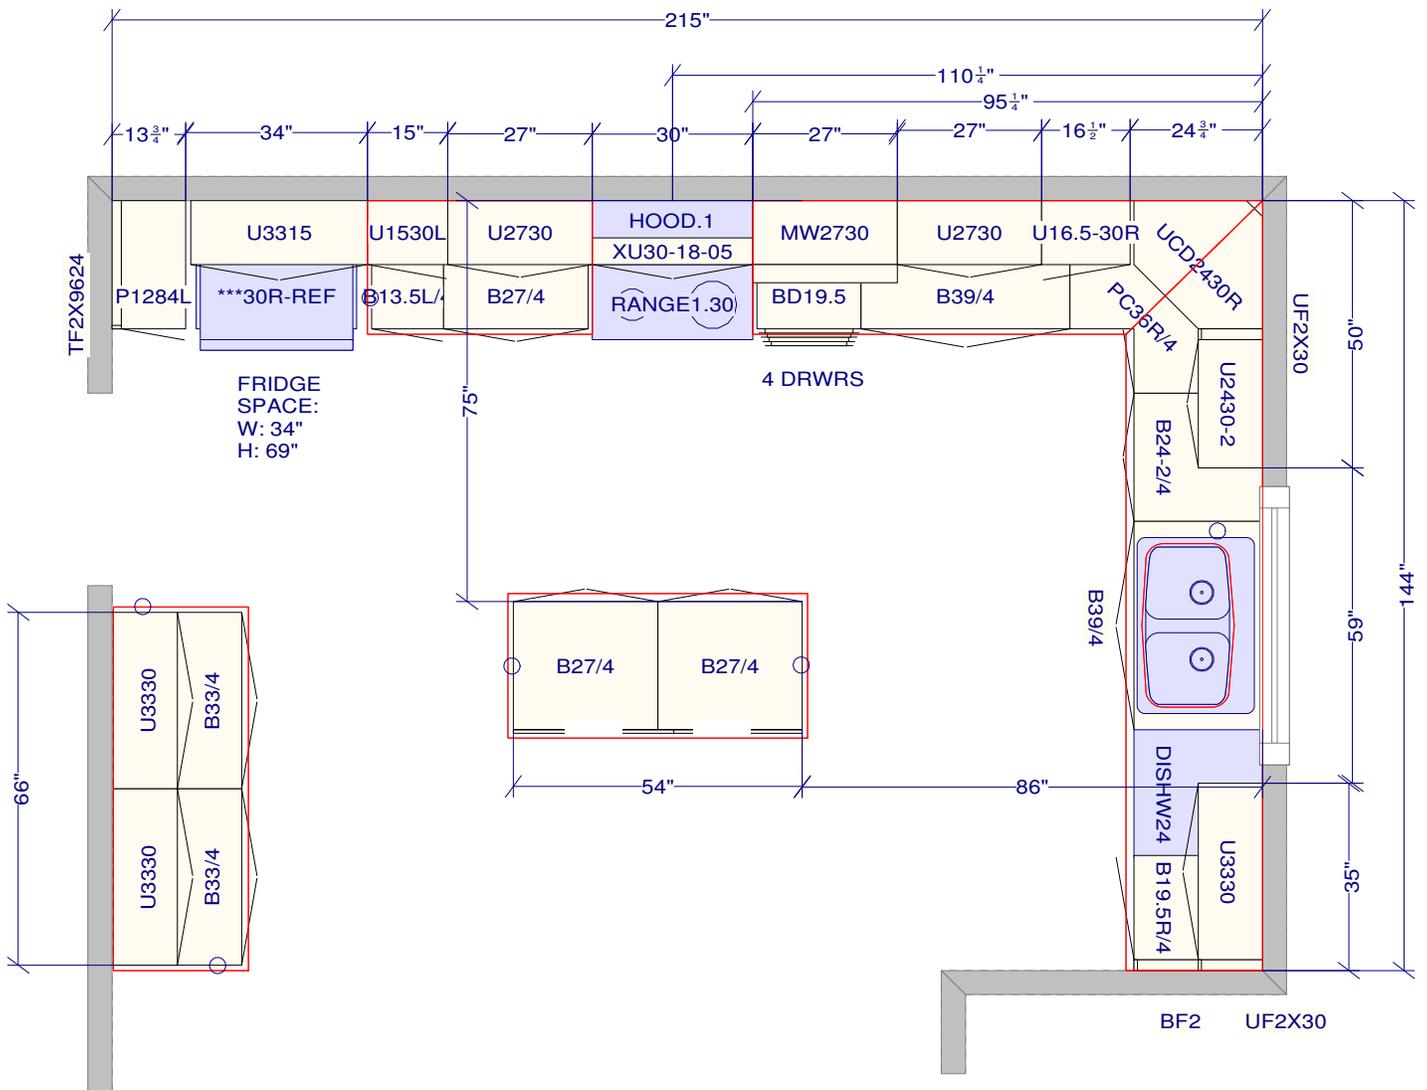

All dimensions and size designations given are subject to verification on job site and adjustment to fit job conditions.

This is an original design and must not be released or copied unless applicable fee has been paid or job order placed.

Designed: 2024-02-13
 Printed: 2024-02-13

KR KR AR