


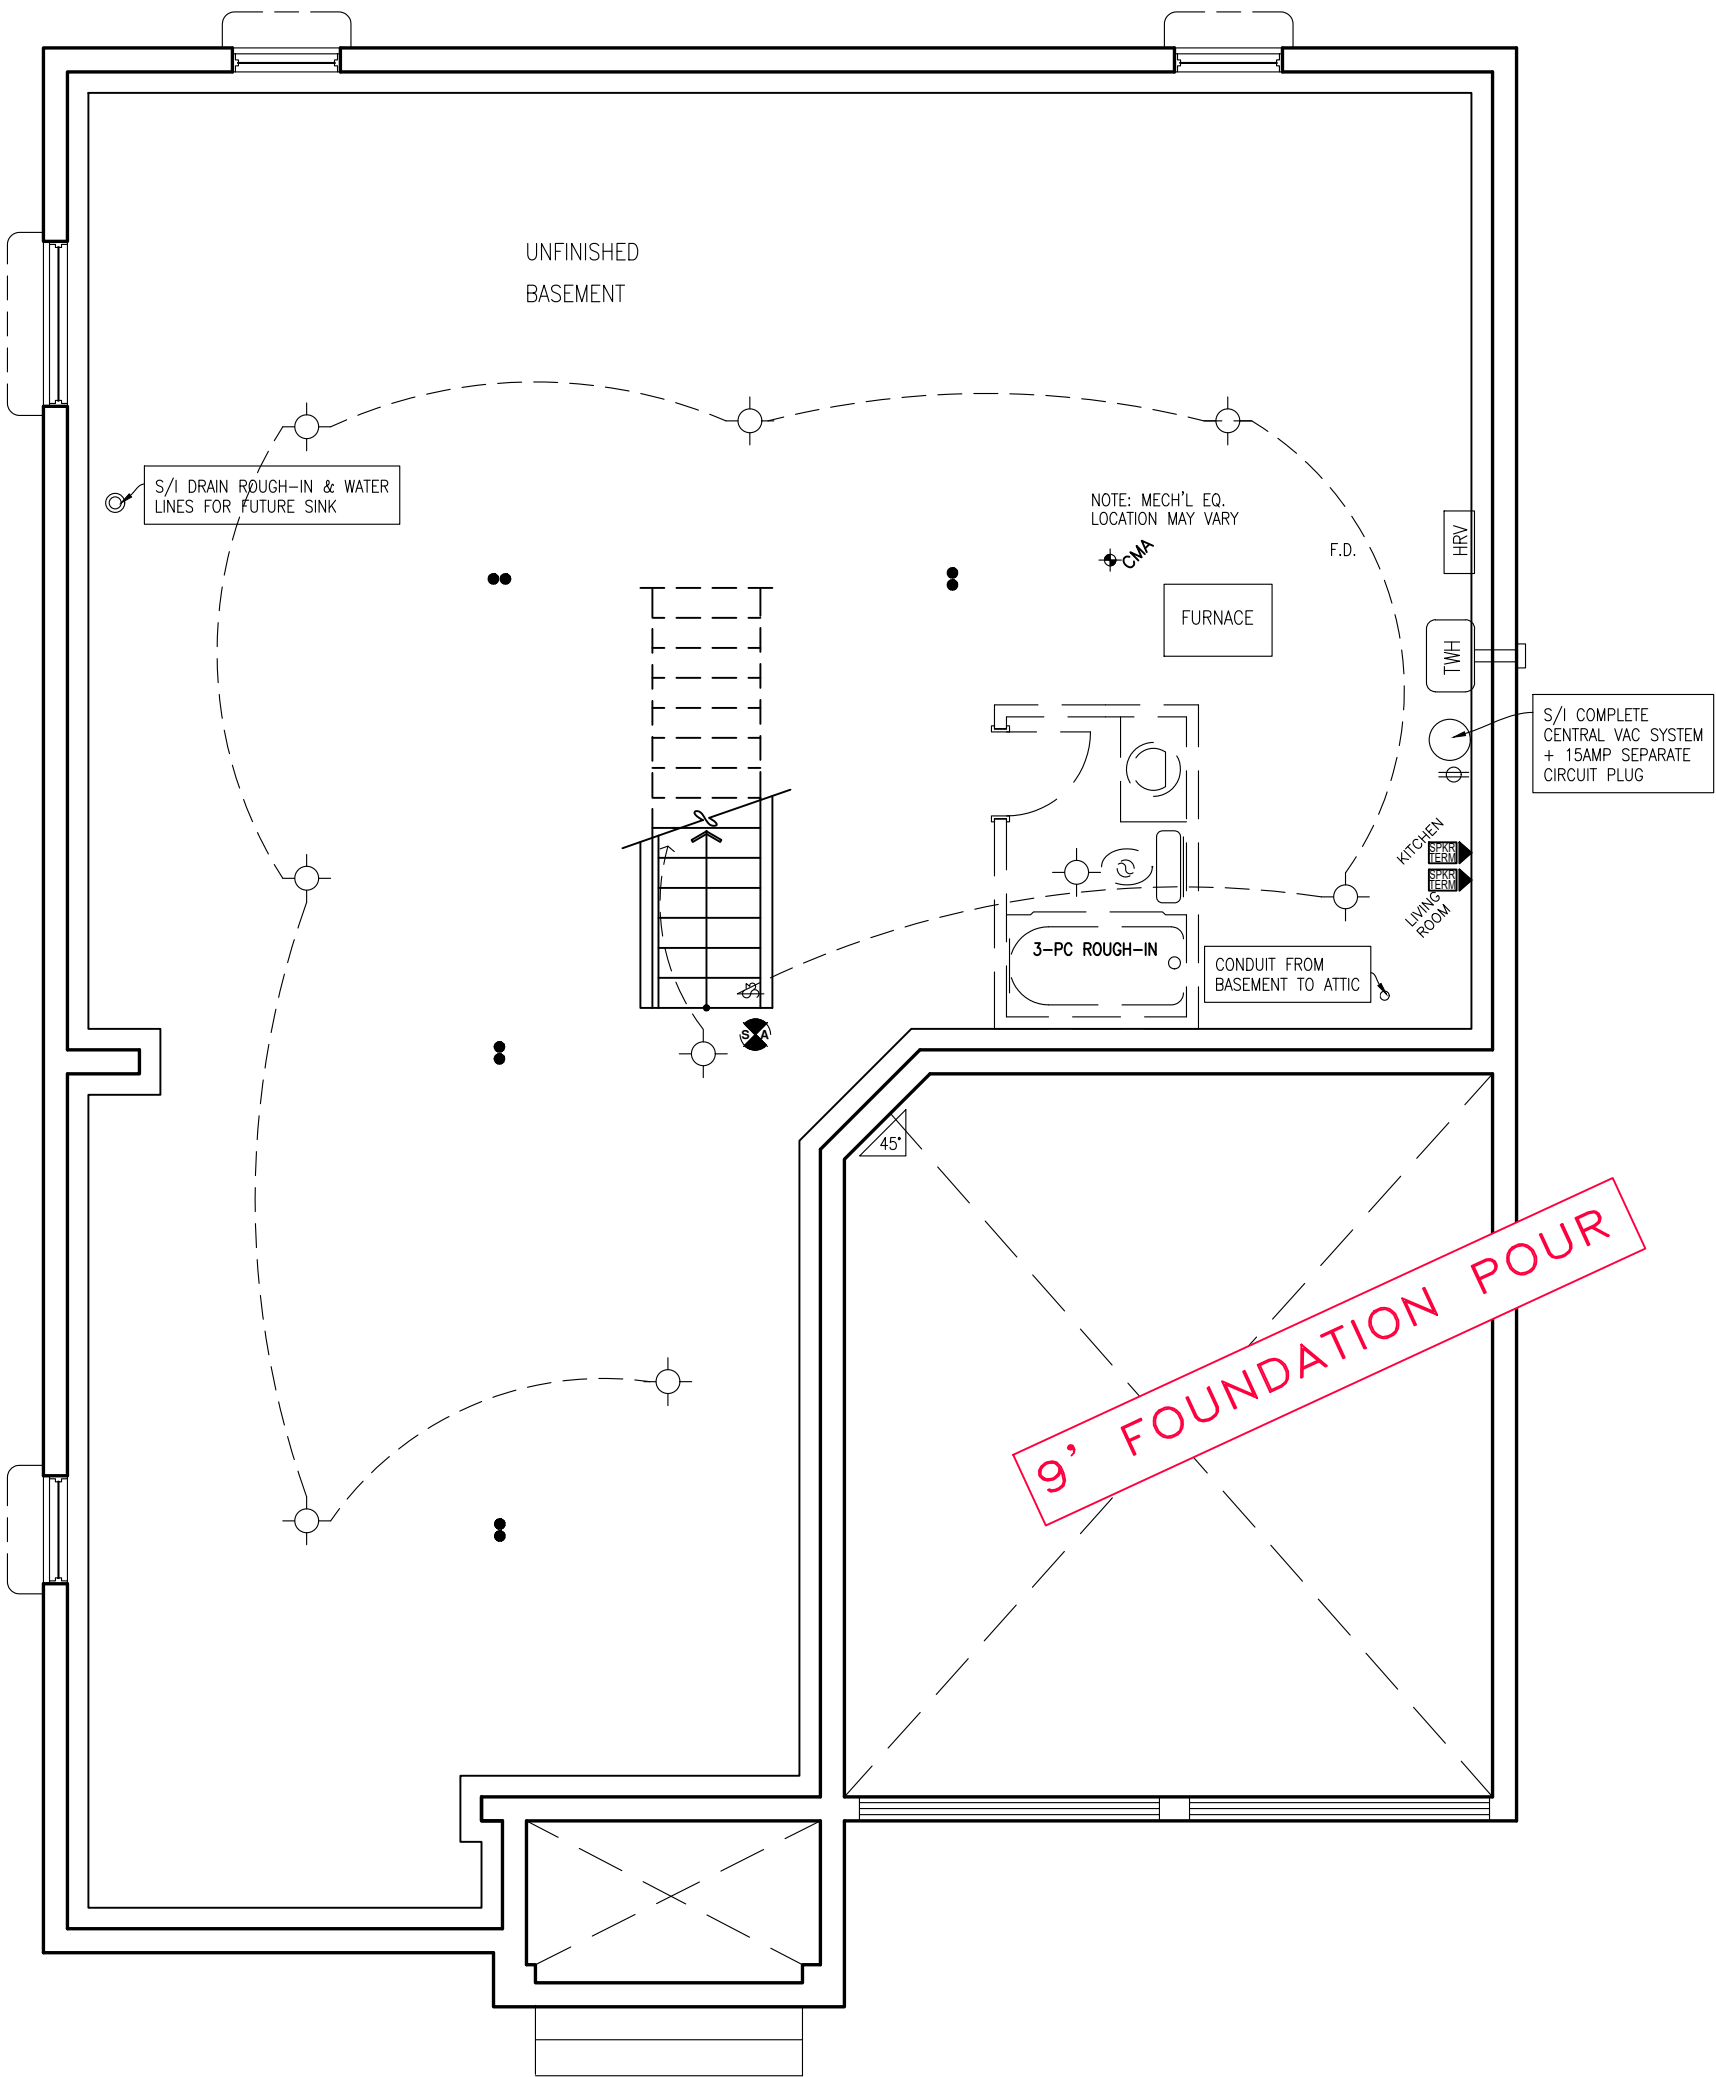

BASEMENT PLAN 'E'

E.& O.E. / FOR REFERENCE ONLY
SUBJECT TO CHANGES

2/16/2024 | 11:59 AM PST

DS
Ml

DS
MT



PLATINA-2007

SITE: PATHWAYS PH2


LOT NUMBER: 278

CIVIC ADDRESS: 660 MIKANA ROAD

18	FINAL BLACKLINES REV-CAPPED LIGHTS ADDED	16/02/24	CB
17	FINAL FOR SITE	09/08/23	CB
16	FINAL BLACKLINES	31/08/22	CB
15	ISSUED FOR LAYOUTS	21/06/22	KE
14	BEP BLACKLINES REVISED	13/06/22	KE
13	BEP BLACKLINES	30/05/22	KE
No.	Description	dd/mm/yy	By
REVISIONS			

footprint:	512
sht. title:	
drawn by:	1V
checked by:	.
date:	JULY 2007
scale:	3/16"=1'-0"
D.C.L. - 202	
sheet no:	2E of 9

FLAT CEILINGS THROUGHOUT
NO STIPPLE

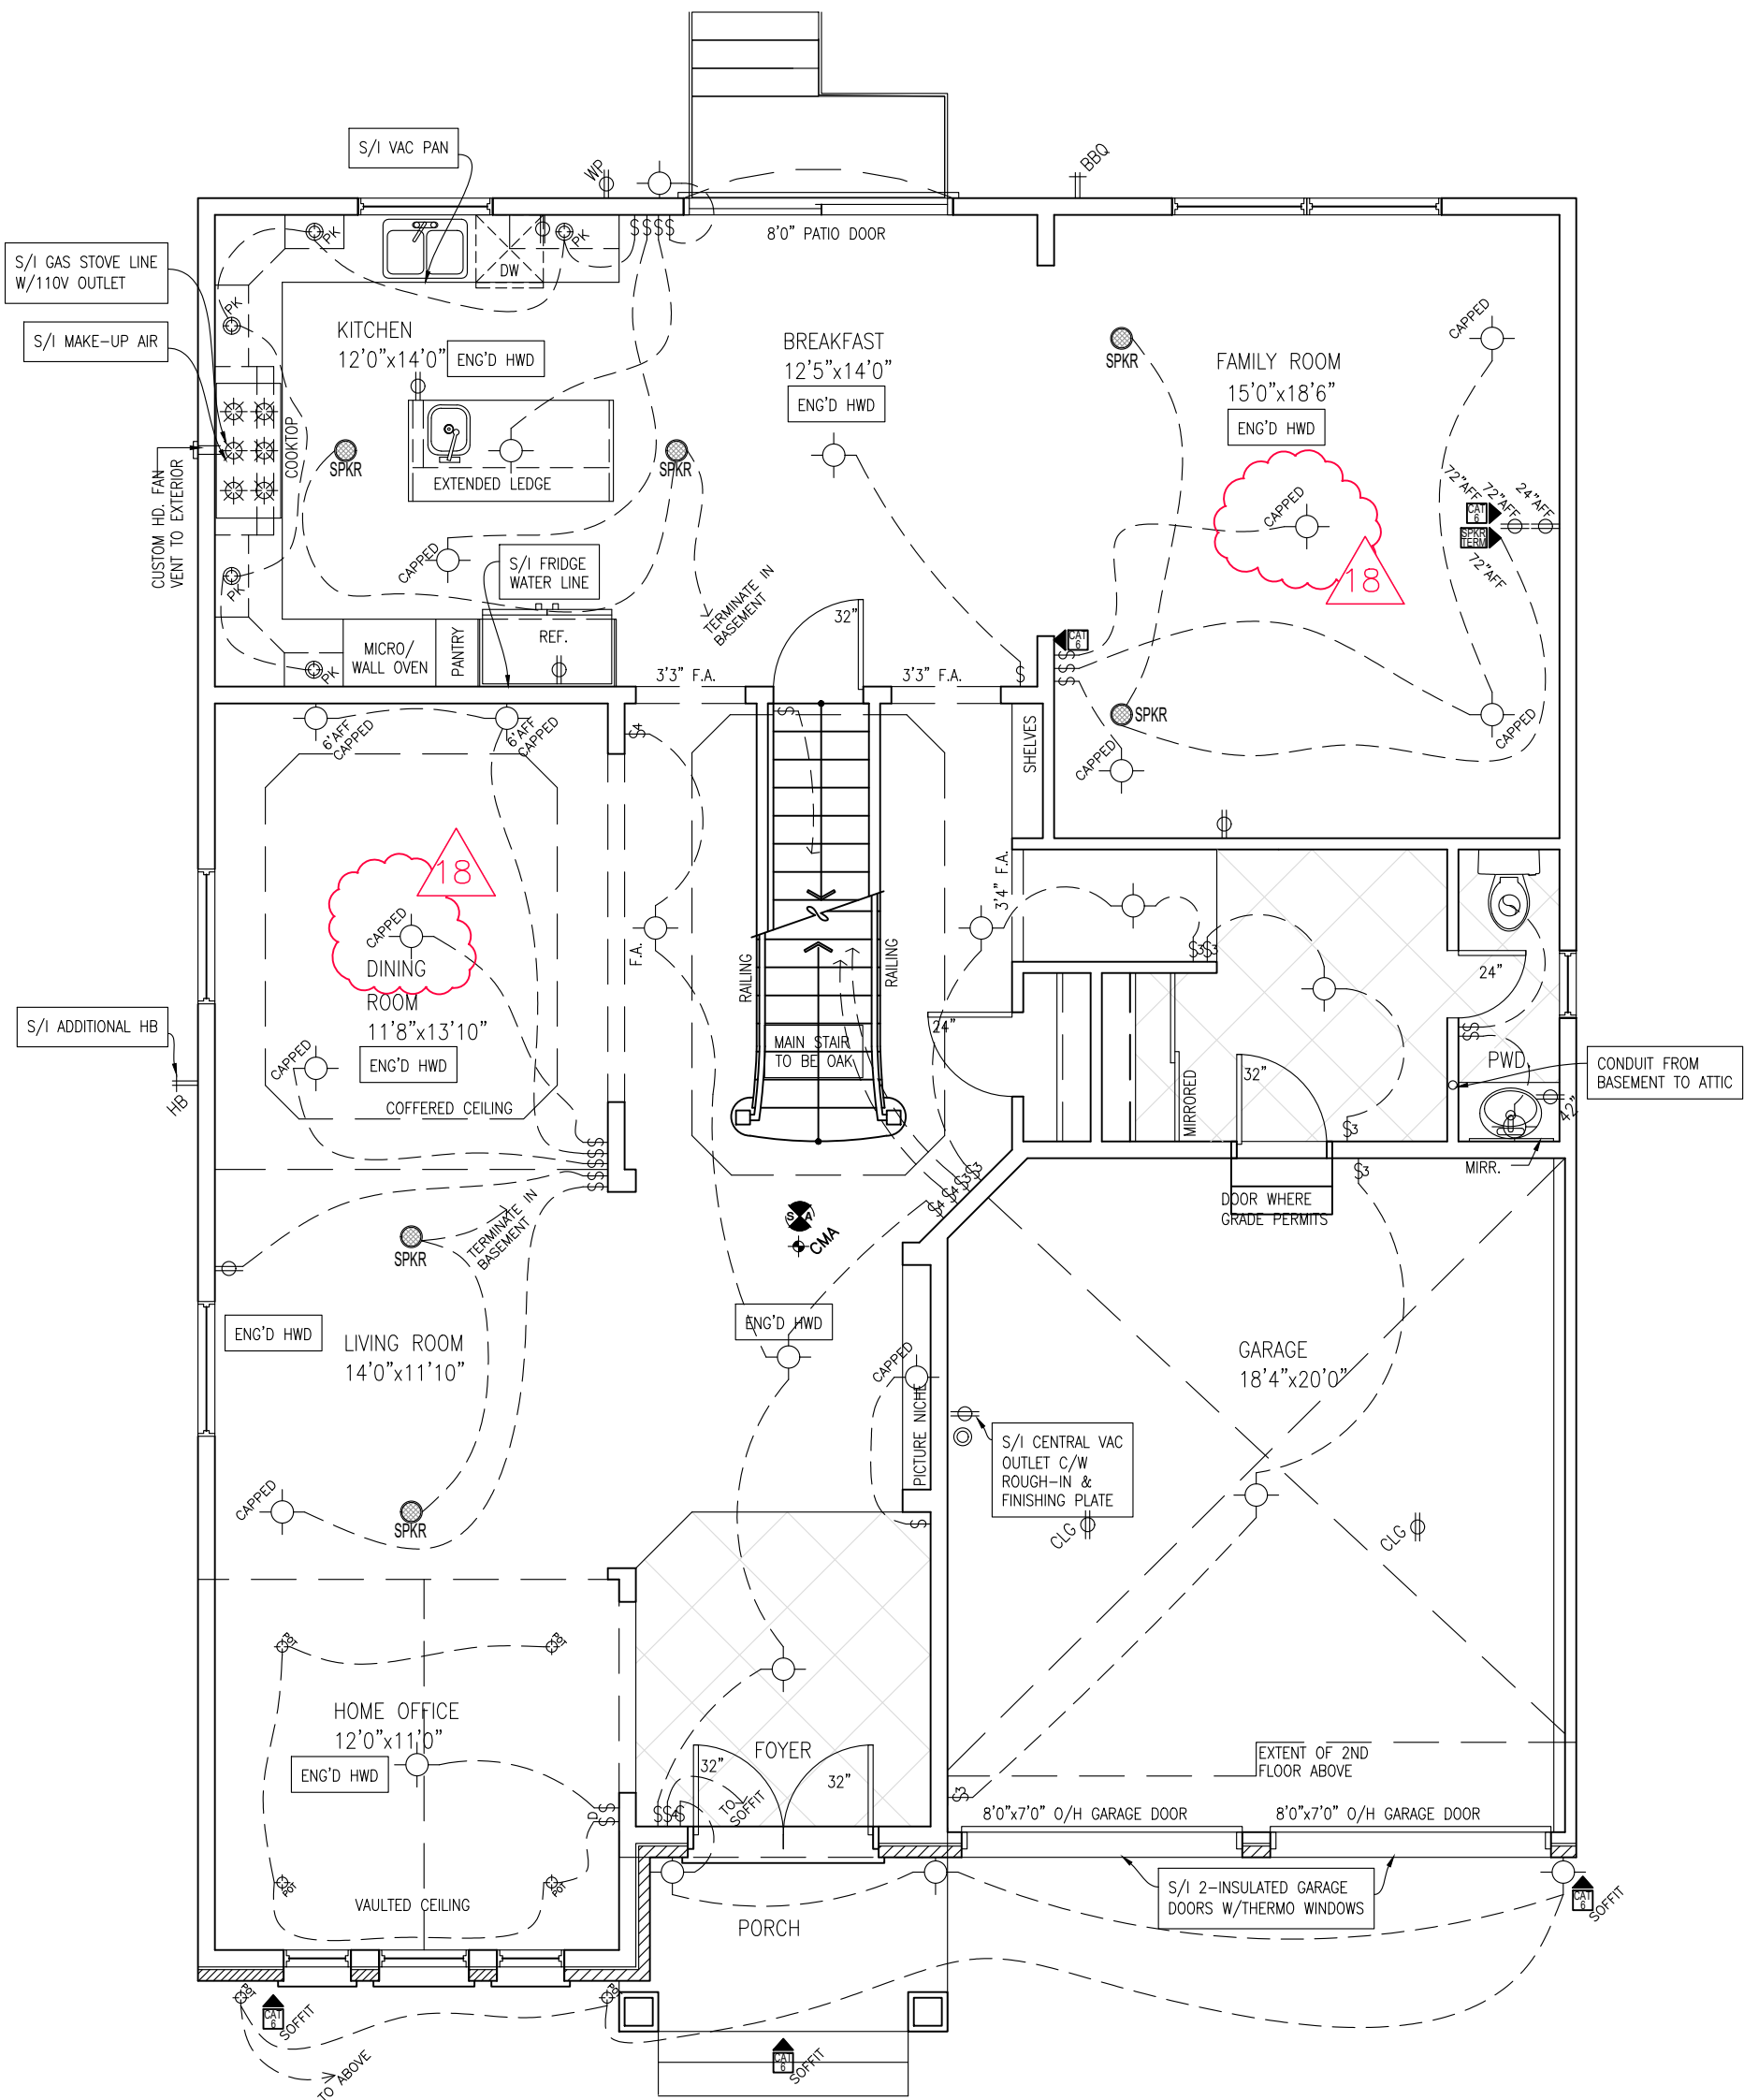

GROUND FLOOR PLAN 'E'

E.&O.E. / FOR REFERENCE ONLY
SUBJECT TO CHANGES

DS
ml

DS
NT

2/16/2024 | 11:59 AM PST



PLATINA-2007

SITE: PATHWAYS PH2


LOT NUMBER: 278

CIVIC ADDRESS: 660 MIIKANA ROAD

18	FINAL BLACKLINES REV-CAPPED LIGHTS ADDED	16/02/24	CB
17	FINAL FOR SITE	09/08/23	CB
16	FINAL BLACKLINES	31/08/22	CB
15	ISSUED FOR LAYOUTS	21/06/22	KE
14	BEP BLACKLINES REVISED	13/06/22	KE
13	BEP BLACKLINES	30/05/22	KE
No. Description		dd/mm/yy	By
REVISIONS			

footprint:	512
sht. title:	
drawn by:	1V
checked by:	
date:	JULY 2007
scale:	3/16"=1'-0"
D.C.L. - 202	
sheet no:	3E of 9

FLAT CEILINGS THROUGHOUT
NO STIPPLE

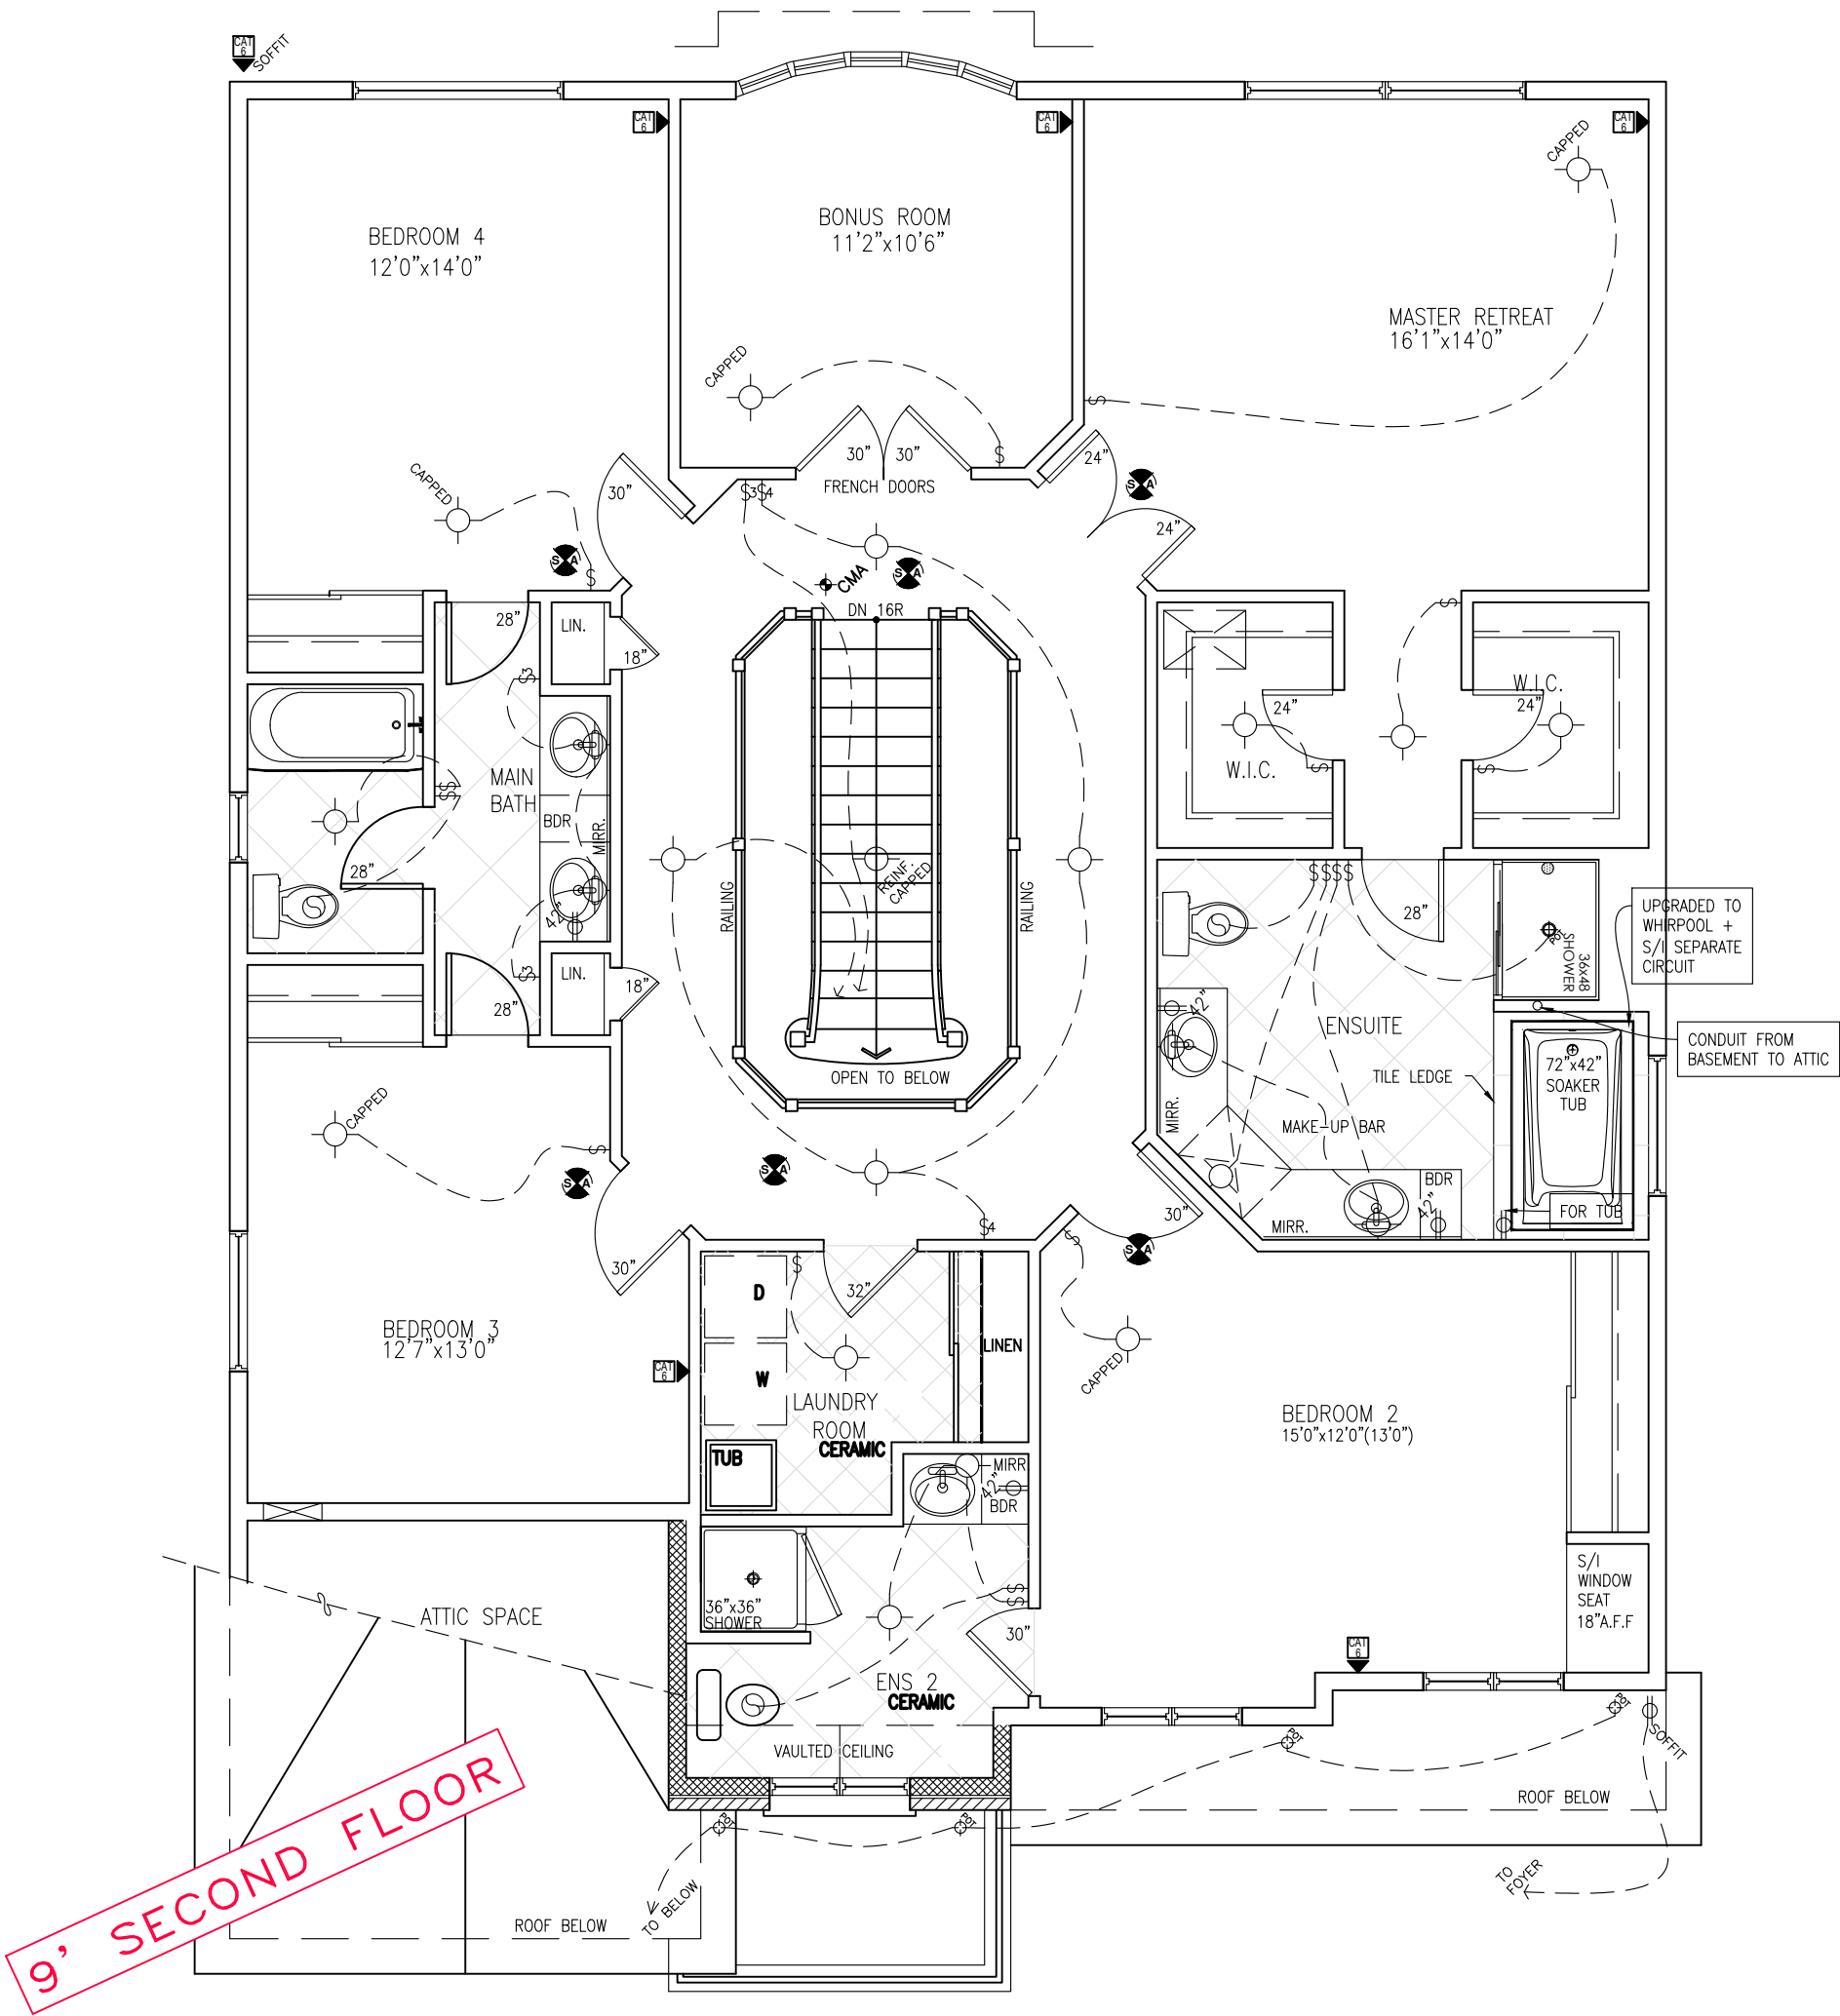

SECOND FLOOR PLAN 'E'

E.& O.E. / FOR REFERENCE ONLY
SUBJECT TO CHANGES

DS
Ml

DS
NT

2/16/2024 | 11:59 AM PST



PLATINA-2007

SITE: PATHWAYS PH2

LOT NUMBER: 278

CIVIC ADDRESS: 660 MIIKANA ROAD

18	FINAL BLACKLINES REV-CAPPED LIGHTS ADDED	16/02/24	CB
17	FINAL FOR SITE	09/08/23	CB
16	FINAL BLACKLINES	31/08/22	CB
15	ISSUED FOR LAYOUTS	21/06/22	KE
14	BEP BLACKLINES REVISED	13/06/22	KE
13	BEP BLACKLINES	30/05/22	KE
No. Description		dd/mm/yy	By
REVISIONS			

footprint:	512
sht. title:	
drawn by:	1V
checked by:	.
date:	JULY 2007
scale:	3/16"=1'-0"
D.C.L. - 202	
sheet no:	4E of 9