


DCR PHOENIX HOMES
92 DIAMONDVIEW PH3
KITCHEN

AS - BUILT
FEB 21-24

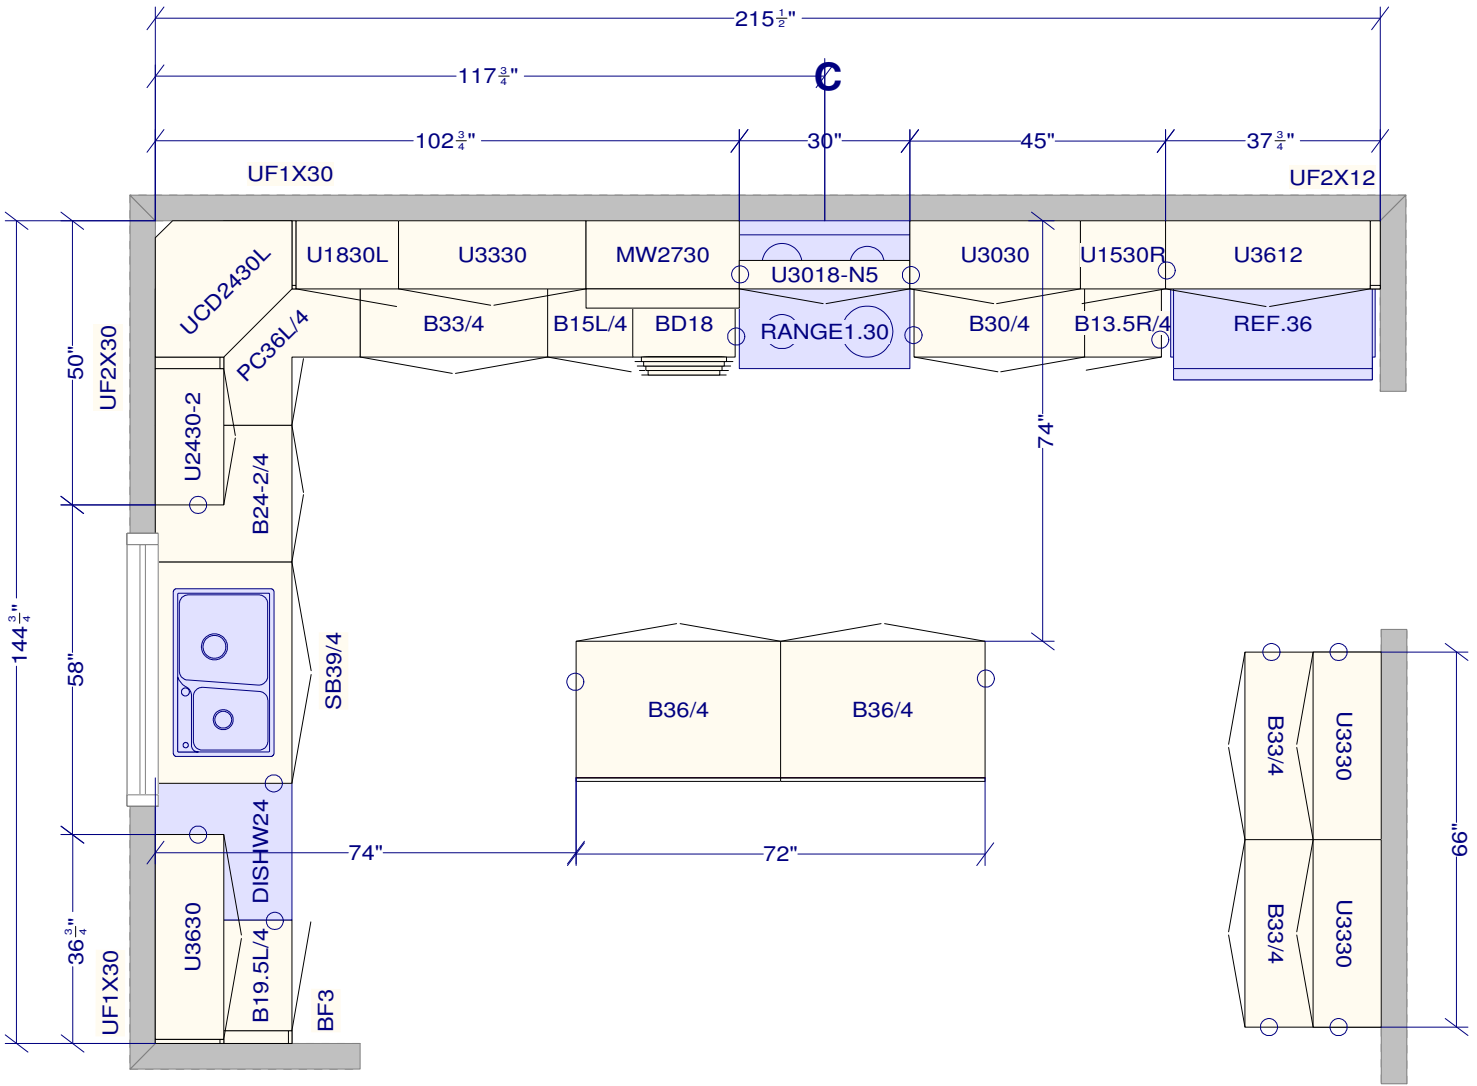

All dimensions and size designations given are subject to verification on job site and adjustment to fit job conditions.

This is an original design and must not be released or copied unless applicable fee has been paid or job order placed.

Designed: 2024-03-01
Printed: 2024-03-01

SPECTRUM KITCHENS OTTAWA

DCR PHOENIX HOMES
92 DIAMONDVIEW PH3

MODEL - KINGSWOOD

VANITIES

VANITIES

LINE 2 - NEW YORK MATTE BLACK

HARDWARE - HU60


STANDARD WHITE INTERIOR

METAL DRAWER BOX


4 PCS - 5/8" KICK - FIN. BOTH ENDS

4 PCS - FLAT MOULDING


AS-BUILT -
FEB 21-24

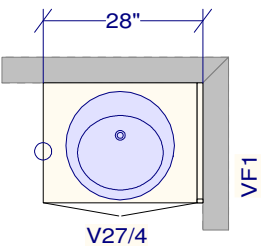


1ST FLOOR ENSUITE

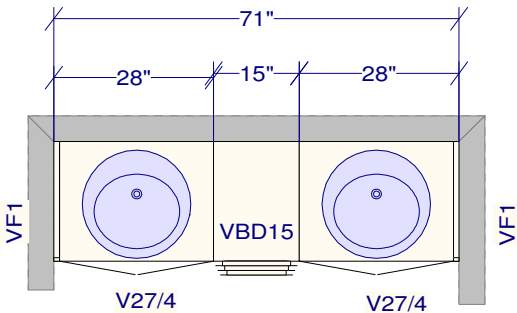


JACK AND JILL

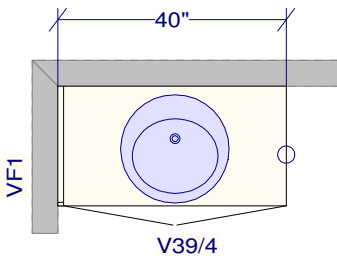

BASEMENT

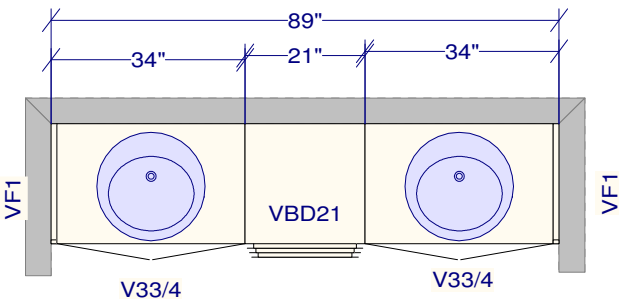

PRIMARY ENSUITE

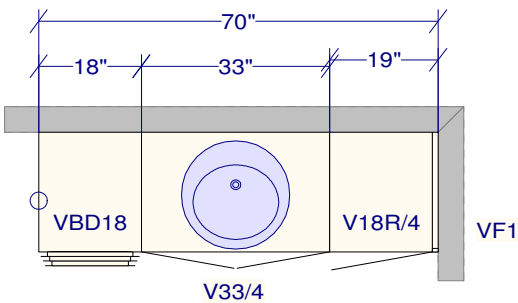

ENSUITE #2

All dimensions and size designations given are subject to verification on job site and adjustment to fit job conditions.

This is an original design and must not be released or copied unless applicable fee has been paid or job order placed.

Designed: 2024-03-01
Printed: 2024-03-01