


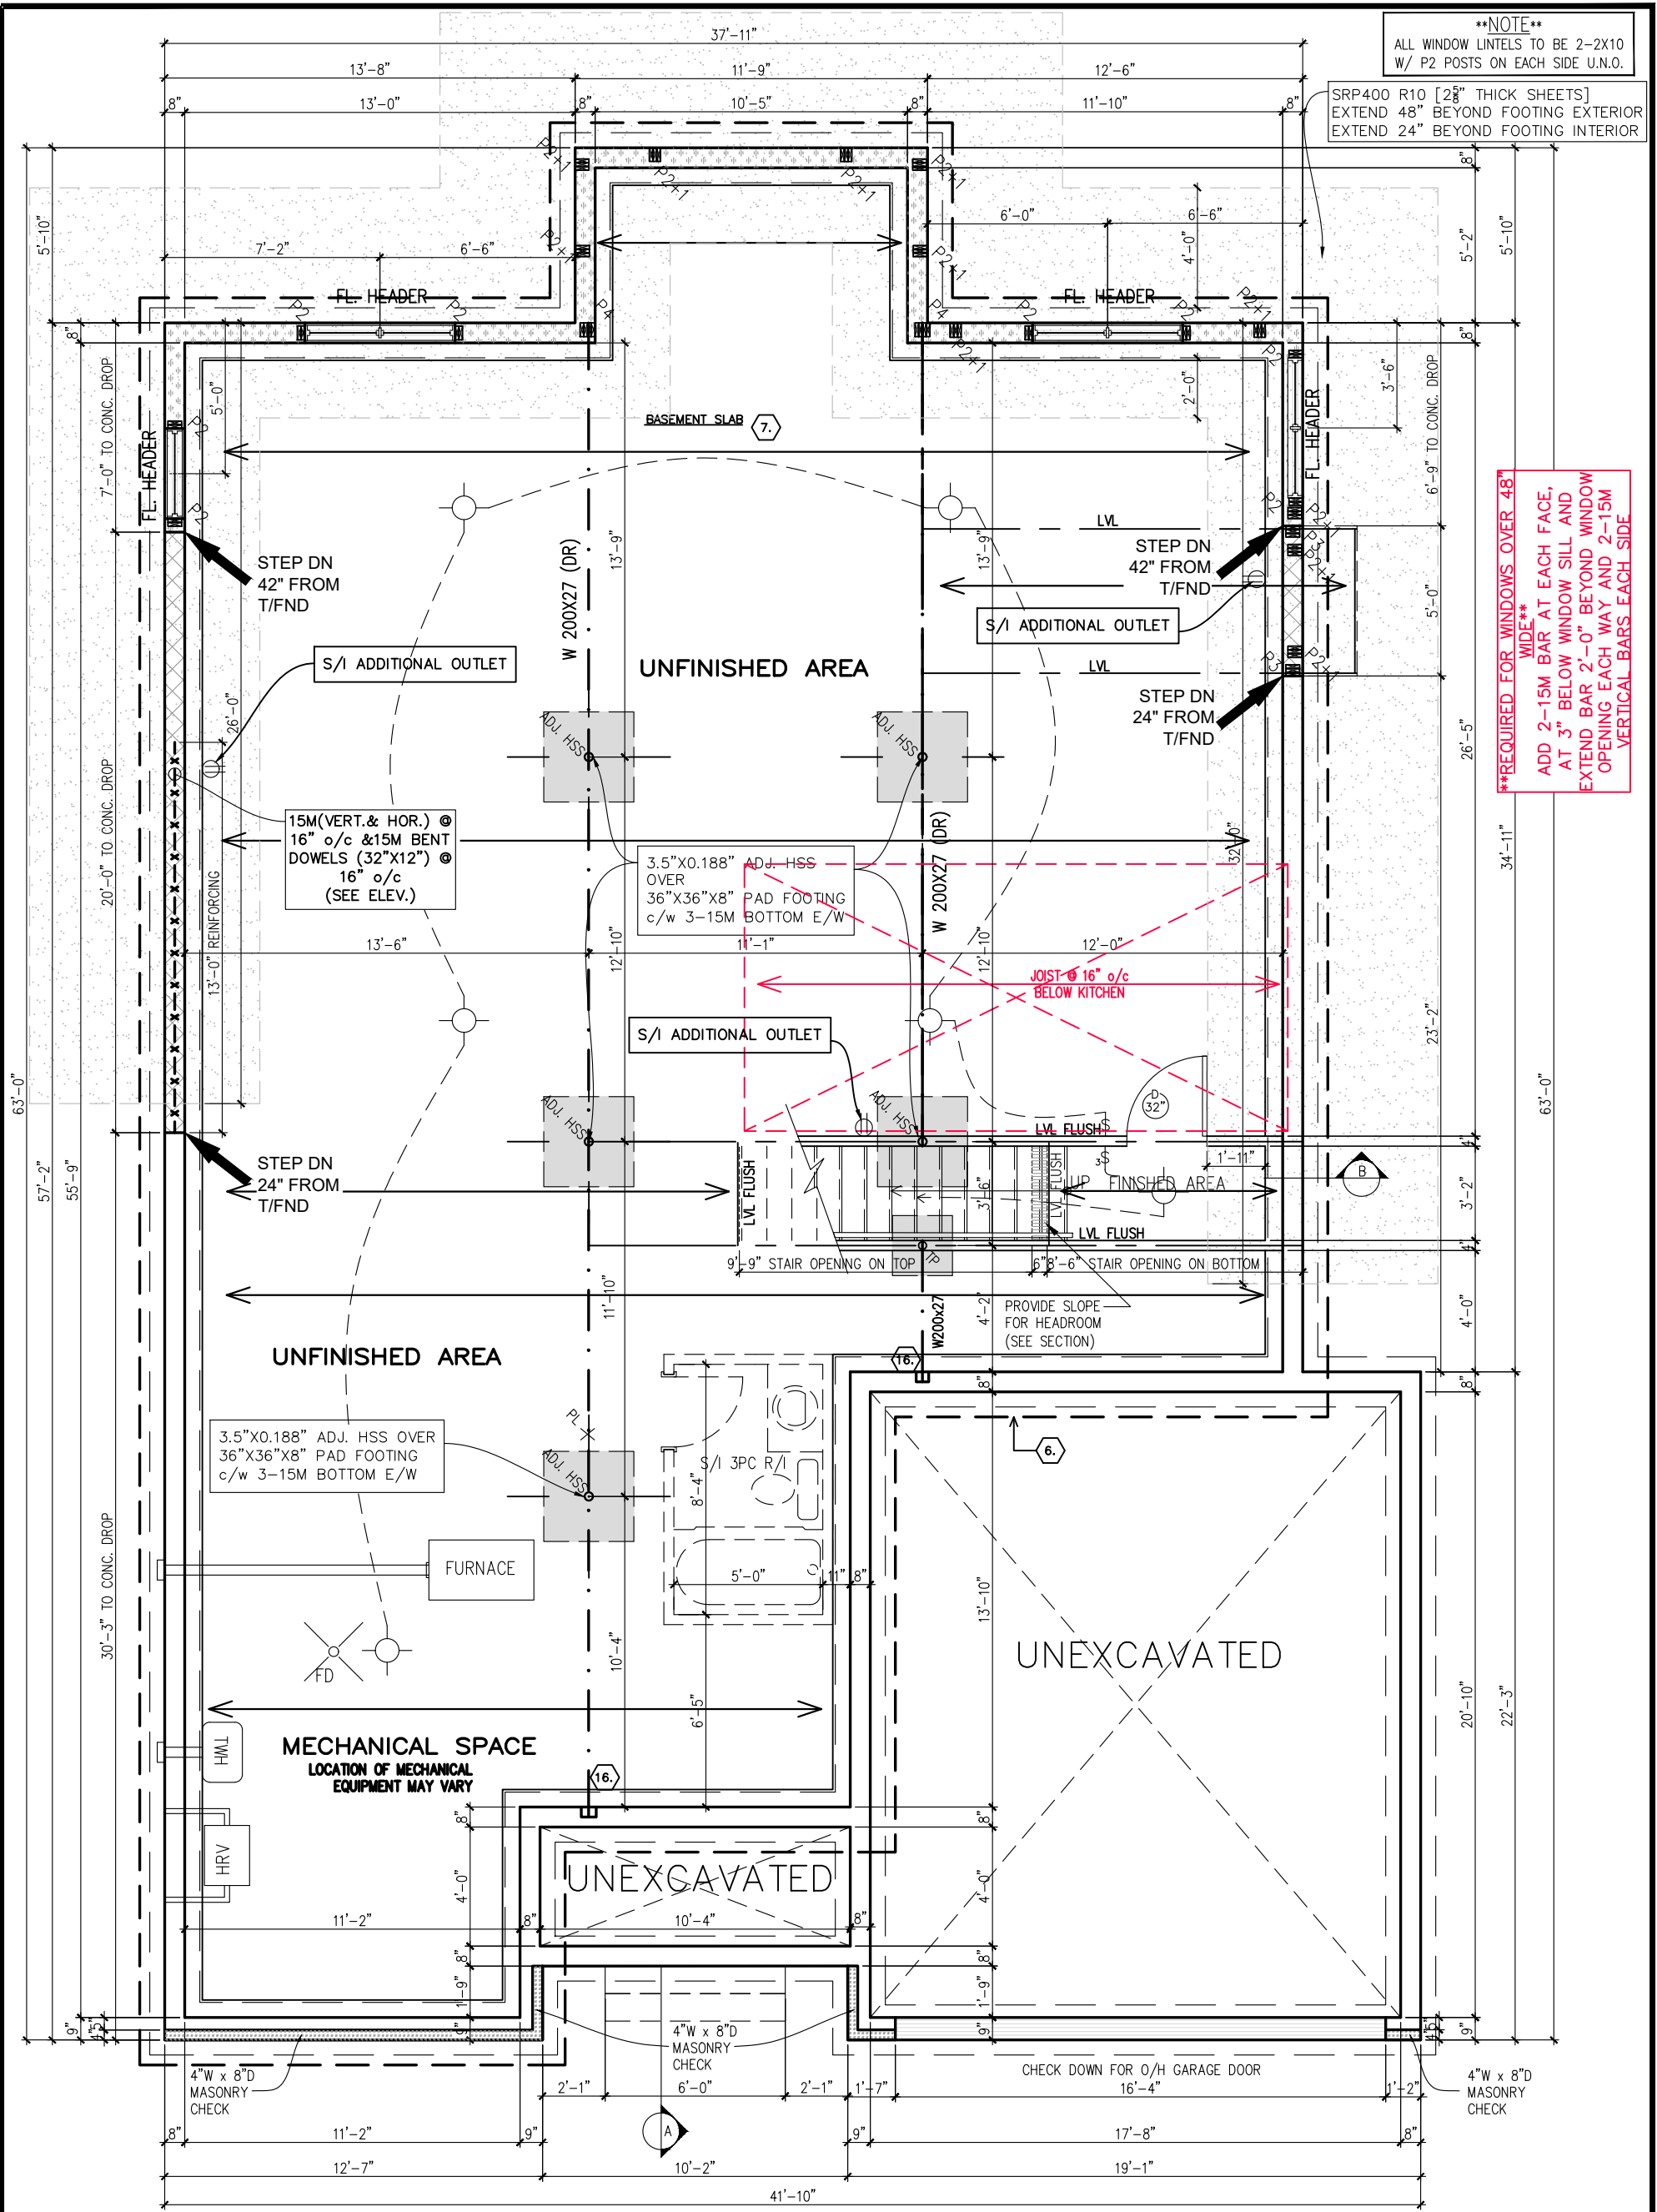

SPRINGFIELD R - 2022

SITE: WHITE TAIL RIDGE PH4

LOT NUMBER: 134

CIVIC ADDRESS:
112 FRANK FISHER CRESCENT

11	FINAL FOR SITE	17/05/24	CB
10	KITCHEN WINDOW REVISED	02/04/24	CB
9	FINAL BLACKLINES - REVISED	26/10/23	CB
8	ISSUED FOR ENGINEERING	12/09/23	CB
7	ISSUED FOR LAYOUTS	30/08/23	CB
6	FOR BEP BLACKLINES	29/08/23	SP
No.	Description	dd/mm/yy	By
REVISIONS			

footprint: B-24

drawn by: SD

date: SEP/12


scale: 3/16"=1'-0"

sheet no: 2/9

D.C.L.-A11

-FLAT CEILINGS THROUGHOUT / NO STIPPLE

-BYPASS SLIDERS FOR ALL SLIDING CLOSET DOORS

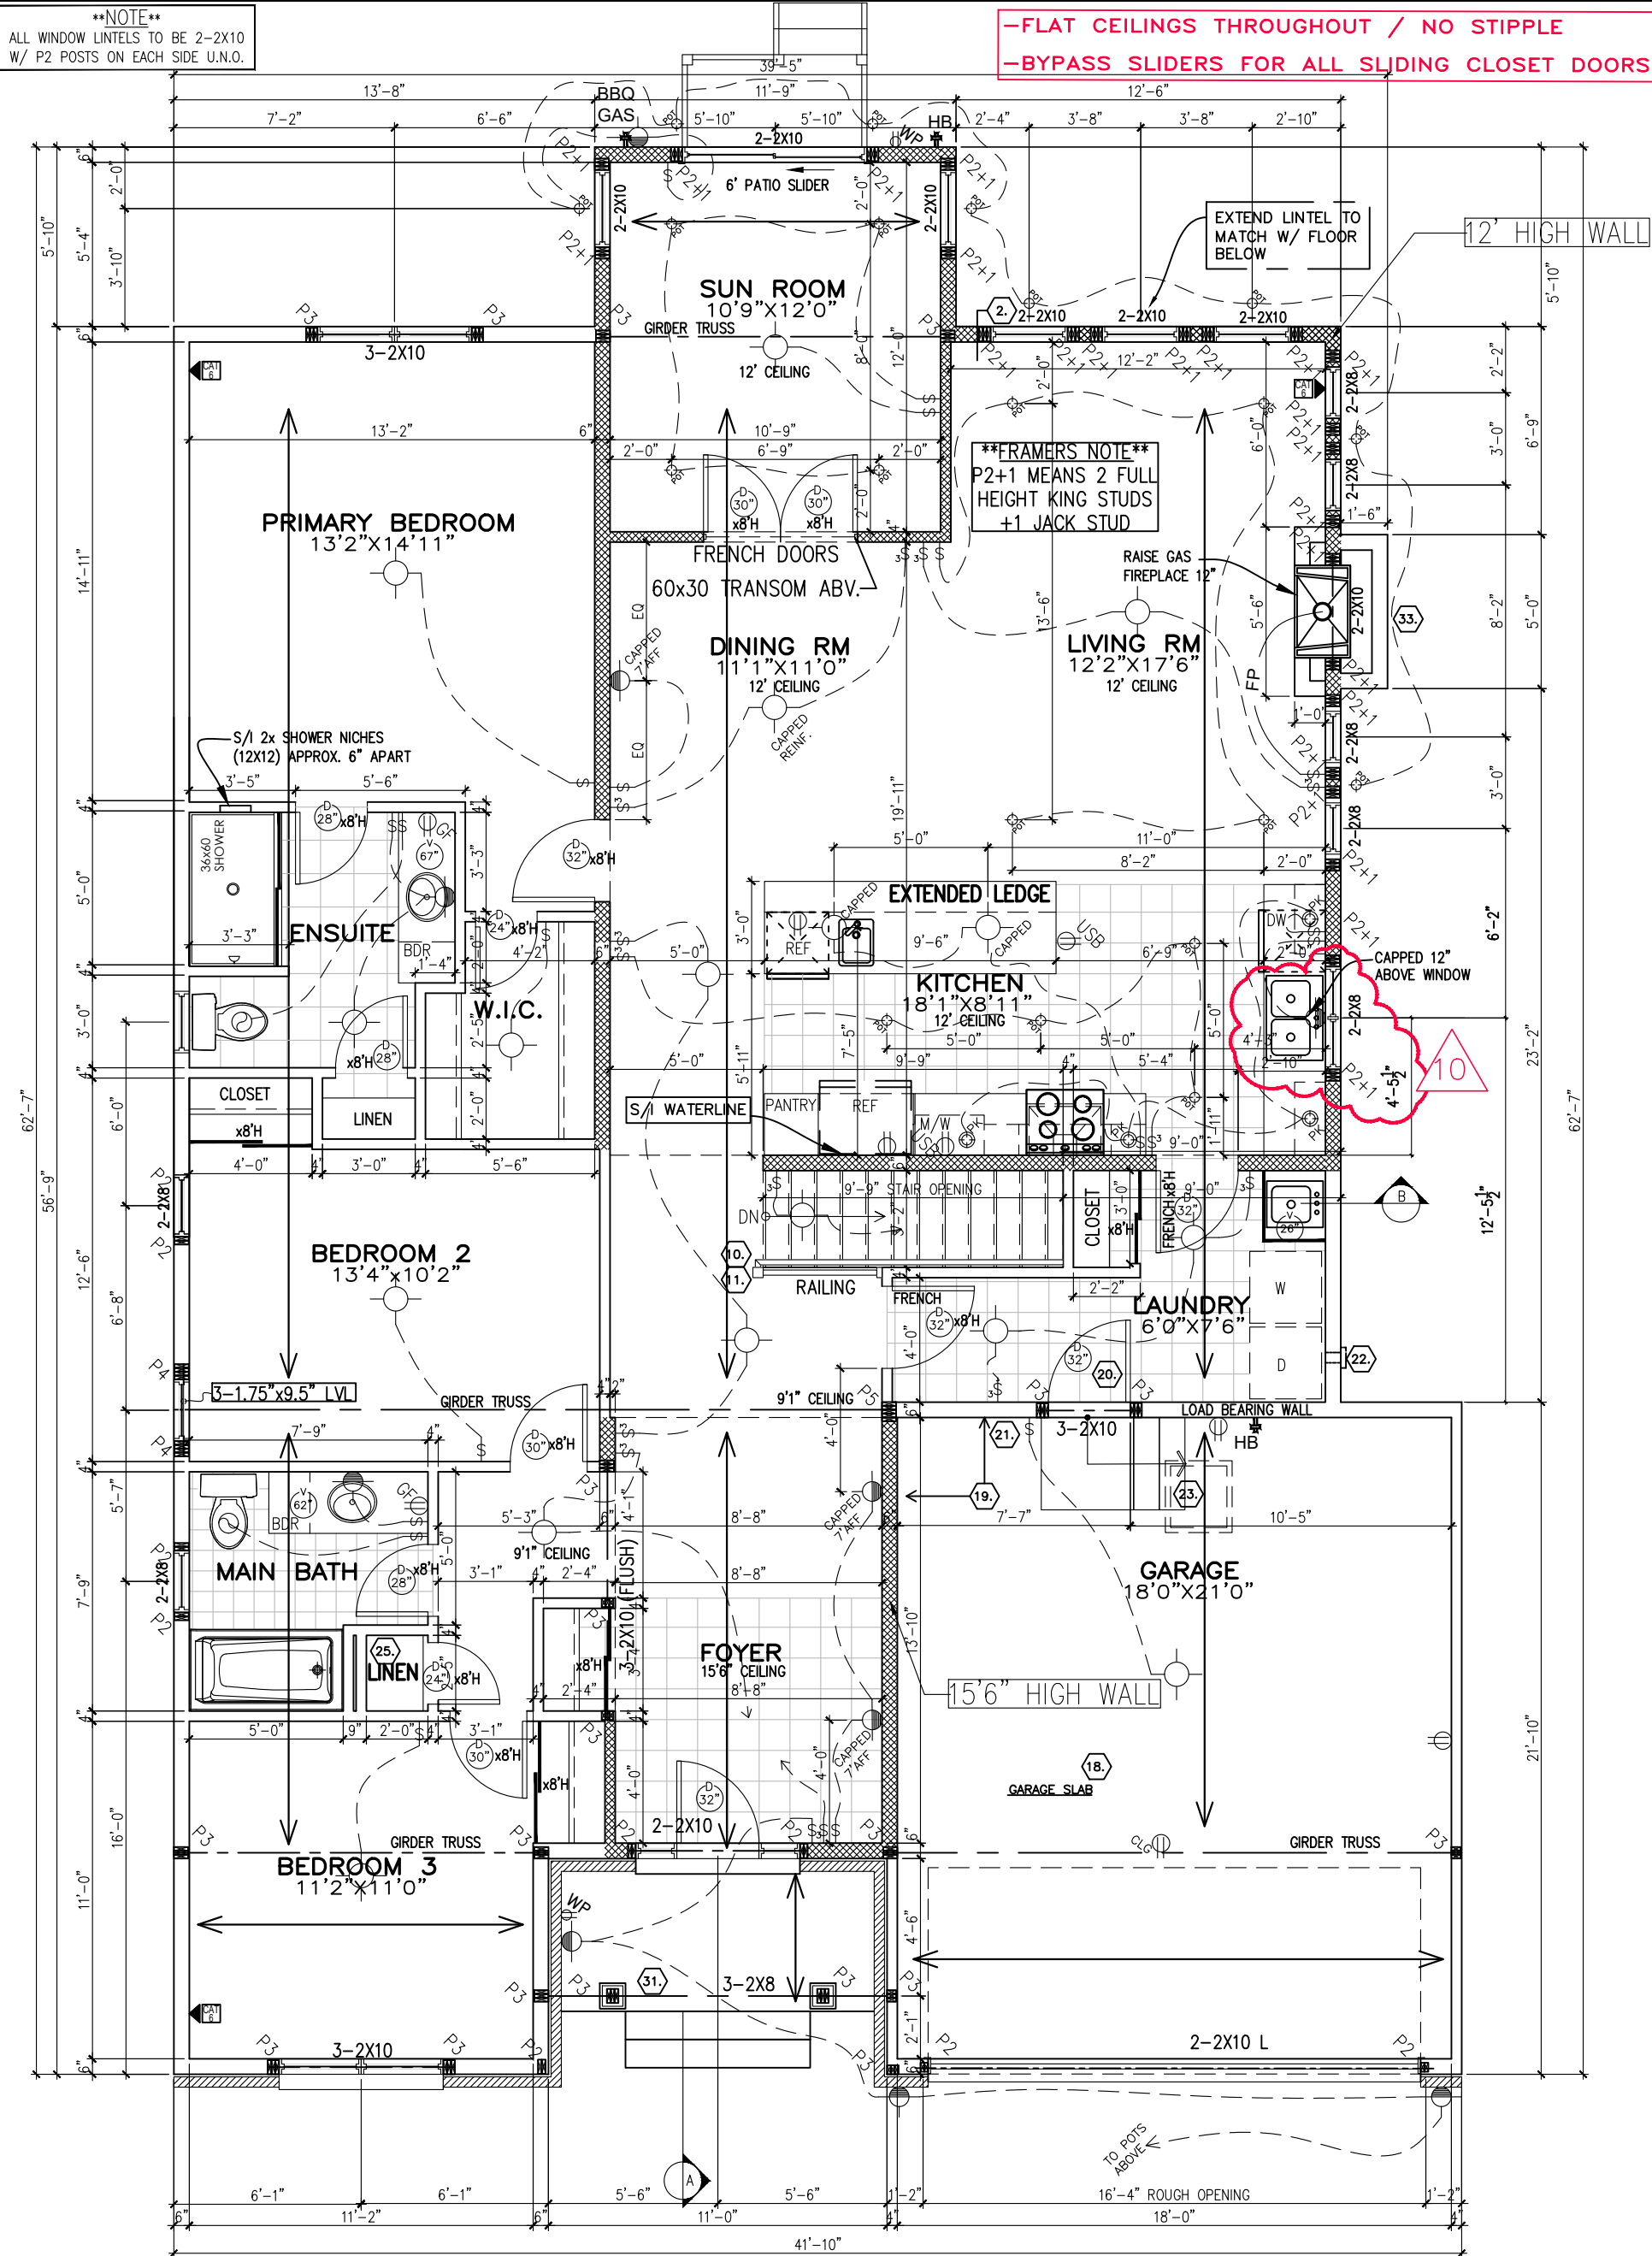

BASEMENT = 25 SQ. FT.
GROUND FLOOR = 1834 SQ. FT.
TOTAL = 1859 SQ. FT.


R ELEVATION





SITE: WHITE TAIL RIDGE PH4	
LOT NUMBER:	134
CIVIC ADDRESS: 112 FRANK FISHER CRESCENT	

11	FINAL FOR SITE	17/05/24	CB
10	KITCHEN WINDOW REVISED	02/04/24	CB
9	FINAL BLACKLINES – REVISED	26/10/23	CB
8	ISSUED FOR ENGINEERING	12/09/23	CB
7	ISSUED FOR LAYOUTS	30/08/23	CB
6	FOR BEP BLACKLINES	29/08/23	SP
No.	Description	dd/mm/yy	By
REVISIONS			

footprint: B-24	
drawn by: SD	
date: SEP/12	
scale: 3/16"=1'-0"	
sheet no:	
D.C.L.-A11	

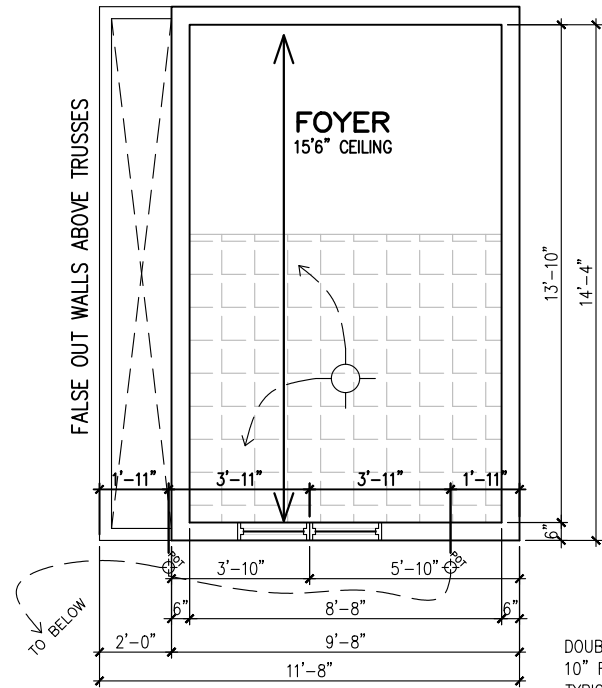

FOYER TOWER WITH SUN ROOM

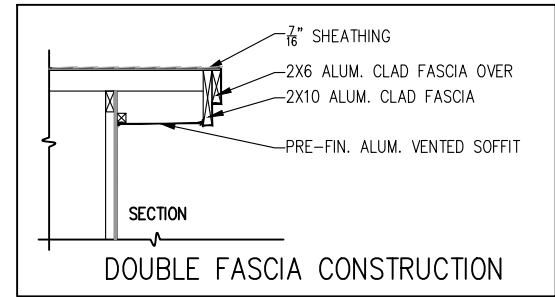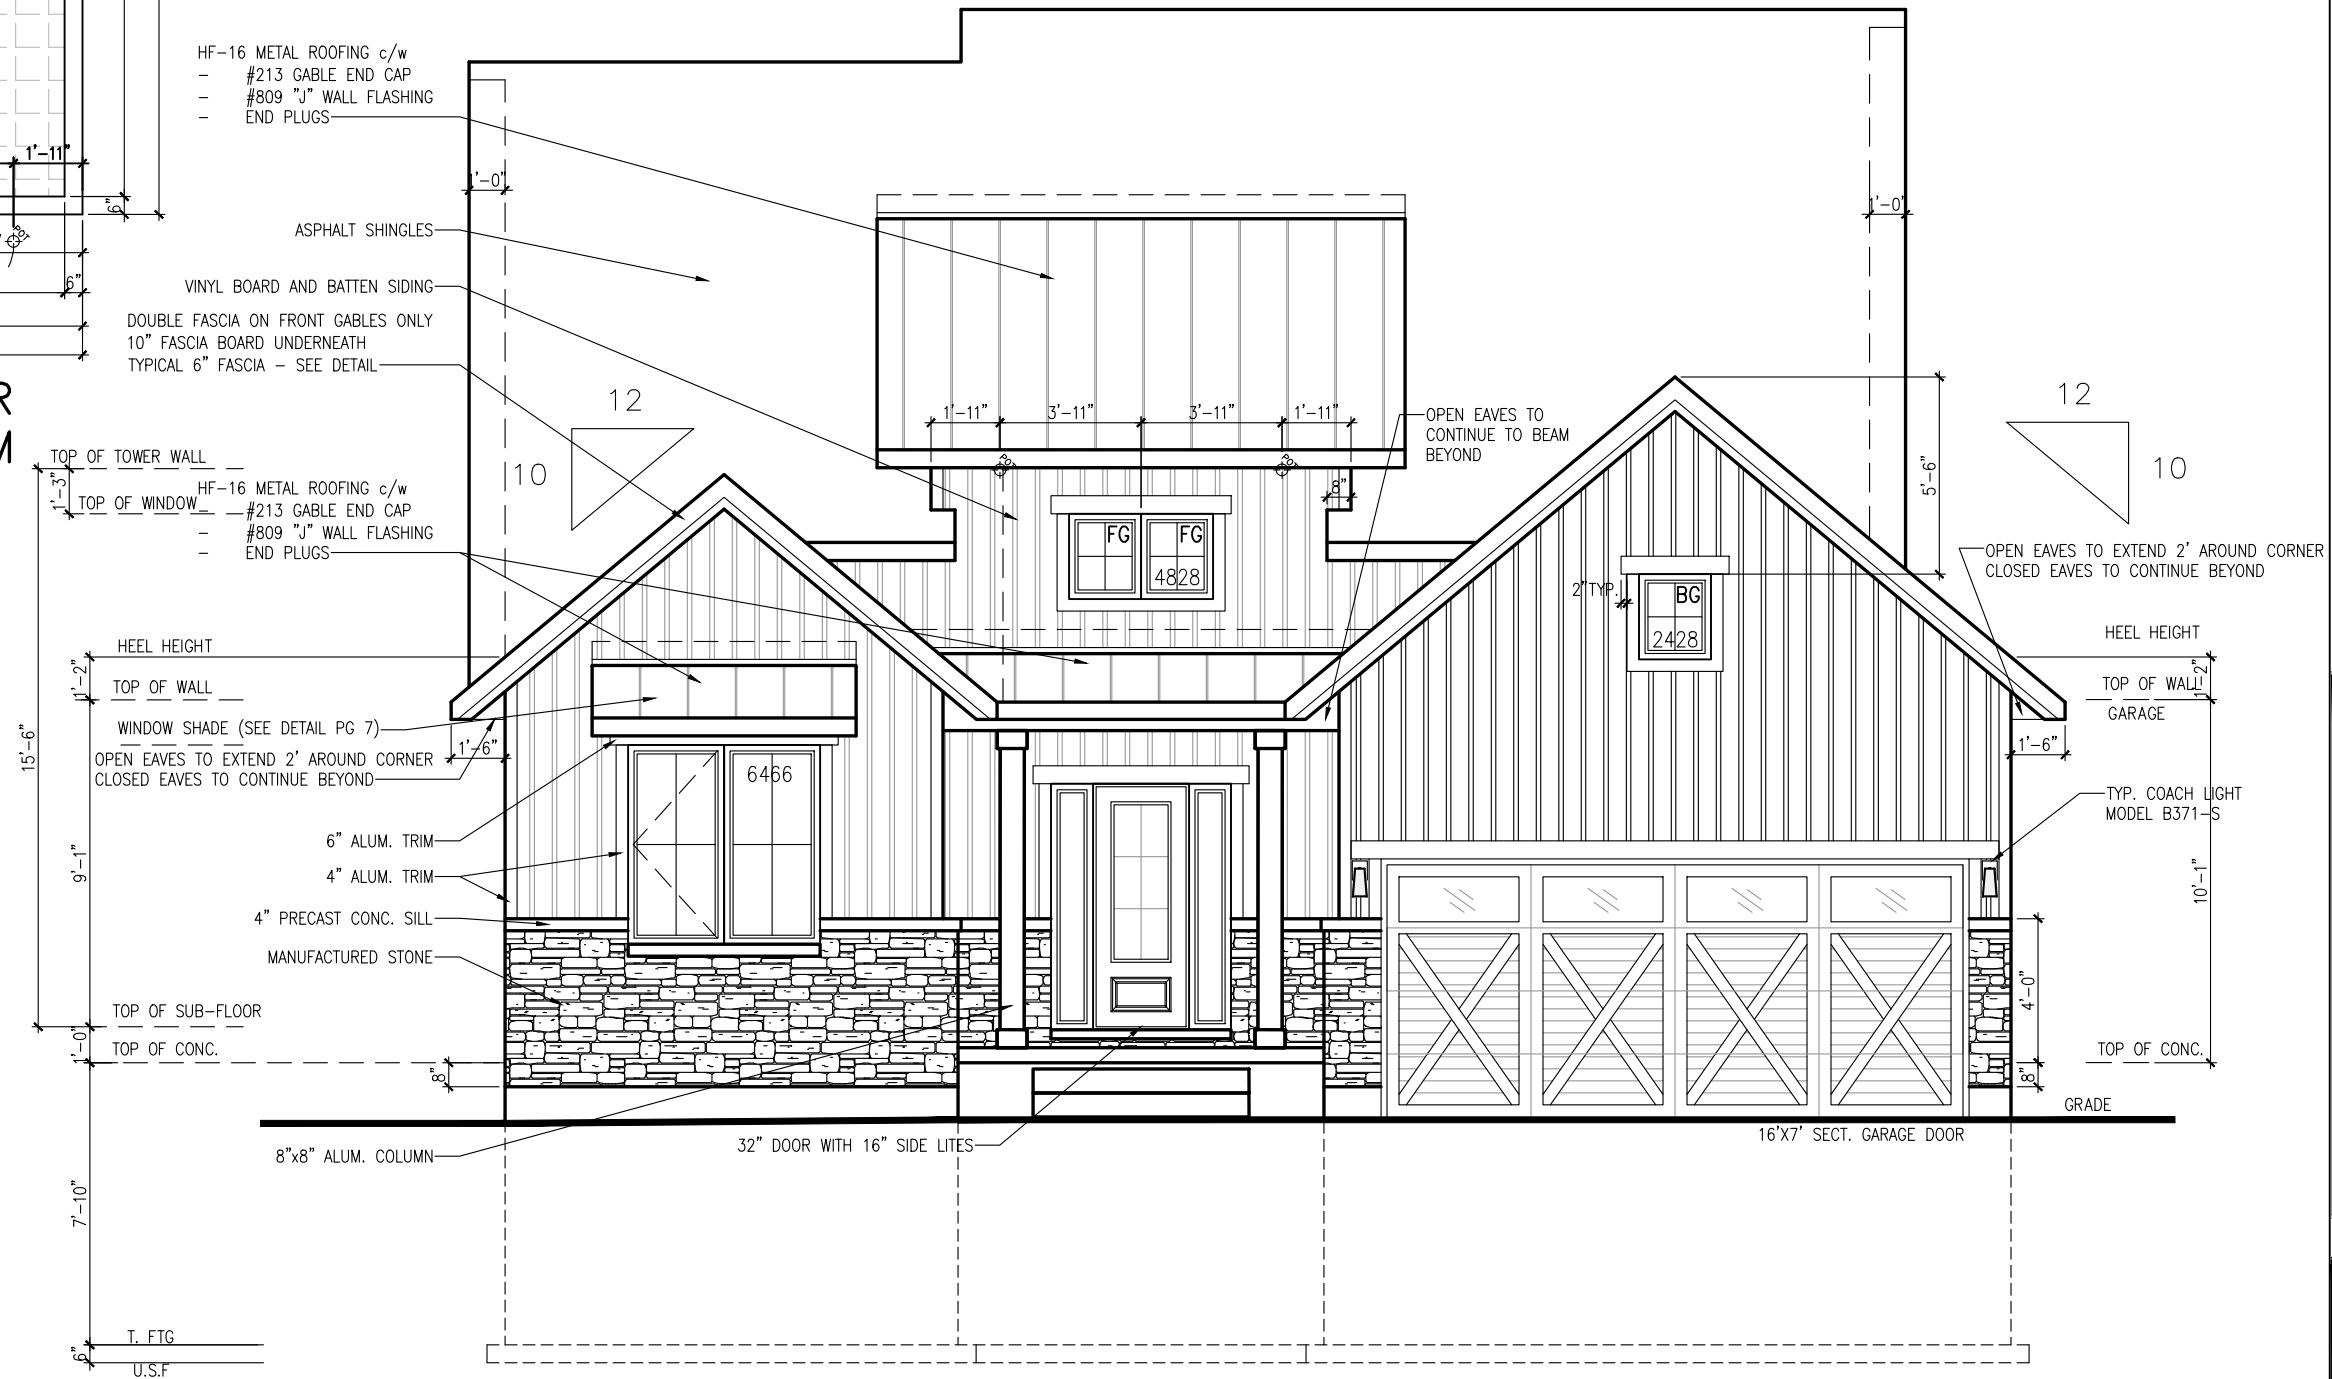

footprint:	B-24
drawn by:	SD
date:	SEP/12
scale:	3/16" = 1'-0"
sheet no:	4
D.C.L. - A11	9

No.	Description	dd/mm/yy	By
11	FINAL FOR SITE	17/05/24	CB
10	KITCHEN WINDOW REVISED	02/04/24	CB
9	FINAL BLACKLINES - REVISED	26/10/23	CB
8	ISSUED FOR ENGINEERING	12/09/23	CB
7	ISSUED FOR LAYOUTS	30/08/23	CB
6	FOR BEP BLACKLINES	29/08/23	SP
REVISIONS			

SPRINGFIELD R - 2022


SITE: WHITE TAIL RIDGE PH4

LOT NUMBER: 134

CIVIC ADDRESS: 112 FRANK FISHER CRESCENT

PHOENIX HOMES

FRONT ELEVATION R

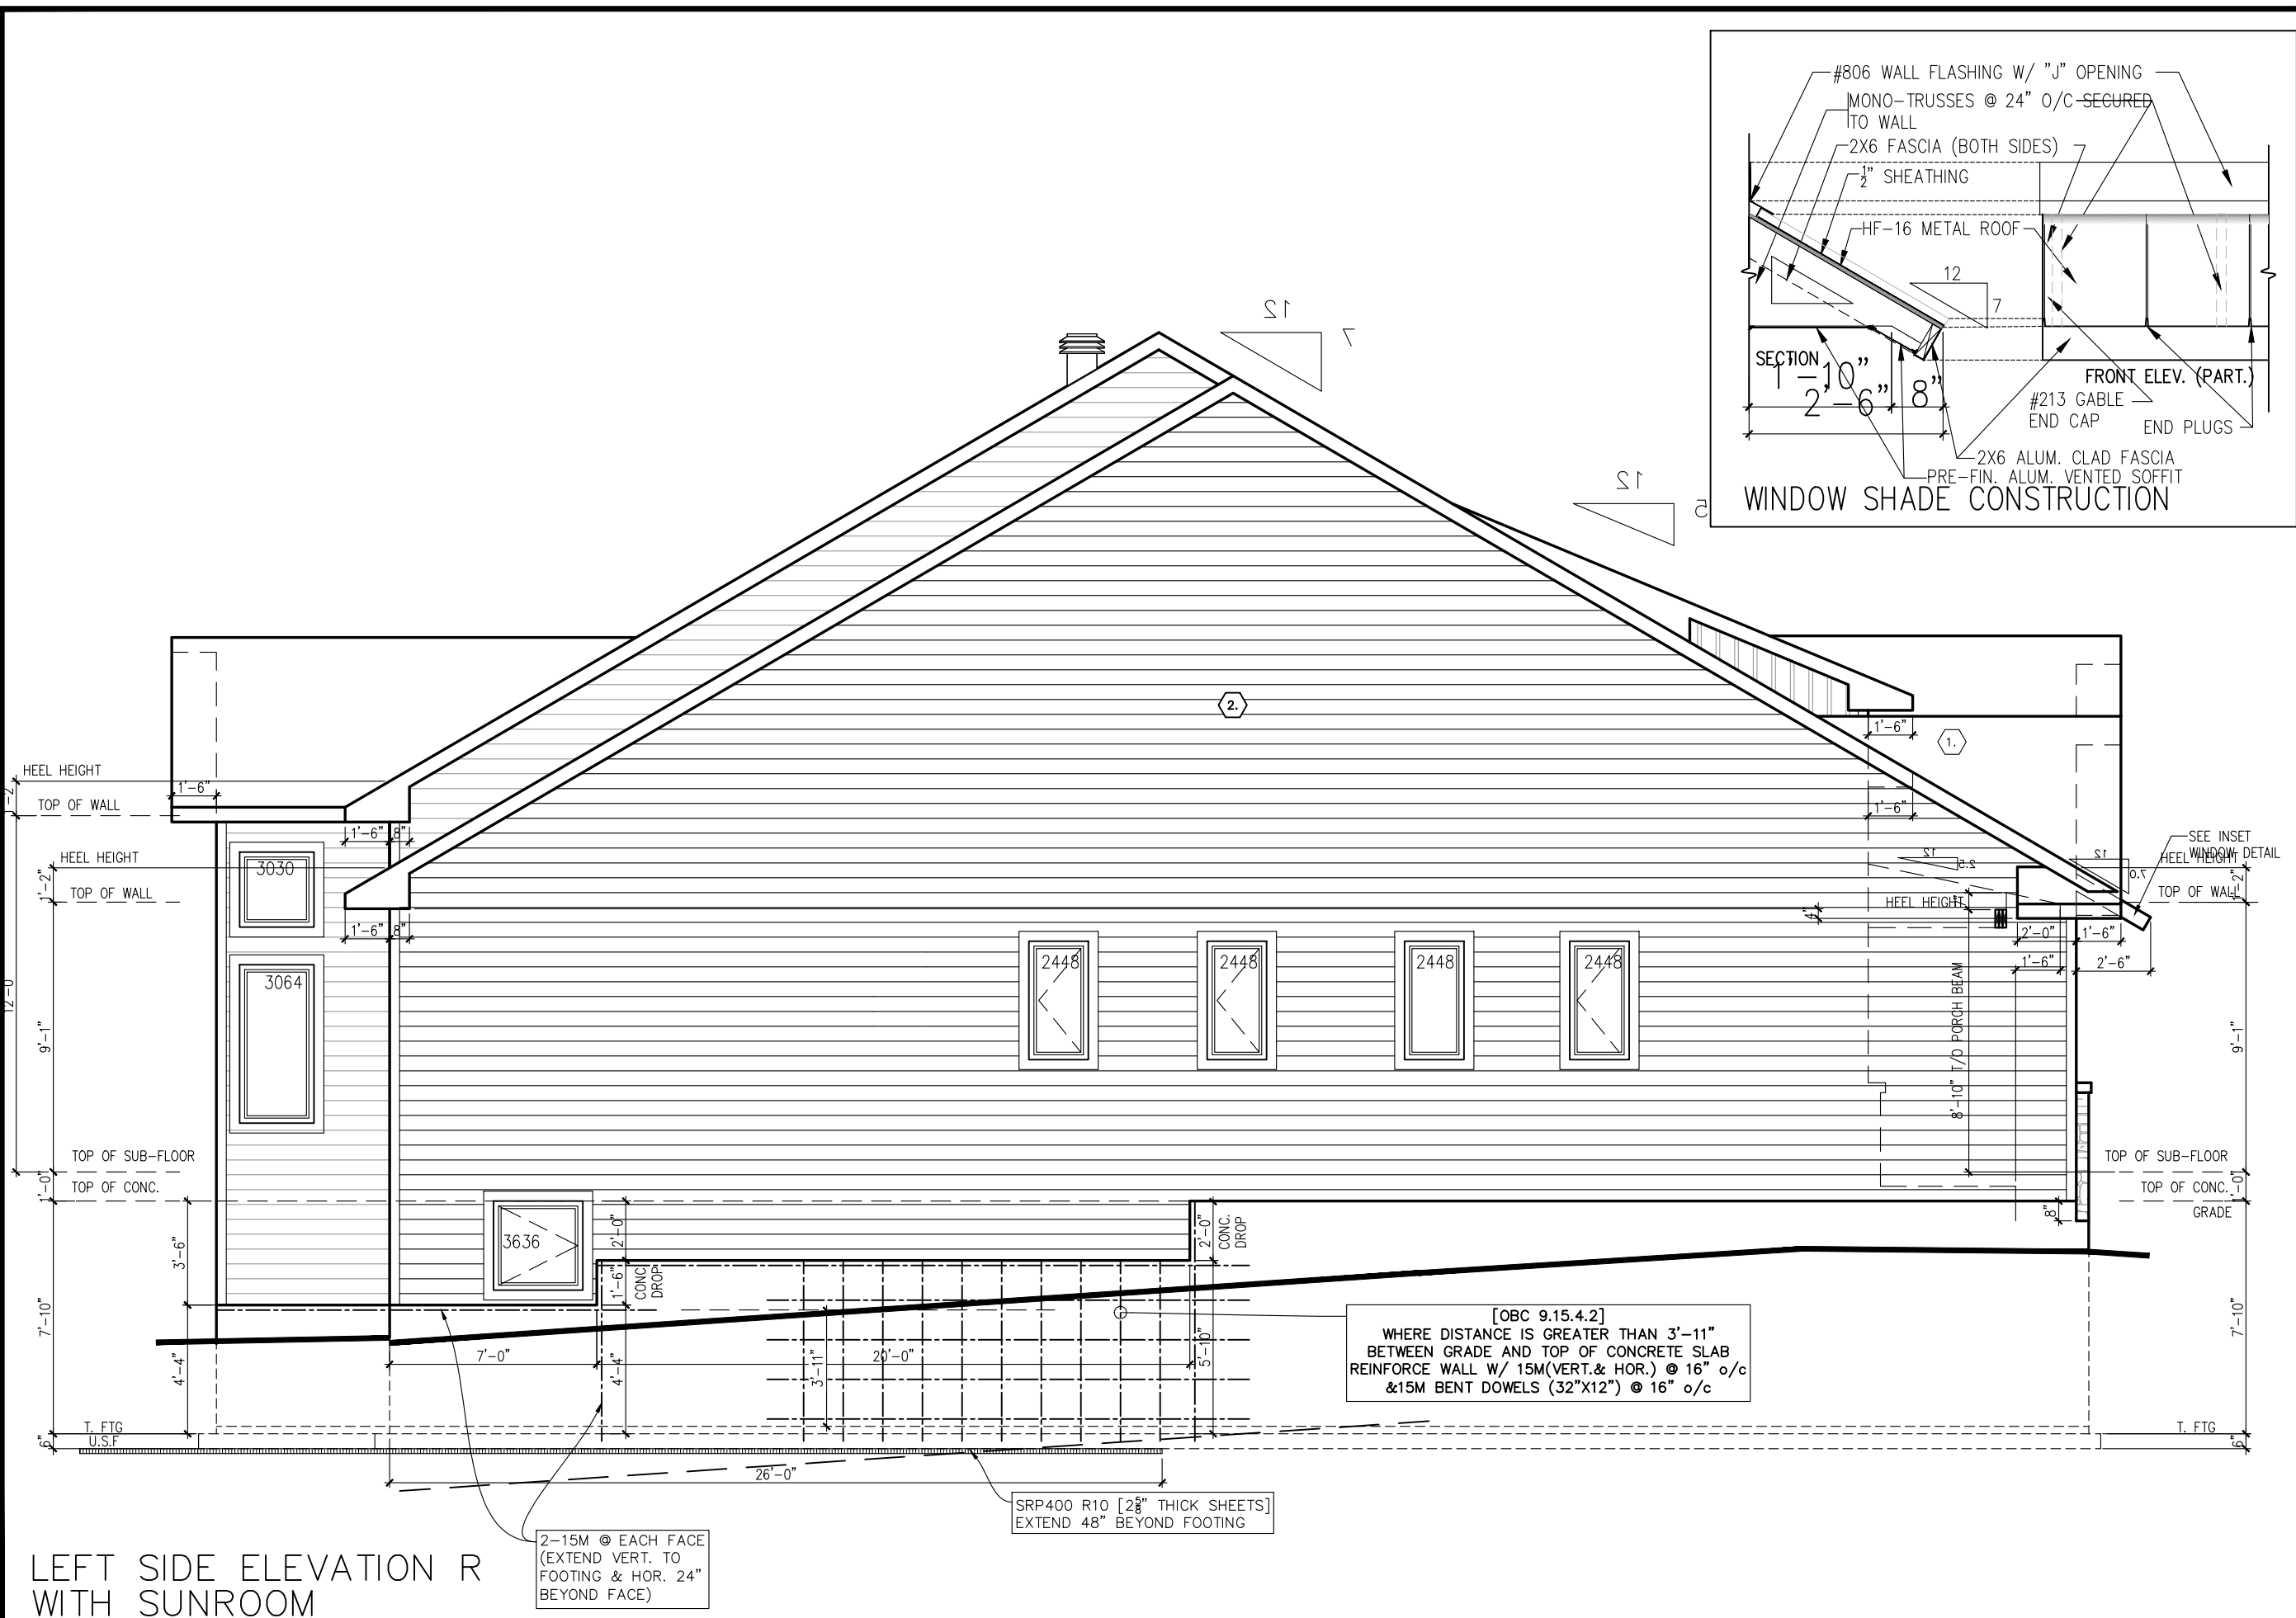

footprint: B-24

drawn by: SD

date: SEP/12

scale: 3/16"=1'-0"

sheet no: 6/9

D.C.L.-A11

	CB	CB	CB	CB	CB	SP	By
11	FINAL FOR SITE	17/05/24					
10	KITCHEN WINDOW REVISED	02/04/24					
9	FINAL BLACKLINES - REVISED	26/10/23					
8	ISSUED FOR ENGINEERING	12/09/23					
7	ISSUED FOR LAYOUTS	30/08/23					
6	FOR BEP BLACKLINES	29/08/23					
No.	Description	da/mm/yy					
REVISIONS							


SPRINGFIELD R - 2022

SITE: WHITE TAIL RIDGE PH4


LOT NUMBER: 134

CIVIC ADDRESS: 112 FRANK FISHER CRESCENT

PHOENIX HOMES

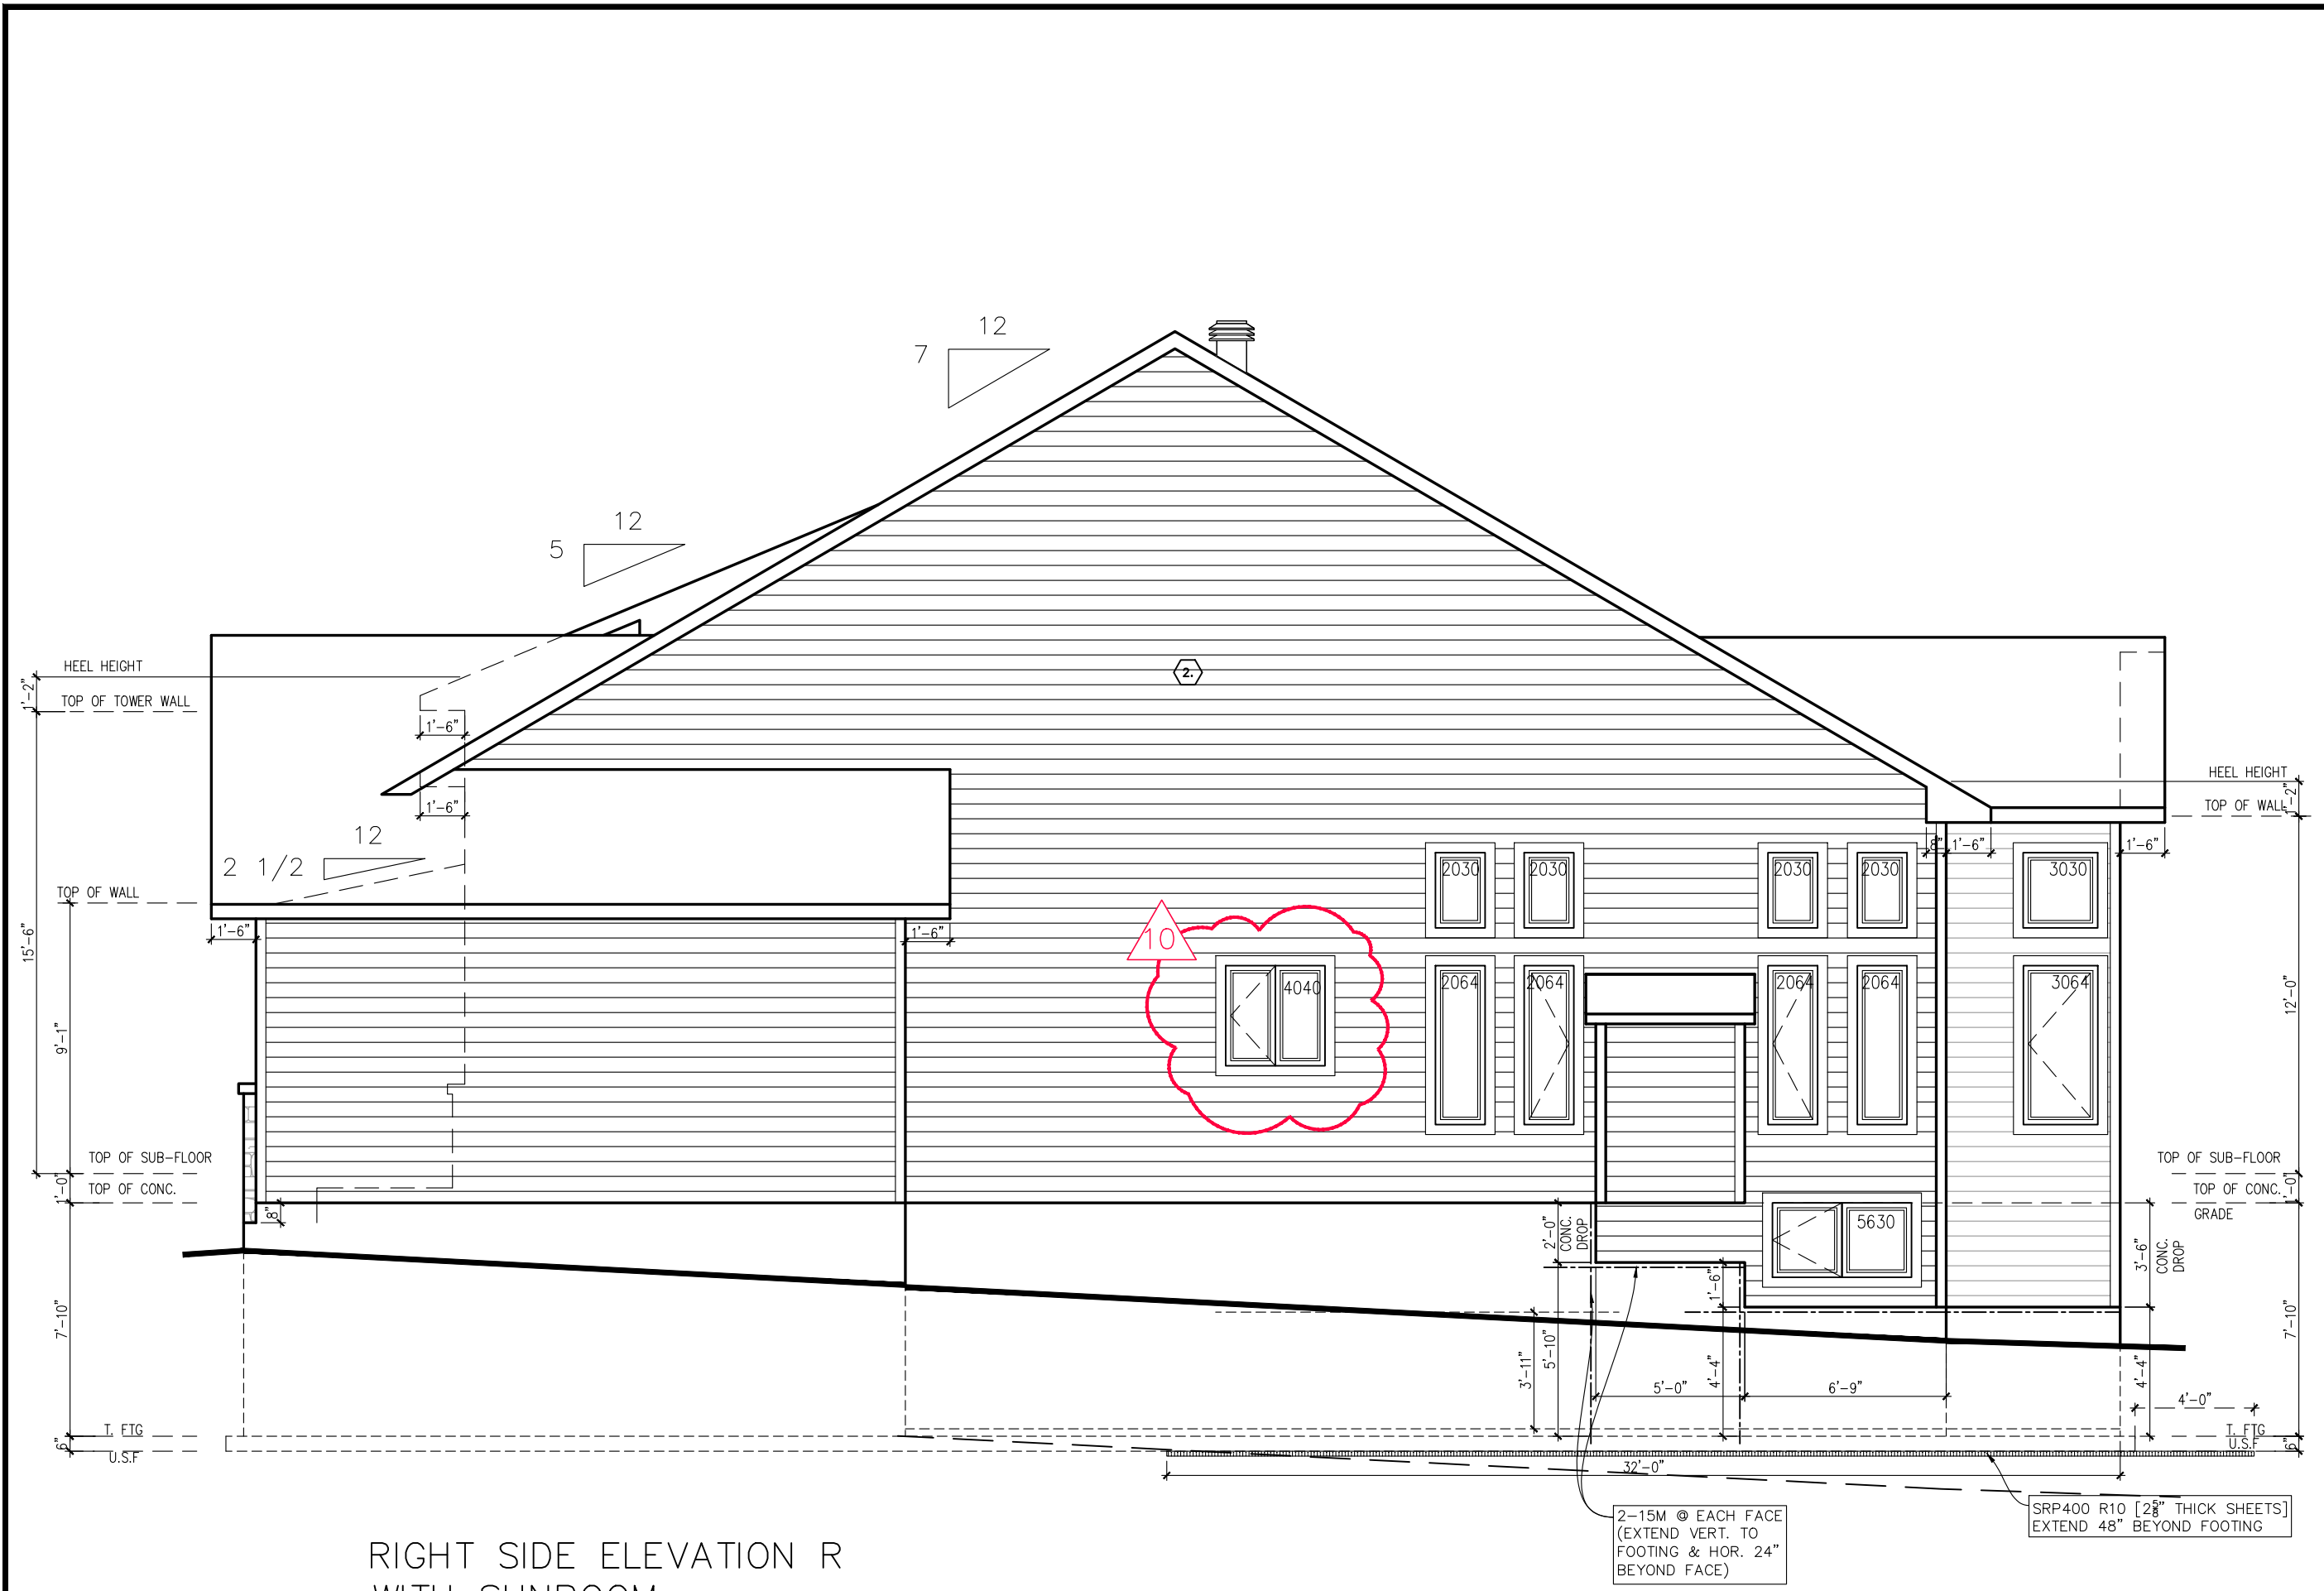

RIGHT SIDE ELEVATION R
WITH SUNROOM

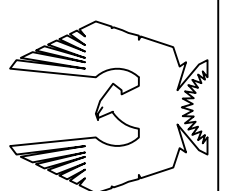

PHOENIX HOMES

SPRINGFIELD R - 2022

SITE: WHITE TAIL RIDGE PH4

LOT NUMBER: 134

CIVIC ADDRESS:
112 FRANK FISHER CRESCENT

11	FINAL FOR SITE	17/05/24	CB
10	KITCHEN WINDOW REVISED	02/04/24	CB
9	FINAL BLACKLINES - REVISED	26/10/23	CB
8	ISSUED FOR ENGINEERING	12/09/23	CB
7	ISSUED FOR LAYOUTS	30/08/23	CB
6	FOR BEP BLACKLINES	29/08/23	SP
No.	Description	dd/mm/yy	By
REVISIONS			

footprint: B-24

drawn by: SD


date: SEP/12

scale: 3/16"=1'-0"

sheet no: 7


D.C.L. - A11

9

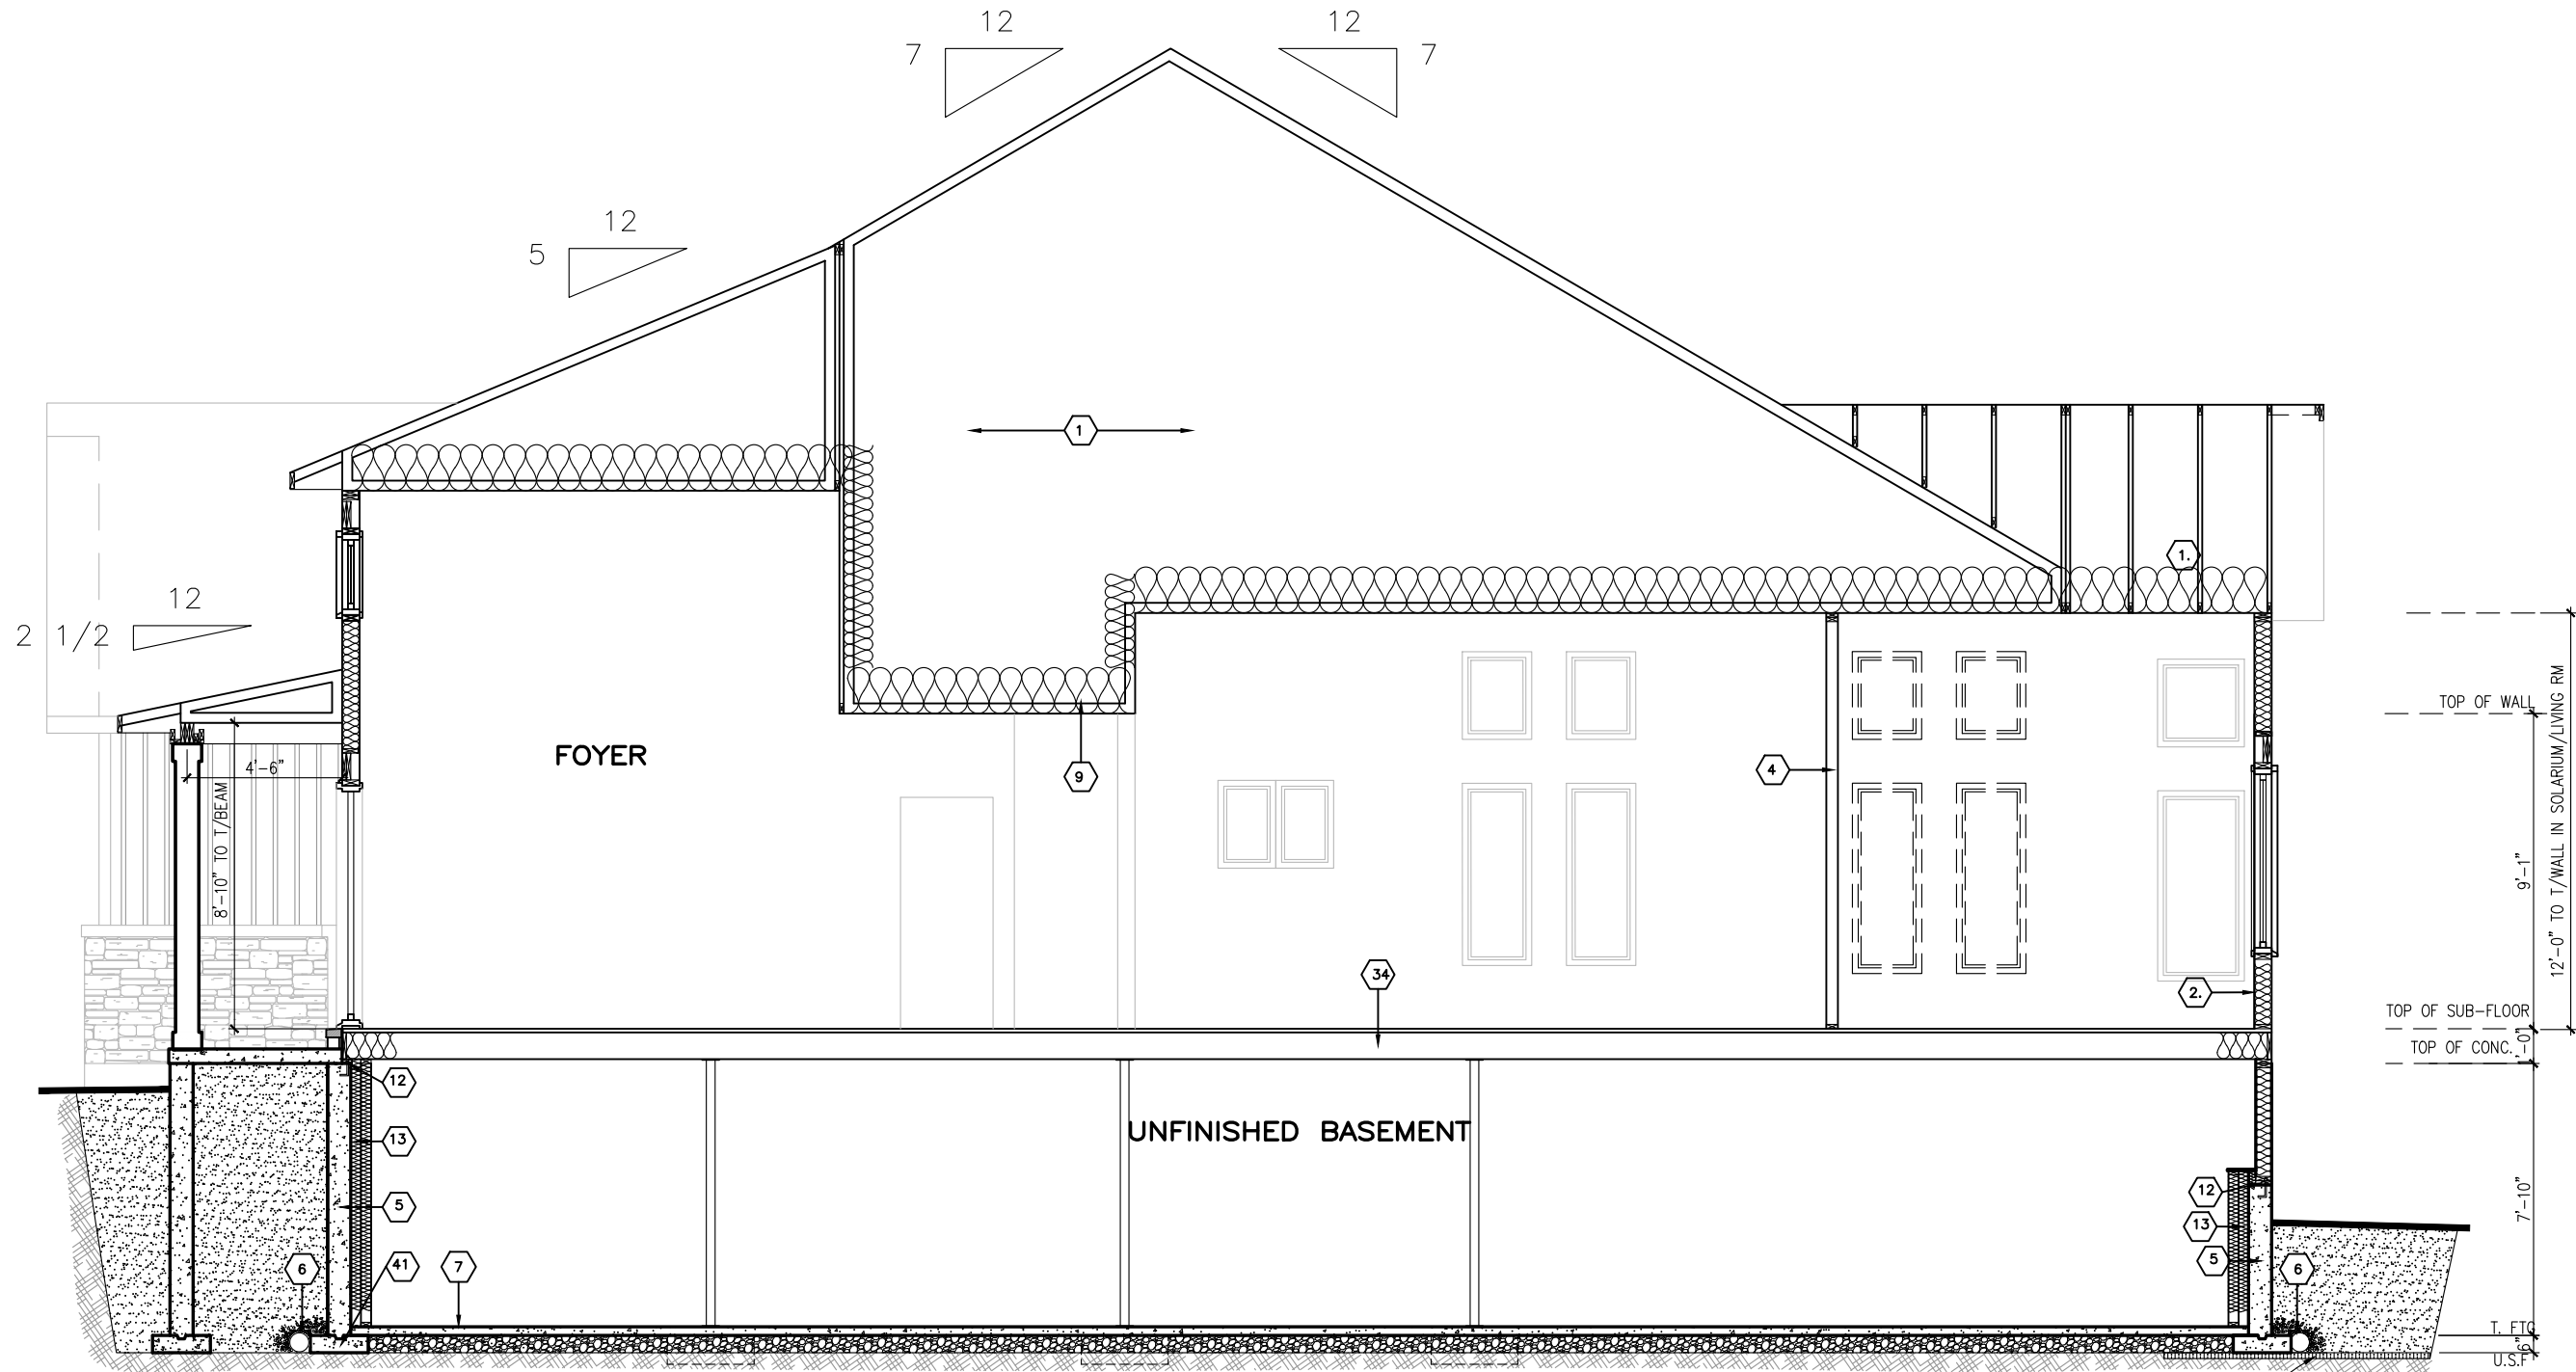

ELEVATION R
SECTION A

SRP400 R10 [2 $\frac{3}{8}$ " THICK SHEETS]
EXTEND 48" BEYOND FOOTING EXTERIOR
EXTEND 24" BEYOND FOOTING INTERIOR

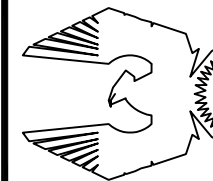

PHOENIX HOMES

SPRINGFIELD R - 2022

SITE: WHITE TAIL RIDGE PH4


LOT NUMBER:

134


CIVIC ADDRESS:
112 FRANK FISHER CRESCENT

11	FINAL FOR SITE	17/05/24	CB
10	KITCHEN WINDOW REVISED	02/04/24	CB
9	FINAL BLACKLINES - REVISED	26/10/23	CB
8	ISSUED FOR ENGINEERING	12/09/23	CB
7	ISSUED FOR LAYOUTS	30/08/23	CB
6	FOR BEP BLACKLINES	29/08/23	SP
No.	Description	dd/mm/yy	By
REVISIONS			

footprint:	B-24
drawn by:	SD
date:	SEP/12
scale:	3/16"=1'-0"
sheet no:	D.C.L. - A11
8 9	

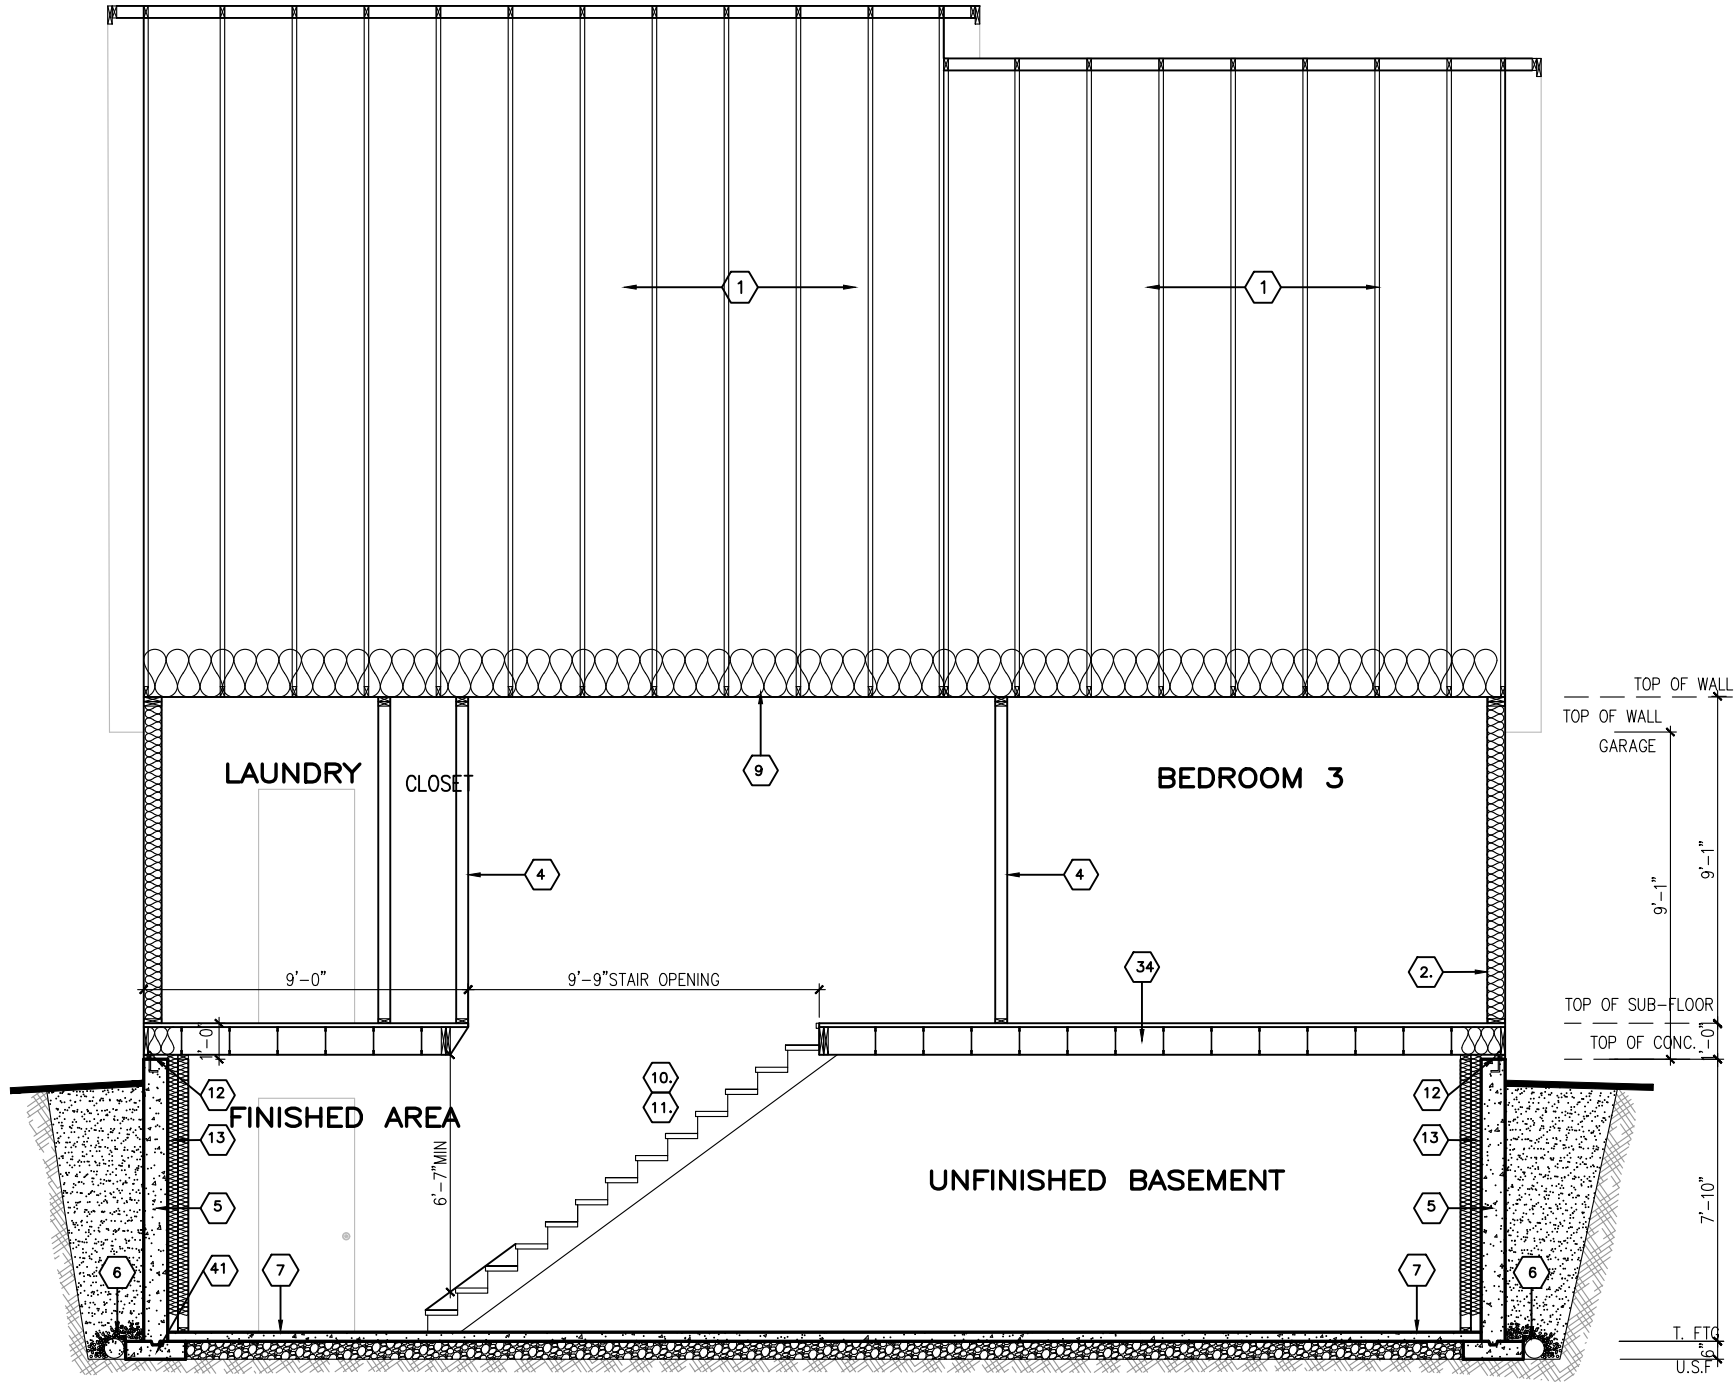

ELEVATION R
SECTION B

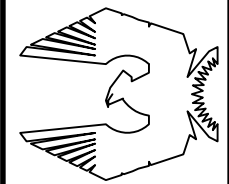

PHOENIX HOMES

SPRINGFIELD R - 2022

SITE: WHITE TAIL RIDGE PH4

LOT NUMBER:

134

CIVIC ADDRESS:
112 FRANK FISHER CRESCENT

No.	Description	REVISIONS	dd/mm/yy	By
11	FINAL FOR SITE		17/05/24	CB
10	KITCHEN WINDOW REVISED		02/04/24	CB
9	FINAL BLACKLINES - REVISED		26/10/23	CB
8	ISSUED FOR ENGINEERING		12/09/23	CB
7	ISSUED FOR LAYOUTS		30/08/23	CB
6	FOR BEP BLACKLINES		29/08/23	SP

footprint:	B-24
drawn by:	SD
date:	SEP/12
scale:	3/16"=1'-0"
sheet no:	D.C.L.-A11
	9/9