


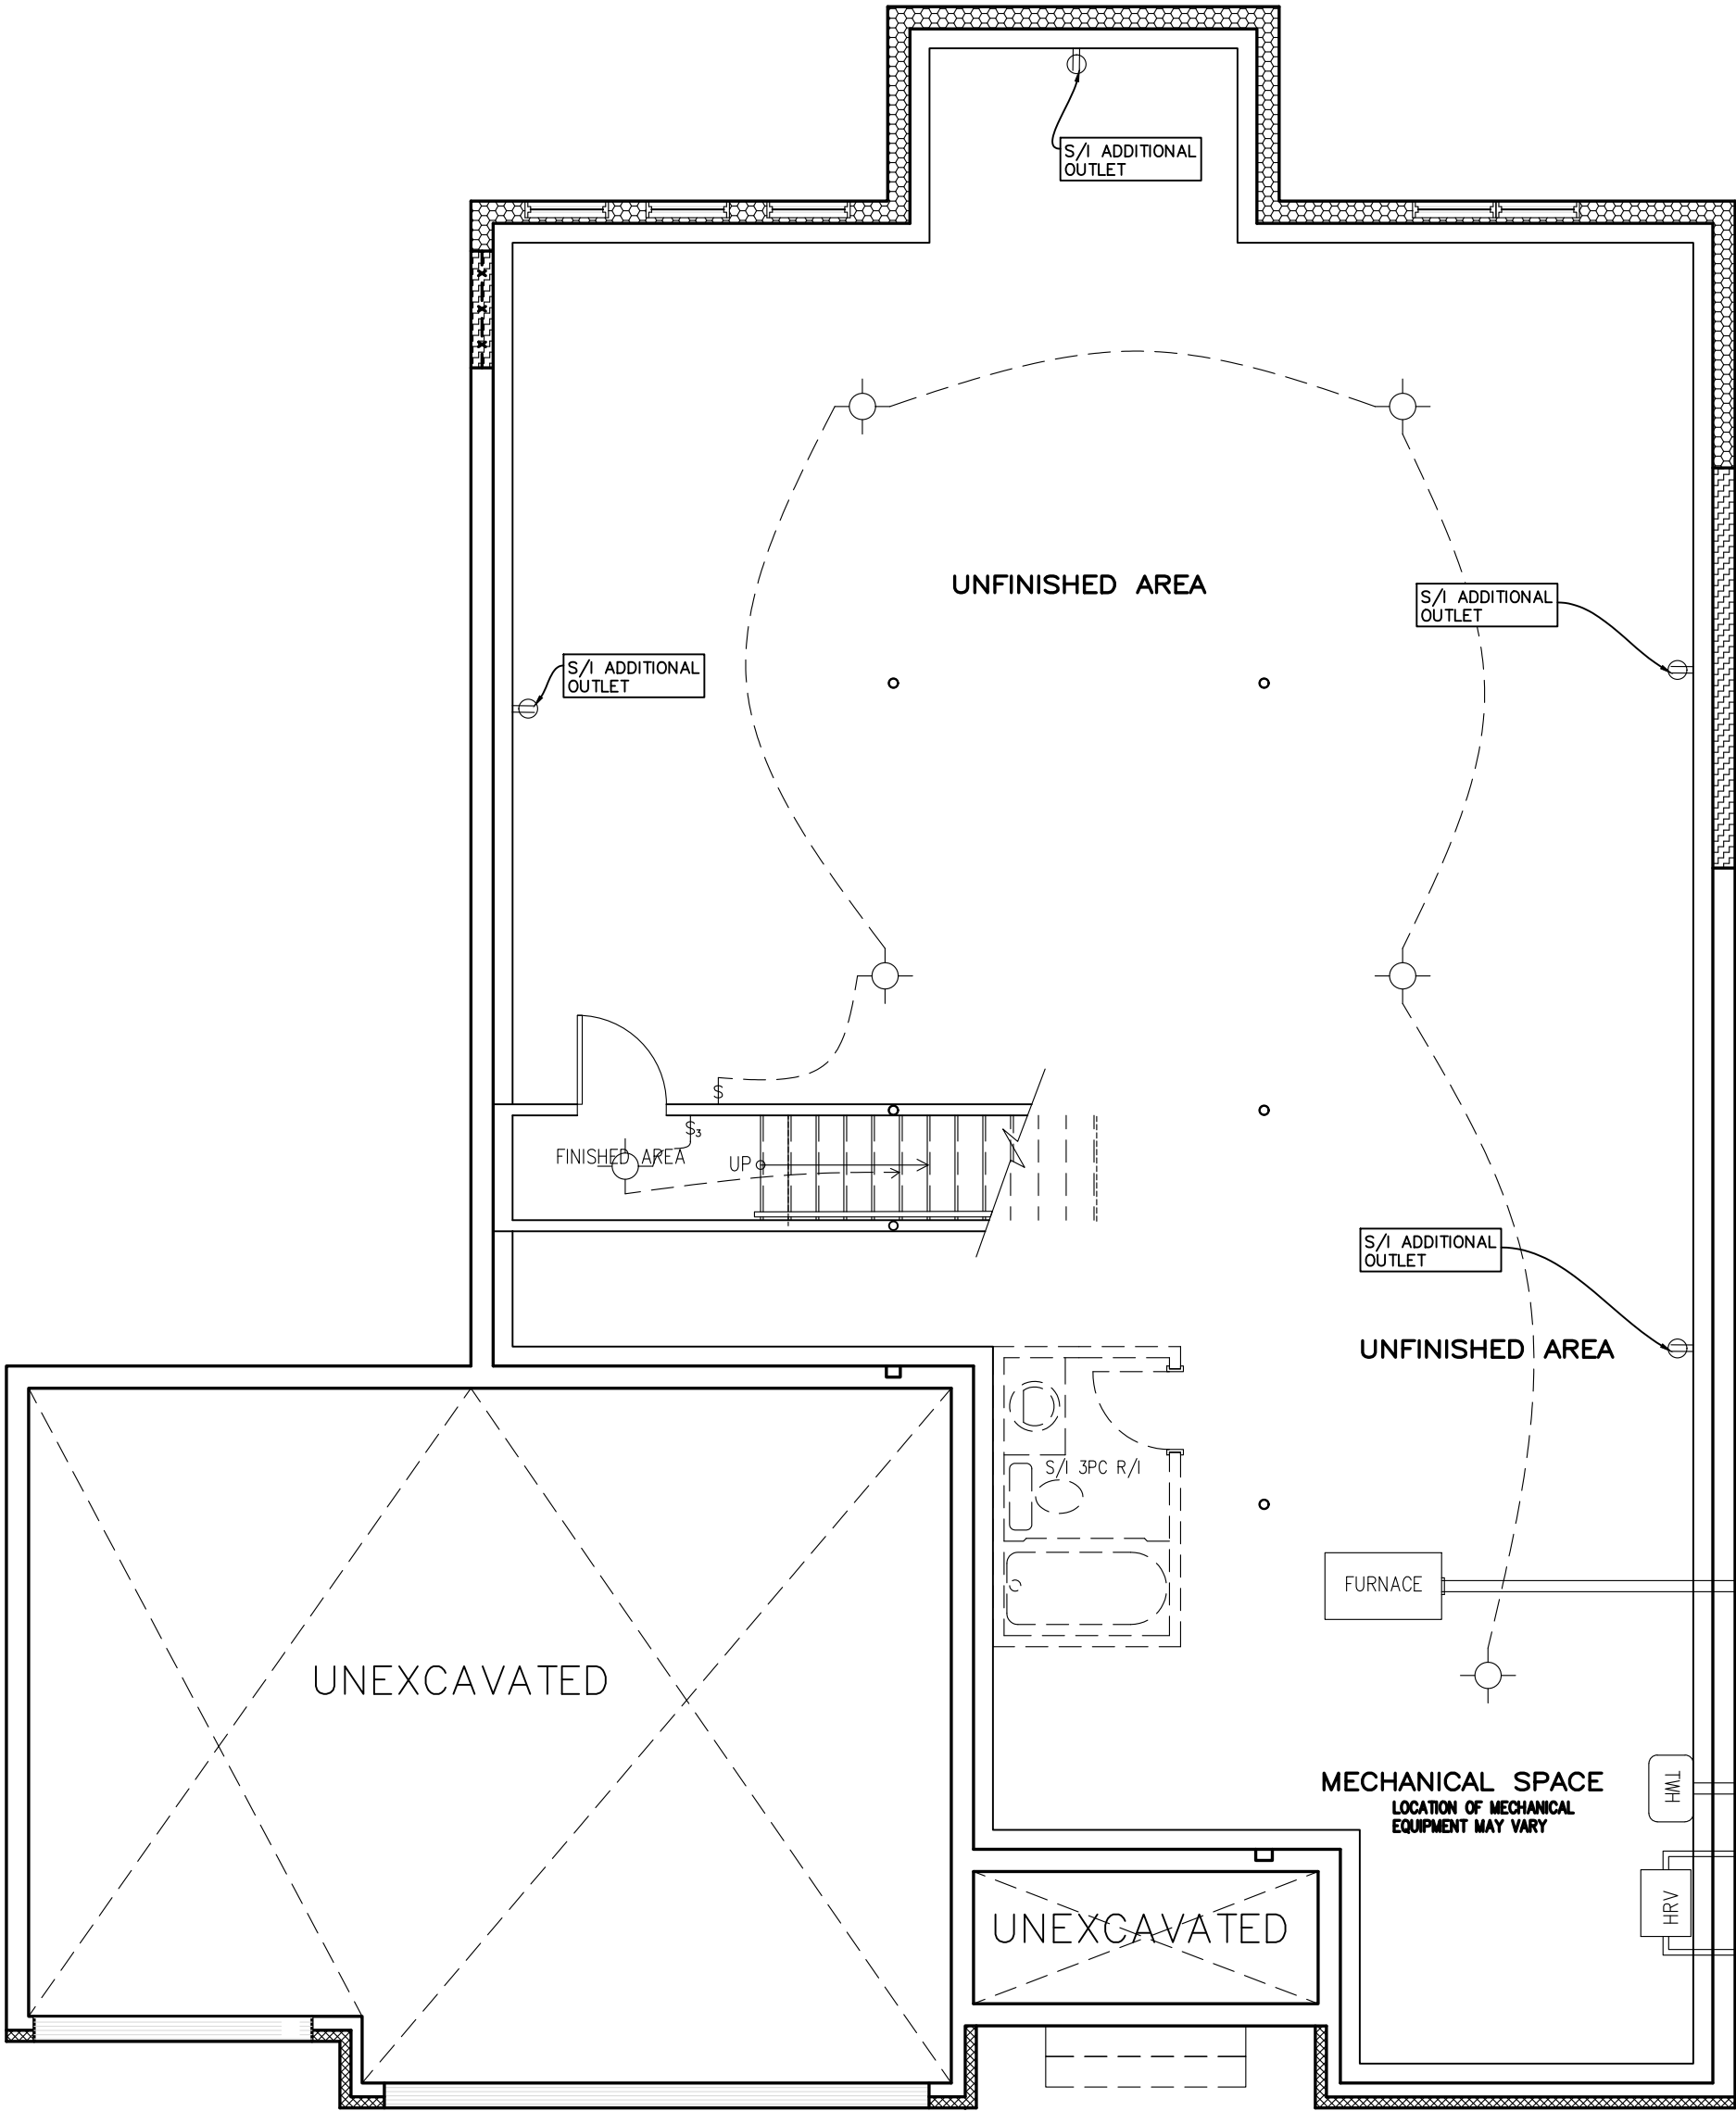

BASEMENT PLAN




R ELEVATION



SPRINGFIELD R – 2022	
SITE: WHITE TAIL RIDGE	
LOT NUMBER:	143
CIVIC ADDRESS: 157 FRANK FISHER CRESCENT	

10	FINAL BLACKLINES – REVISED	14/12/23	CB
9	FINAL BLACKLINES	04/12/23	SP
8	ISSUED FOR ENGINEERING	21/09/23	CB
7	ISSUED FOR LAYOUTS	14/09/23	CB
6	BEP BLACKLINES	14/09/23	CB
5	PRELIM BLACKLINES	17/08/23	SP
No.	Description	dd/mm/yy	By
REVISIONS			

footprint:	B – 24
drawn by:	SD
date:	SEP/12
scale:	3/16" = 1' – 0"
sheet no:	2
D.C.L. – A11	9

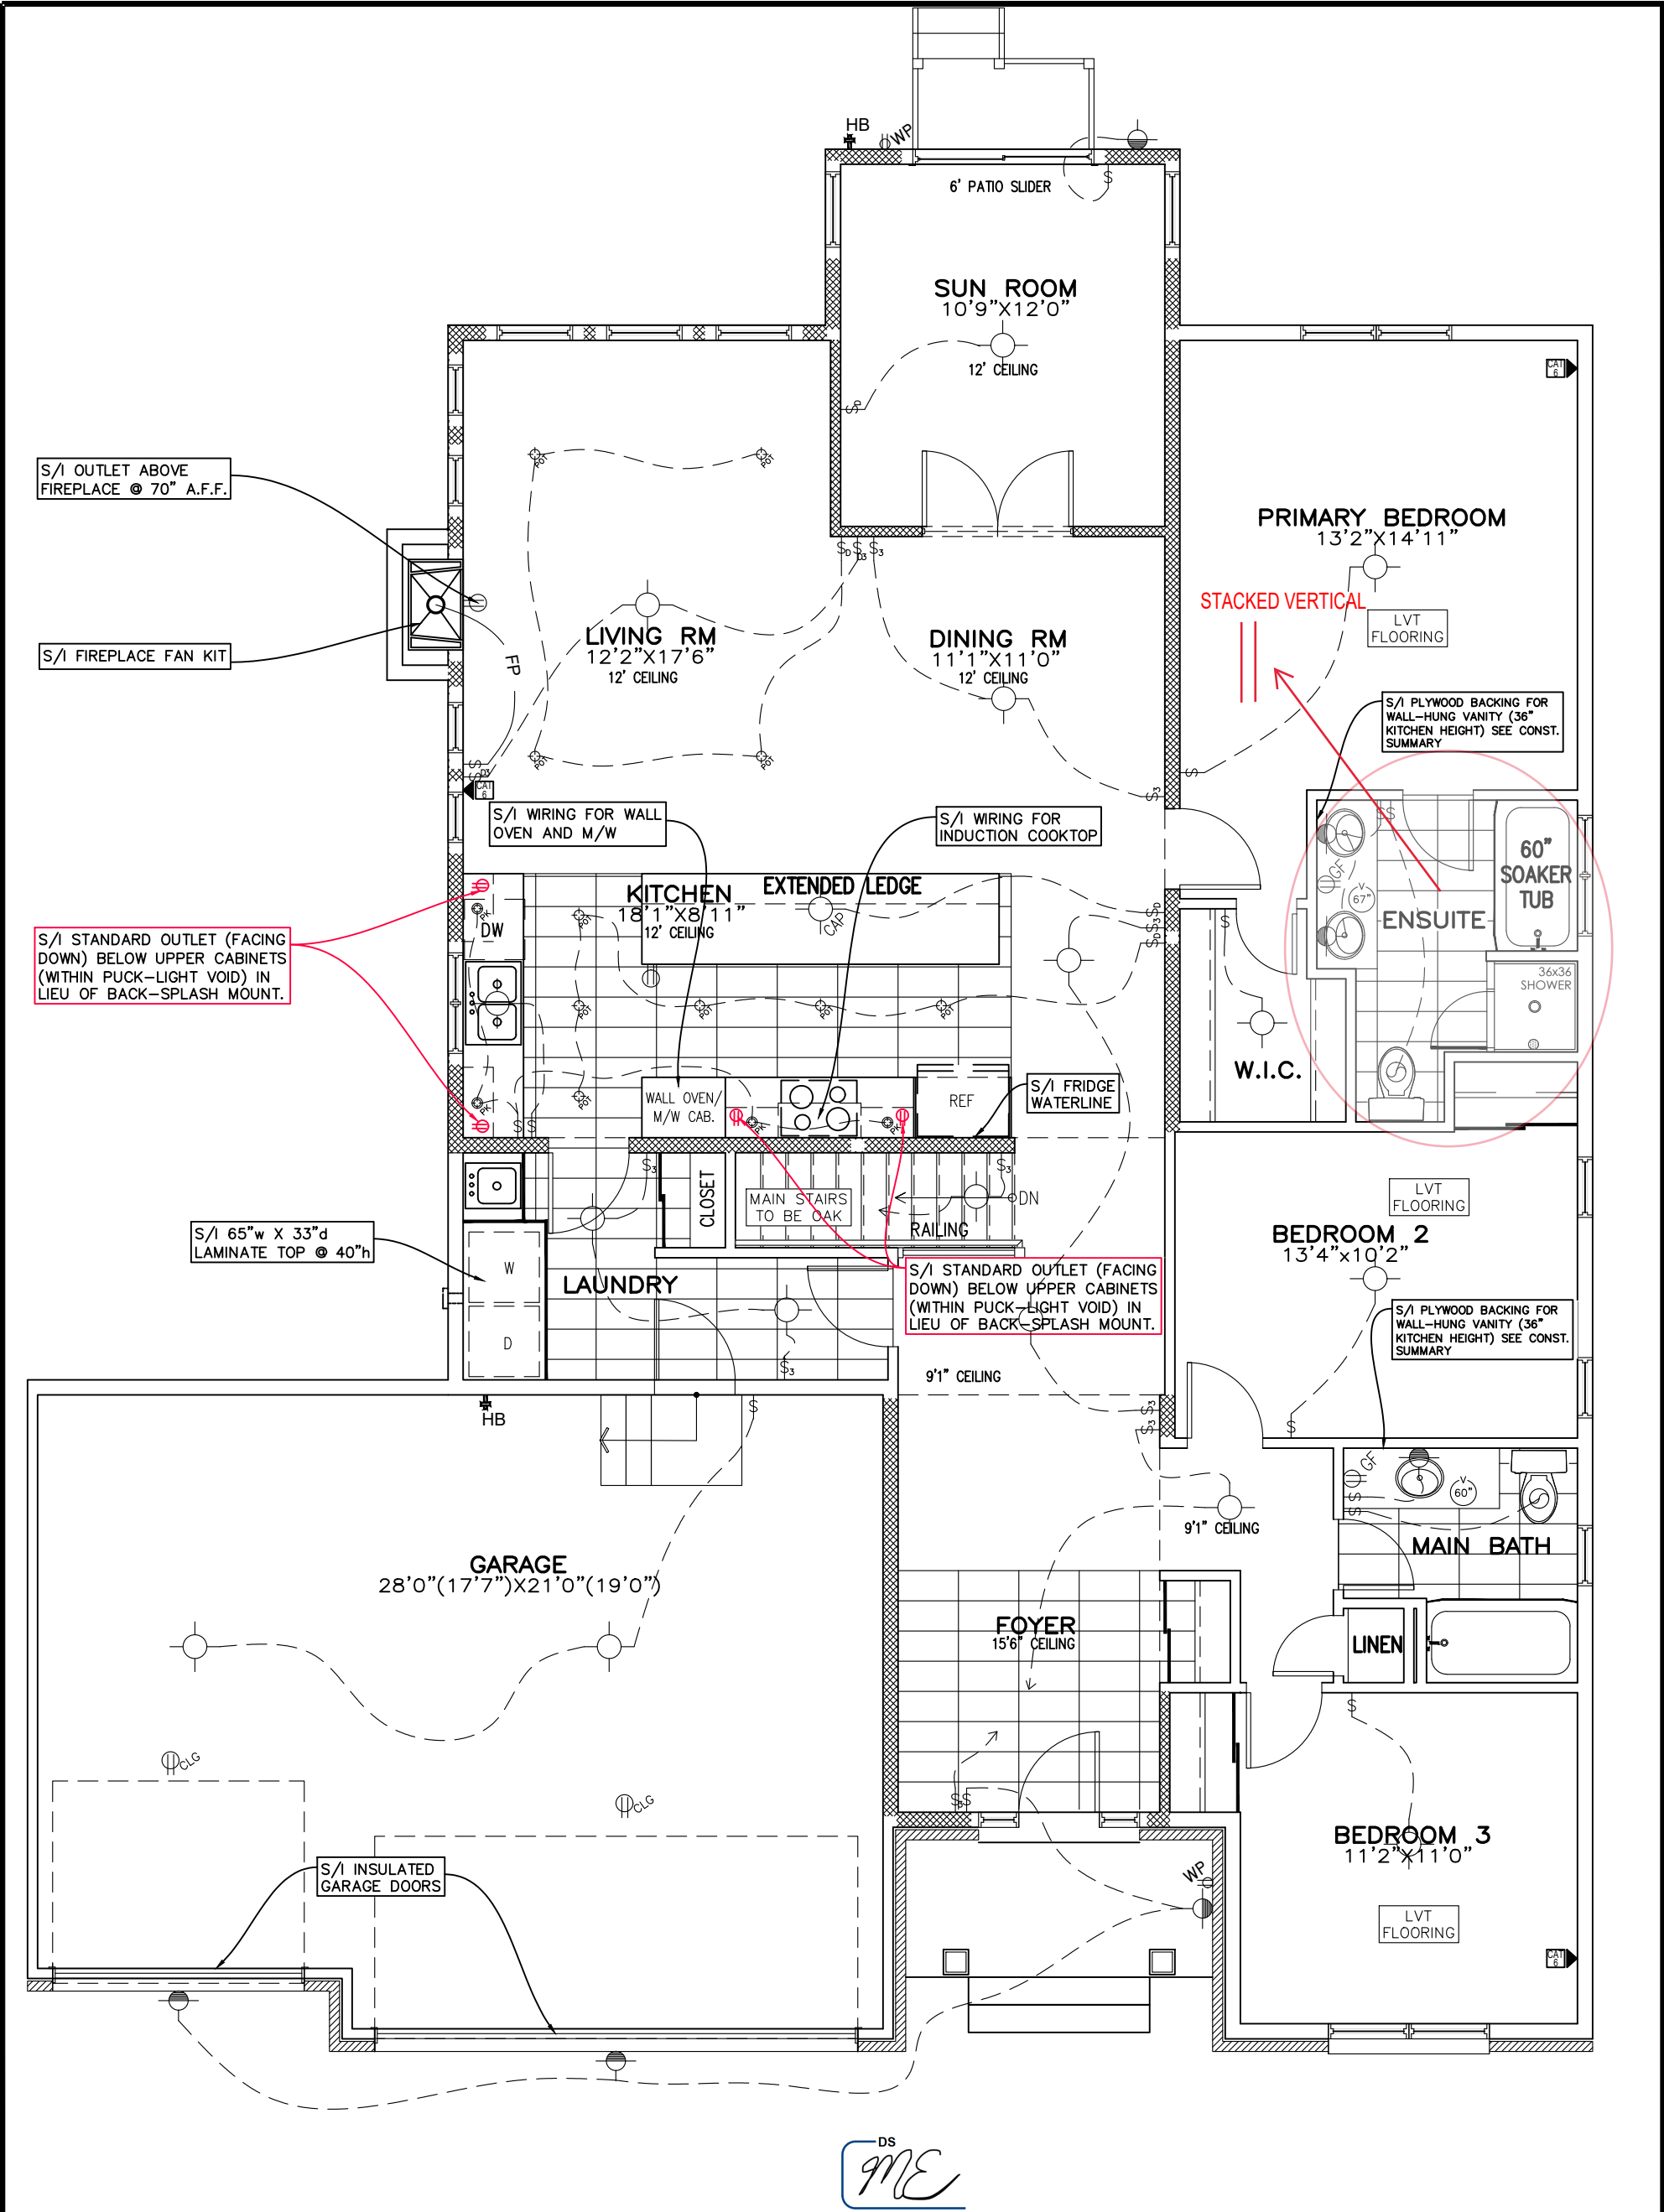

GROUND FLOOR

-FLAT CEILINGS THROUGHOUT / NO STIPPLE
-BYPASS SLIDERS FOR ALL SLIDING CLOSET DOORS

R ELEVATION

PHOENIX HOMES

SPRINGFIELD R - 2022

SITE: WHITE TAIL RIDGE

LOT NUMBER: 143

CIVIC ADDRESS: 157 FRANK FISHER CRESCENT

10	FINAL BLACKLINES - REVISED	14/12/23	CB
9	FINAL BLACKLINES	04/12/23	SP
8	ISSUED FOR ENGINEERING	21/09/23	CB
7	ISSUED FOR LAYOUTS	14/09/23	CB
6	BEP BLACKLINES	14/09/23	CB
5	PRELIM BLACKLINES	17/08/23	SP
No.	Description	dd/mm/yy	By
REVISIONS			

footprint: B-24

drawn by: SD

date: SEP/12

scale: 3/16"=1'-0"

sheet no: 3/9

D.C.L.-A11