



****REQUIRED FOR WINDOWS OVER 47" WIDE****
O.B.C. 9.15.4.3
ADD 2-15M HORIZONTAL BARS BELOW WINDOW EXTENDING
2'-0" BEYOND EDGE OF OPENING & 2-15M VERTICAL
BARS EACH SIDE

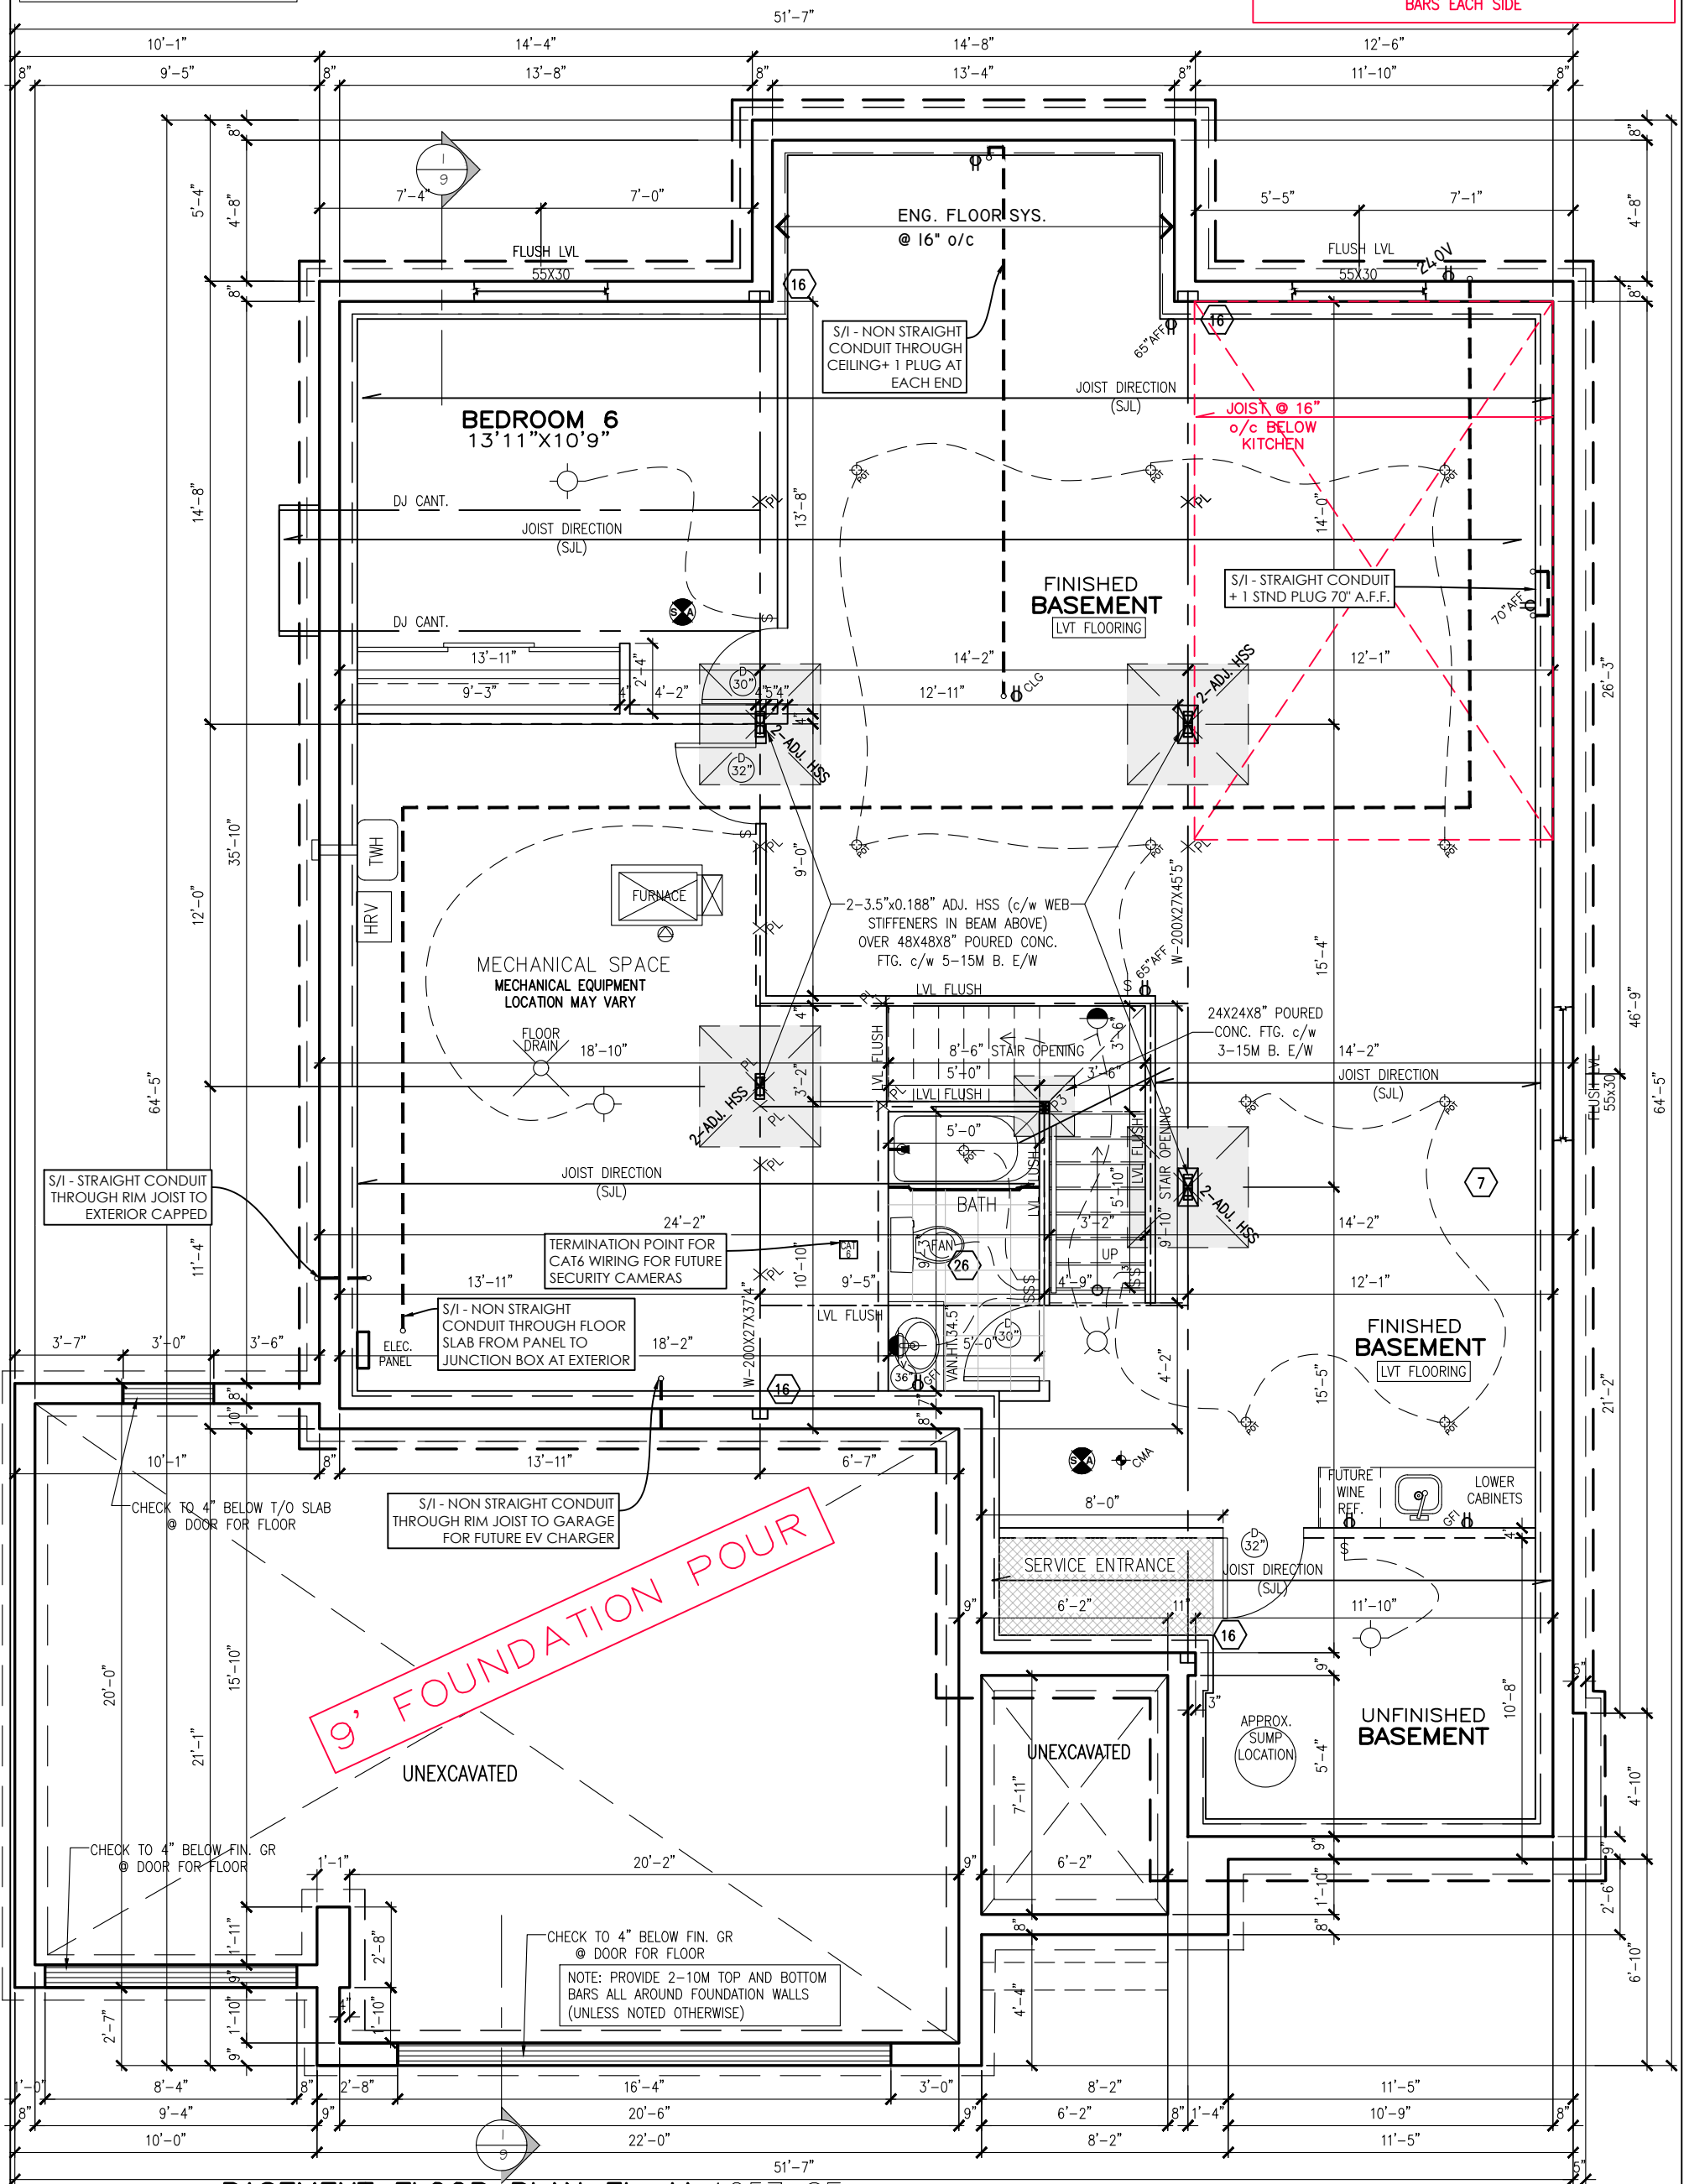

BASEMENT FLOOR PLAN EL. M 1257 SF

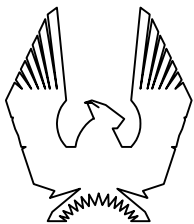

PHOENIX HOMES

KINGSWOOD-M-2022

SITE:DIAMONDVIEW PH3

LOT NUMBER:

CIVIC ADDRESS:
202 SILVER DART PRIVATE

94

11	FINAL FOR SITE	MAY-21-24	CB
10	FINAL BLACKLINES REVISED	MAR-20-24	CB
9	FINAL BLACKLINES REVISED	MAR-13-24	SP
8	FINAL BLACKLINES	MAR-08-24	CB
7	BEP FOR SITE	MAR-08-24	CB
6	ISSUED FOR ENGINEERING	JAN-15-24	CB
No.	Description	Date	By
REVISIONS			

file number: 50-22-4M

drawn by: S.P.


date: FEB. 2022

scale: $3/16"=1'$

sheet no:

D.C.L.-A29

$$\frac{2M}{9}$$

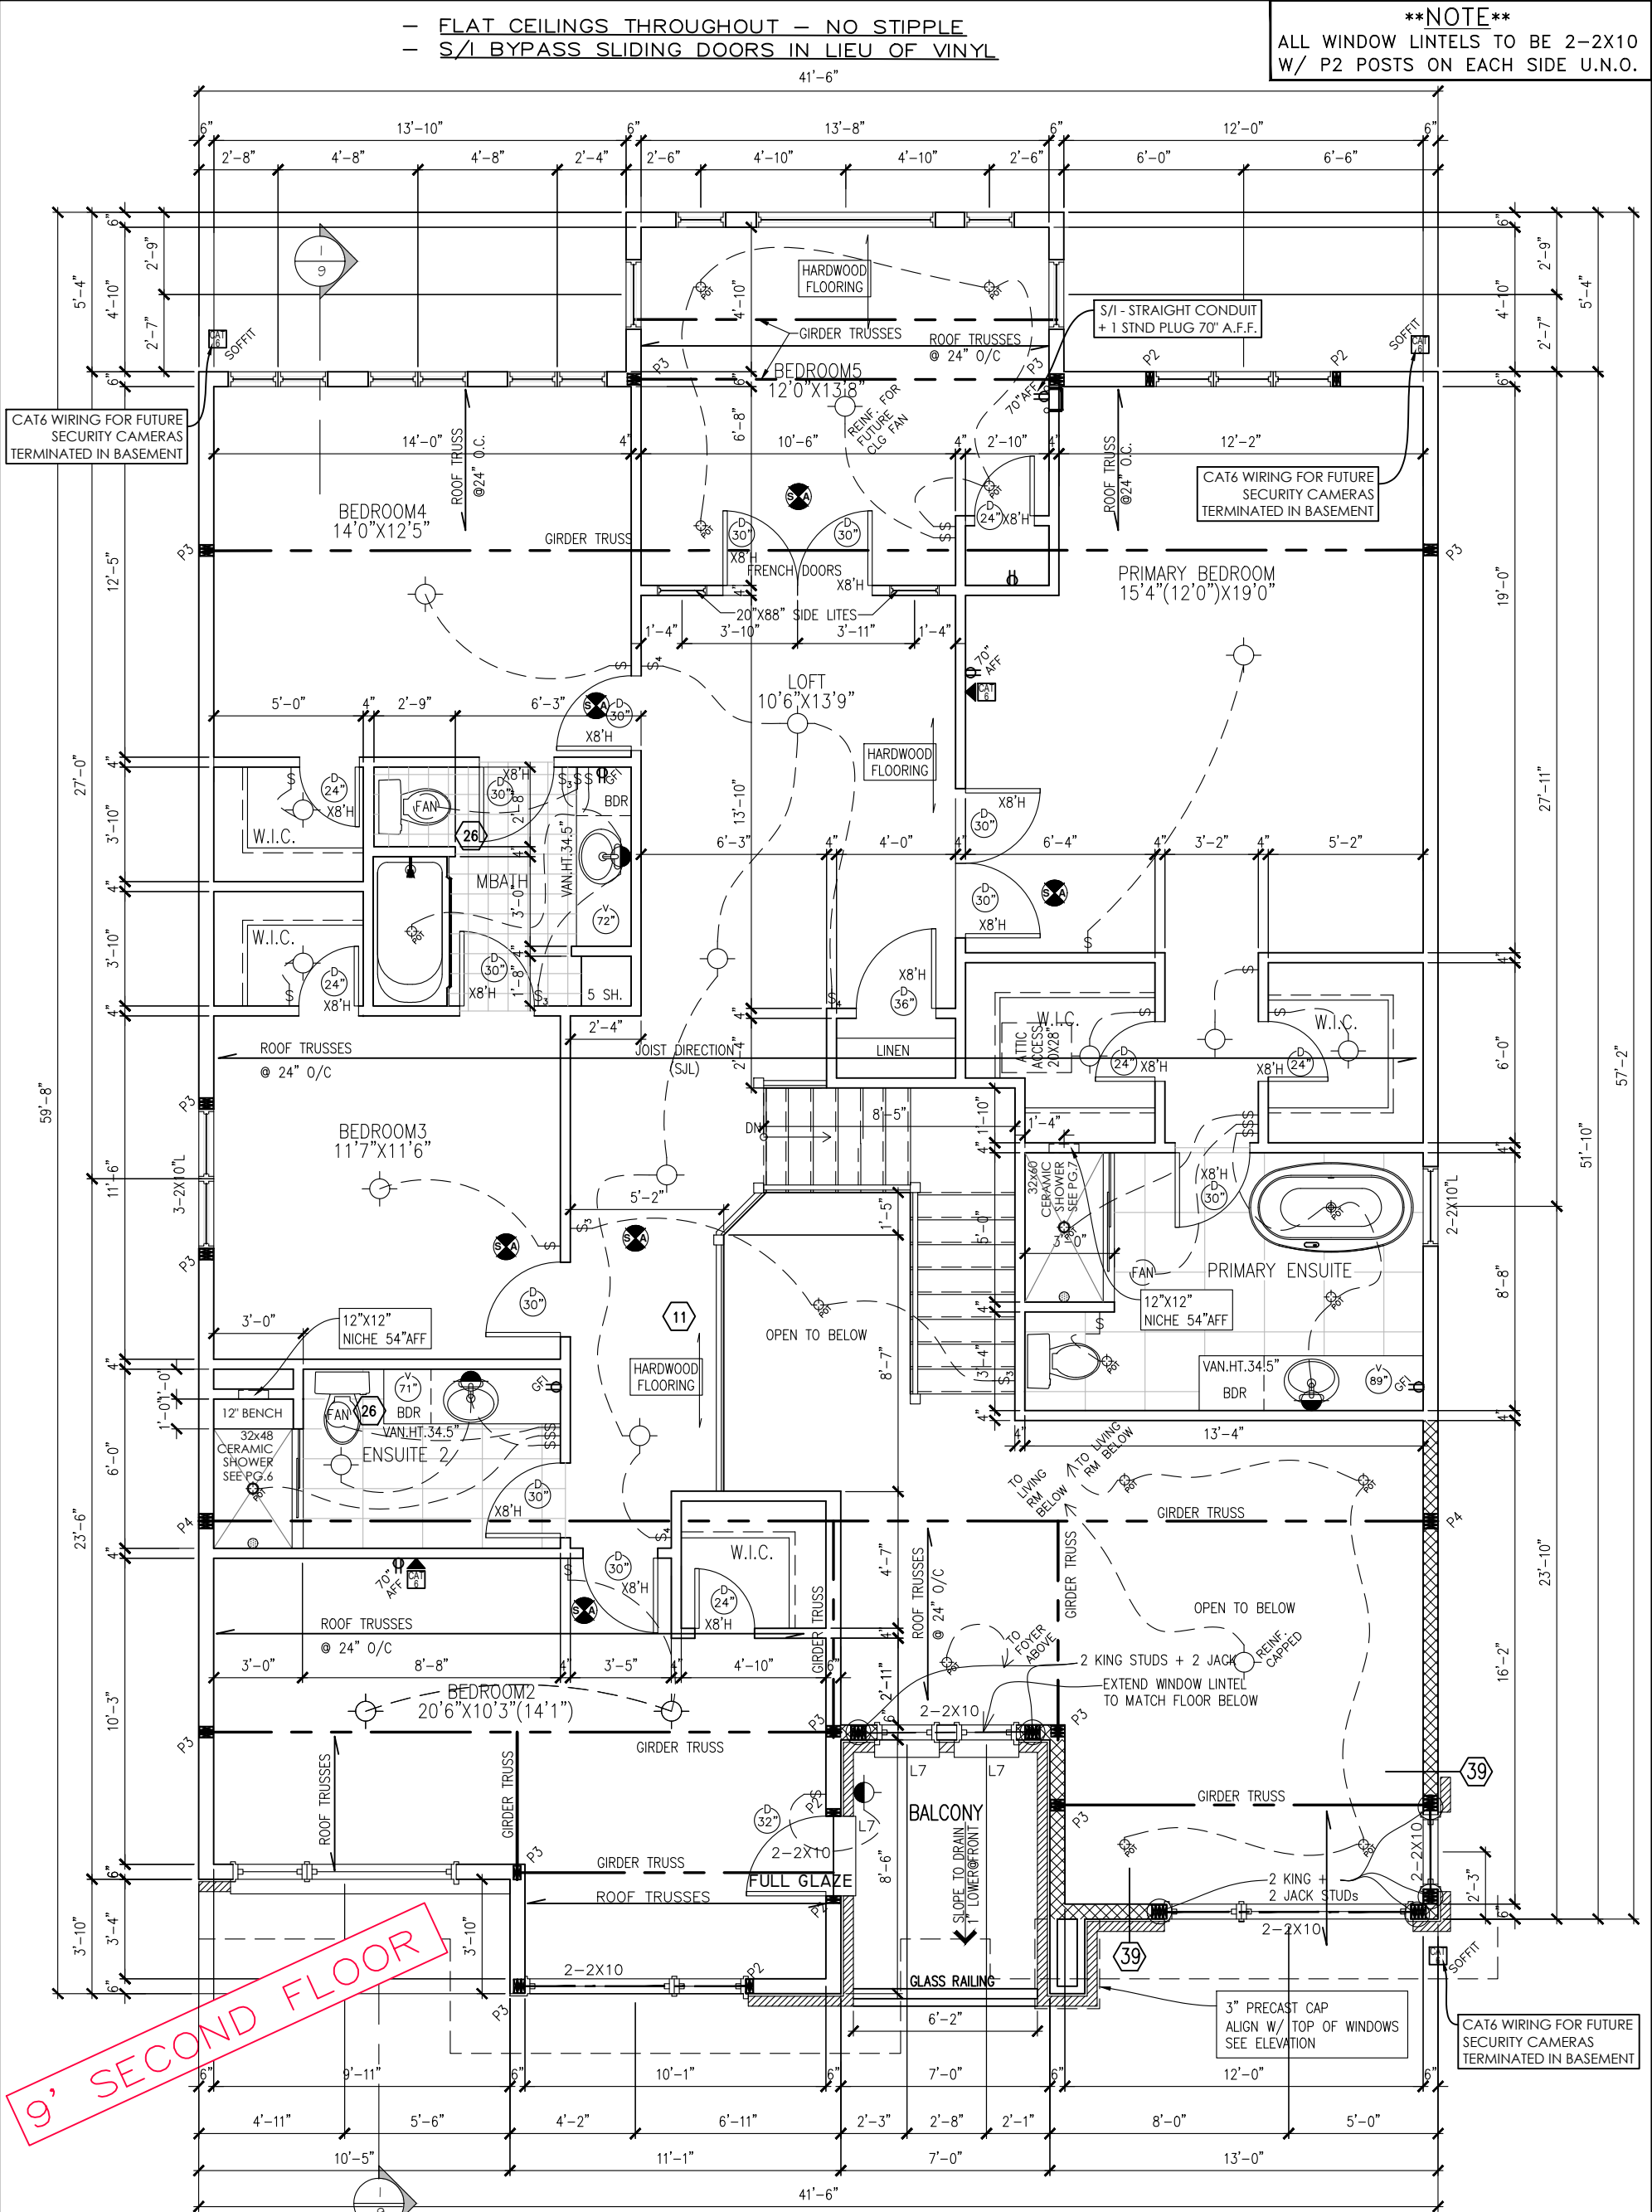

SECOND FLOOR PLAN ELEV. M 1818 SF



KINGSWOOD-M-2022

SITE:DIAMONDVIEW PH3

LOT NUMBER: 94

CIVIC ADDRESS:
202 SILVER DART PRIVATE

11	FINAL FOR SITE	MAY-21-24	CB
10	FINAL BLACKLINES REVISED	MAR-20-24	CB
9	FINAL BLACKLINES REVISED	MAR-13-24	SP
8	FINAL BLACKLINES	MAR-08-24	CB
7	BEP FOR SITE	MAR-08-24	CB
6	ISSUED FOR ENGINEERING	JAN-15-24	CB
No. Description		Date	By
REVISIONS			

file number: 50-22-4M

drawn by: S.P.


date: FEB. 2022

scale: 3/16"=1'

sheet no:
D.C.L.-A29

4M
9


9' SECOND FLOOR

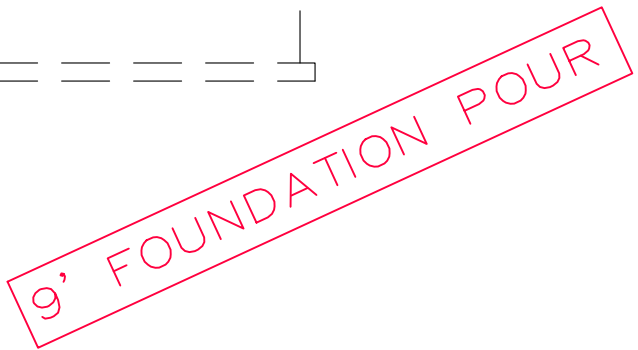

file number: 50-22-4M	
drawn by: S.P.	
date: FEB. 2022	
scale: 3/16"=1'	
sheet no:	
D.C.L.-A29	

CONTRACTOR MUST VERIFY ALL DIMENSIONS ON THE JOB AND REPORT ANY DISCREPANCY TO DCR/PHOENIX BEFORE PROCEEDING WITH THE WORK.
ALL DRAWINGS AND SPECIFICATIONS ARE INSTRUMENTS OF SERVICE AND THE PROPERTY OF THE DCR/PHOENIX WHICH MUST BE RETURNED AT THE COMPLETION OF THE WORK.
ALL DRAWINGS TO BE USED FOR CONSTRUCTION ONLY AFTER BUILDING PERMIT HAS BEEN ISSUED.
DO NOT SCALE DRAWINGS, USE DIMENSIONS PROVIDED.

****ATTENTION SIDING CREW****
DO NOT INSTALL
DECORATIVE TRIM AROUND
WINDOWS

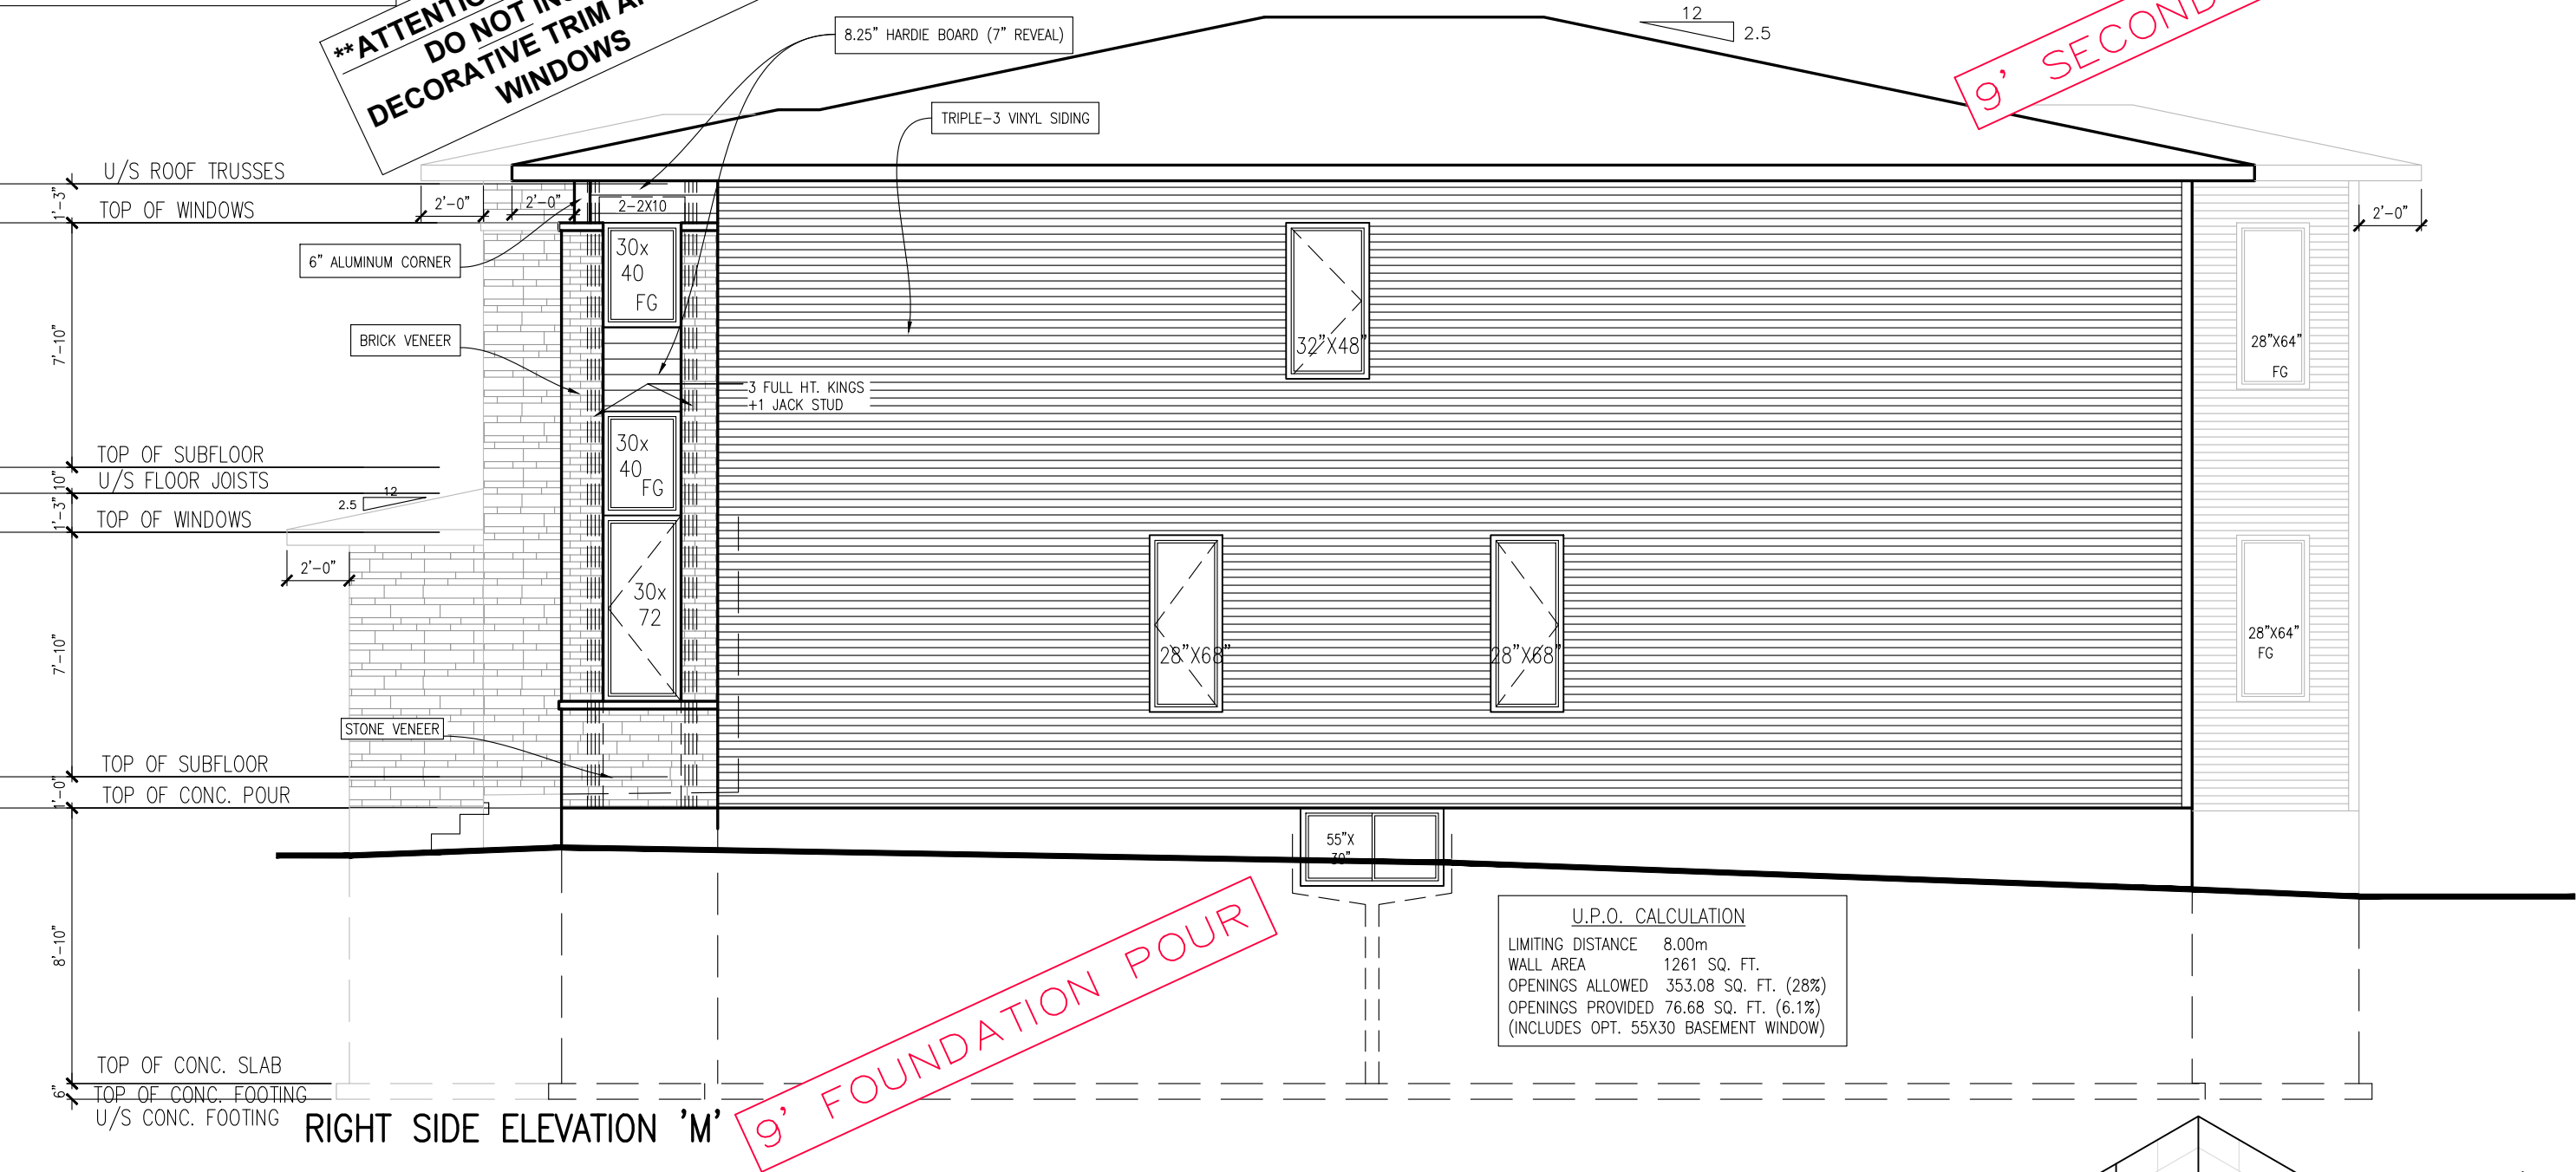

KINGSWOOD-M-2022

SITE:DIAMONDVIEW PH3

LOT NUMBER:

94

CIVIC ADDRESS:
202 SILVER DART PRIVATE

11	FINAL FOR SITE	MAY-21-24	CB
10	FINAL BLACKLINES REVISED	MAR-20-24	CB
9	FINAL BLACKLINES REVISED	MAR-13-24	SP
8	FINAL BLACKLINES	MAR-08-24	CB
7	BEP FOR SITE	MAR-08-24	CB
6	ISSUED FOR ENGINEERING	JAN-15-24	CB
No.	Description	Date	By
REVISIONS			

file number: 50-22-4M

drawn by: S.P.

date: FEB. 2022


scale: 3/16"=1'

sheet no:

D.C.L.-A29

6M

9

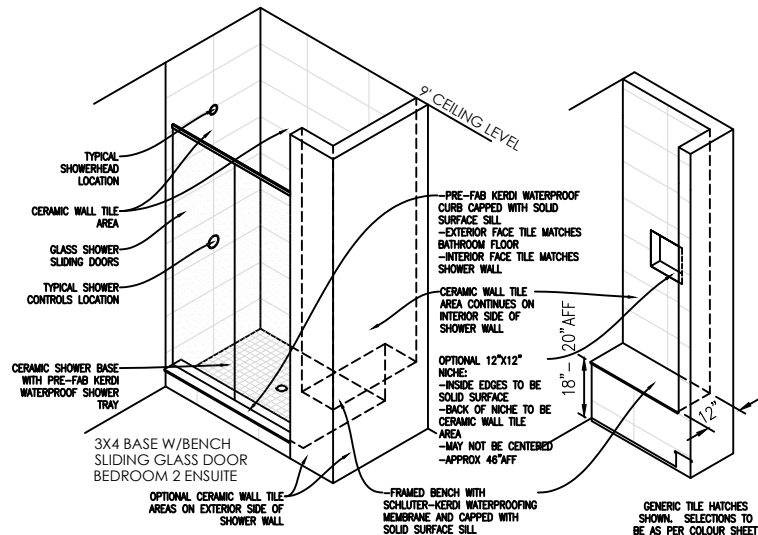

CONTRACTOR MUST VERIFY ALL DIMENSIONS ON THE JOB AND REPORT ANY DISCREPANCY TO DCR/PHOENIX BEFORE PROCEEDING WITH THE WORK.
ALL DRAWINGS AND SPECIFICATIONS ARE INSTRUMENTS OF SERVICE AND THE PROPERTY OF THE DCR/PHOENIX WHICH MUST BE RETURNED AT THE COMPLETION OF THE WORK.
ALL DRAWINGS TO BE USED FOR CONSTRUCTION ONLY AFTER BUILDING PERMIT HAS BEEN ISSUED.
DO NOT SCALE DRAWINGS, USE DIMENSIONS PROVIDED.

9' SECOND FLOOR

ATTENTION SIDING CREW
DO NOT INSTALL
DECORATIVE TRIM AROUND
WINDOWS



LEFT SIDE ELEVATION 'M'

U.P.O. CALCULATION	
LIMITING DISTANCE	2.00m
WALL AREA	1387 SQ. FT.
OPENINGS ALLOWED	110.96 SQ. FT. (8%)
OPENINGS PROVIDED	55.4 SQ. FT. (3.99%)

9' FOUNDATION POUR



KINGSWOOD-M-2022

SITE:DIAMONDVIEW PH3

LOT NUMBER: 94

CIVIC ADDRESS:
202 SILVER DART PRIVATE

11	FINAL FOR SITE	MAY-21-24	CB
10	FINAL BLACKLINES REVISED	MAR-20-24	CB
9	FINAL BLACKLINES REVISED	MAR-13-24	SP
8	FINAL BLACKLINES	MAR-08-24	CB
7	BEP FOR SITE	MAR-08-24	CB
6	ISSUED FOR ENGINEERING	JAN-15-24	CB
No.	Description	Date	By
REVISIONS			

file number: 50-22-4M


drawn by: S.P.

date: FEB. 2022

scale: 3/16"=1'

sheet no: D.C.L.-A29


7M
9

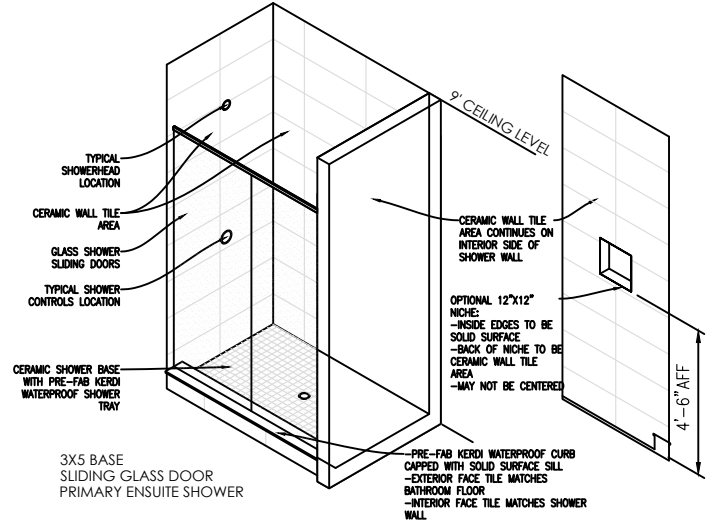

CONTRACTOR MUST VERIFY ALL DIMENSIONS ON THE JOB AND REPORT ANY DISCREPANCY TO DCR/PHOENIX BEFORE PROCEEDING WITH THE WORK.
ALL DRAWINGS AND SPECIFICATIONS ARE INSTRUMENTS OF SERVICE AND THE PROPERTY OF THE DCR/PHOENIX WHICH MUST BE RETURNED AT THE COMPLETION OF THE WORK.
ALL DRAWINGS TO BE USED FOR CONSTRUCTION ONLY AFTER BUILDING PERMIT HAS BEEN ISSUED.
DO NOT SCALE DRAWINGS, USE DIMENSIONS PROVIDED.

9' SECOND FLOOR

ATTENTION SIDING CREW
DO NOT INSTALL
DECORATIVE TRIM AROUND
WINDOWS

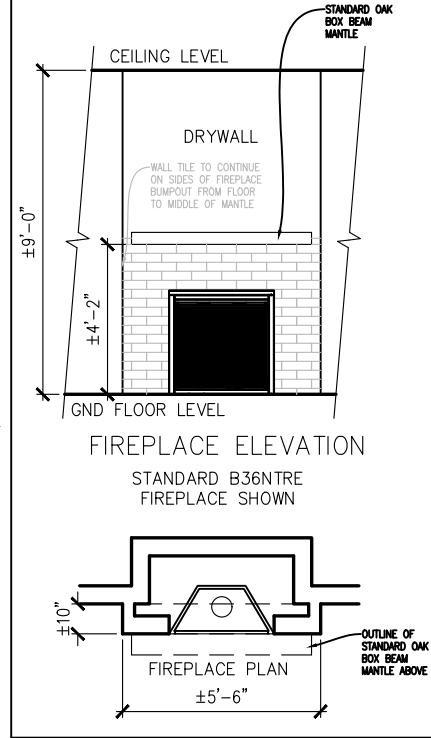

REAR ELEVATION M

9' FOUNDATION POUR



KINGSWOOD-M-2022

SITE:DIAMONDVIEW PH3

LOT NUMBER:

94


CIVIC ADDRESS:
202 SILVER DART PRIVATE

11	FINAL FOR SITE	MAY-21-24	CB
10	FINAL BLACKLINES REVISED	MAR-20-24	CB
9	FINAL BLACKLINES REVISED	MAR-13-24	SP
8	FINAL BLACKLINES	MAR-08-24	CB
7	BEP FOR SITE	MAR-08-24	CB
6	ISSUED FOR ENGINEERING	JAN-15-24	CB
No.	Description	Date	By
REVISIONS			

file number:	50-22-4M
drawn by:	S.P.
date:	FEB. 2022
scale:	3/16"=1'
sheet no:	8M 9
D.C.L.-A29	

CONTRACTOR MUST VERIFY ALL DIMENSIONS ON THE JOB AND REPORT ANY DISCREPANCY TO DCR/PHOENIX BEFORE PROCEEDING WITH THE WORK.
ALL DRAWINGS AND SPECIFICATIONS ARE INSTRUMENTS OF SERVICE AND THE PROPERTY OF THE DCR/PHOENIX WHICH MUST BE RETURNED AT THE COMPLETION OF THE WORK.
ALL DRAWINGS TO BE USED FOR CONSTRUCTION ONLY AFTER BUILDING PERMIT HAS BEEN ISSUED.
DO NOT SCALE DRAWINGS, USE DIMENSIONS PROVIDED.

9' SECOND FLOOR

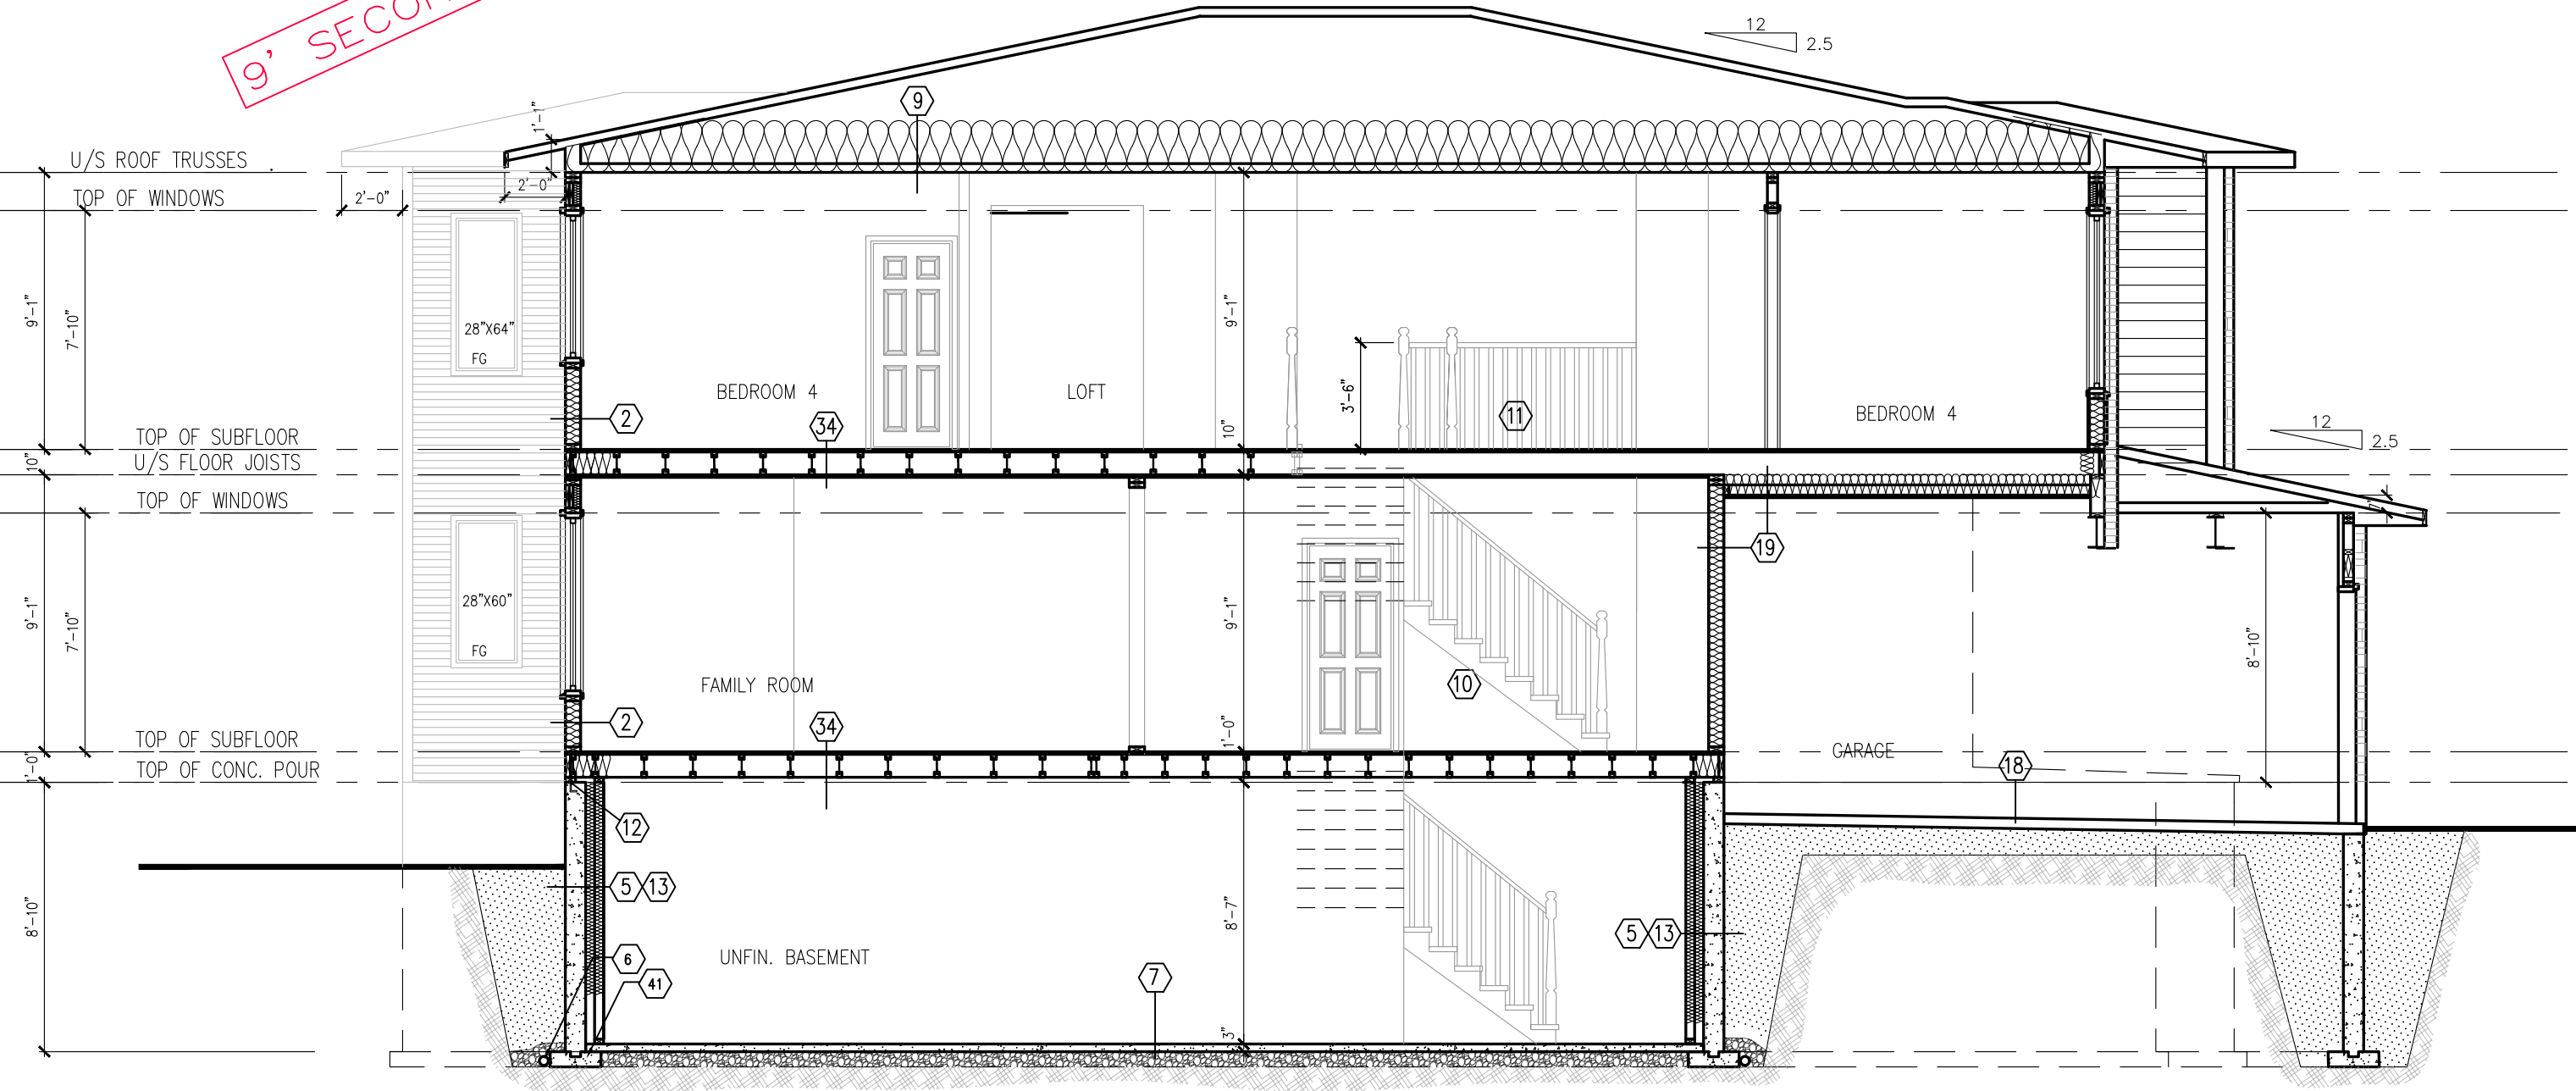

SECTION @ STAIRS (ELEV. M SHOWN)



KINGSWOOD-M-2022

SITE: DIAMONDVIEW PH3

LOT NUMBER:

94

CIVIC ADDRESS:
202 SILVER DART PRIVATE

11	FINAL FOR SITE	MAY-21-24	CB
10	FINAL BLACKLINES REVISED	MAR-20-24	CB
9	FINAL BLACKLINES REVISED	MAR-13-24	SP
8	FINAL BLACKLINES	MAR-08-24	CB
7	BEP FOR SITE	MAR-08-24	CB
6	ISSUED FOR ENGINEERING	JAN-15-24	CB
No.	Description	Date	By
REVISIONS			

file number: 50-22-4M
drawn by: S.P.
date: FEB. 2022
scale: 3/16"=1'
sheet no:
D.C.L.-A29

9M
9

9' FOUNDATION POUR