




Owner/Applicant
DCR/PHOENIX HOMES
Telephone # 723-9227
Plan # 27M-47
Project name: WHITE TAIL RIDGE
Civic Address: 119 FRANK FISHER CRESCENT
House model: OAKSIDE C

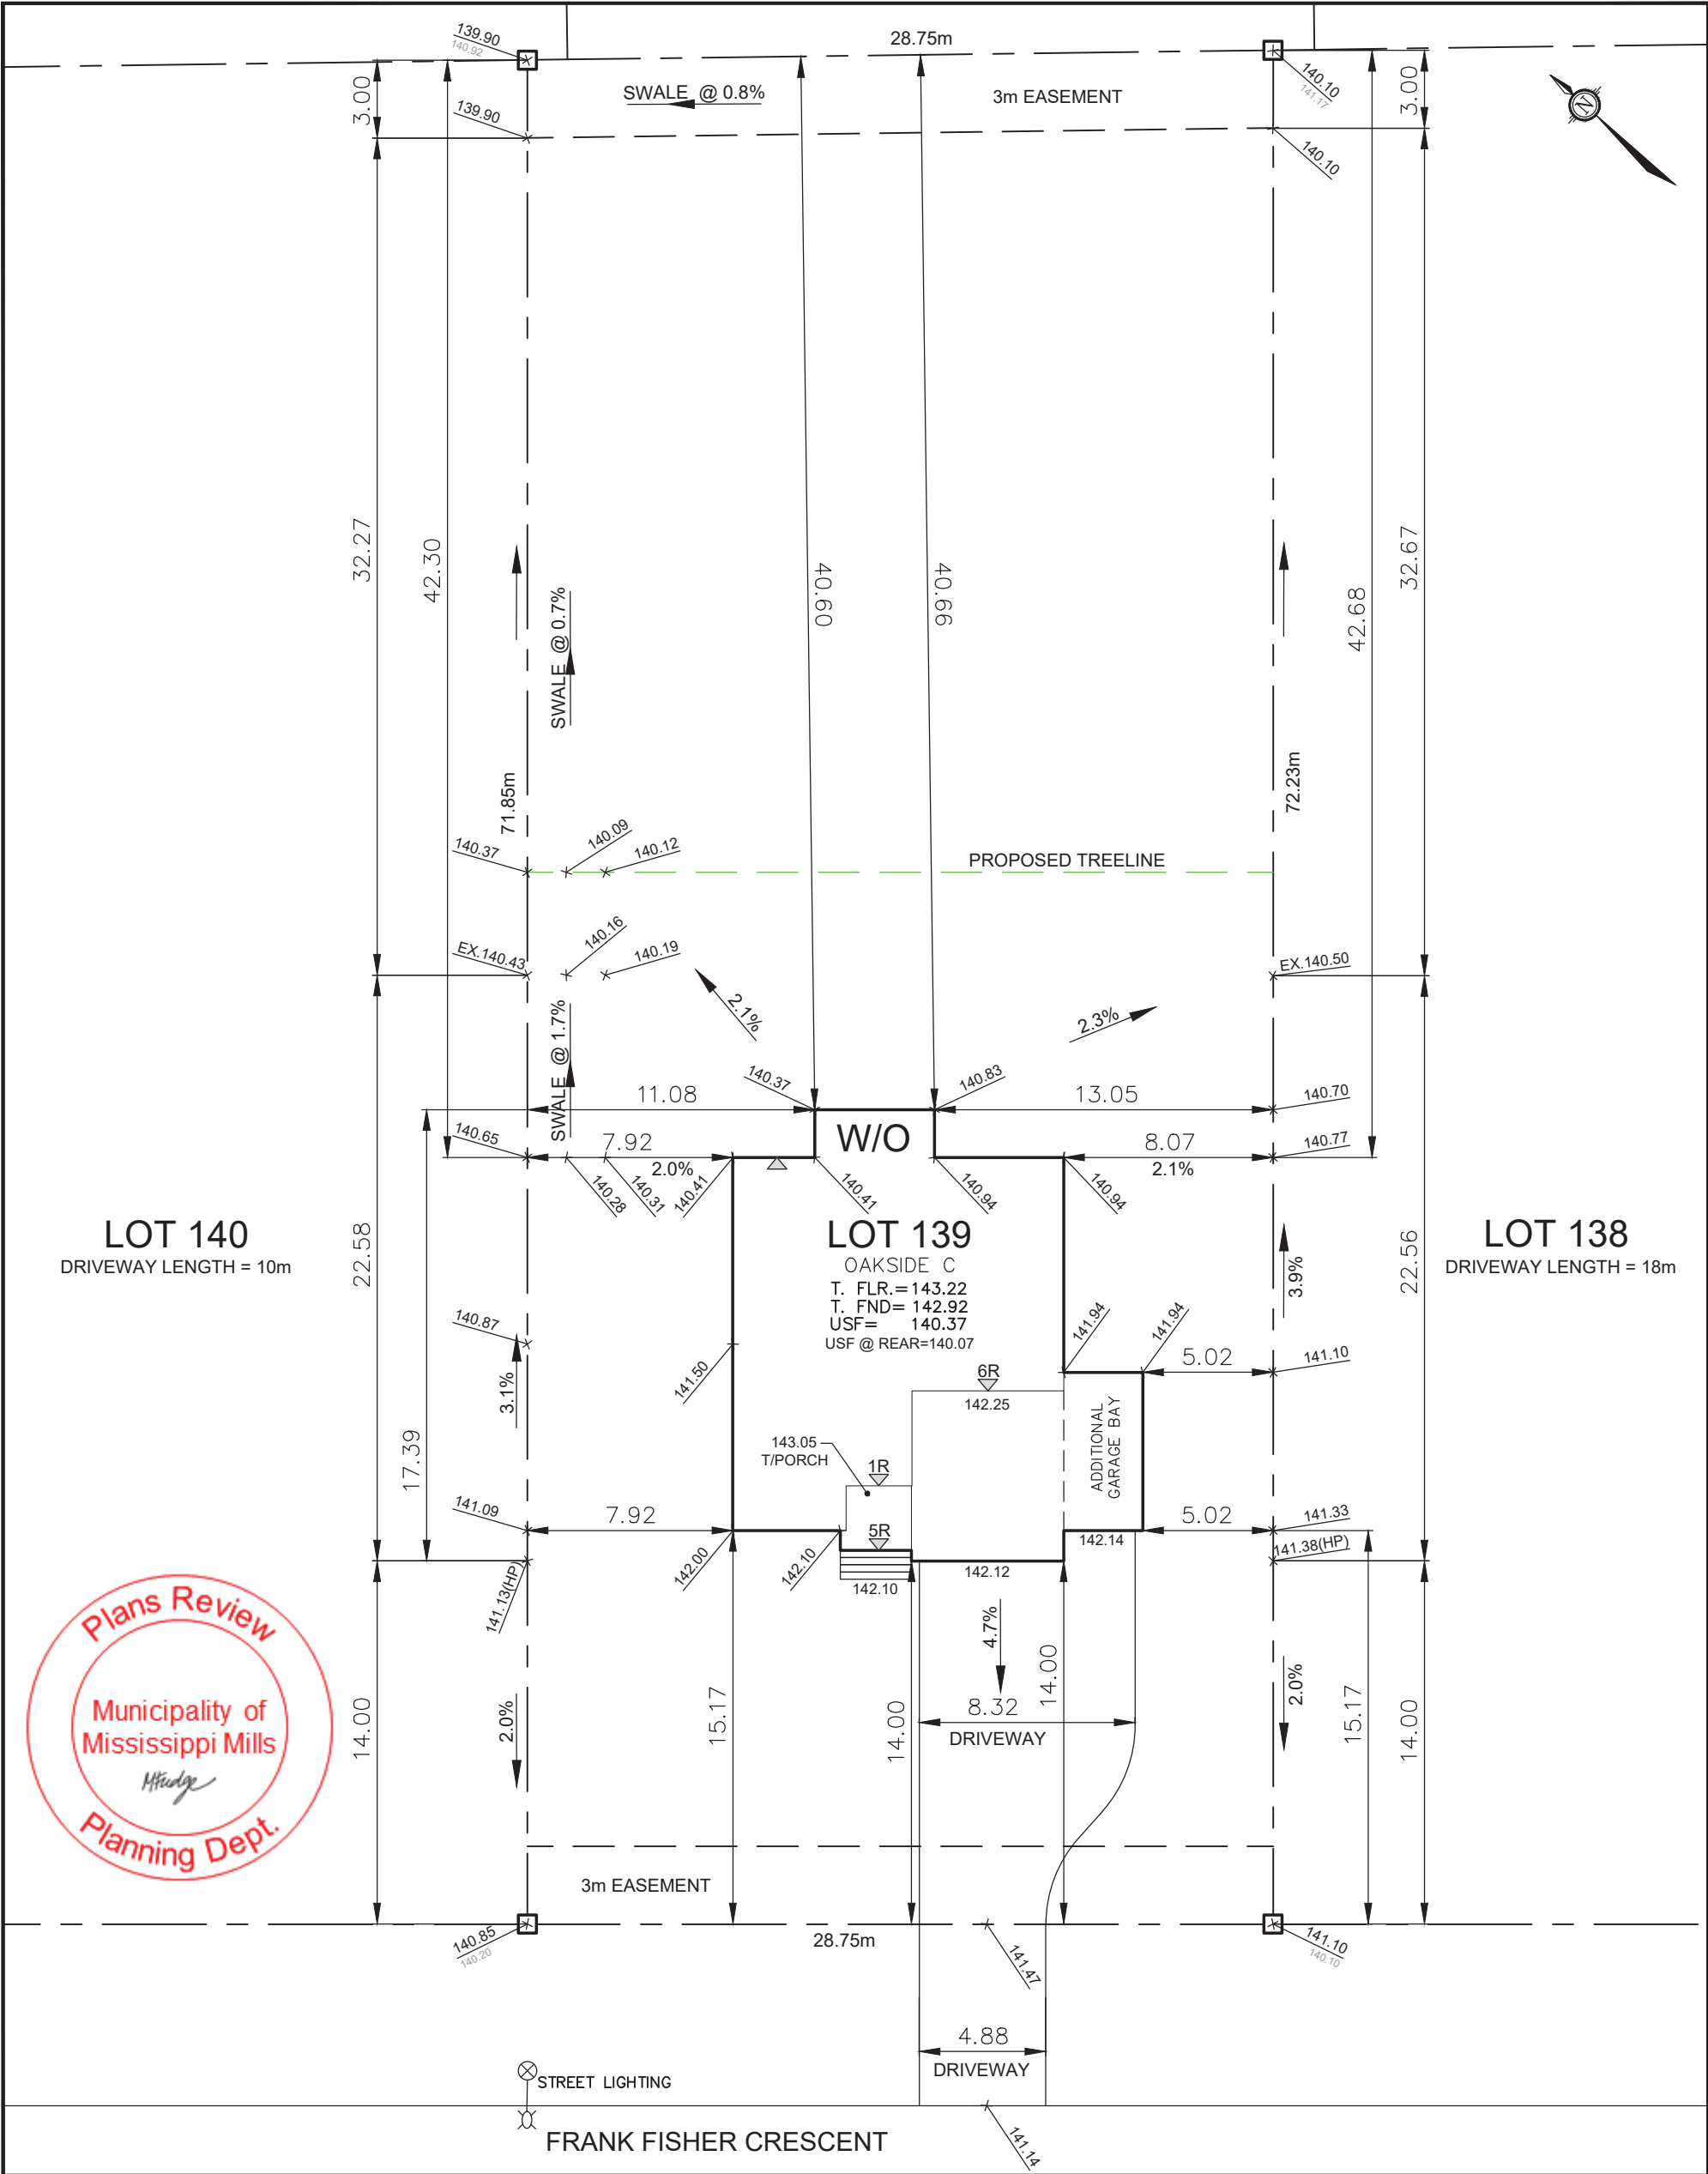

LOT 139 SITE/GRADING PLAN

WHITE TAIL RIDGE PH. IV

INDIVIDUAL LOT GRADING REVIEW SUMMARY FOR SITED HOUSE AS COMPARED WITH OVERALL SUBDIVISION PLAN

NOTE: THIS PLAN IS NOT A SURVEY PLAN OR SUBDIVISION PLAN WITHIN THE MEANING OF PLANNING ACT.

THIS PLAN IS FOR REFERENCE ONLY AND IS PRELIMINARY IN NATURE, ALL DIMENSIONS SHOWN ARE APPROXIMATE. E.O&E.

CHECKED/APPROVED BY:
T.L.MAK ENG.

Bldg. Ht.	7.21	m
Lot coverage	10.6	%
Scale	1:250	
Sod Area	1913	m ²
Asphalt Area	141	m ²