



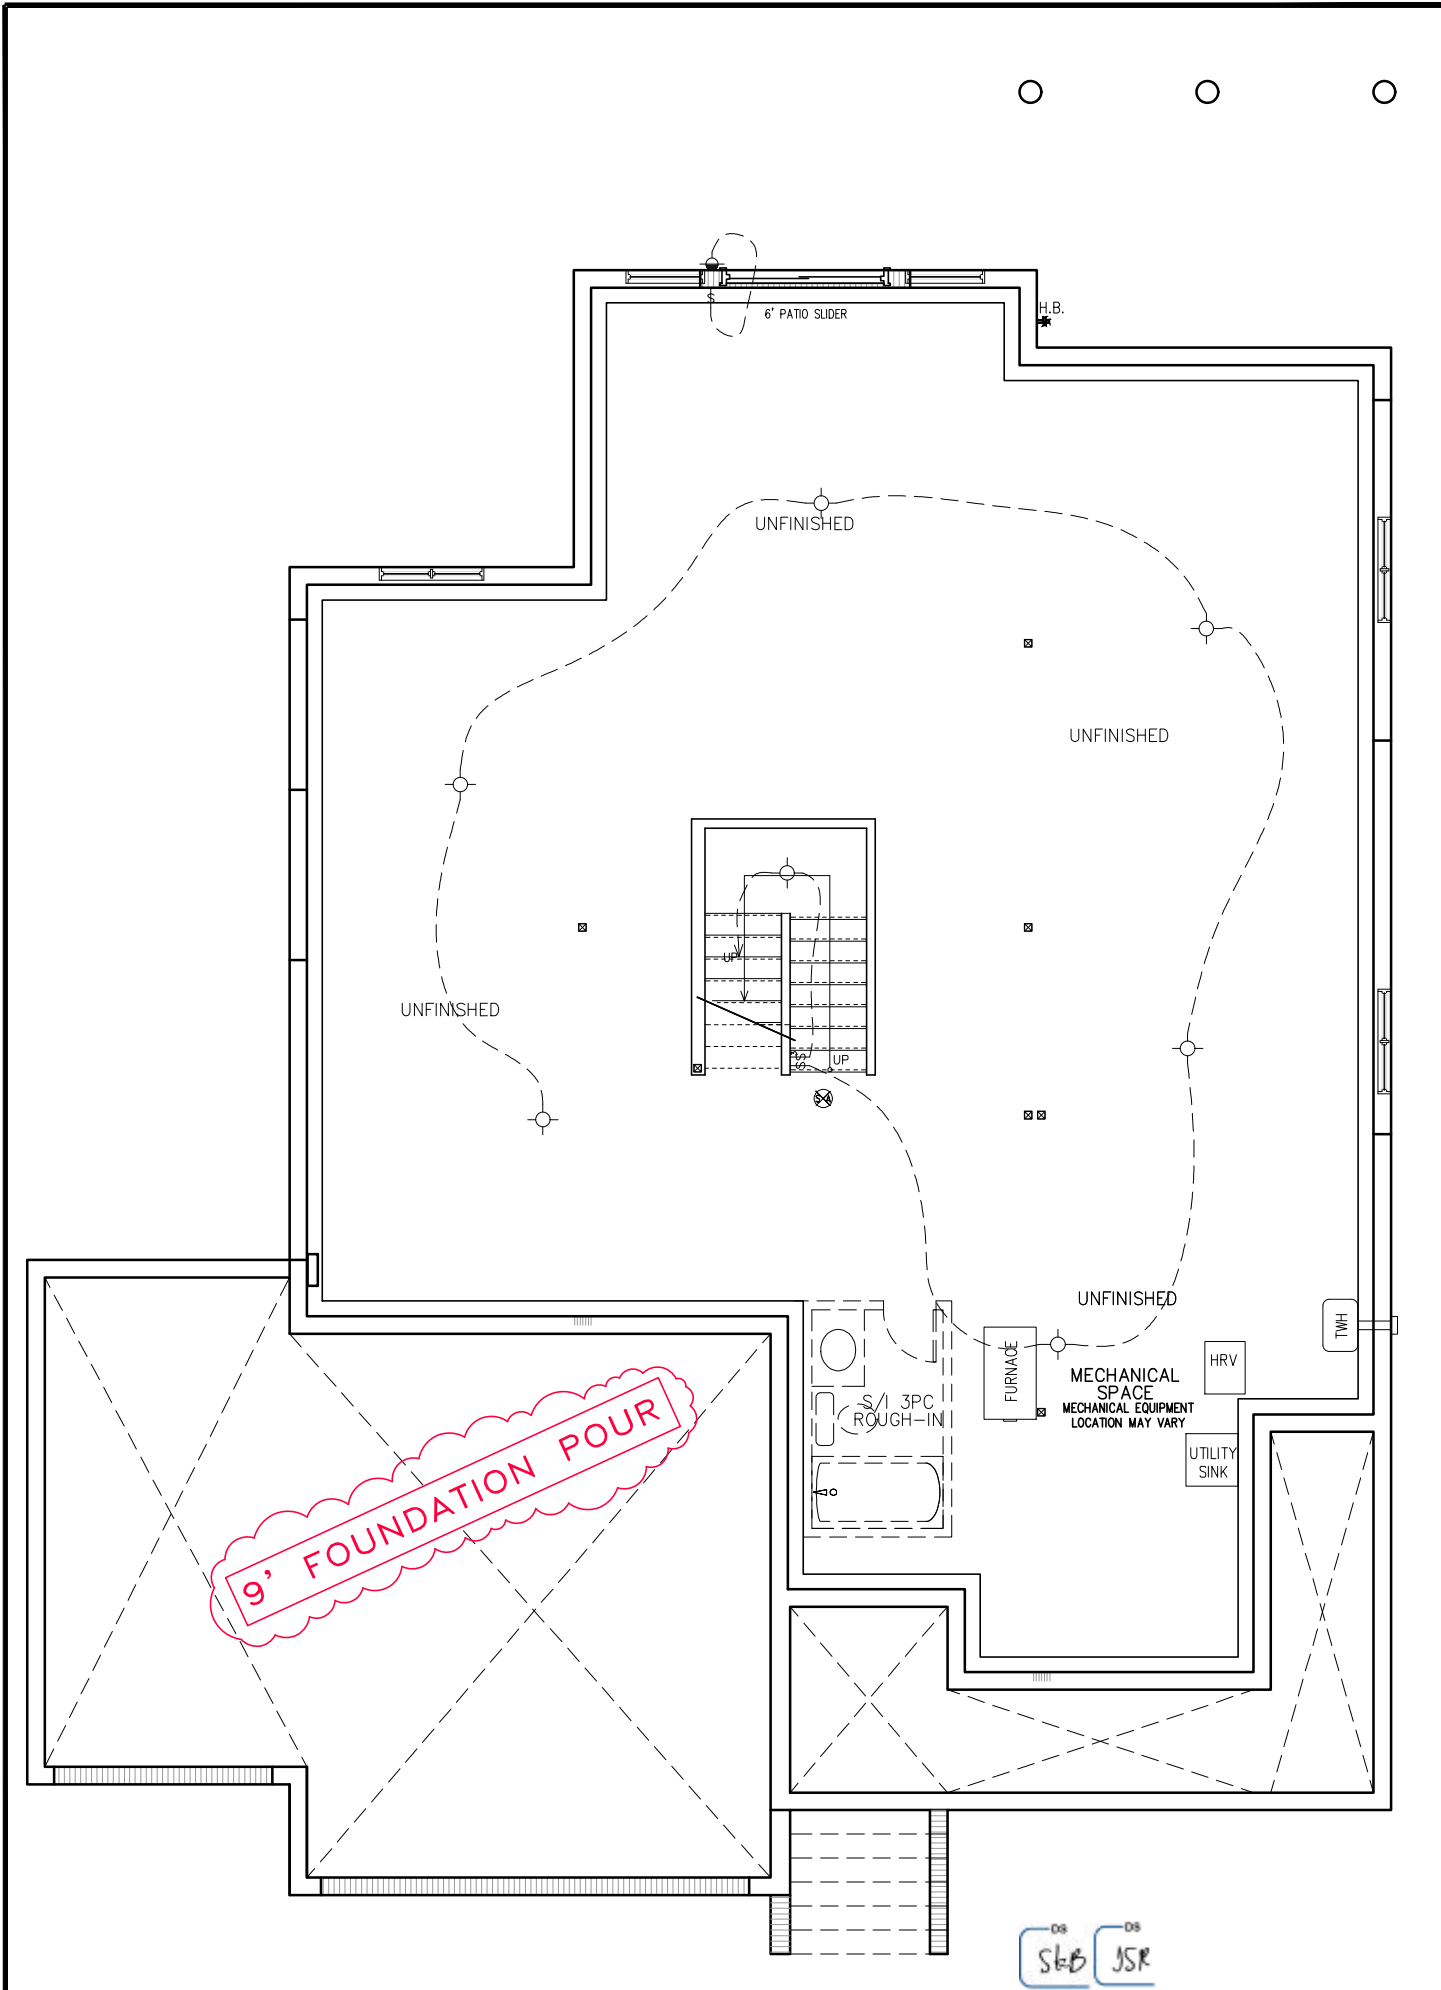

FOUNDATION PLAN (ALL ELEVATIONS)

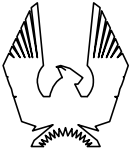

PHOENIX HOMES

NEWINGTON M – 2021

SITE: WHITE TAIL RIDGE

LOT NUMBER:

138

CIVIC ADDRESS:
115 FRANK FISHER CRES

13	FINAL BLACKLINES – REV 9' FOUNDATION	12/12/23	CB
12	FINAL BLACKLINES – REVISED	01/12/23	CB
11	FINAL BLACKLINES	07/11/23	CB
10	CHANGED LOTS TO 138	22/08/23	CB
9	ISSUED FOR ENGINEERING	06/07/23	CB
8	ISSUED FOR LAYOUTS	12/06/23	CB
No.	Description	dd/mm/yy	By
REVISIONS			

footprint: 518

drawn by: SP

date: JUN 12/16


scale: 3/16"=1'-0"

D.C.L. – A5

sheet no:

2M of

9

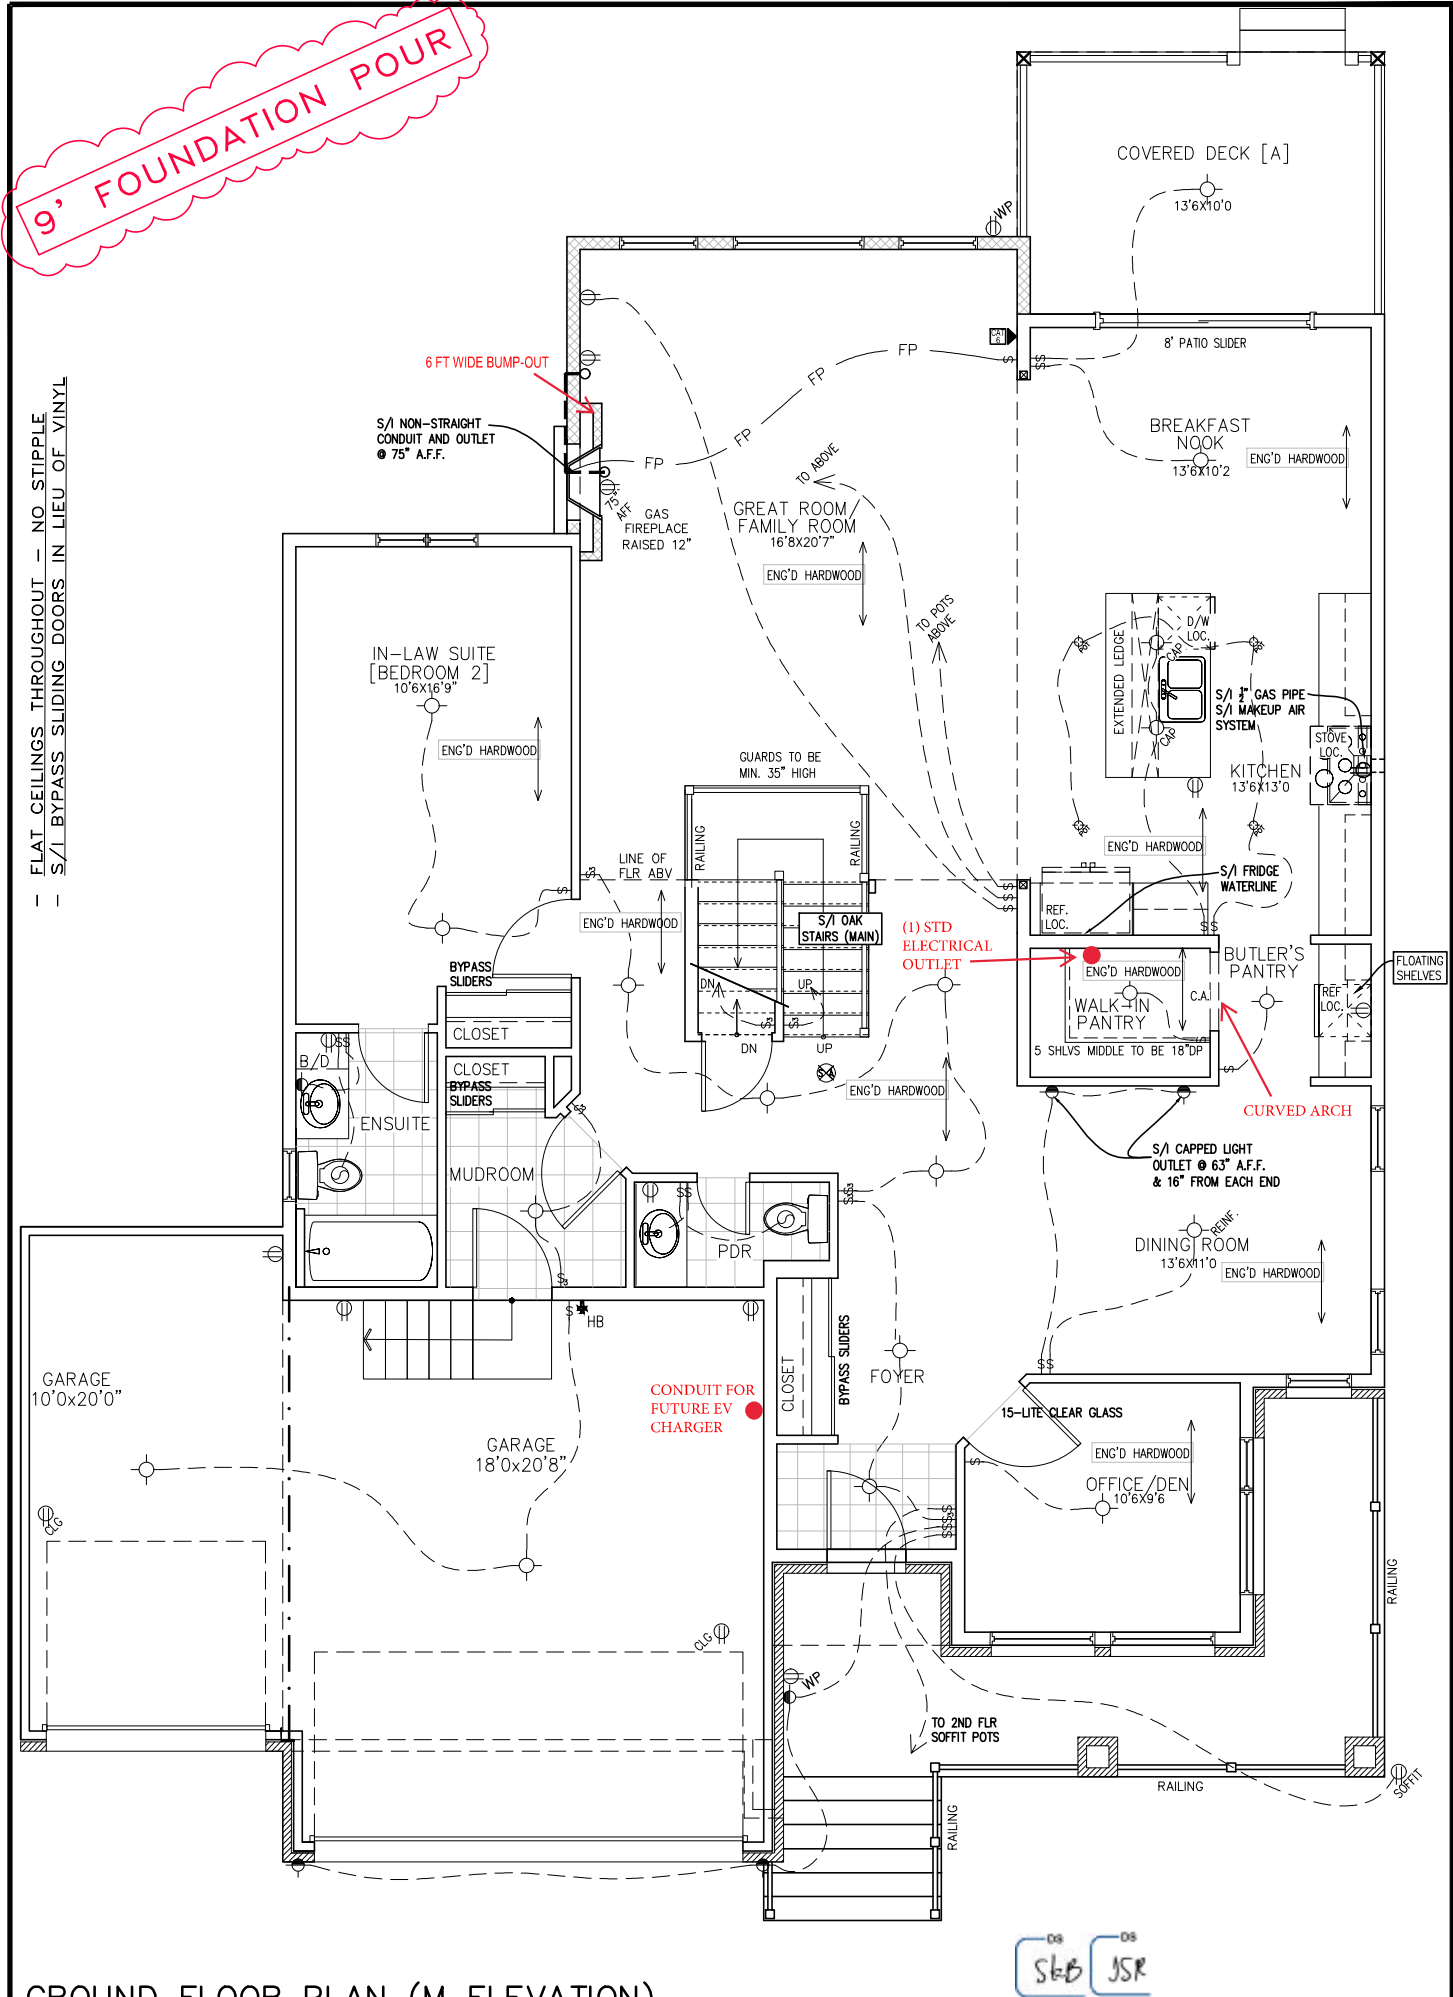

GROUND FLOOR PLAN (M ELEVATION)



NEWINGTON M – 2021

SITE: WHITE TAIL RIDGE

LOT NUMBER: 138

CIVIC ADDRESS: 115 FRANK FISHER CRES

13	FINAL BLACKLINES – REV 9' FOUNDATION	12/12/23	CB
12	FINAL BLACKLINES – REVISED	01/12/23	CB
11	FINAL BLACKLINES	07/11/23	CB
10	CHANGED LOTS TO 138	22/08/23	CB
9	ISSUED FOR ENGINEERING	06/07/23	CB
8	ISSUED FOR LAYOUTS	12/06/23	CB
No.	Description	dd/mm/yy	By
REVISIONS			

footprint: 518

drawn by: SP


date: JUN 12/16

scale: 3/16"=1'-0"

D.C.L. – A5

sheet no: 3M of 9

- FLAT CEILINGS THROUGHOUT - NO STIPPLE
- S/I BYPASS SLIDING DOORS IN LIEU OF VINYL

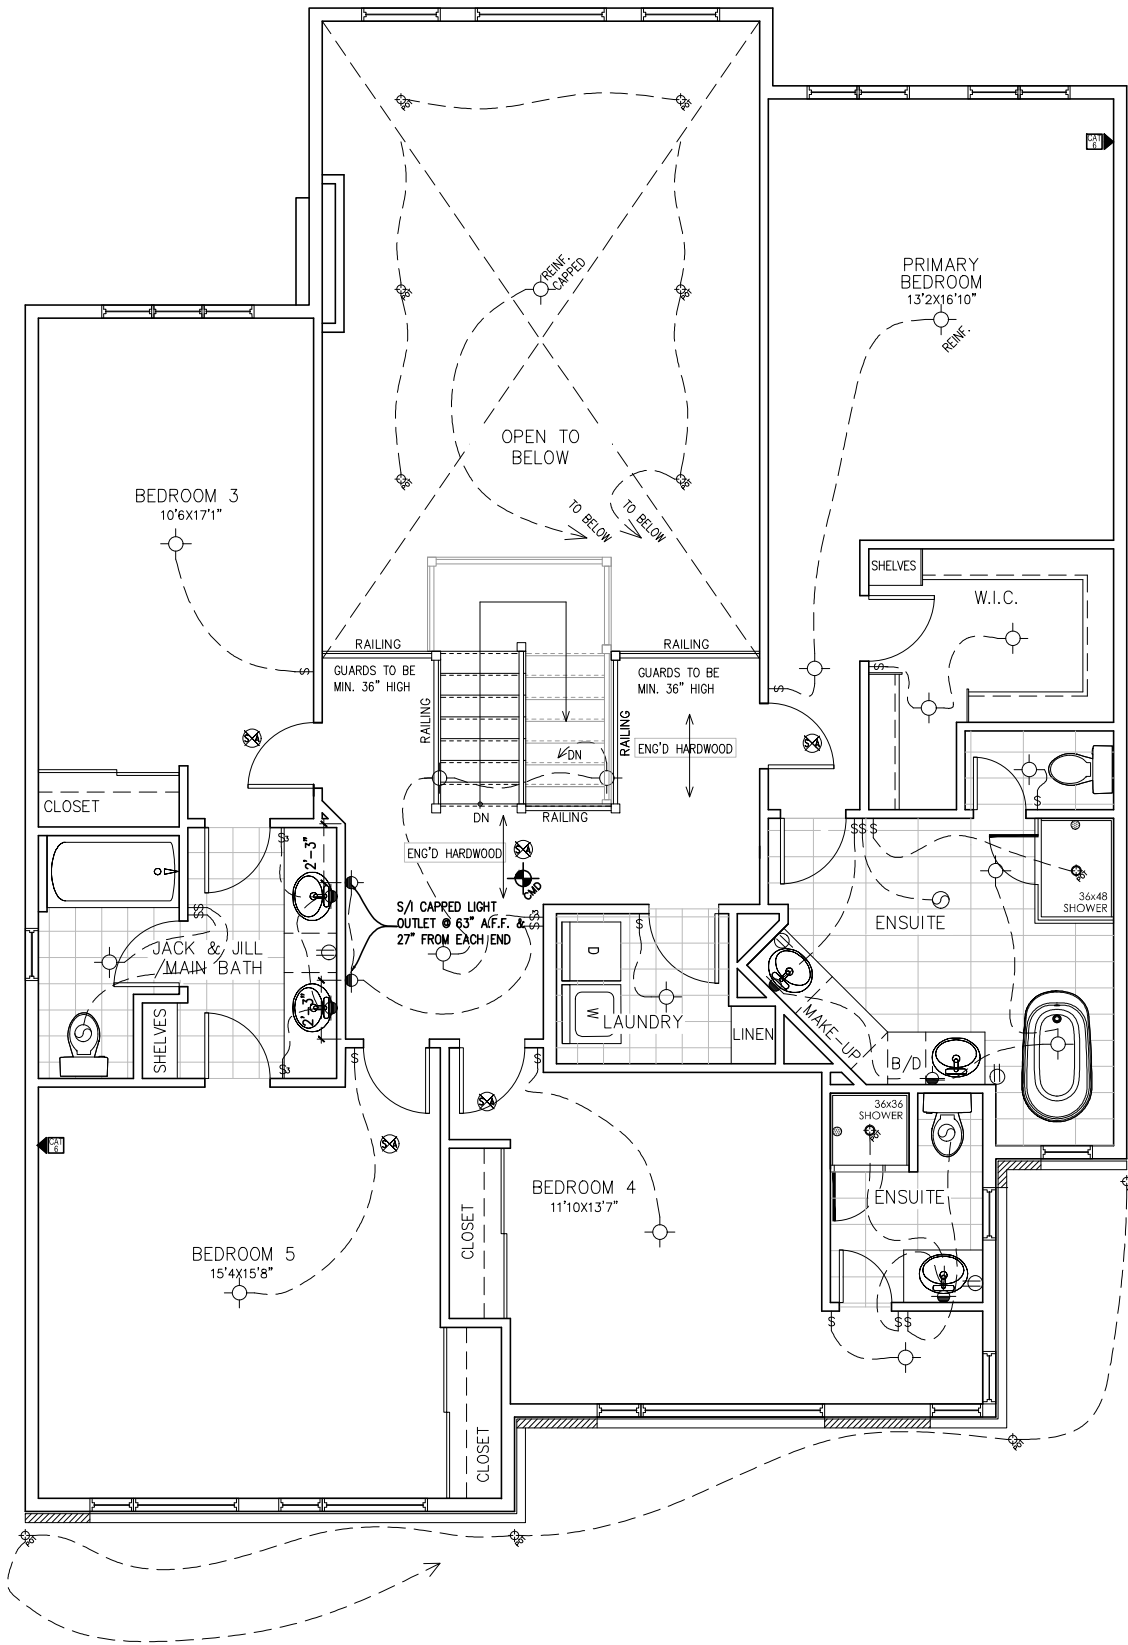

SECOND FLOOR PLAN (ELEVATION M)



NEWINGTON M - 2021

SITE: WHITE TAIL RIDGE

LOT NUMBER: 138

CIVIC ADDRESS: 115 FRANK FISHER CRES

13	FINAL BLACKLINES - REV 9' FOUNDATION	12/12/23	CB
12	FINAL BLACKLINES - REVISED	01/12/23	CB
11	FINAL BLACKLINES	07/11/23	CB
10	CHANGED LOTS TO 138	22/08/23	CB
9	ISSUED FOR ENGINEERING	06/07/23	CB
8	ISSUED FOR LAYOUTS	12/06/23	CB
No. Description		dd/mm/yy	By
REVISIONS			

footprint:	518
drawn by:	SP
date:	JUN 12/16
scale:	3/16"=1'-0"
D.C.L. - A5	
sheet no:	4M of 9

PHOENIX HOMES



NEWINGTON M – 2021

SITE: WHITE TAIL RIDGE

LOT NUMBER:

138

CIVIC ADDRESS:
115 FRANK FISHER CRES

No.	Description	dd/mm/yy	By
13	FINAL BLACKLINES - REV 9' FOUNDATION	12/12/23	CB
12	FINAL BLACKLINES - REVISED	01/12/23	CB
11	FINAL BLACKLINES	07/11/23	CB
10	CHANGED LOTS TO 138	22/08/23	CB
9	ISSUED FOR ENGINEERING	06/07/23	CB
8	ISSUED FOR LAYOUTS	12/06/23	CB

footprint: 518	drawn by: SP	date: JUN 12/16	scale: 3/16"=1'-0"	D.C.L. - AS	sheet no:
SM of 9					

6' FOUNDATION POOR



FRONT ELEVATION M

16'X7' O/H GARAGE DOOR

8'X7' O/H GARAGE DOOR

6' SECOND FLOOR

6M of

9

518

footprint:

drawn by: SP

date: JUN 12/16

scale: 3/16"=1'-0"

D.C.L. - A5

sheet no:

13	FINAL BLACKLINES - REV 9' FOUNDATION	12/12/23	CB
12	FINAL BLACKLINES - REVISED	01/12/23	CB
11	FINAL BLACKLINES	07/11/23	CB
10	CHANGED LOTS TO 138	22/08/23	CB
9	ISSUED FOR ENGINEERING	06/07/23	CB
8	ISSUED FOR LAYOUTS	12/06/23	CB
REVISIONS		dd/mm/yy	By

NEWINGTON M - 2021

138

LOT NUMBER:

CIVIC ADDRESS:
115 FRANK FISHER CRES

SITE: WHITE TAIL RIDGE

PHOENIX HOMES




9' FOUNDATION POUR

SR
DB

REAR ELEVATION M

6' SECONDS FLOOR

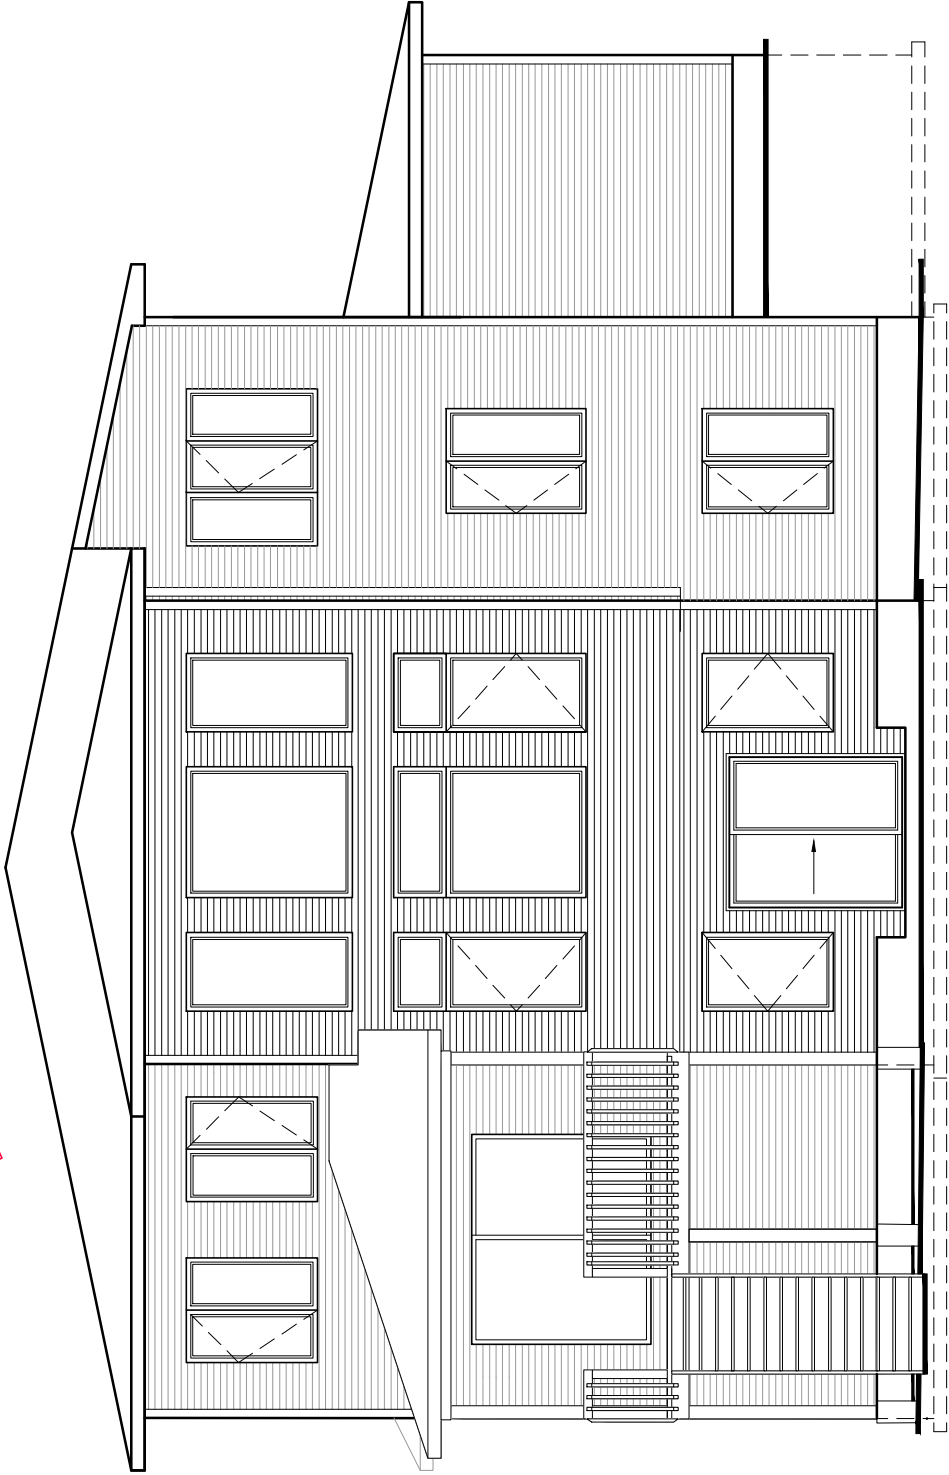

PHOENIX HOMES



LOT NUMBER:

SITE: WHITE TAIL RIDGE

CIVIC ADDRESS:
115 FRANK FISHER CRES

138

NEWINGTON M - 2021

No.	Description	dd/mm/yy	By
13	FINAL BLACKLINES - REV 9' FOUNDATION	12/12/23	CB
12	FINAL BLACKLINES - REVISED	01/12/23	CB
11	FINAL BLACKLINES	07/11/23	CB
10	CHANGED LOTS TO 138	22/08/23	CB
9	ISSUED FOR ENGINEERING	06/07/23	CB
8	ISSUED FOR LAYOUTS	12/06/23	CB


footprint: 518	drawn by: SP	date: JUN 12/16	scale: 3/16"=1'-0"	D.C.L. - A5	sheet no:
9 of 7M					

JSR
S&B
DB DB

RIGHT SIDE ELEVATION M

9' FOUNDATION FOUR

9' SECOND FLOOR

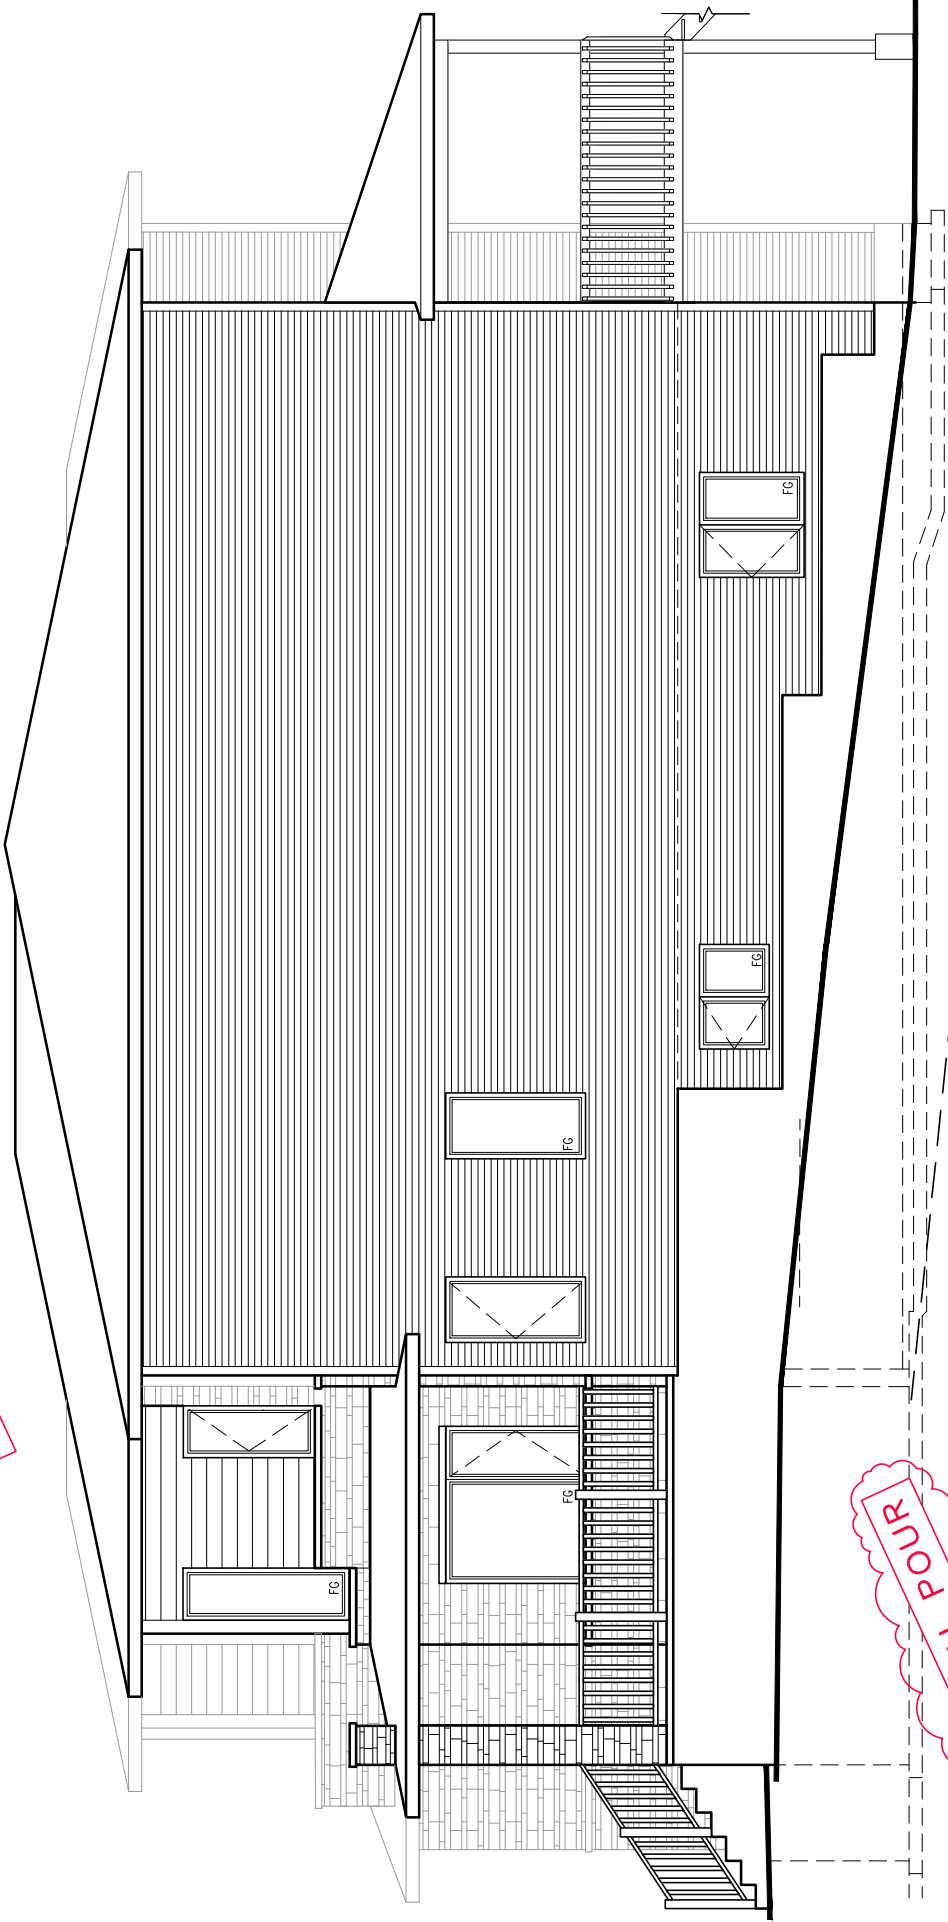

PHOENIX HOMES



NEWINGTON M – 2021

SITE: WHITE TAIL RIDGE

LOT NUMBER:

CIVIC ADDRESS:
115 FRANK FISHER CRES

138

REVISIONS		
No.	Description	
13	FINAL BLACKLINES – REV 9' FOUNDATION	12/12/23 CB
12	FINAL BLACKLINES – REVISED	01/12/23 CB
11	FINAL BLACKLINES	07/11/23 CB
10	CHANGED LOTS TO 138	22/08/23 CB
9	ISSUED FOR ENGINEERING	06/07/23 CB
8	ISSUED FOR LAYOUTS	12/06/23 CB
		By dd/mm/yy

footprint: 518

drawn by: SP


date: JUN 12/16

scale: 3/16"=1'-0"

D.C.L. – A5

sheet no:

8M of 9

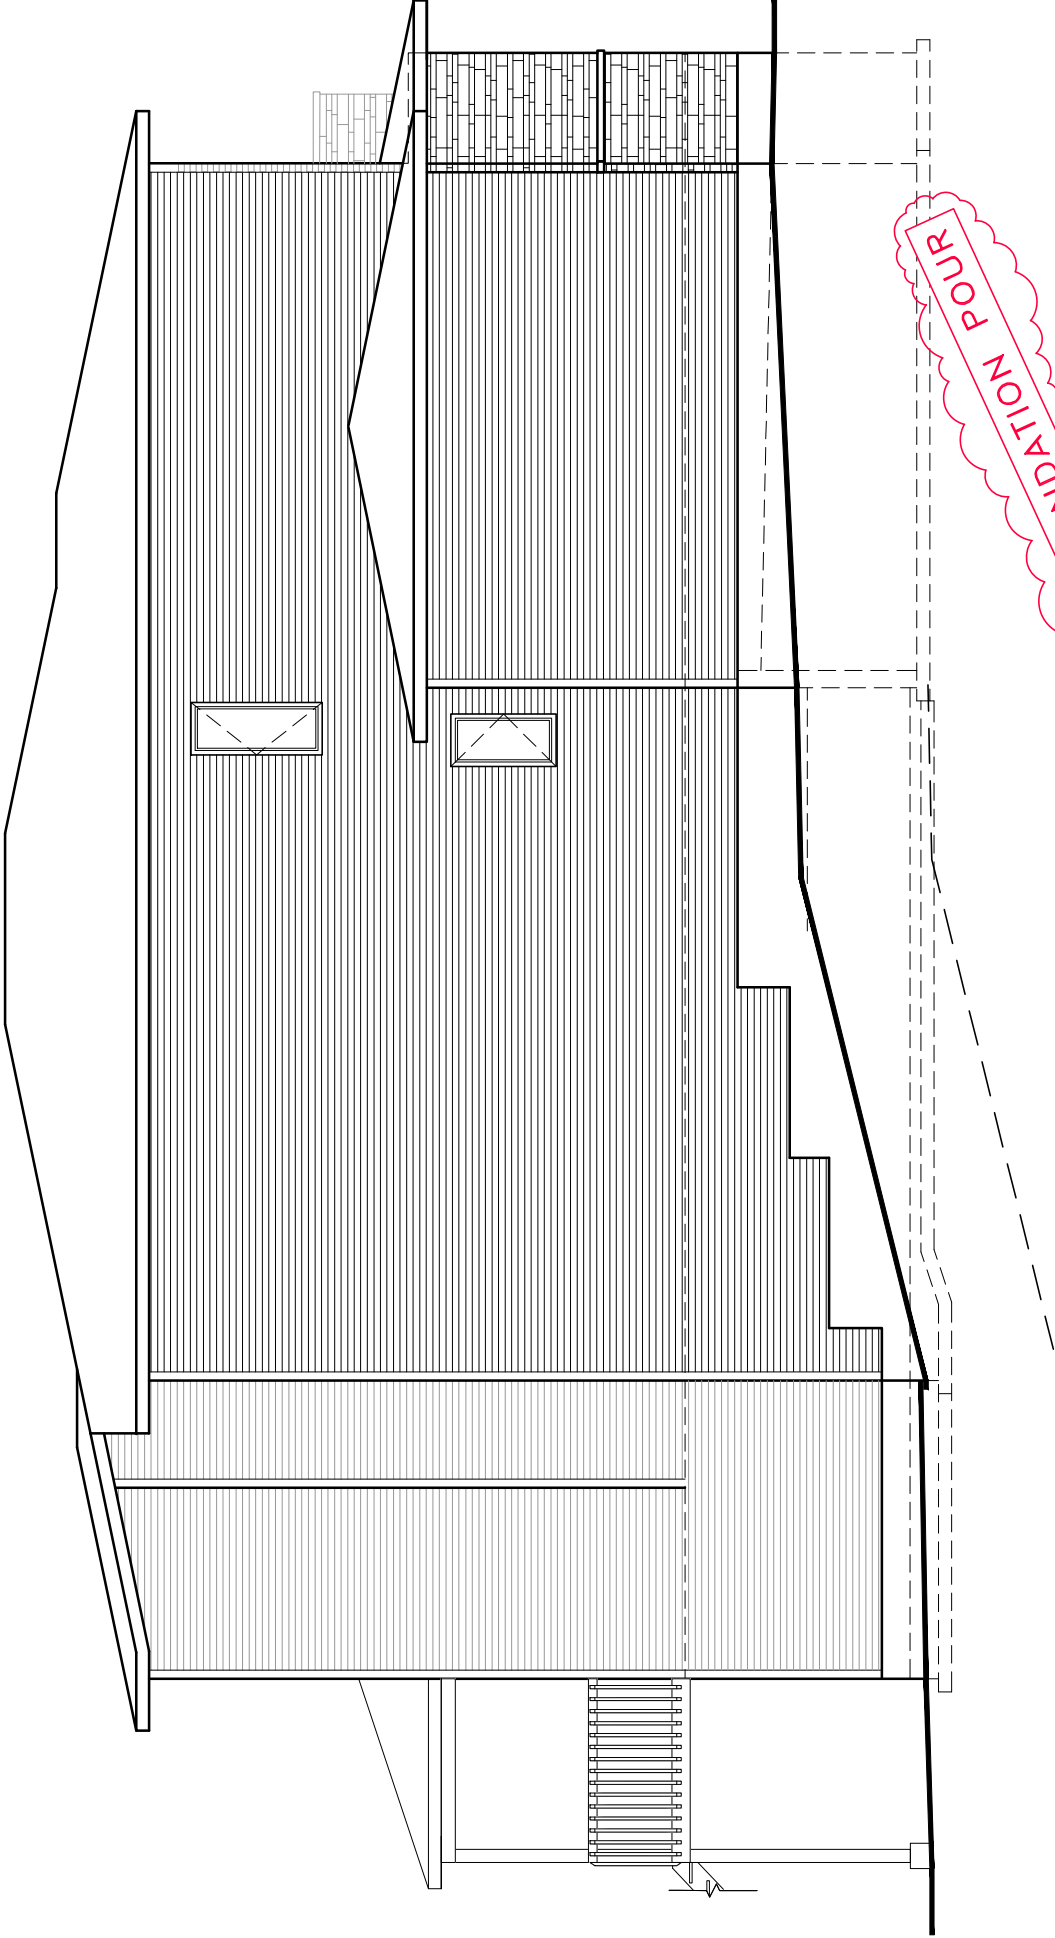

LEFT SIDE ELEVATION M

6' SECOND FLOOR