
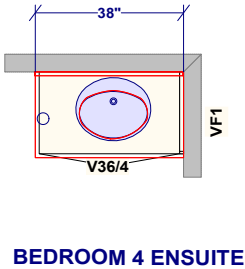
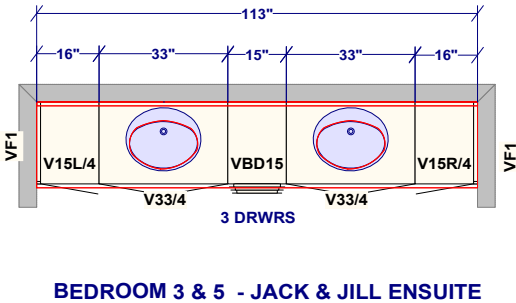
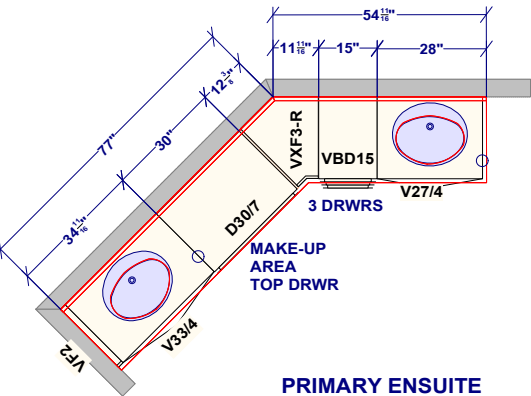
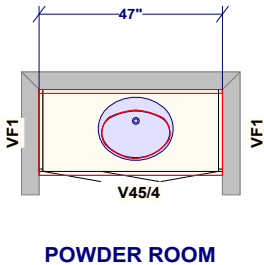
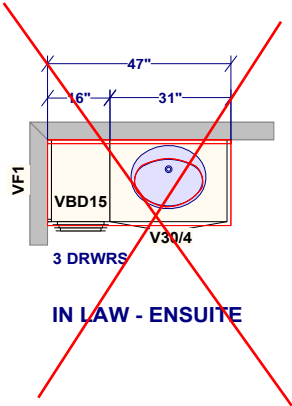


DCR PHOENIX HOMES

NEWINGTON
GARAGE RIGHT
VANITIES
5 BDRM

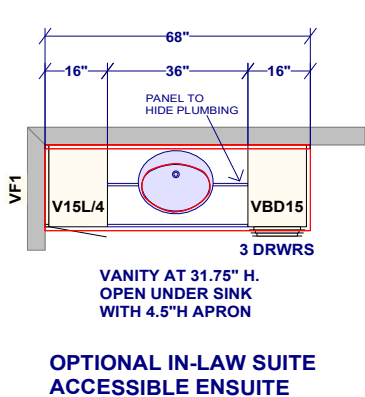

CUSTOMER APPROVAL

I have reviewed these drawings and understand the details of the design and the Cartier Kitchens specifications

Signature _____


Date _____

All dimensions size designations given are subject to verification on job site and adjustment to fit job conditions.




This is an original design and must not be released or copied unless applicable fee has been paid or job order placed.


Designed: 4/12/2023
Printed: 4/12/2023

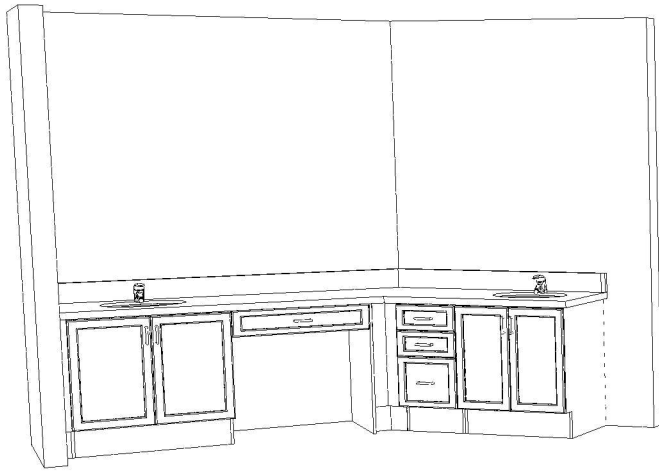

PRIMARY ENSUITE

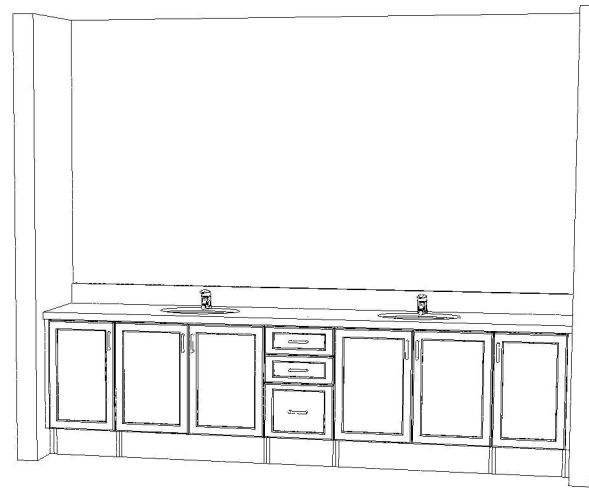

BEDROOM 3 & 5-JACK&JILL ENSUITE

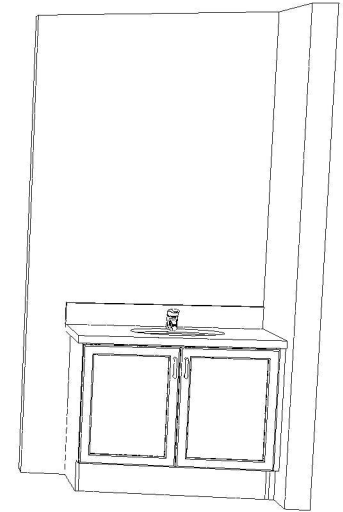

BEDROOM 4 ENSUITE

VANITY 3D VIEW

CUSTOMER APPROVAL

I have reviewed these drawings and understand the details of the design and the Cartier Kitchens specifications


Signature _____

Date _____


Note: This drawing is an artistic interpretation of the general appearance of the design. It is not meant to be an exact rendition.




Designed: 4/12/2023
Printed: 4/12/2023

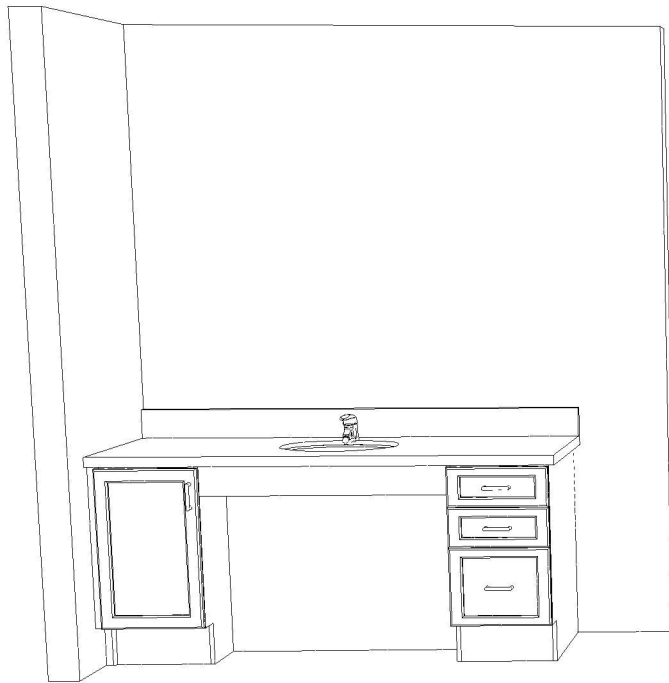

OPTIONAL IN-LAW SUITE
ACCESSIBLE ENSUITE

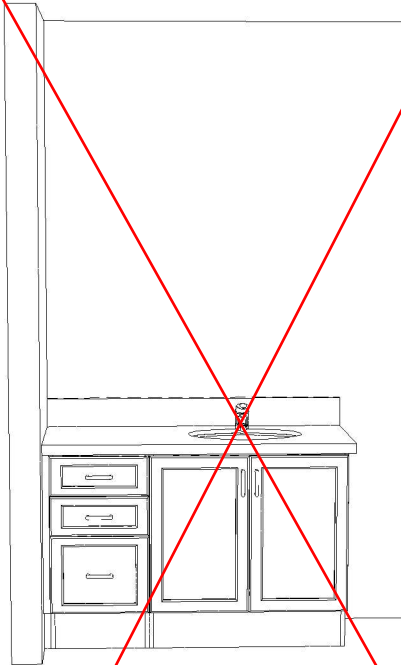

IN LAW - ENSUITE

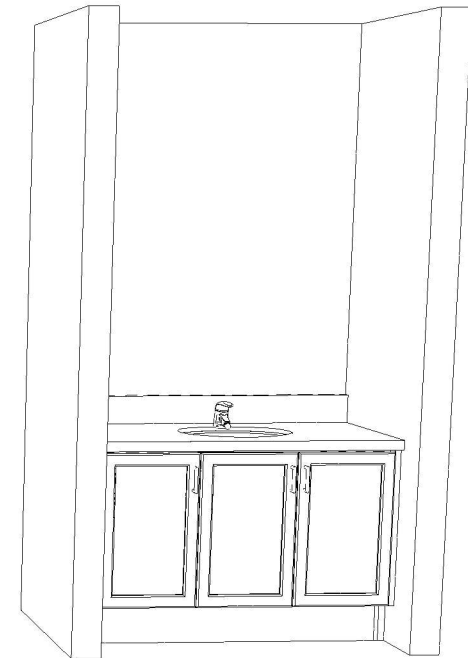

POWDER ROOM

VANITY 3D VIEW

CUSTOMER APPROVAL

I have reviewed these drawings and understand the details of the design and the Cartier Kitchens specifications

Signature _____

Date _____

Note: This drawing is an artistic interpretation of the general appearance of the design. It is not meant to be an exact rendition.



Designed: 4/12/2023
Printed: 4/12/2023