


$$\frac{2M_{of}}{9}$$


- FLAT CEILINGS THROUGHOUT - NO STIPPLE
- S/I BYPASS SLIDING DOORS IN LIEU OF VINYL

****NOTE****
ALL WINDOW LINTELS TO BE 2-2X10
W/ P2 POSTS ON EACH SIDE U.N.O.

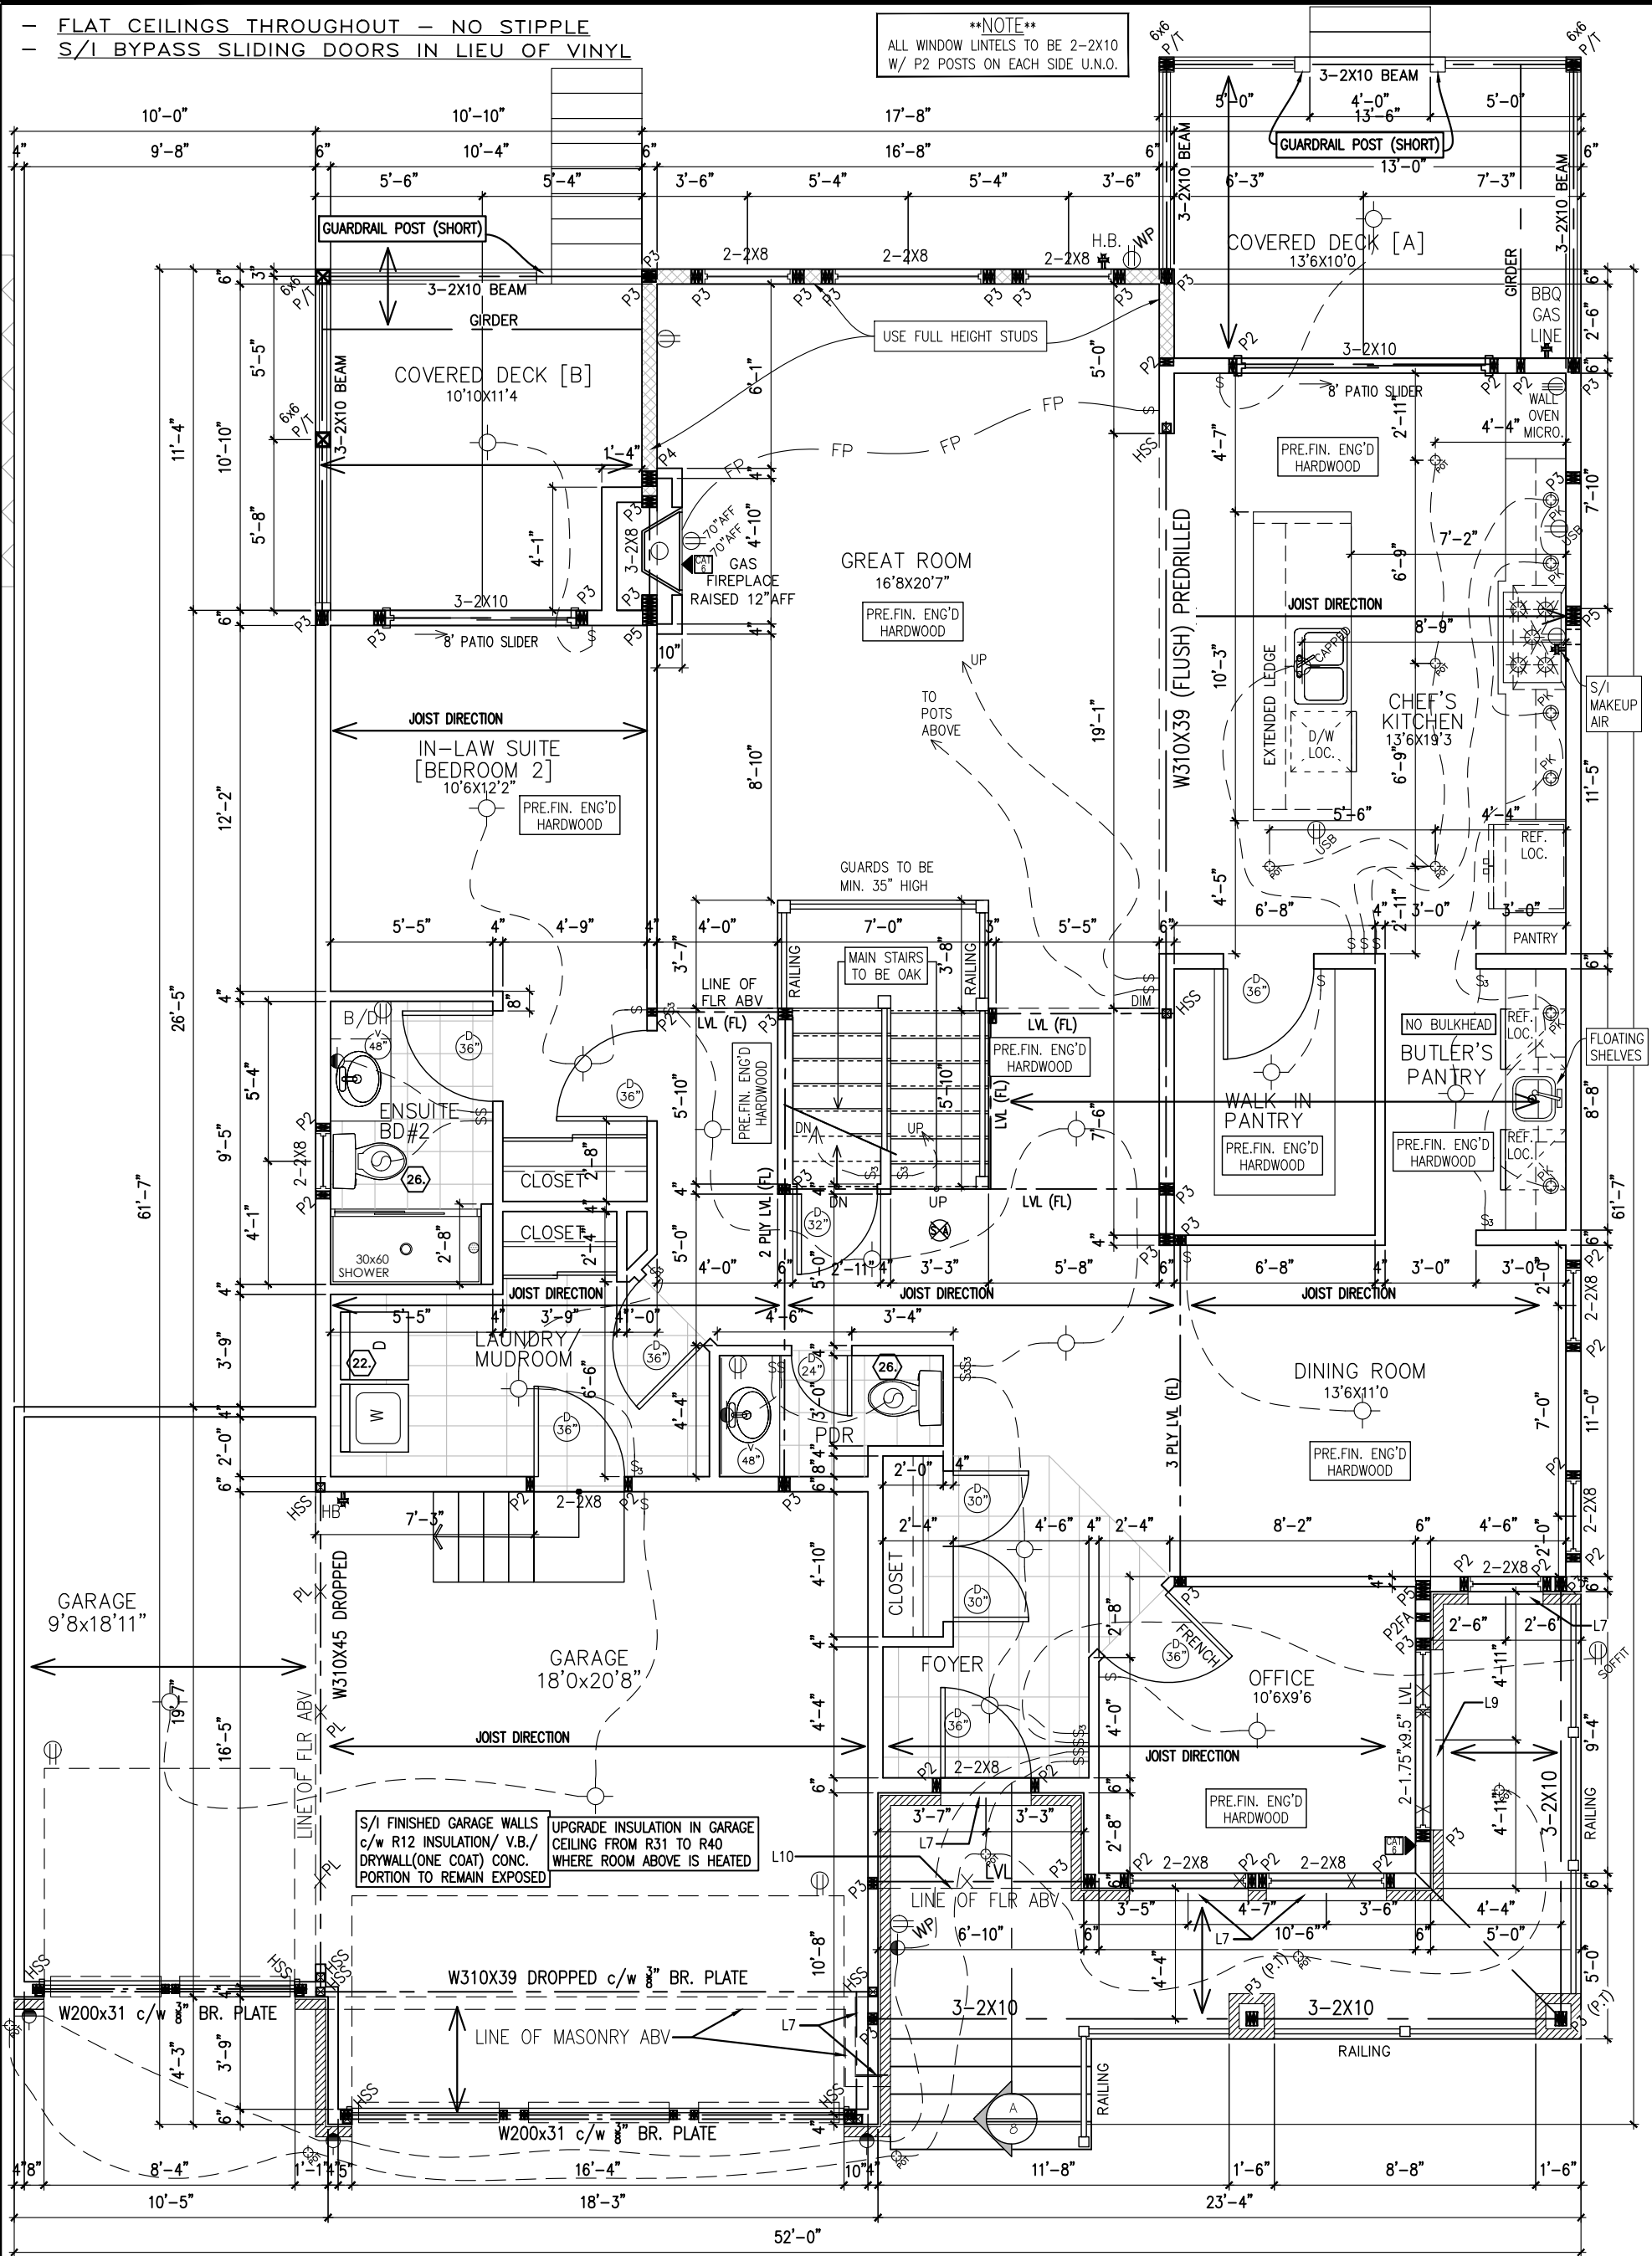

GROUND FLOOR PLAN (M ELEVATION)

1782 SQ. FT.

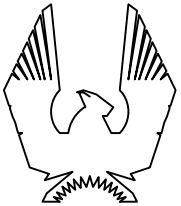

PHOENIX HOMES

NEWINGTON M - 2021

SITE: WHITE TAIL RIDGE

LOT NUMBER:

135

CIVIC ADDRESS:
108 FRANK FISHER CRESCENT

11 FINAL FOR CONSTRUCTION-REVISED

19/08/24

SP

10 FINAL FOR CONSTRUCTION

06/08/24

SP

9 FINAL FOR SITE

11/01/24

CB

8 FINAL BLACKLINES

16/11/23

CB

7 BEP BLACKLINES

14/07/23

CB

6 B1 BLACKLINES

01/06/23

CB

No. Description
REVISIONS

dd/mm/yy By

footprint: 518

drawn by: SP

date: JUN 12/16

scale: 3/16"=1'-0"


D.C.L. - A45

sheet no:


3M of
9

- FLAT CEILINGS THROUGHOUT - NO STIPPLE
- S/I BYPASS SLIDING DOORS IN LIEU OF VINYL

****NOTE****
ALL WINDOW LINTELS TO BE 2-2X10
W/ P2 POSTS ON EACH SIDE U.N.O.

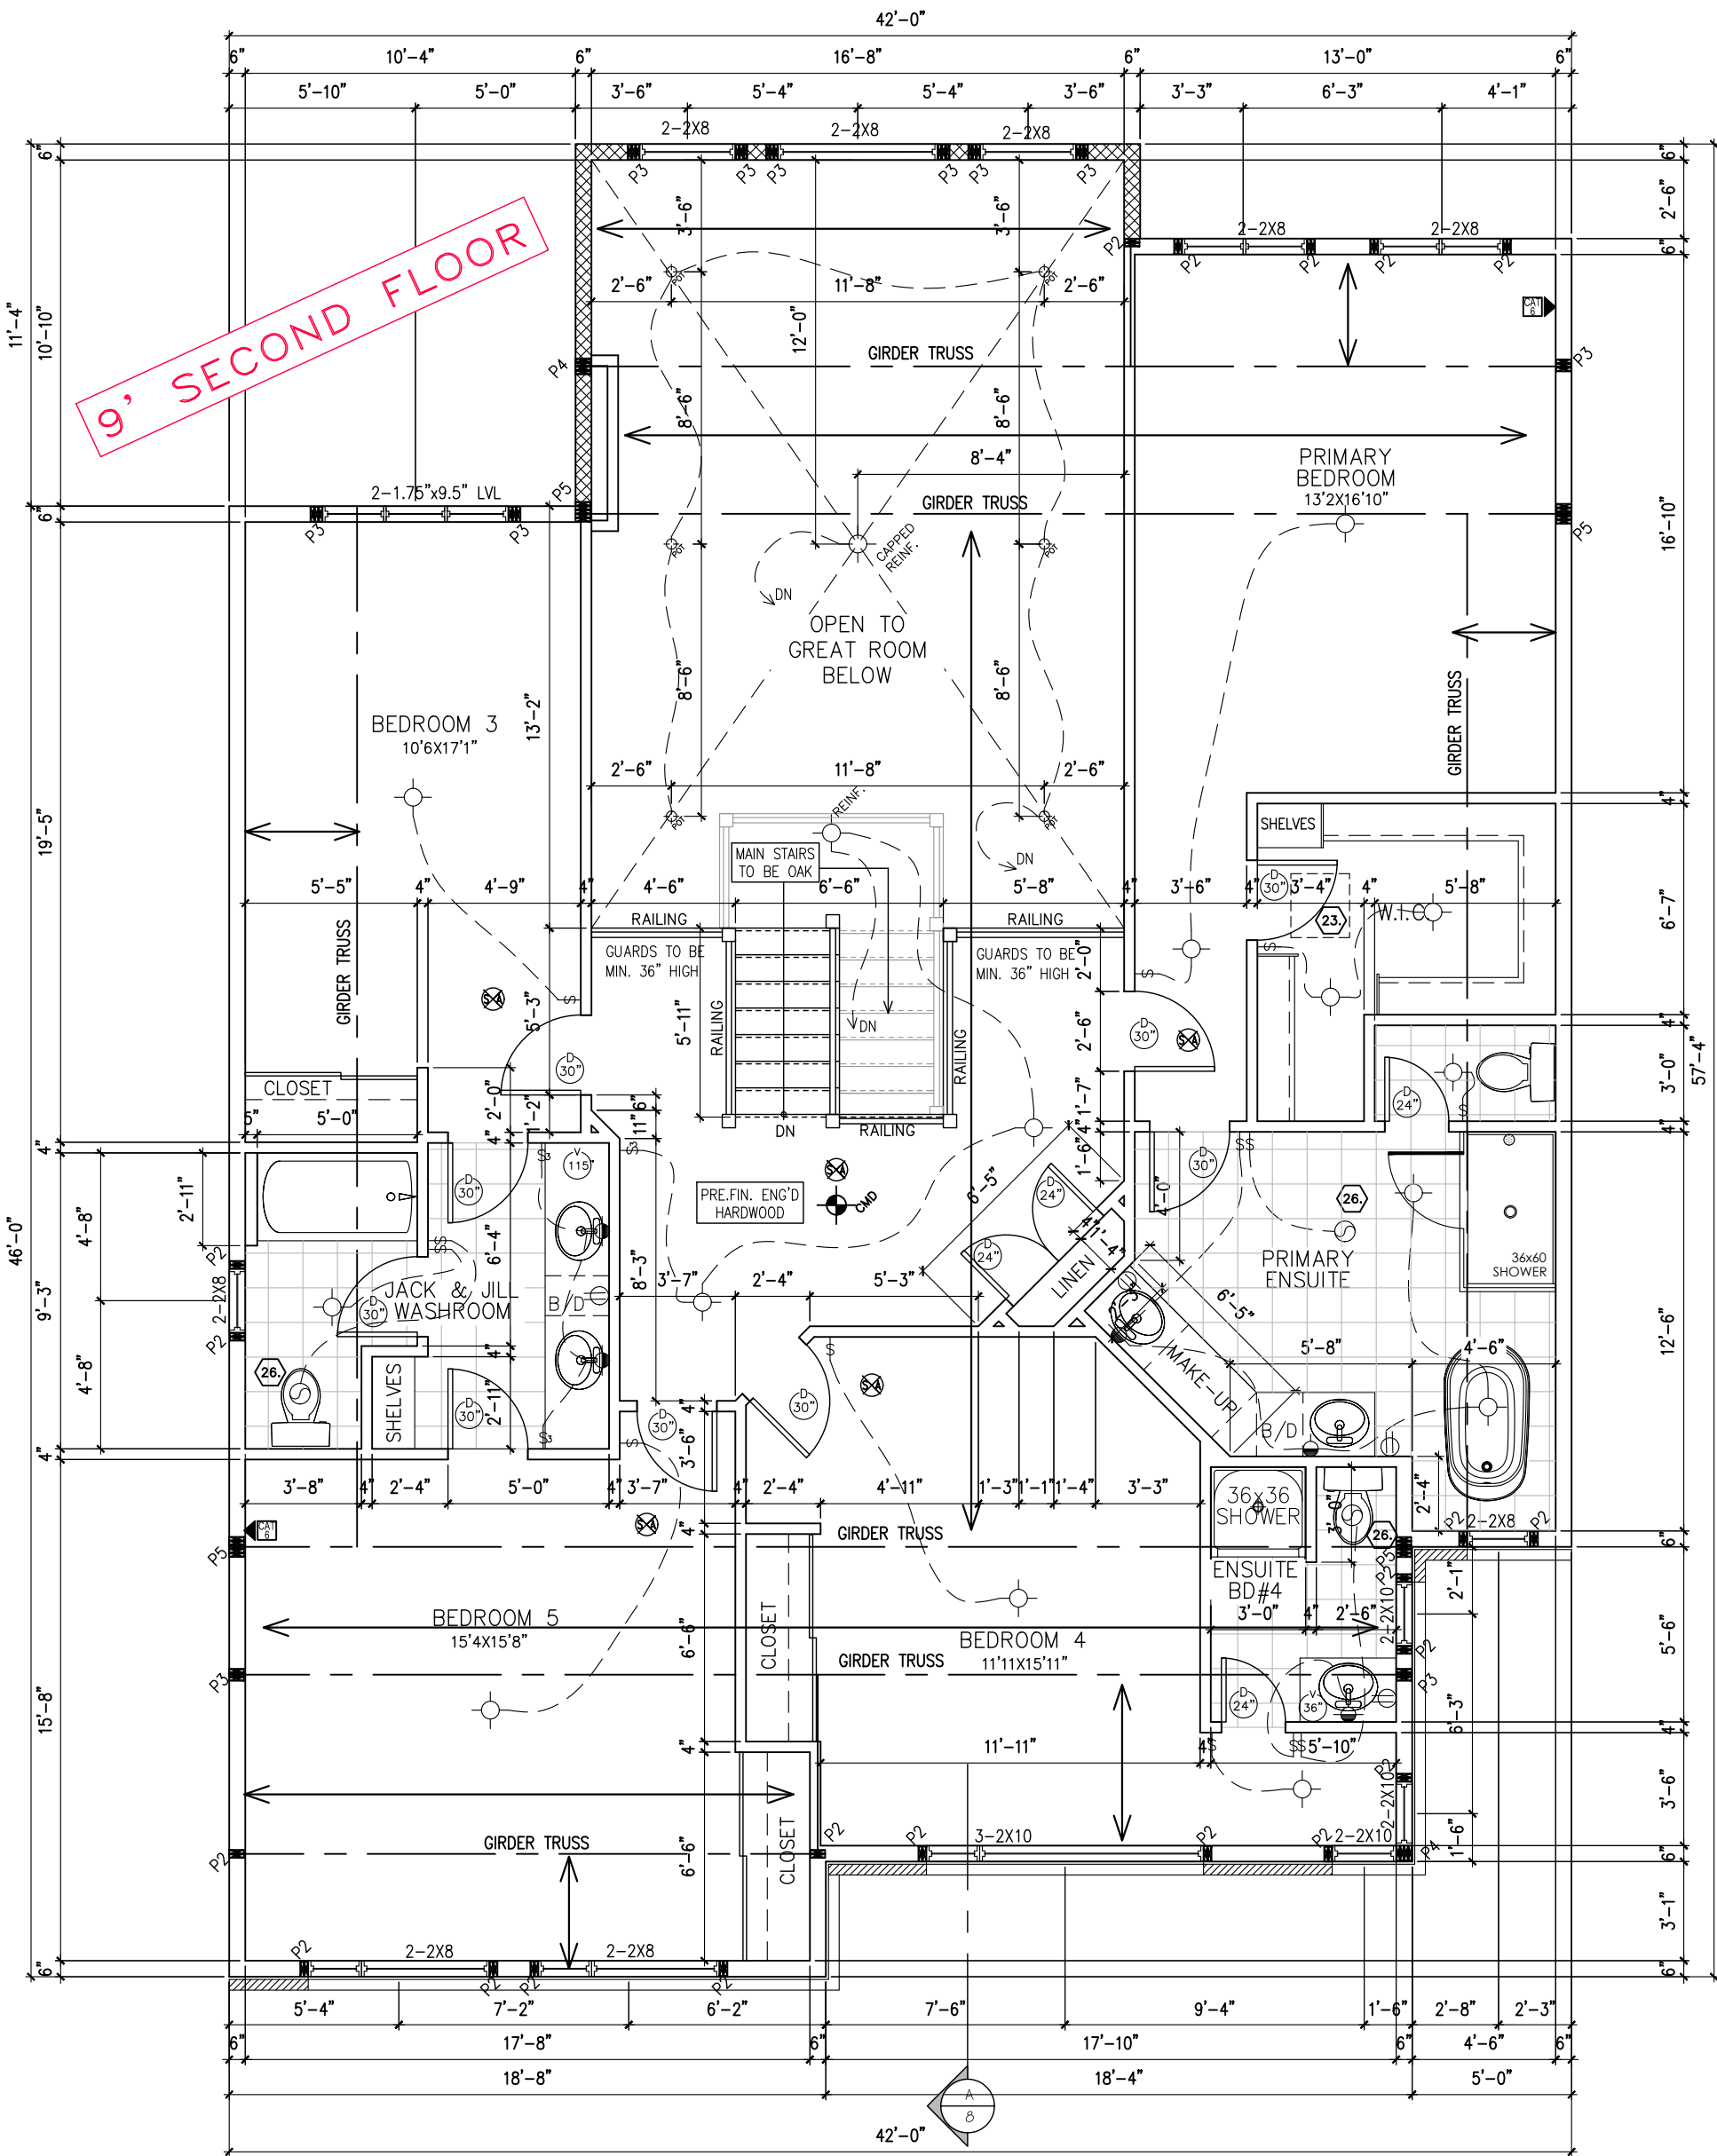

SECOND FLOOR PLAN (ELEVATION M)
1672 SQ. FT.

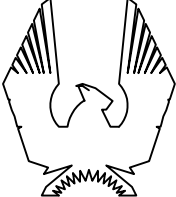

PHOENIX HOMES

NEWINGTON M – 2021

SITE: WHITE TAIL RIDGE

LOT NUMBER:

CIVIC ADDRESS:
108 FRANK FISHER CRESCENT

135

11	FINAL FOR CONSTRUCTION-REVISED	19/08/24	SP
10	FINAL FOR CONSTRUCTION	06/08/24	SP
9	FINAL FOR SITE	11/01/24	CB
8	FINAL BLACKLINES	16/11/23	CB
7	BEP BLACKLINES	14/07/23	CB
6	B1 BLACKLINES	01/06/23	CB
No.	Description	dd/mm/yy	By
REVISIONS			

footprint: 518

drawn by: SP

date: JUN 12/16


scale: 3/16"=1'-0"

D.C.L. – A45

sheet no:

4M of 9

9' SECOND FLOOR

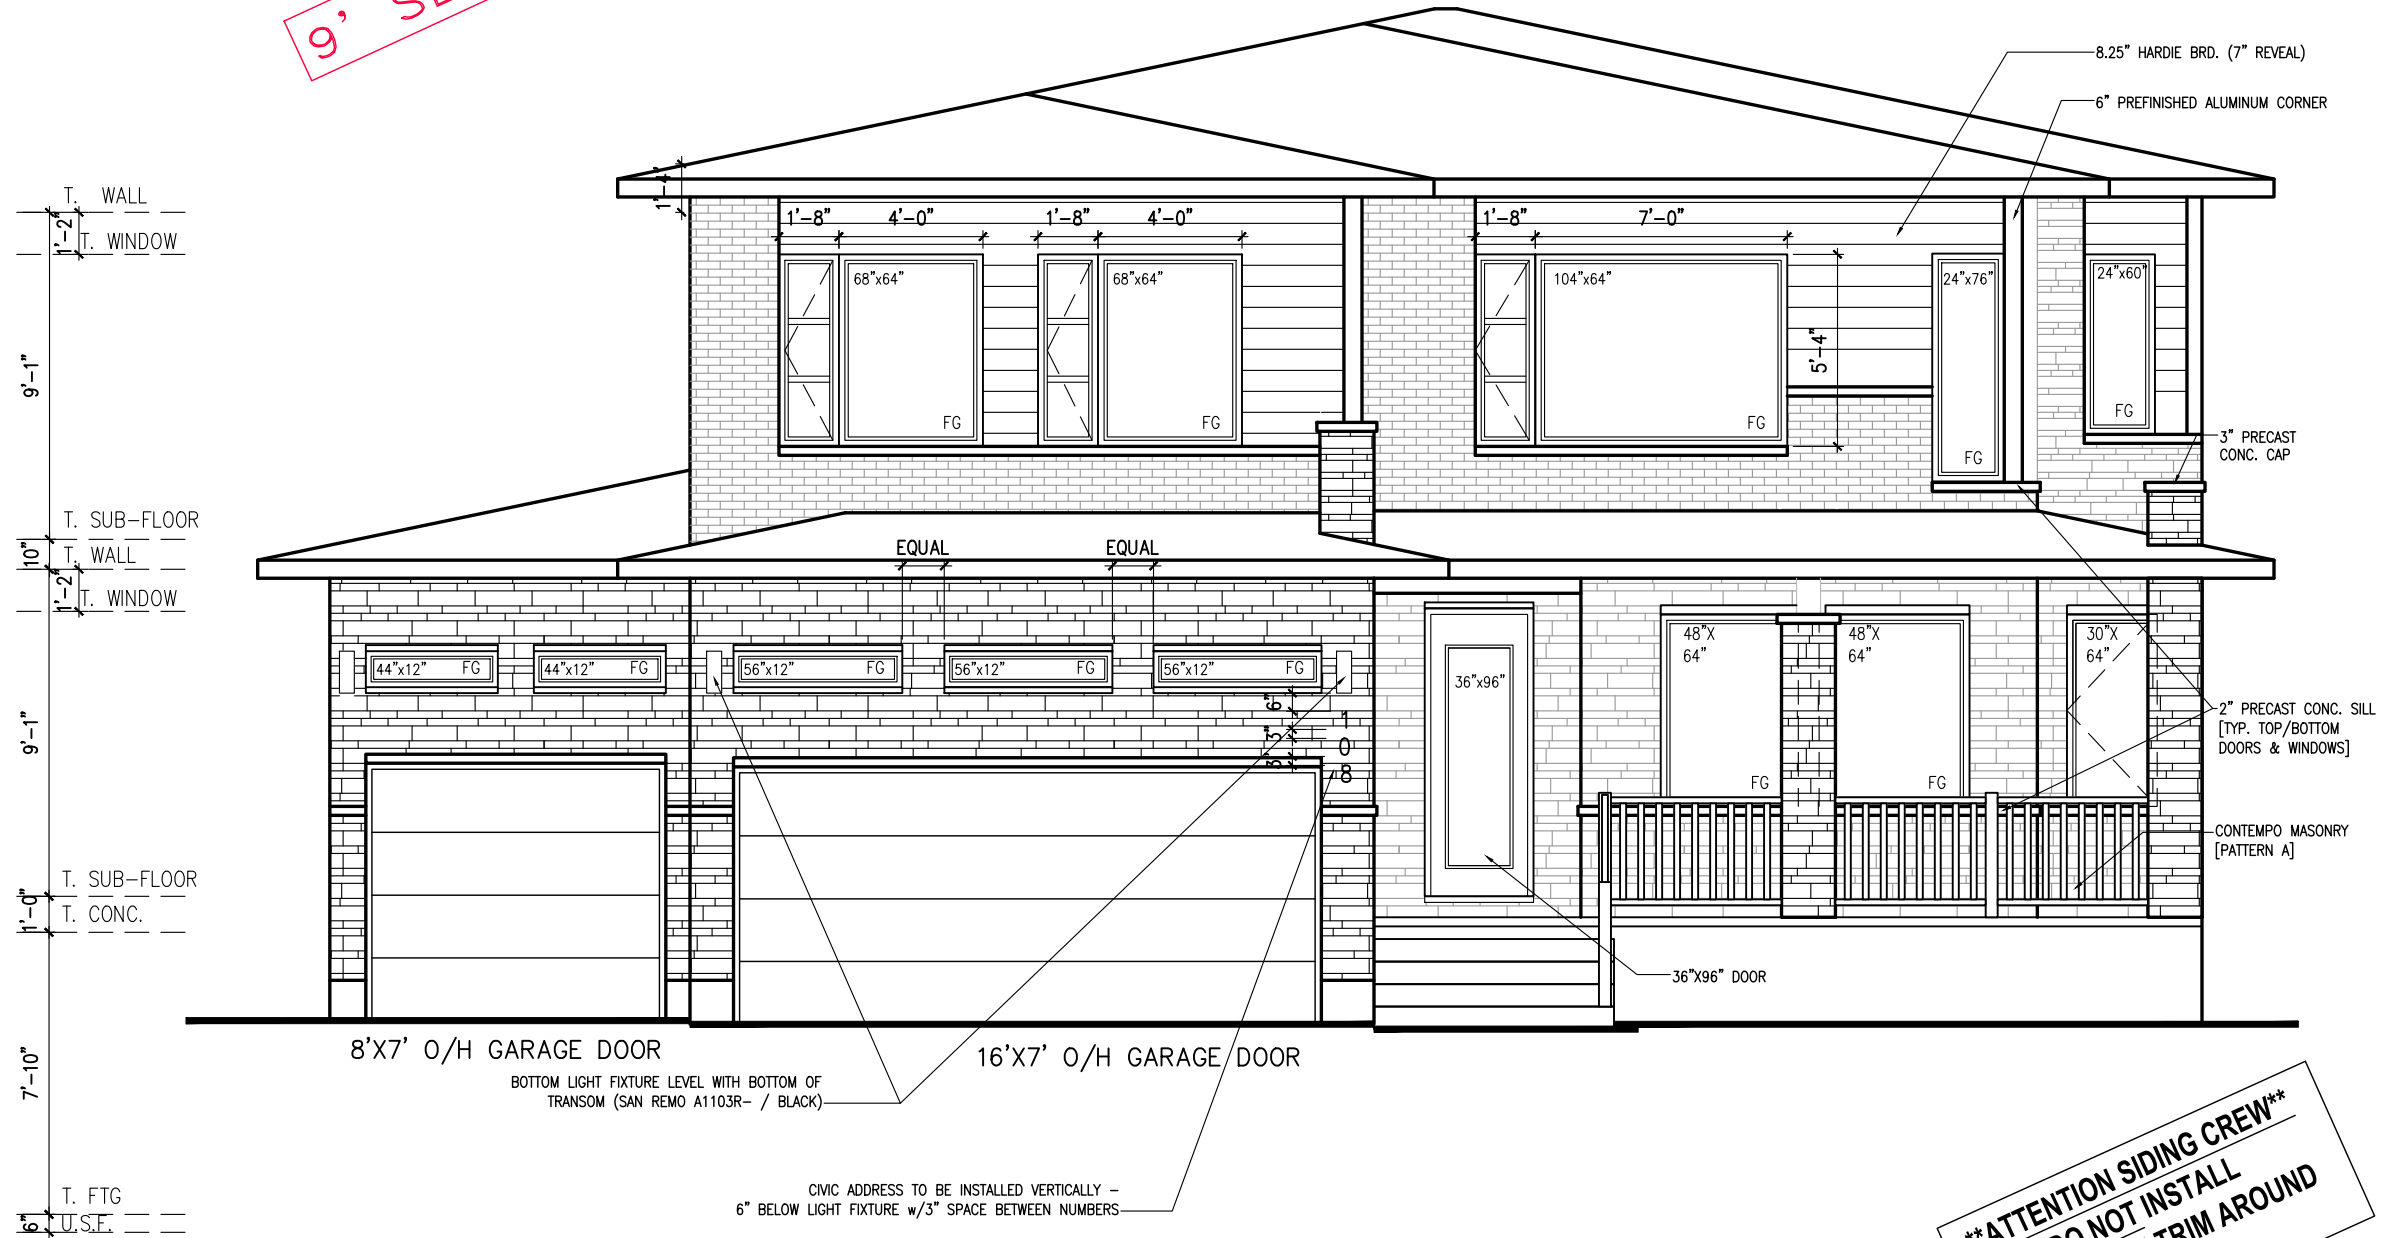

footprint:	518
drawn by:	SP
date:	JUN 12/16
scale:	3/16"=1'-0"
D.C.L. - A45	
sheet no:	5M of 9


No.	Description	By
11	FINAL FOR CONSTRUCTION-REVISED	19/08/24 SP
10	FINAL FOR CONSTRUCTION	06/08/24 SP
9	FINAL FOR SITE	11/01/24 CB
8	FINAL BLACKLINES	16/11/23 CB
7	BEP BLACKLINES	14/07/23 CB
6	B1 BLACKLINES	01/06/23 CB
REVISIONS		

NEWINGTON M - 2021
SITE: WHITE TAIL RIDGE
LOT NUMBER: 135
CIVIC ADDRESS: 108 FRANK FISHER CRESCENT

PHOENIX HOMES



ELEVATION M

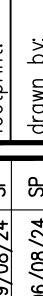

PHOENIX HOMES

NEWINGTON M – 2021

SITE: WHITE TAIL RIDGE

135

LOT NUMBER:

CIVIC ADDRESS:
108 FRANK FISHER CRESCENT

11	FINAL FOR CONSTRUCTION-REVISED	19/08/24	SP
10	FINAL FOR CONSTRUCTION	06/08/24	SP
9	FINAL FOR SITE	11/01/24	CB
8	FINAL BLACKLINES	16/11/23	CB
7	BEP BLACKLINES	14/07/23	CB
6	B1 BLACKLINES	01/06/23	CB
No.	Description	ad/mm/yy	By
REVISIONS			

11	FINAL FOR CONSTRUCTION-REVISED
10	FINAL FOR CONSTRUCTION
9	FINAL FOR SITE
8	FINAL BLACKLINES
7	BEP BLACKLINES
6	B1 BLACKLINES
No.	Description
REVISIONS	

11	FINAL FOR CONSTRUCTION-REVISED
10	FINAL FOR CONSTRUCTION
9	FINAL FOR SITE
8	FINAL BLACKLINES
7	BEP BLACKLINES
6	B1 BLACKLINES
No.	Description
REVISIONS	

11	FINAL FOR CONSTRUCTION-REVISED
----	--------------------------------

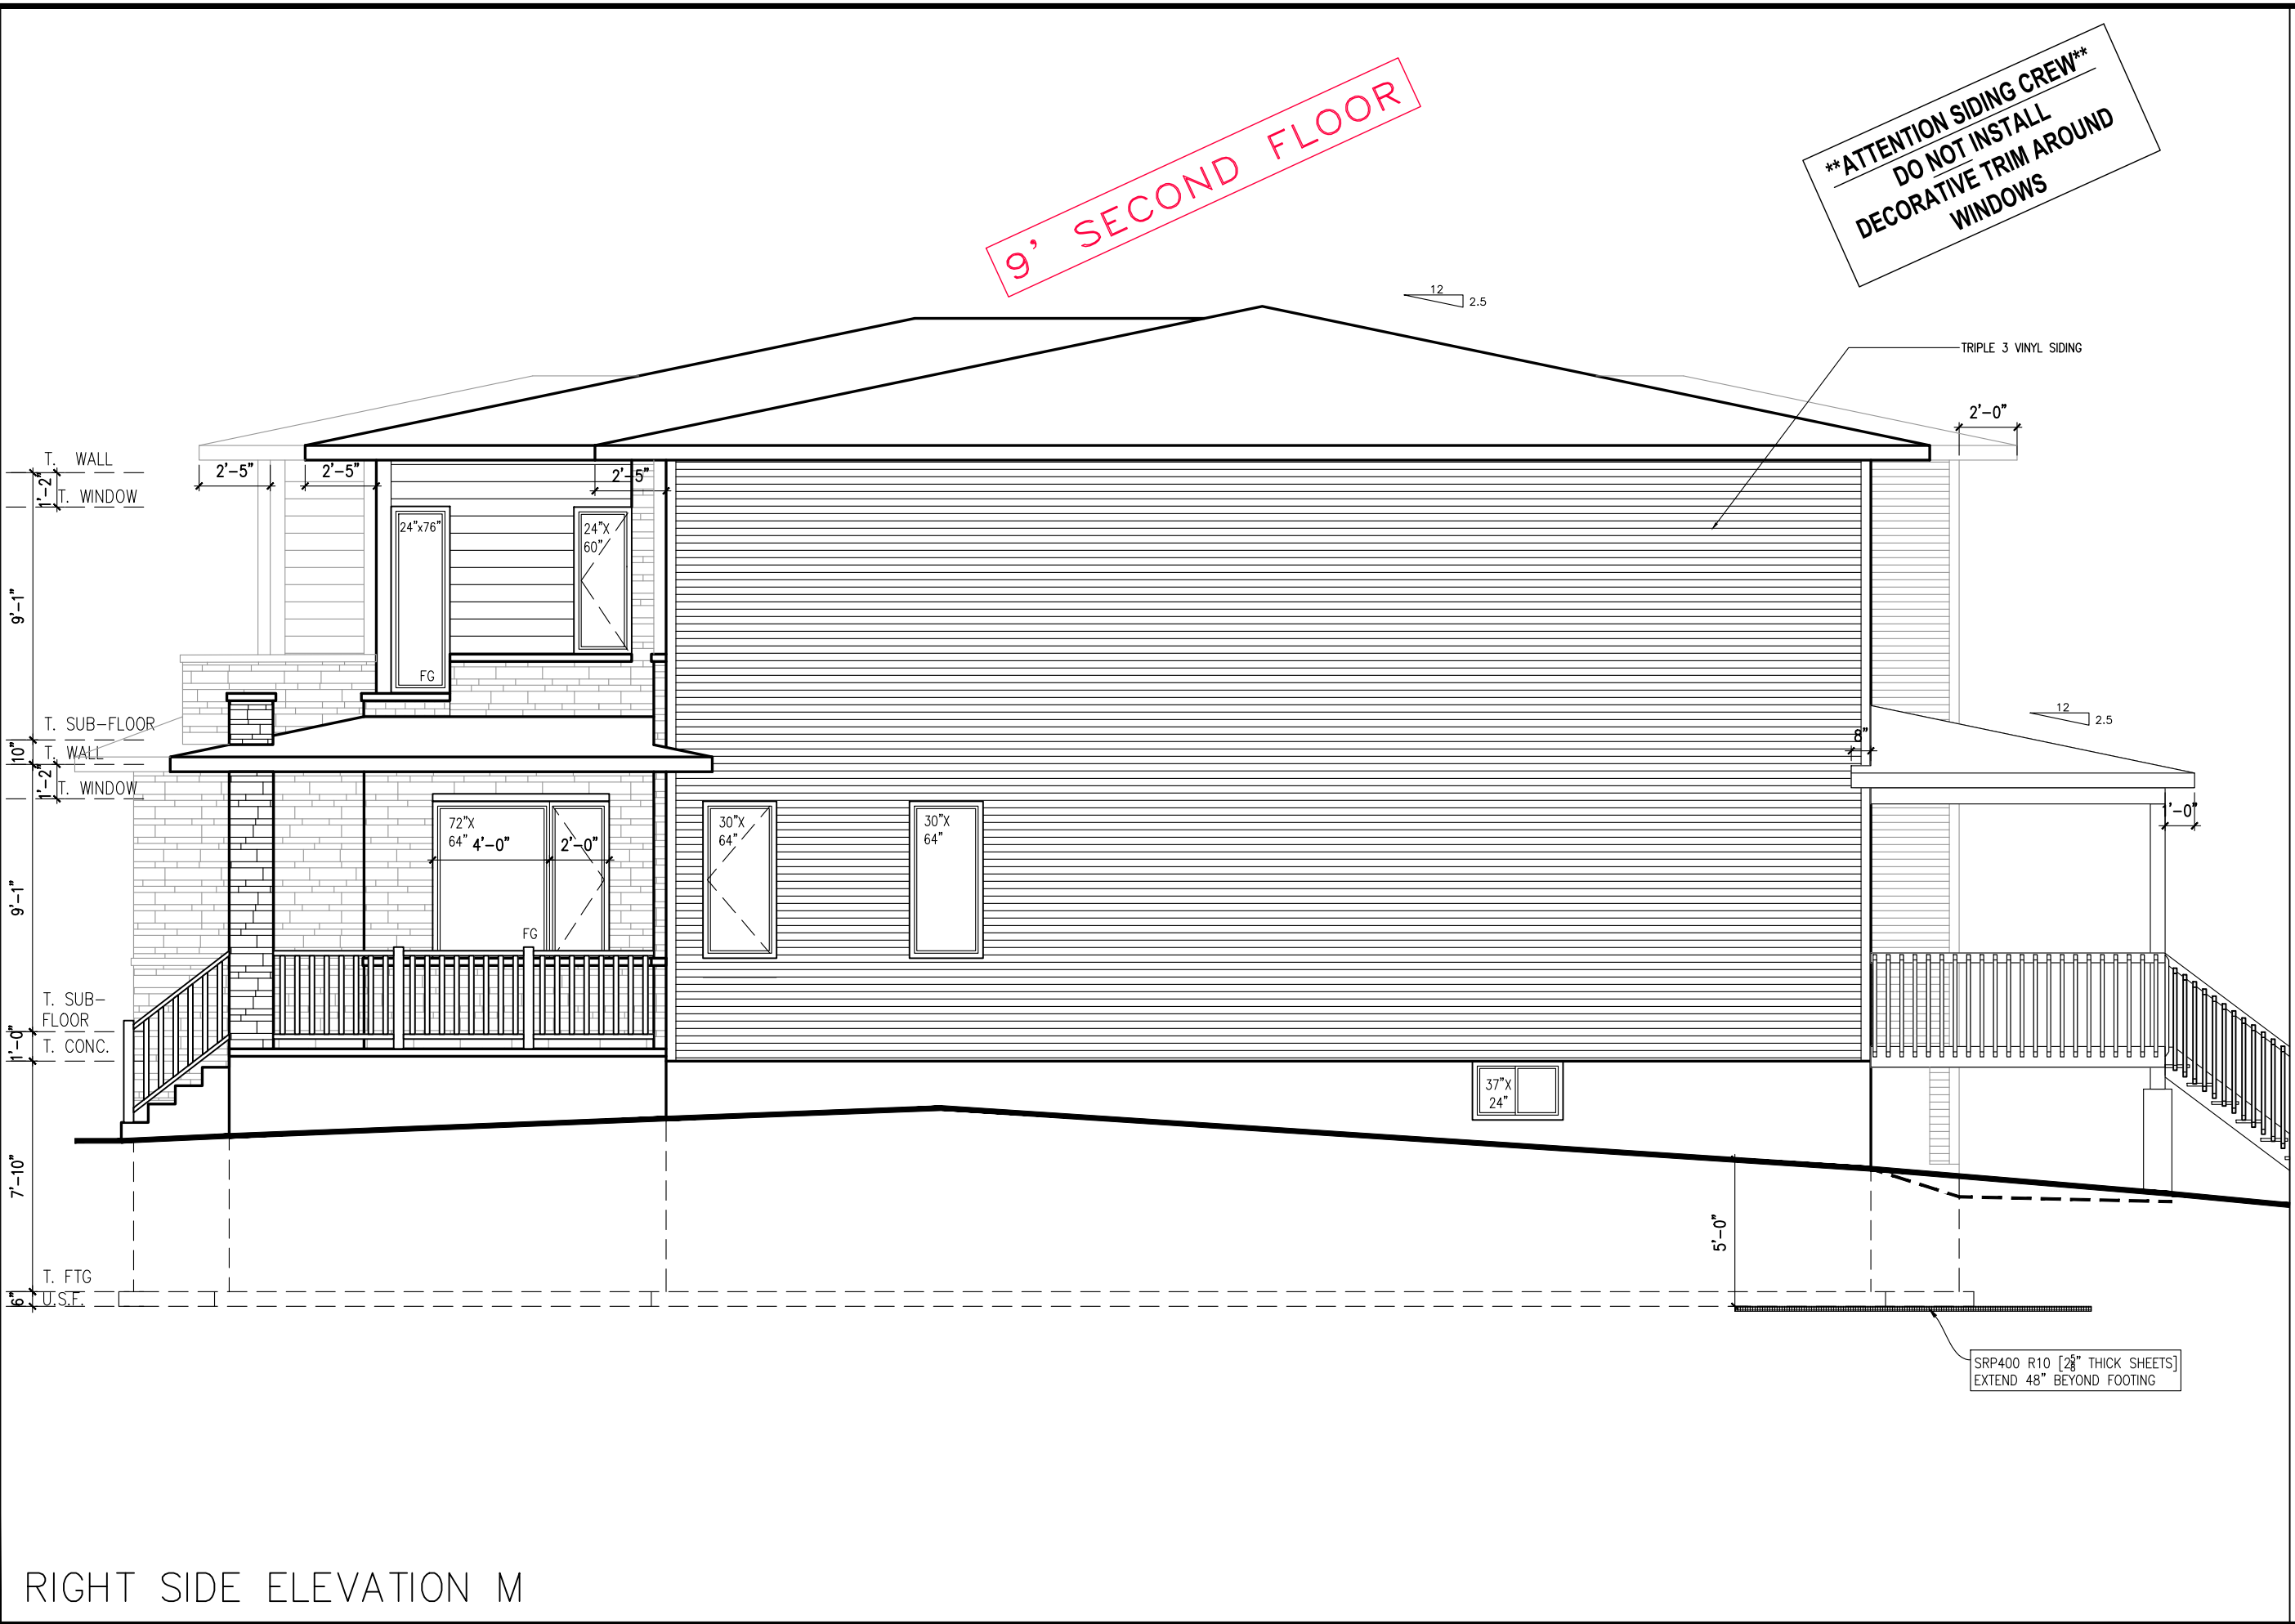

RIGHT SIDE ELEVATION M

****ATTENTION SIDING CREW****
DO NOT INSTALL
DECORATIVE TRIM AROUND
WINDOWS

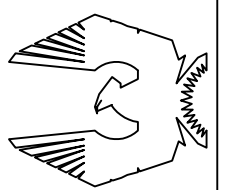

PHOENIX HOMES

NEWINGTON M – 2021

SITE: WHITE TAIL RIDGE

LOT NUMBER: 135

CIVIC ADDRESS: 108 FRANK FISHER CRESCENT

SP	19/08/24	11 FINAL FOR CONSTRUCTION-REVISED
SP	06/08/24	10 FINAL FOR CONSTRUCTION
CB	11/01/24	9 FINAL FOR SITE
CB	16/11/23	8 FINAL BLACKLINES
CB	14/07/23	7 BEP BLACKLINES
CB	01/06/23	6 B1 BLACKLINES
By	ad/mm/yy	No. Description REVISIONS

footprint: 518

drawn by: SP


date: JUN 12/16

scale: 3/16"=1'-0"

D.C.L. – A45

sheet no:

7M of 9

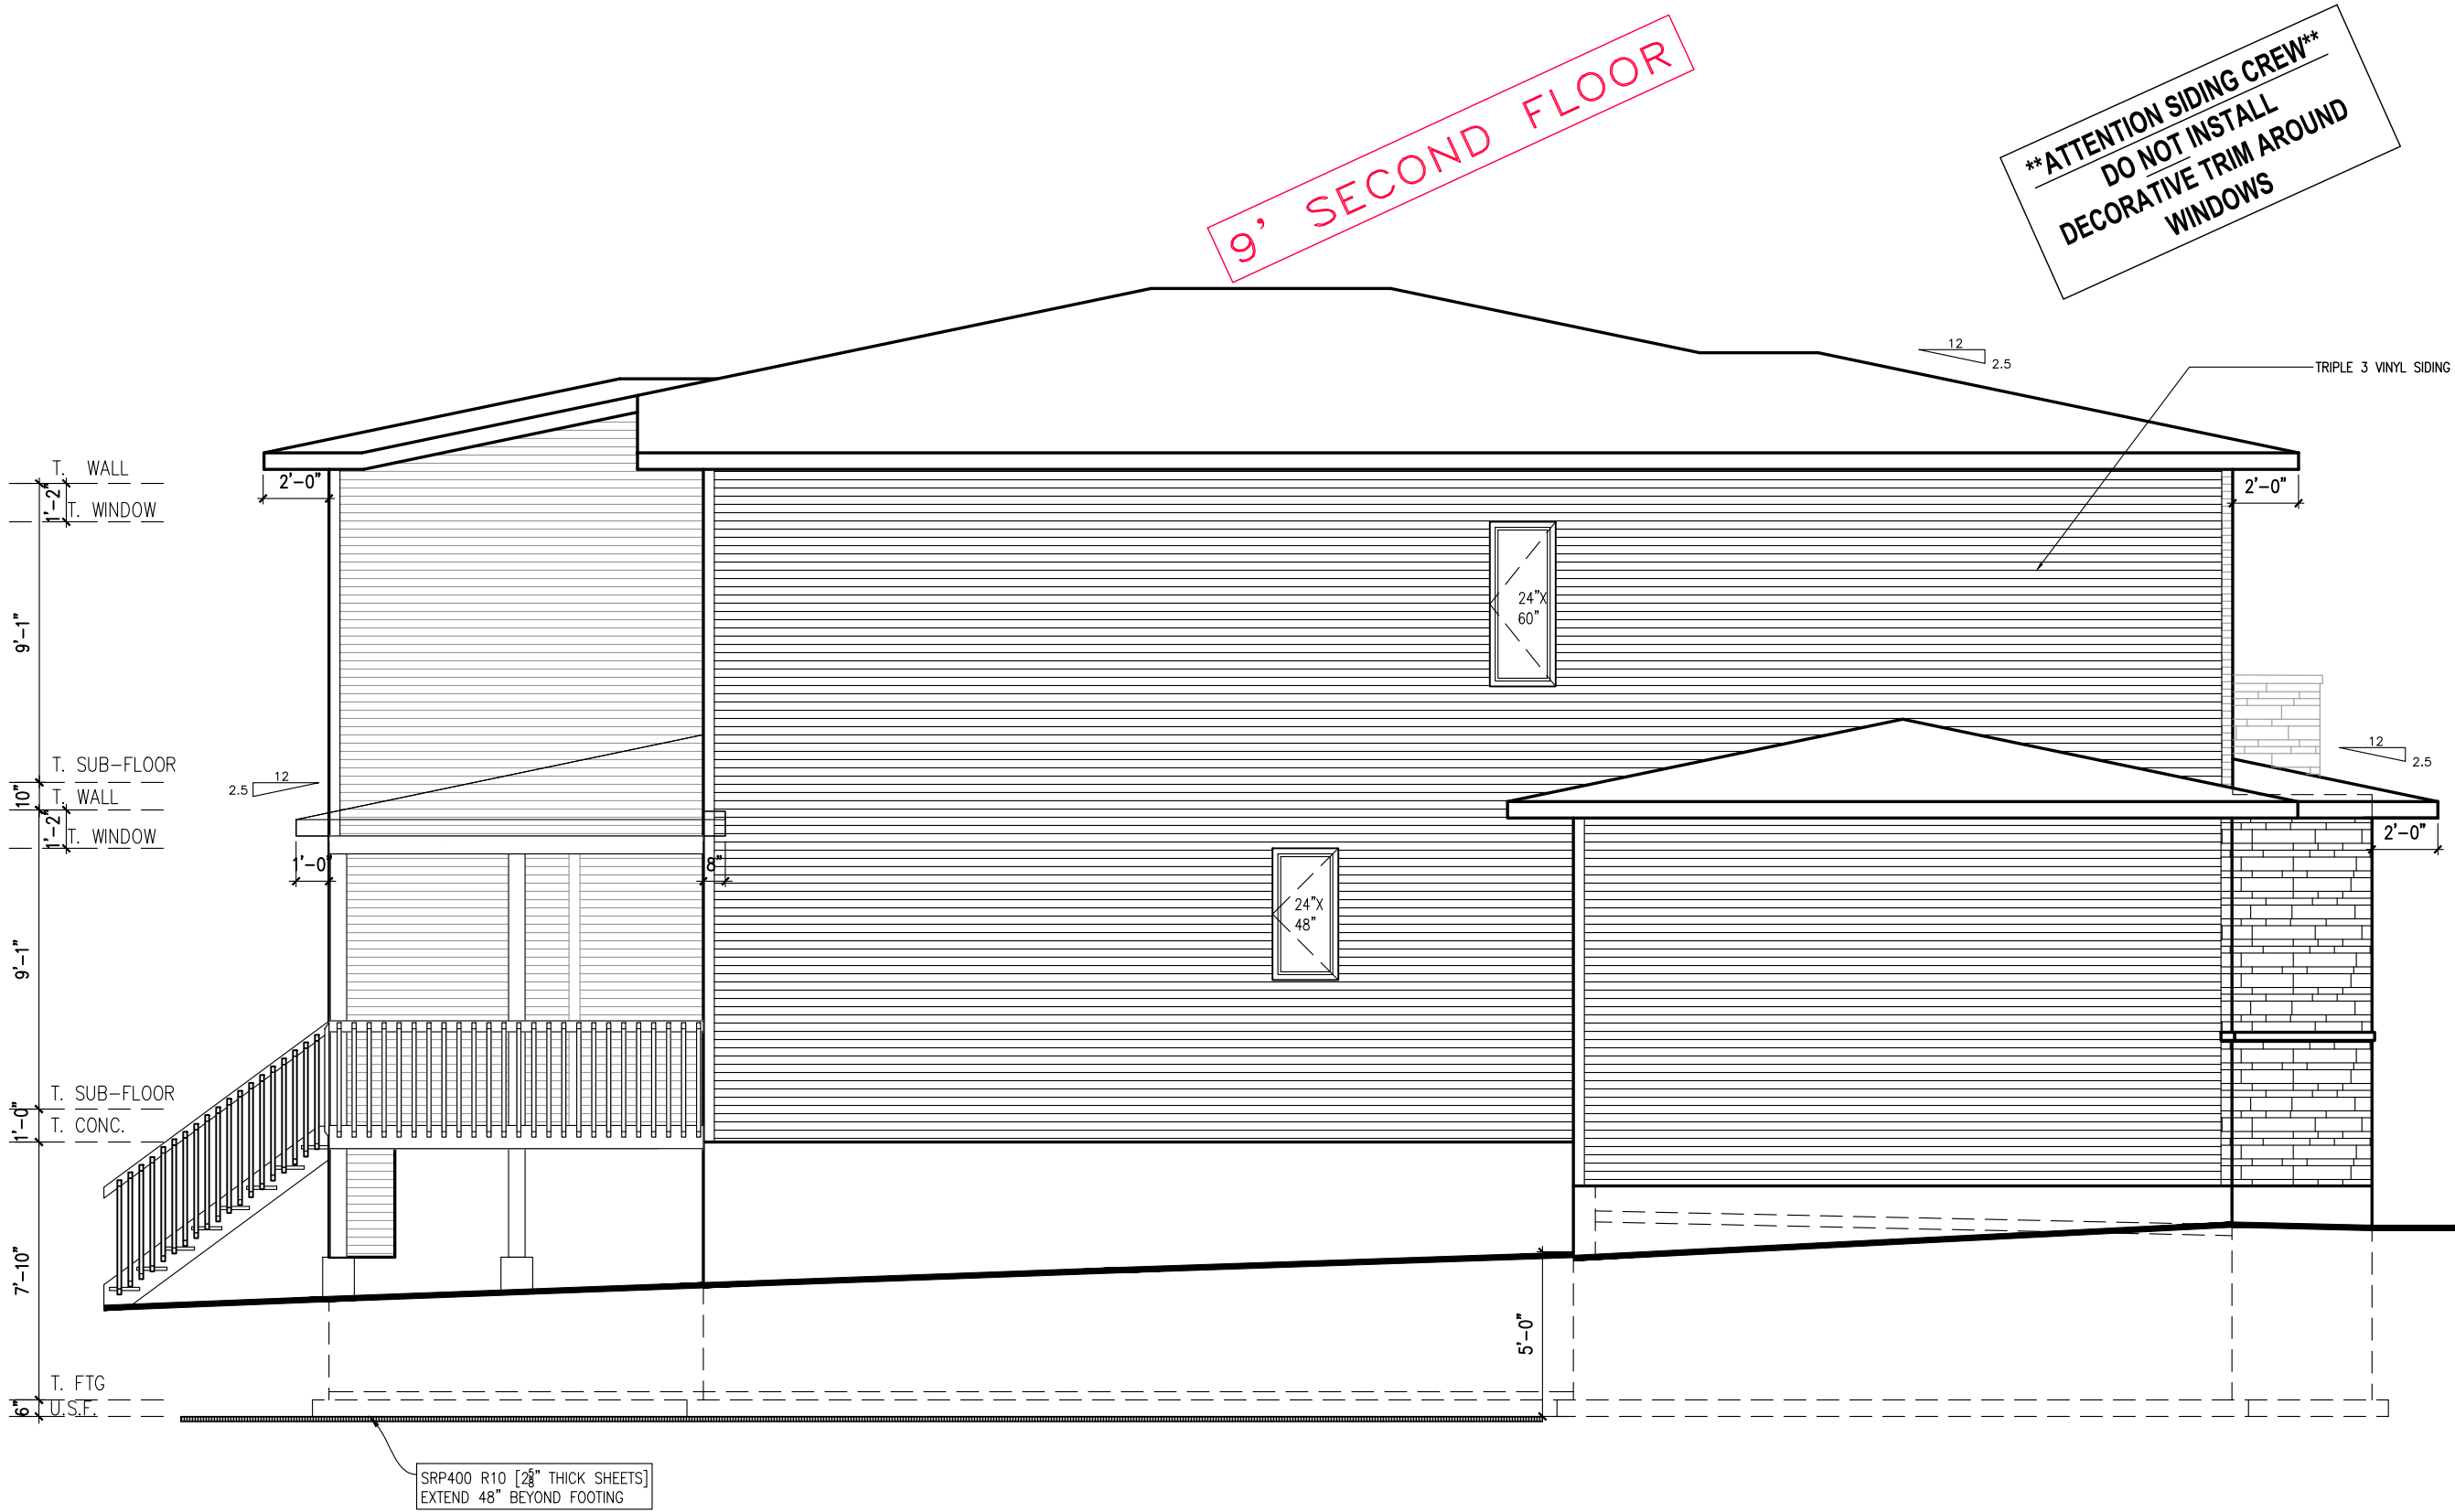

LEFT SIDE ELEVATION M

footprint:	518
drawn by:	SP
date:	JUN 12/16
scale:	3/16"=1'-0"
D.C.L. - A45	8M of 9
sheet no:	


11	FINAL FOR CONSTRUCTION-REVISED	SP	19/08/24
10	FINAL FOR CONSTRUCTION	SP	06/08/24
9	FINAL FOR SITE	CB	11/01/24
8	FINAL BLACKLINES	CB	16/11/23
7	BEP BLACKLINES	CB	14/07/23
6	B1 BLACKLINES	CB	01/06/23
No.	Description	dd/mm/yy	By
REVISIONS			

NEWINGTON M - 2021


SITE: WHITE TAIL RIDGE

LOT NUMBER: 135


CIVIC ADDRESS: 108 FRANK FISHER CRESCENT

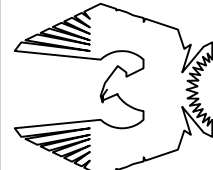


PHOENIX HOMES

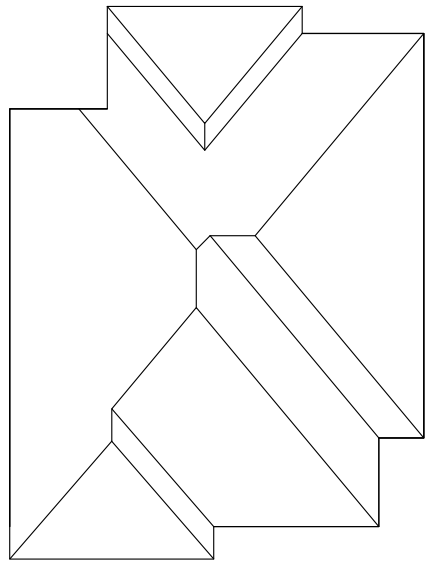

ROOF PLAN

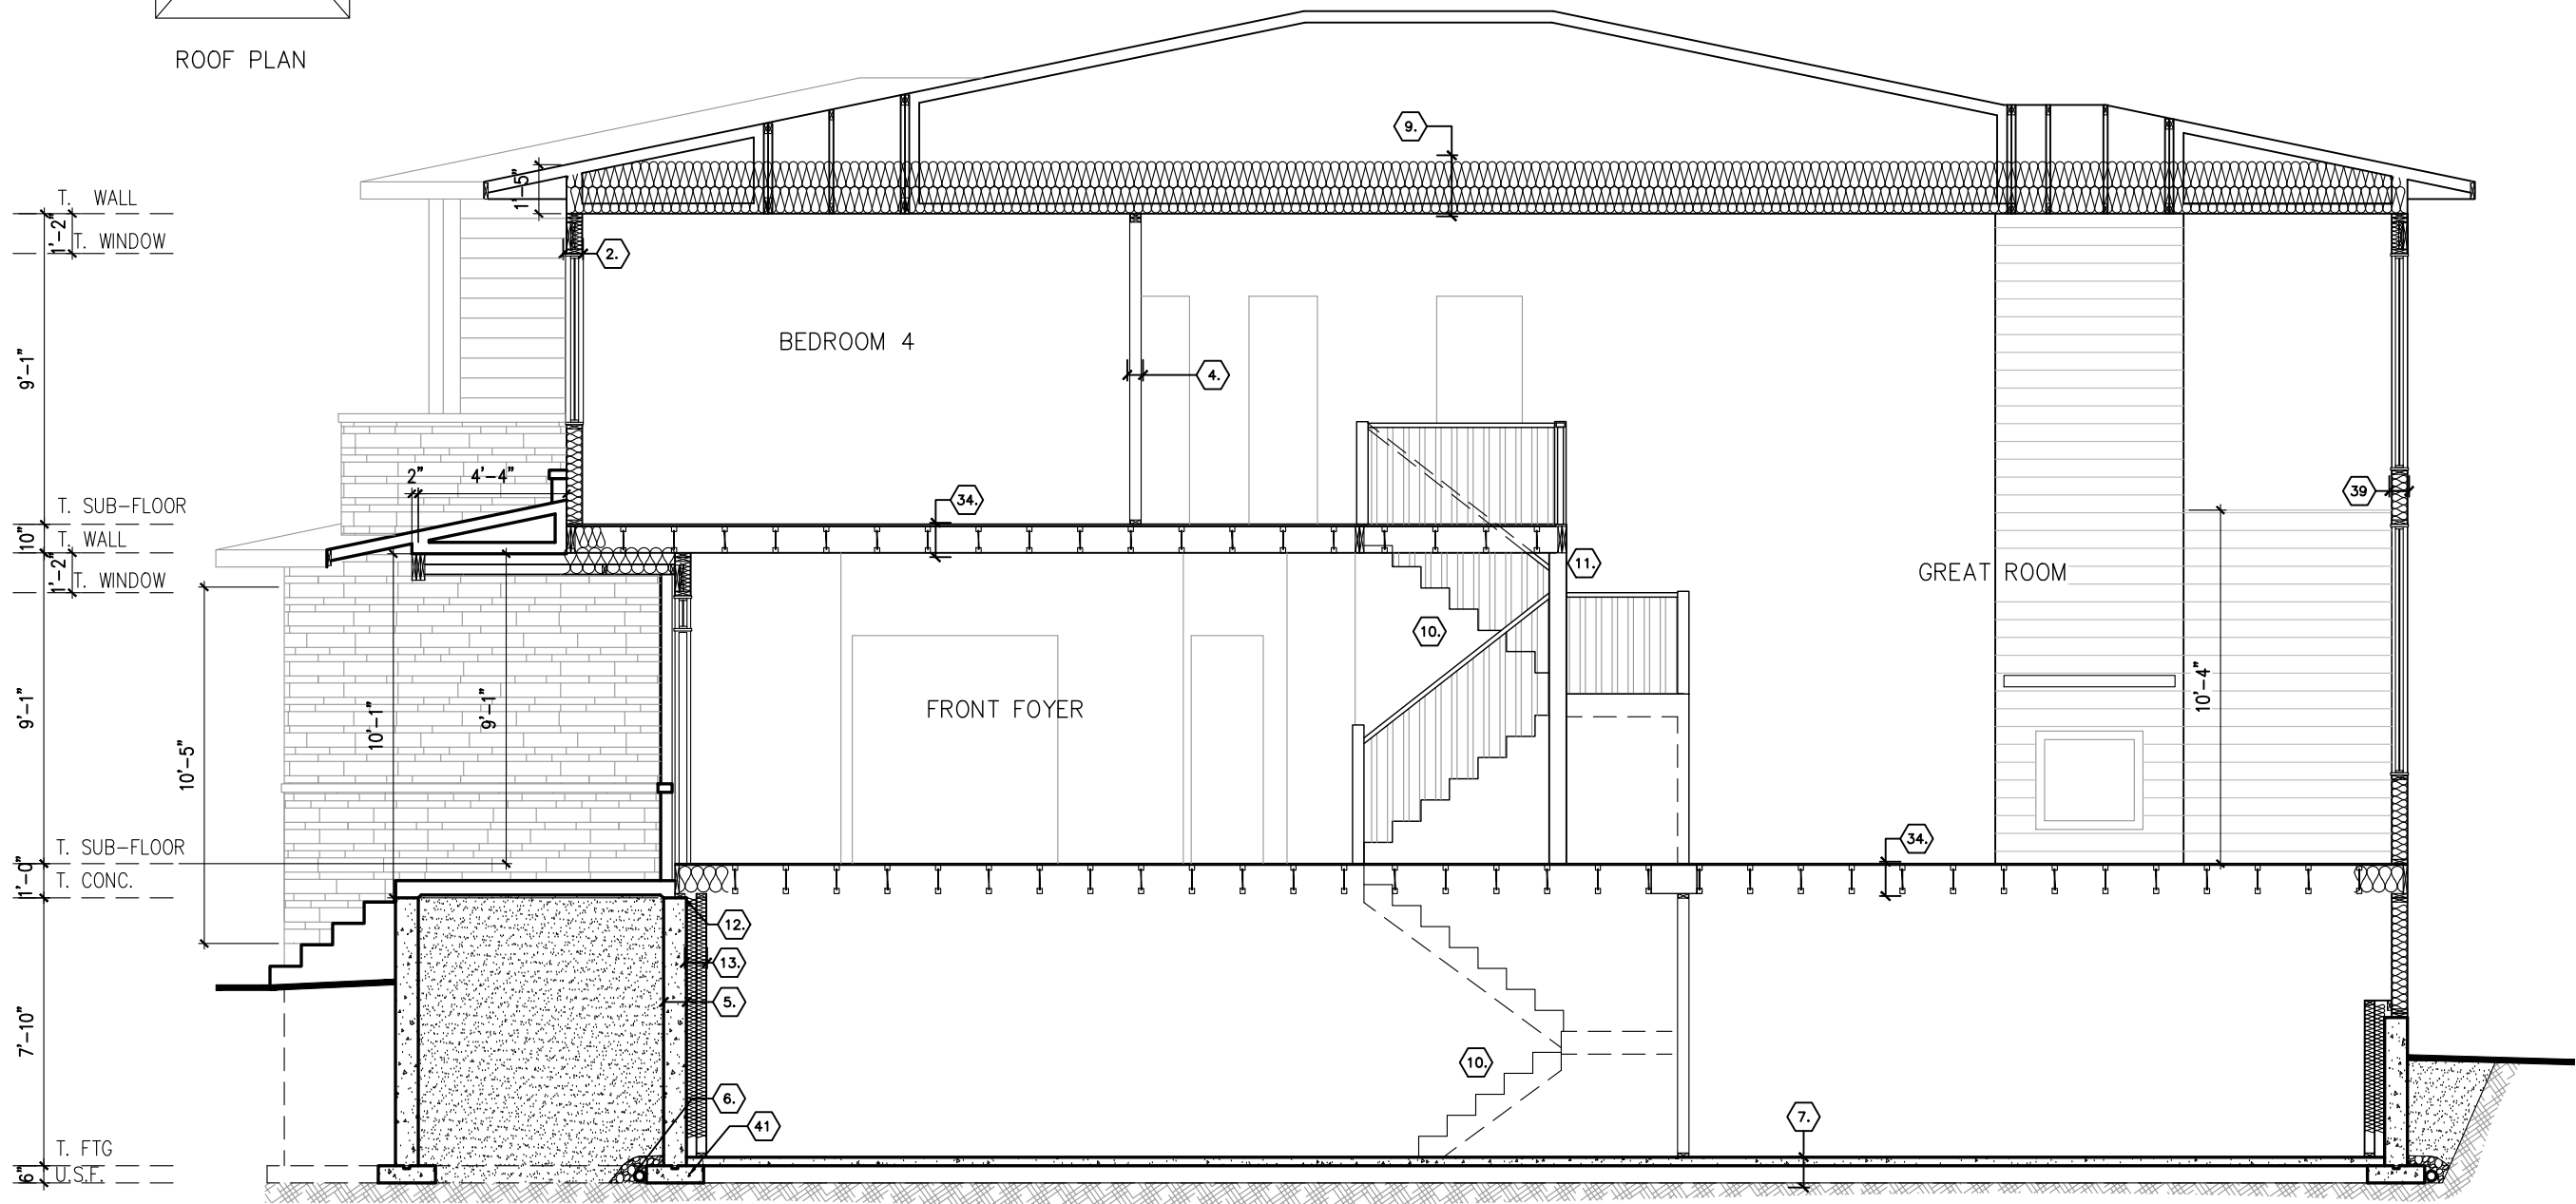

SECTION A-A

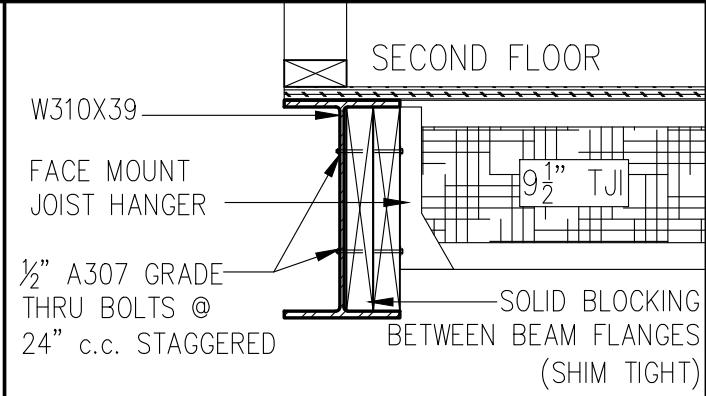

SECTION B-B
STEEL BEAM SECTION DETAIL

footprint:	518
drawn by:	SP
date:	JUN 12/16
scale:	3/16" = 1'-0"
D.C.L. - A45	sheet no:
9M of 9	

11	FINAL FOR CONSTRUCTION-REVISED	19/08/24	SP
10	FINAL FOR CONSTRUCTION	06/08/24	SP
9	FINAL FOR SITE	11/01/24	CB
8	FINAL BLACKLINES	16/11/23	CB
7	BEP BLACKLINES	14/07/23	CB
6	B1 BLACKLINES	01/06/23	CB
No.	Description	dd/mm/yy	By
REVISIONS			

NEWINGTON M - 2021
SITE: WHITE TAIL RIDGE
LOT NUMBER: 135
CIVIC ADDRESS: 108 FRANK FISHER CRESCENT

PHOENIX HOMES