


REVISED
26AUG2024

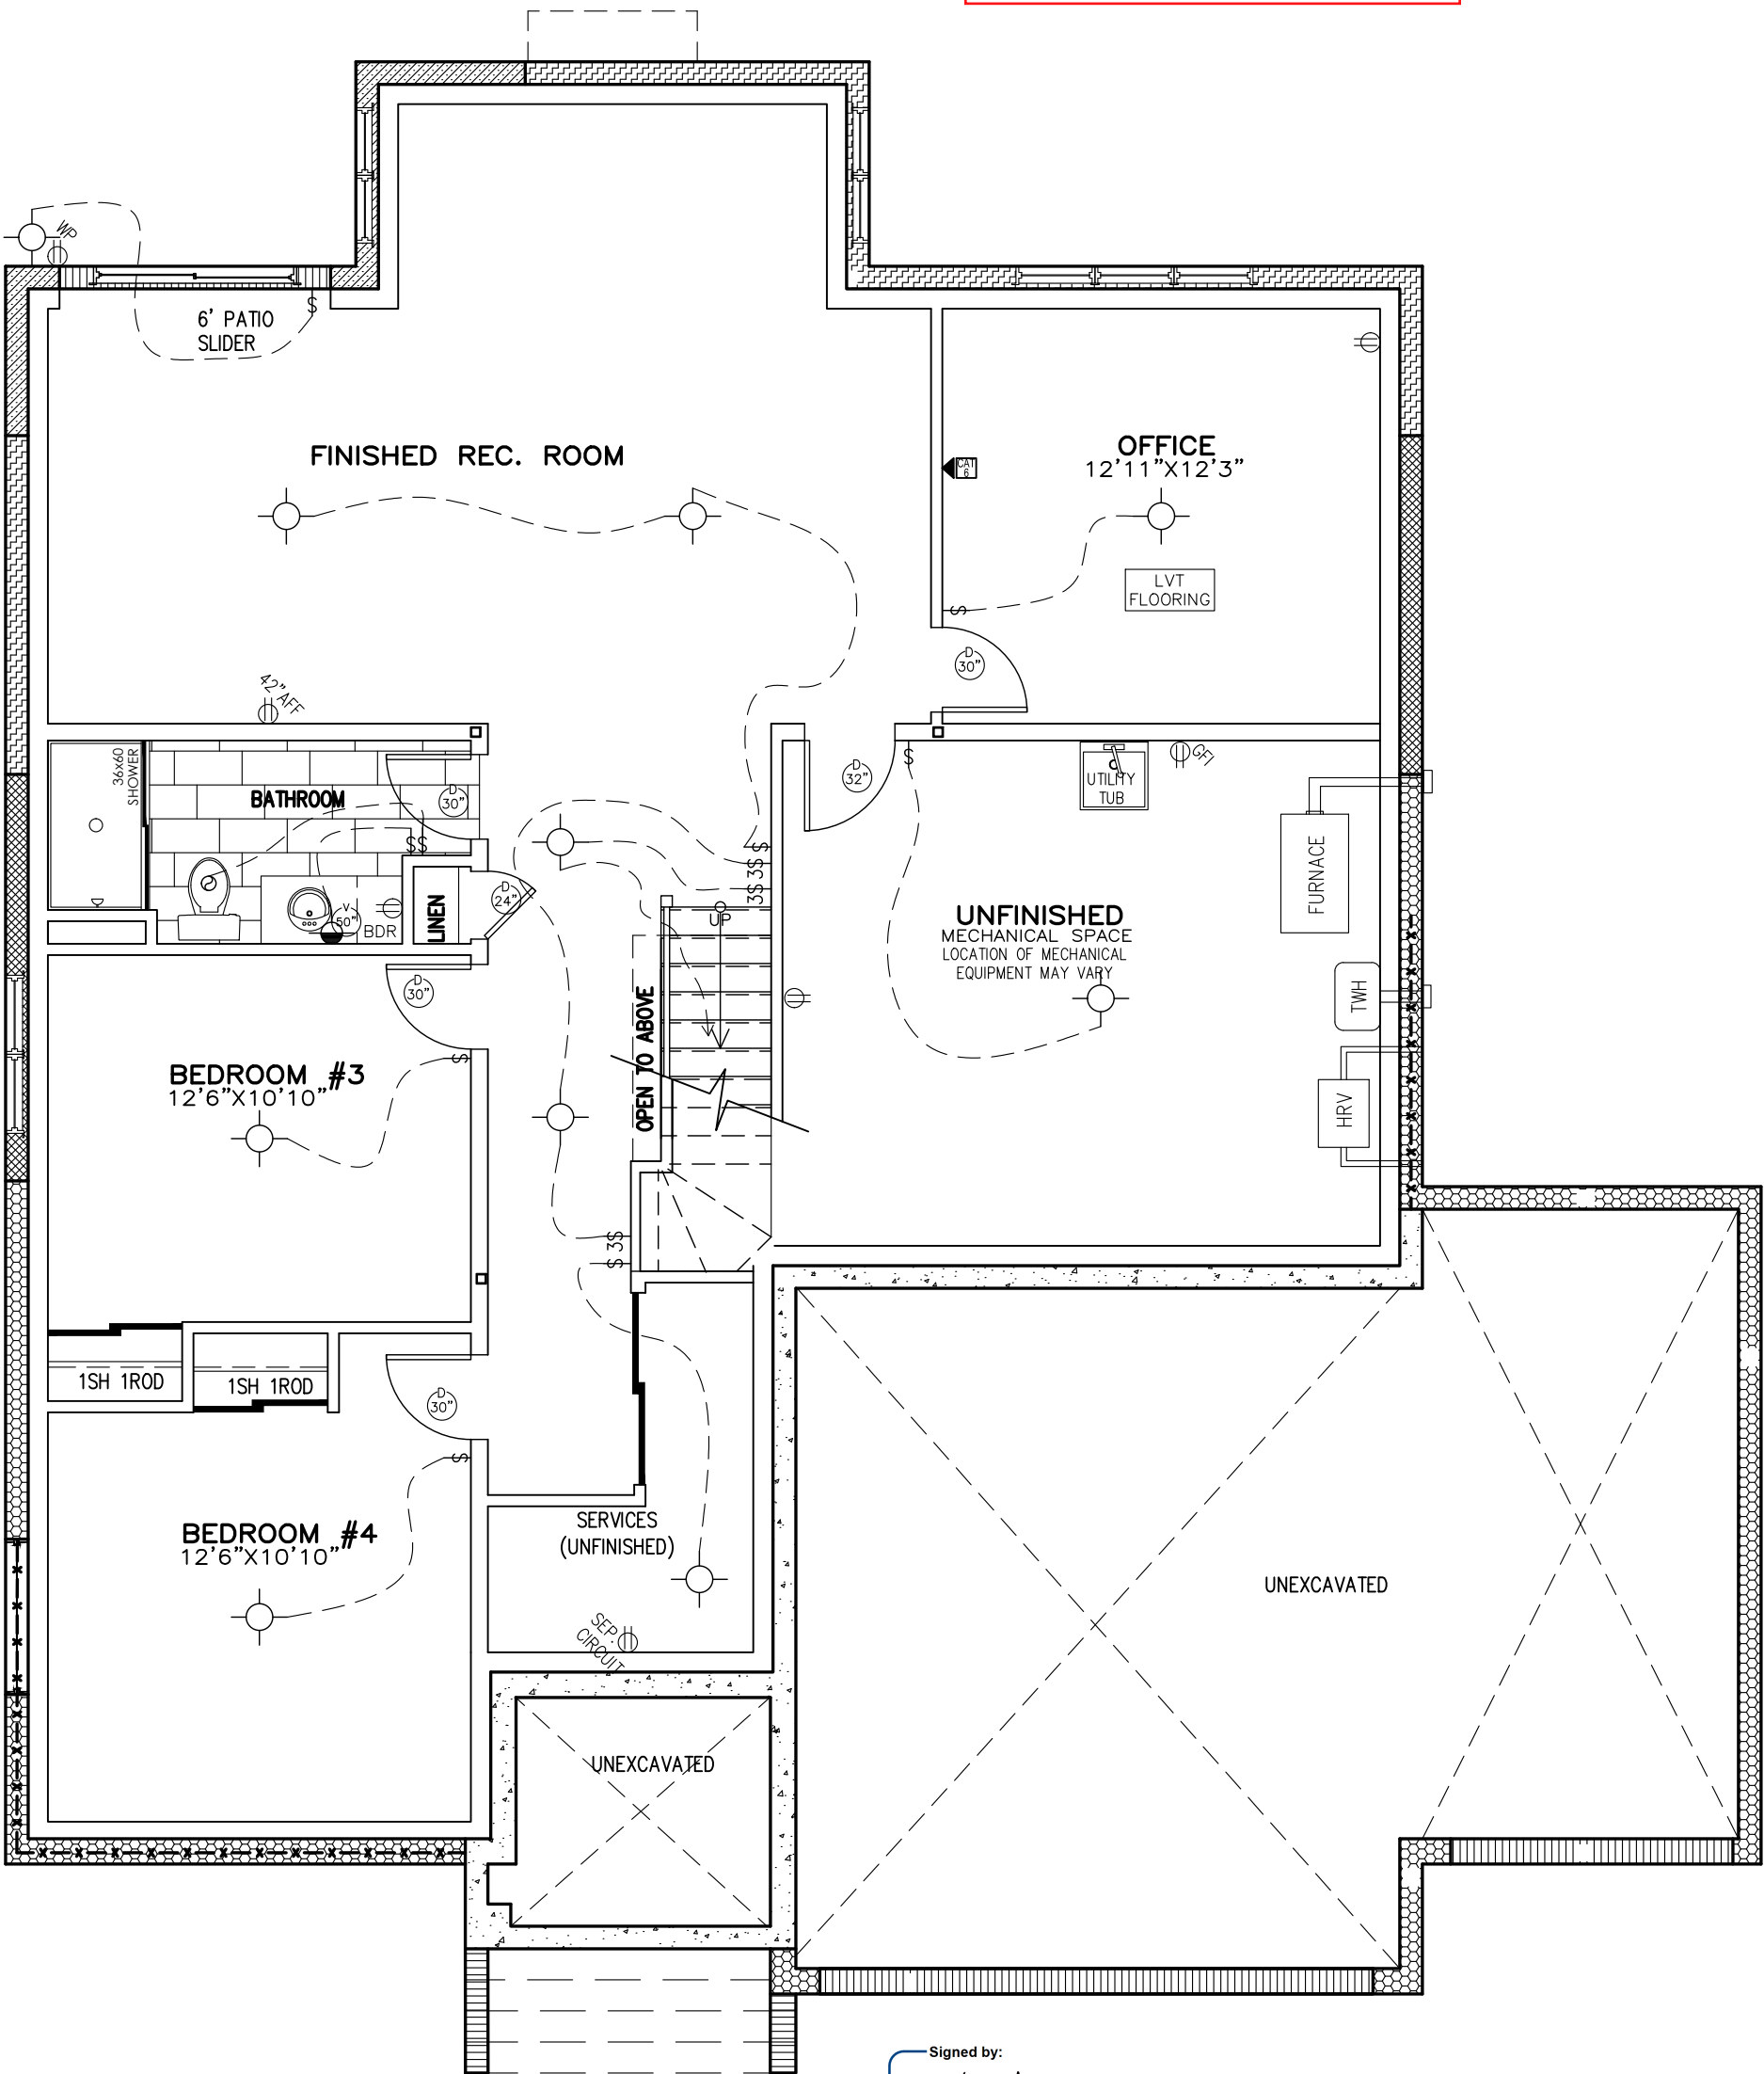

Signed by:
Gerhard Sauer
850B9CFD36444FB...


8/29/2024 | 9:01 AM EDT

Signed by:
Sylvie Sauer
888CF0226B4242A...

8/29/2024 | 9:04 AM EDT

FOUNDATION PLAN
ELEVATION C

OAKSIDE C – 2022

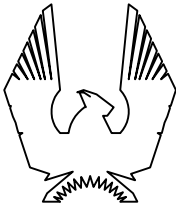


PHOENIX HOMES

11	FINAL FOR SITE	21/05/24	CB
10	ADD 3-WAY SWITCH FOR GARAGE LIGHT	15/03/24	SP
9	BASEMENT SEPARATE CIRCUIT RELOCATED	10/01/24	SP
8	FINAL BLACKLINES	20/11/23	CB
7	ISSUED FOR ENGINEERING REVIEW	12/09/23	CB
6	BEP BLACKLINES	31/08/23	CB
No.	Description	dd/mm/yy	By
REVISIONS			


footprint:	B-20
drawn by:	SP
date:	JAN 13/16
scale:	3/16"=1'-0"
sheet no:	D.C.L.-A-10

REVISED
26AUG2024

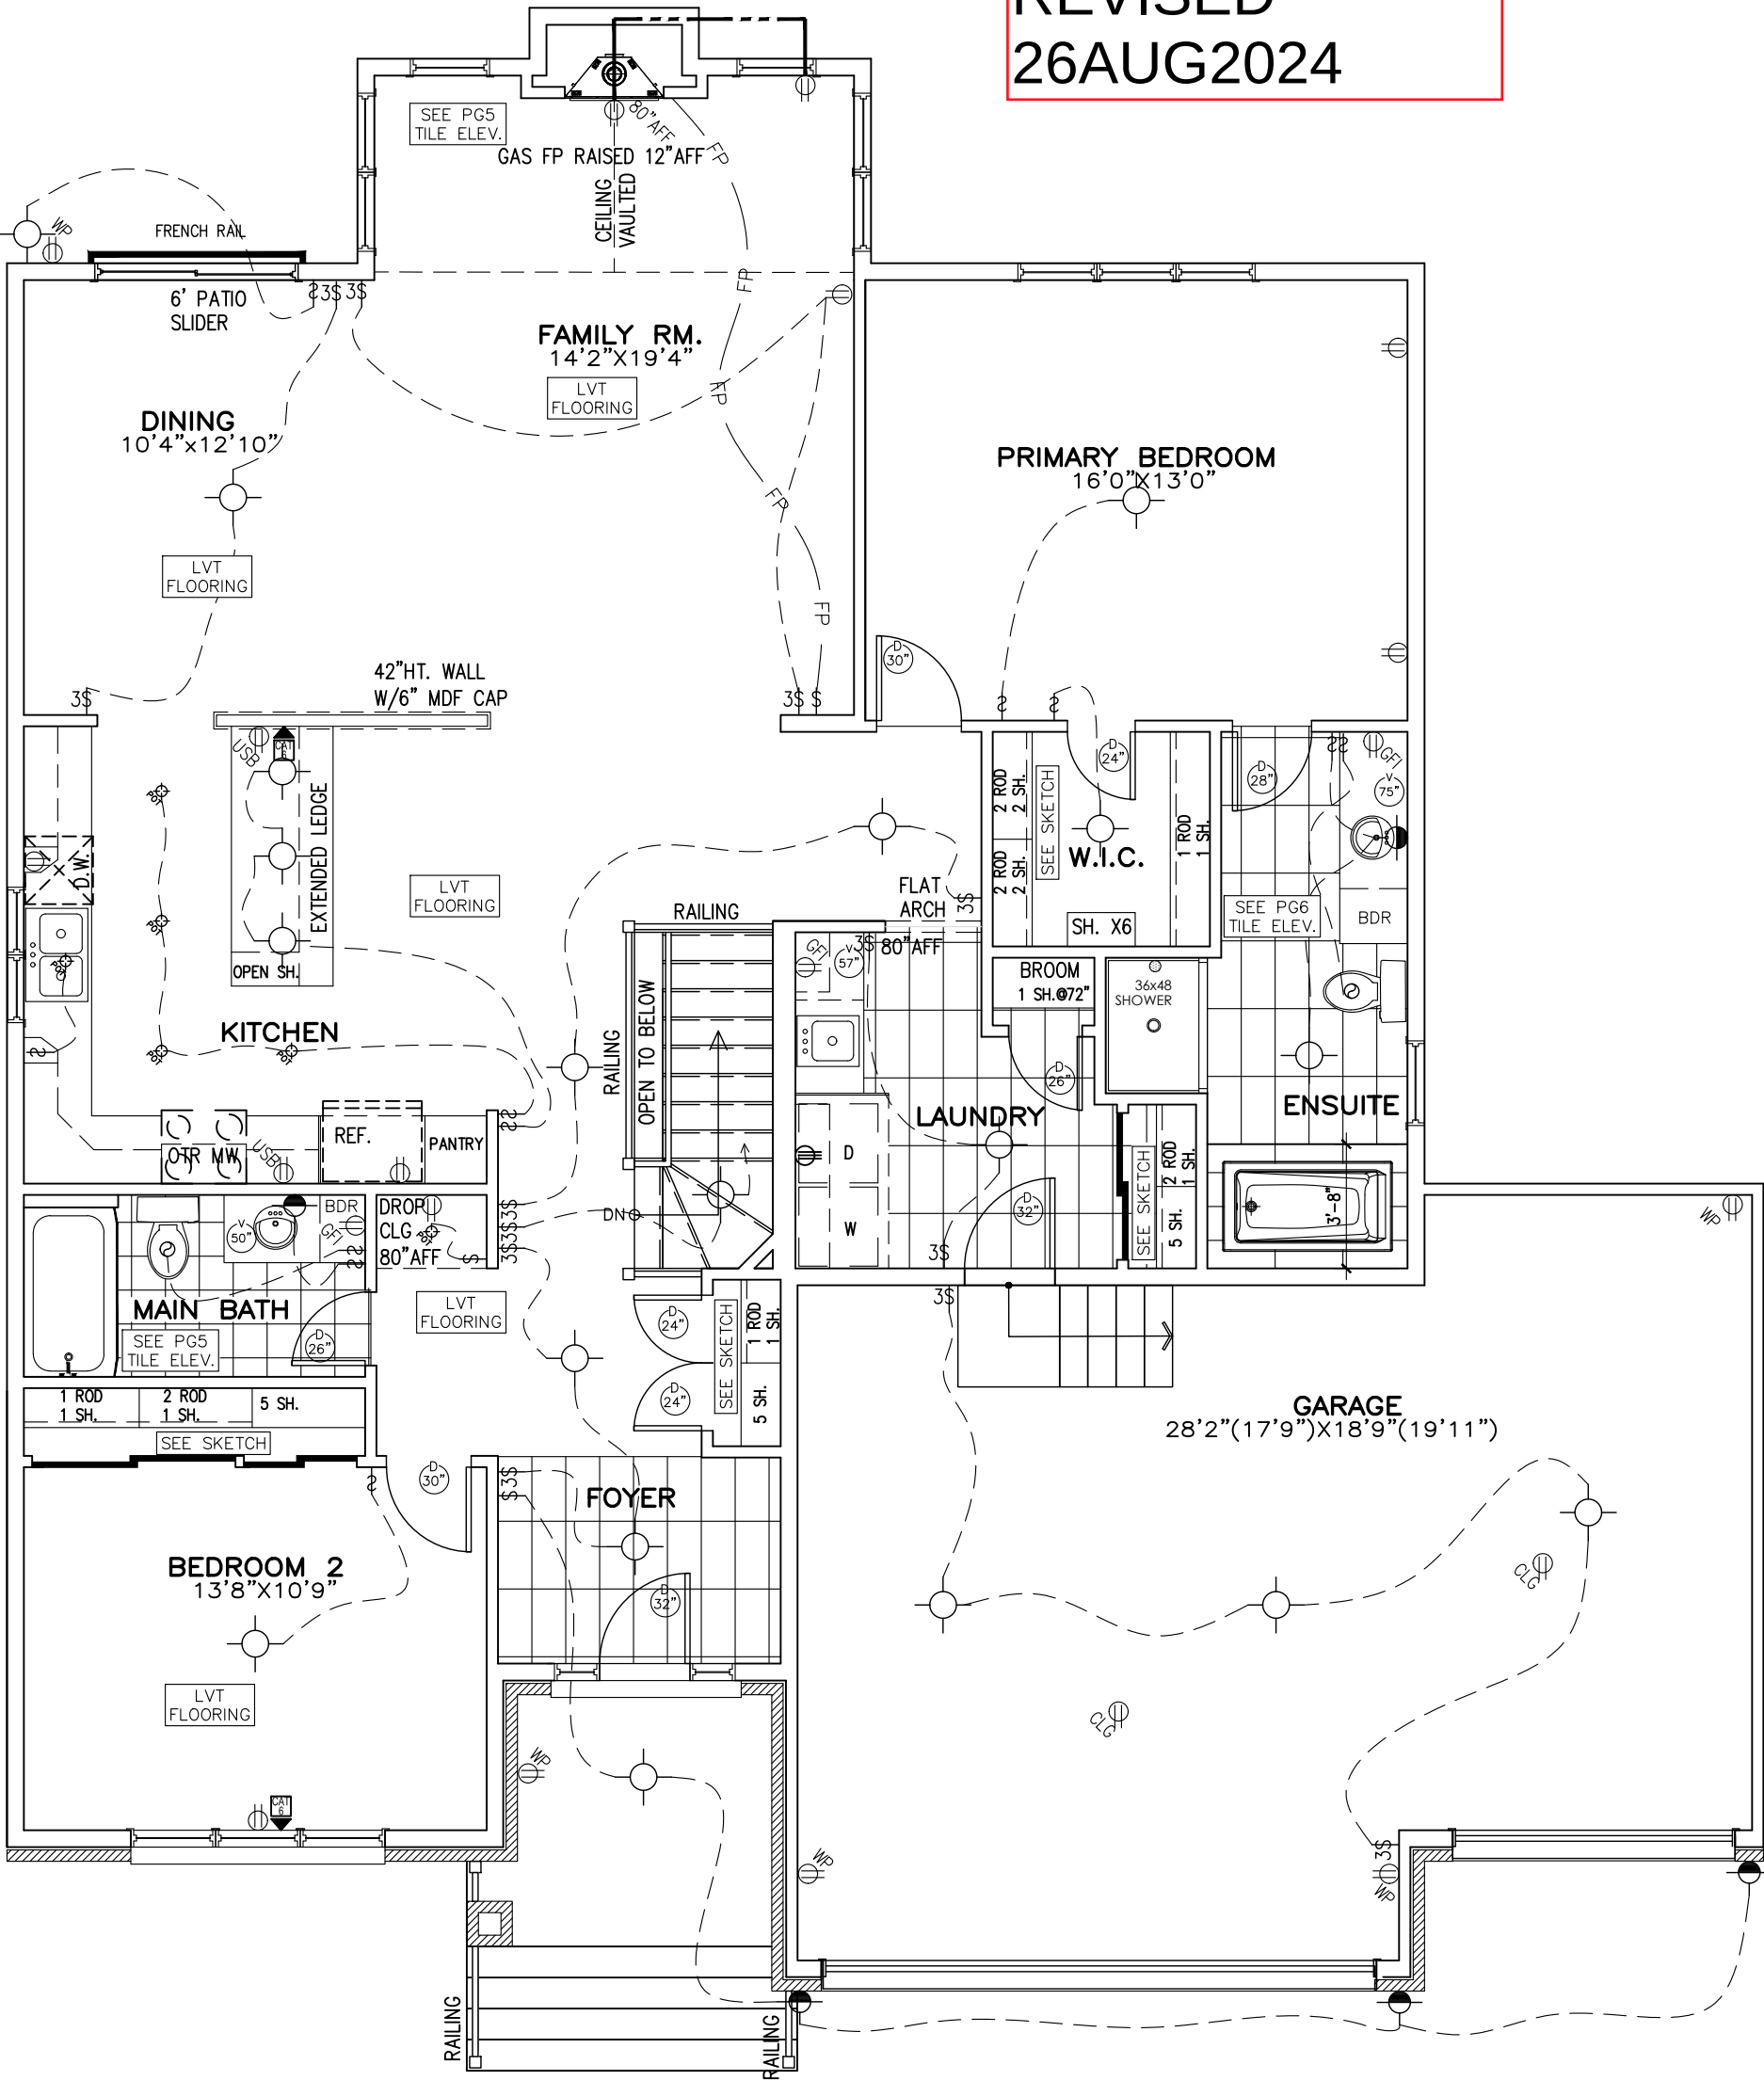

GROUND FLOOR
ELEVATION C

OAKSIDE C – 2022

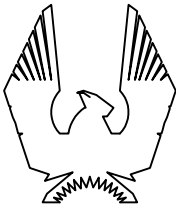

PHOENIX HOMES

Signed by:

Gerhard Sauer

850B9CFD36444FB...

8/29/2024 | 9:01 AM EDT

Signed by:

Sylvie Sauer

888CF0226B4242A...

8/29/2024 | 9:04 AM EDT

11	FINAL FOR SITE	21/05/24	CB
10	ADD 3-WAY SWITCH FOR GARAGE LIGHT	15/03/24	SP
9	BASEMENT SEPARATE CIRCUIT RELOCATED	10/01/24	SP
8	FINAL BLACKLINES	20/11/23	CB
7	ISSUED FOR ENGINEERING REVIEW	12/09/23	CB
6	BEP BLACKLINES	31/08/23	CB
No.	Description	dd/mm/yy	By
REVISIONS			

footprint:	B-20
drawn by:	SP
date:	JAN 13/16
scale:	3/16"=1'-0"
sheet no:	3 of 9
D.C.L.-A-10	