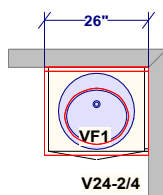
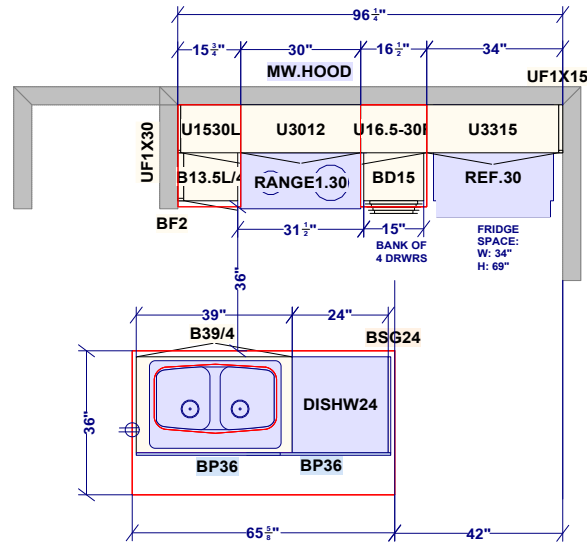


## PATHWAYS


## NUVO - TERRACE HOMES

## BLDG 6 - LOWER UNIT #132


## 33M SALAMANDER WAY

JULY 29 2024  
AS PER SITE MEASURE

POWDER ROOM

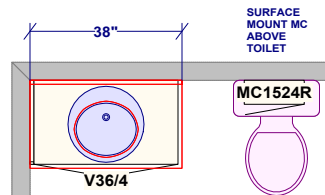

MAIN BATH

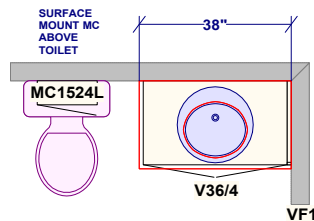

ENSUITE

All dimensions .size designations given are subject to verification on job site and adjustment to fit job conditions.



This is an original design and must not be released or copied unless applicable fee has been paid or job order placed.

Designed: 5/23/2024  
Printed: 7/29/2024