

REVISED
11 SEPT 2024
LAUNDRY ROOM

CLIENT APPROVED VIA EMAIL

DCR PHOENIX HOMES

DIAMONDVIEW PHASE 3
LOT# 3-94

MODEL - KINGSWOOD
(GARAGE LEFT)

KITCHEN


MOUNTING HEIGHT - 99


MAY 8/24

42"H UPPERS

RECESSED LIGHT VALANCE

FURRING PANEL TO CEILING

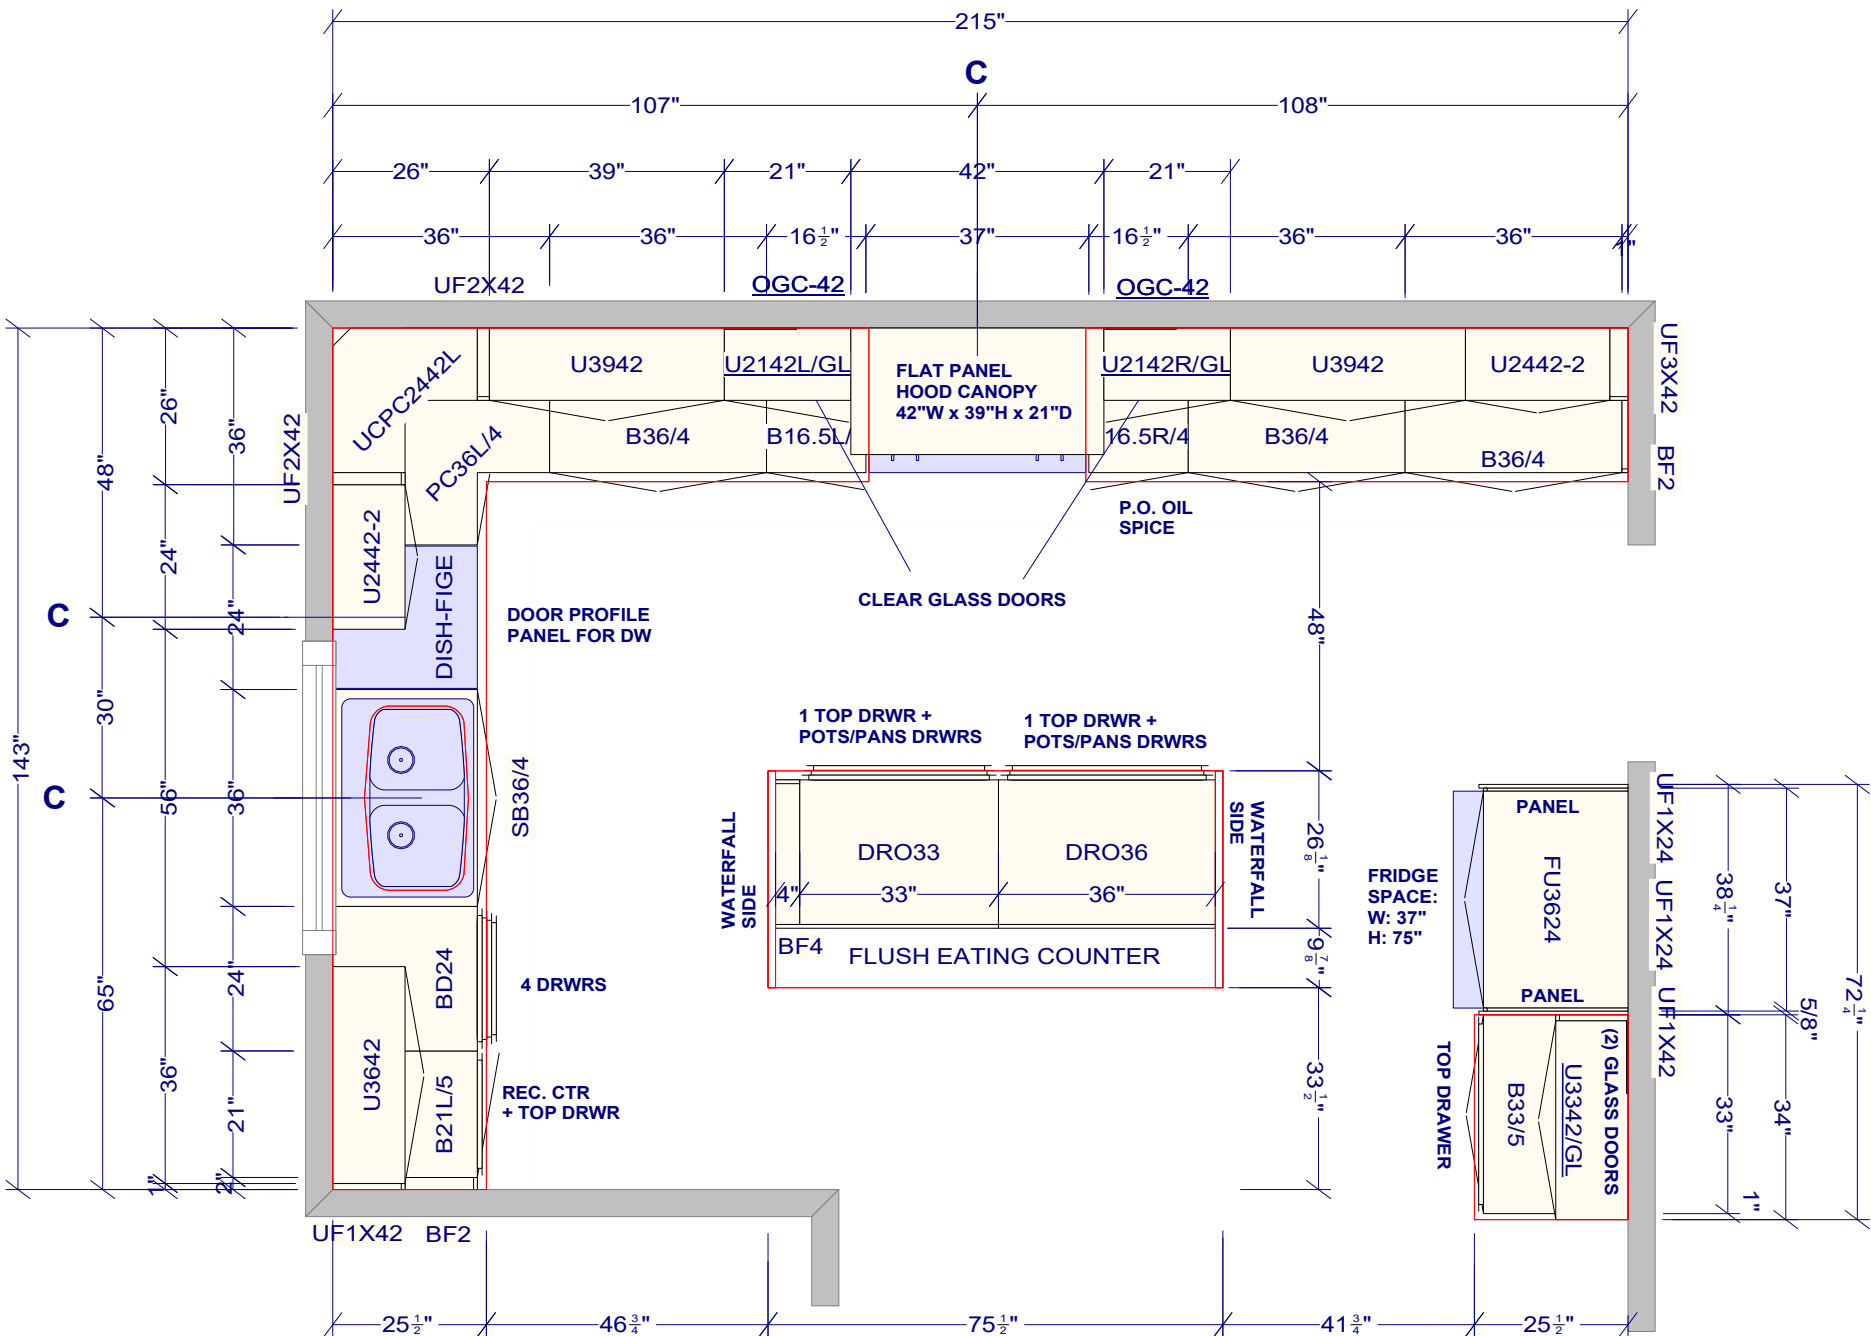

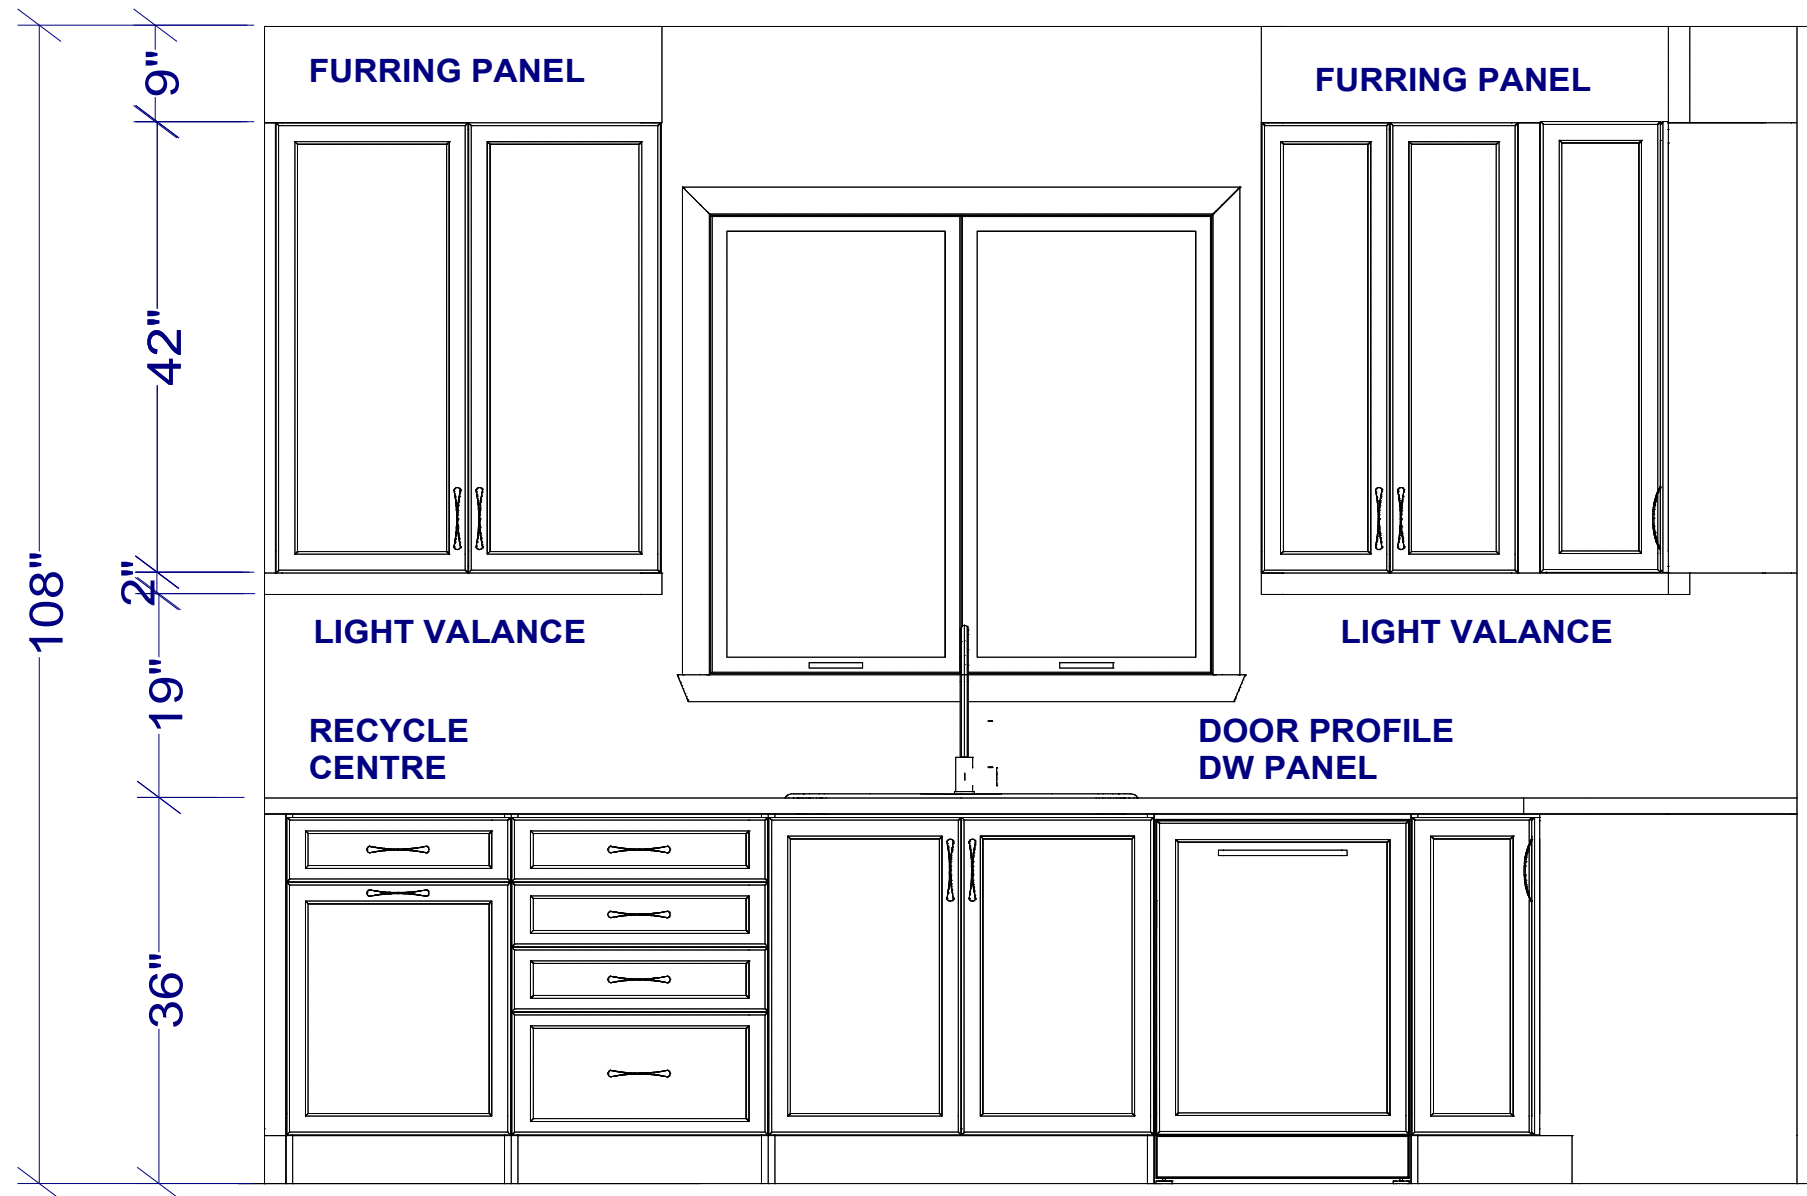


ELEVATION - SINK WALL

All dimensions _size designations given are subject to verification on job site and adjustment to fit job conditions.



This is an original design and must not be released or copied unless applicable fee has been paid or job order placed.

Designed: 3/12/2024
Printed: 3/12/2024

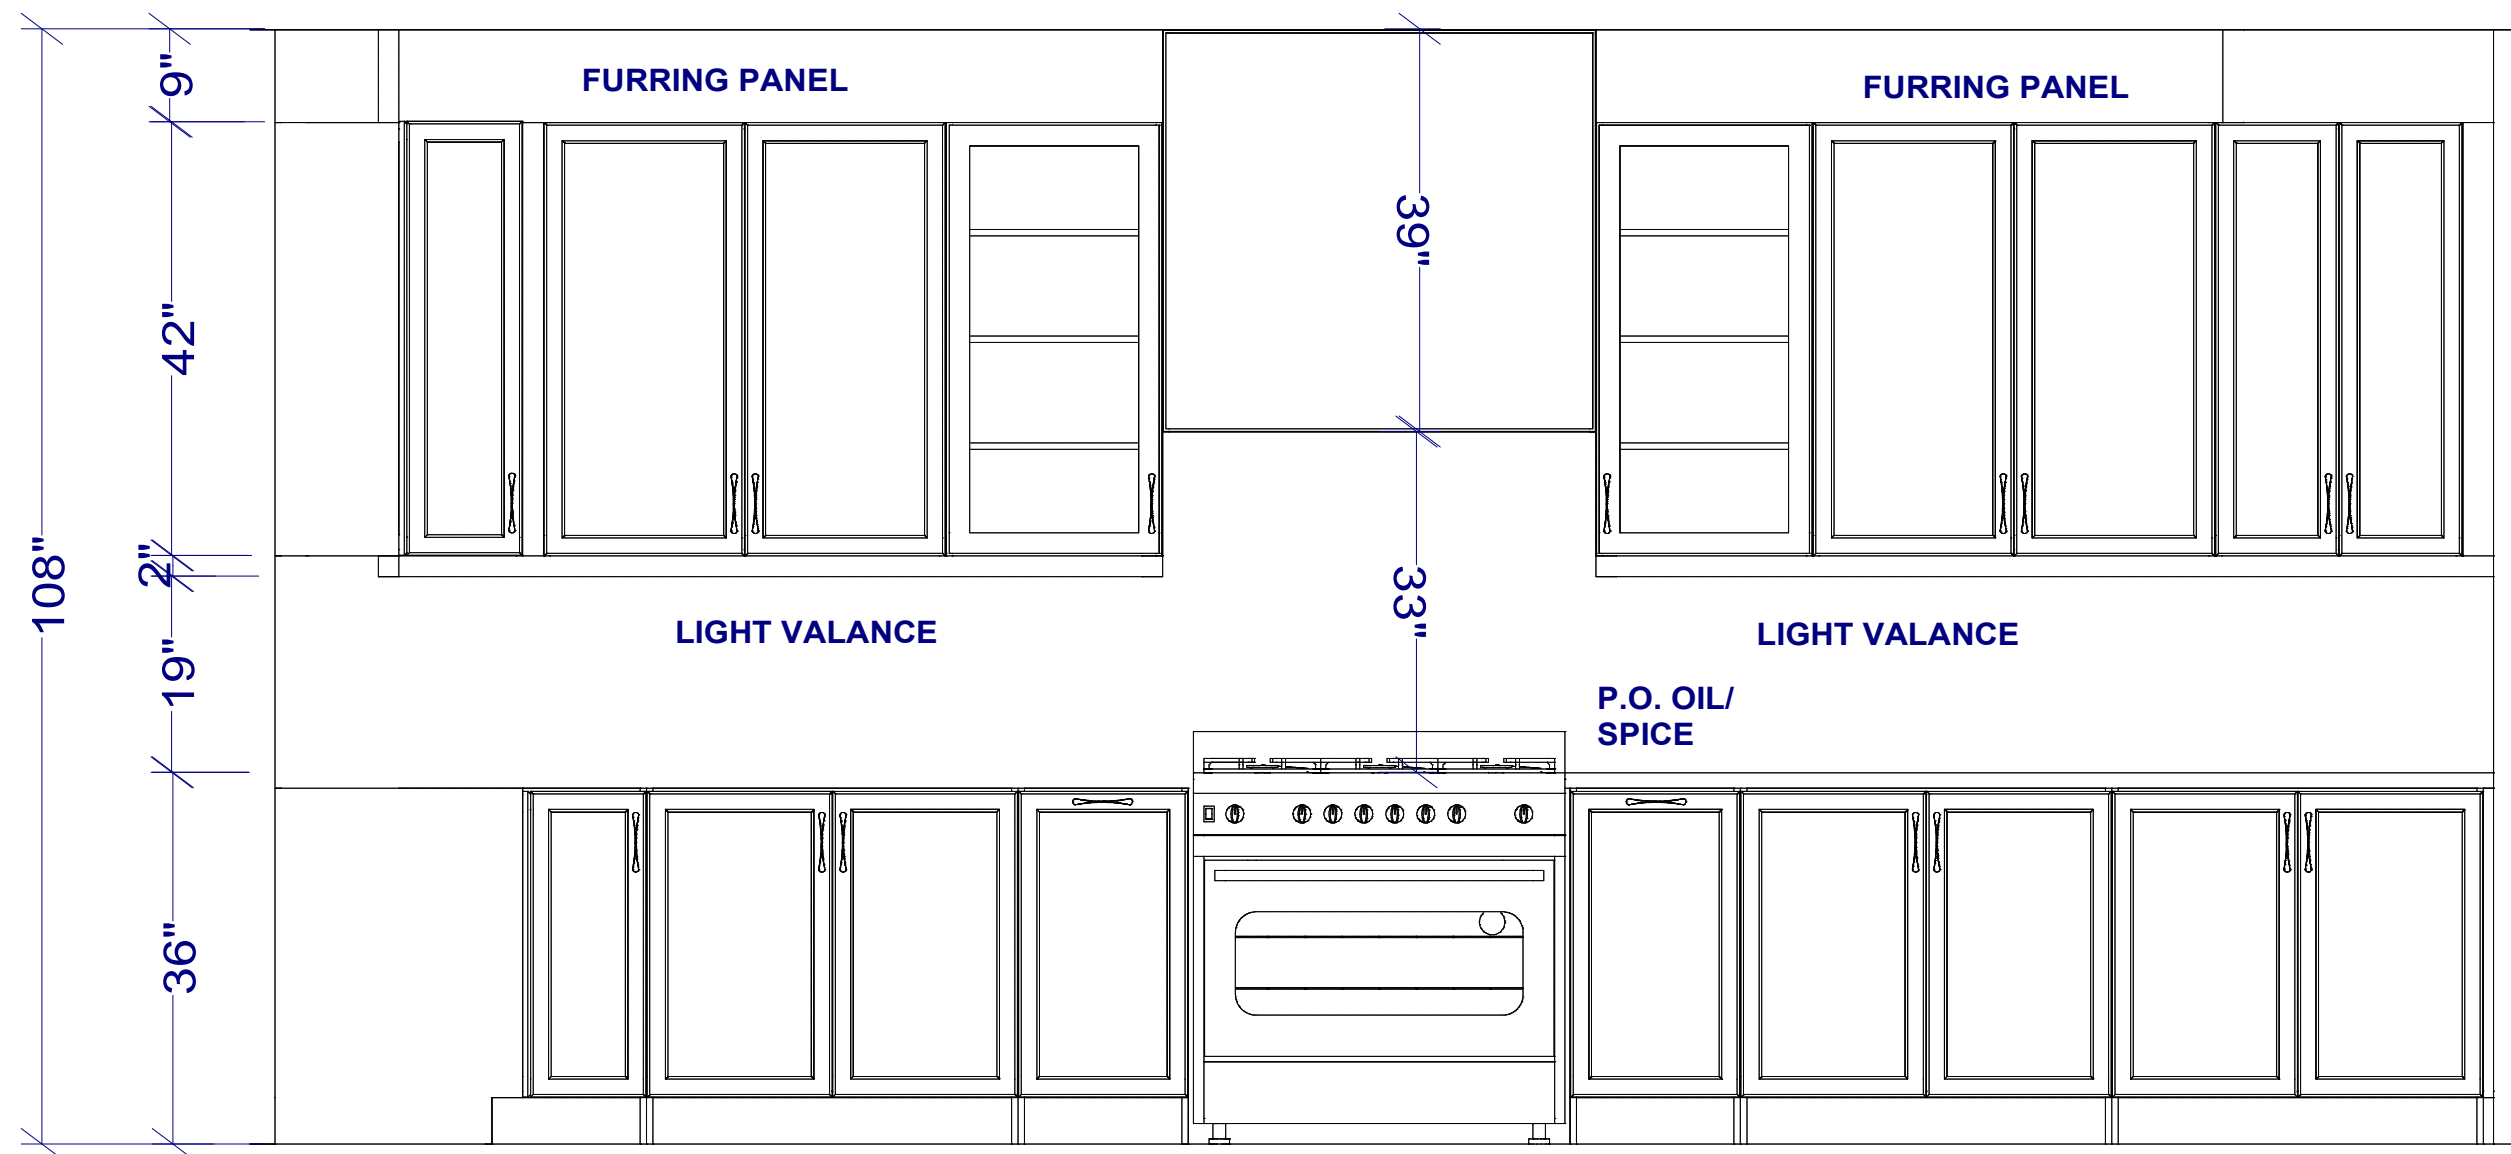


ELEVATION - RANGE WALL

All dimensions _size designations given are subject to verification on job site and adjustment to fit job conditions.




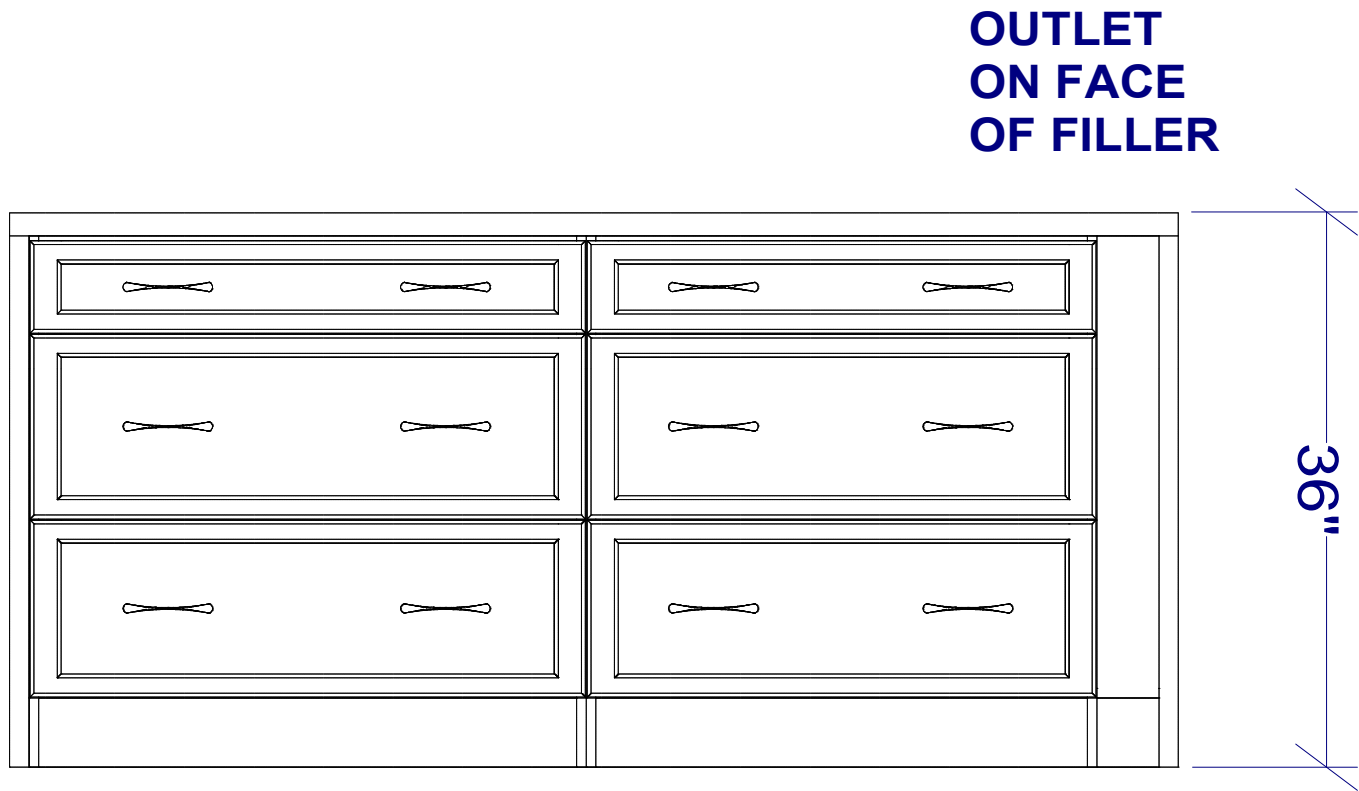
This is an original design and must not be released or copied unless applicable fee has been paid or job order placed.

Designed: 3/12/2024
Printed: 5/8/2024

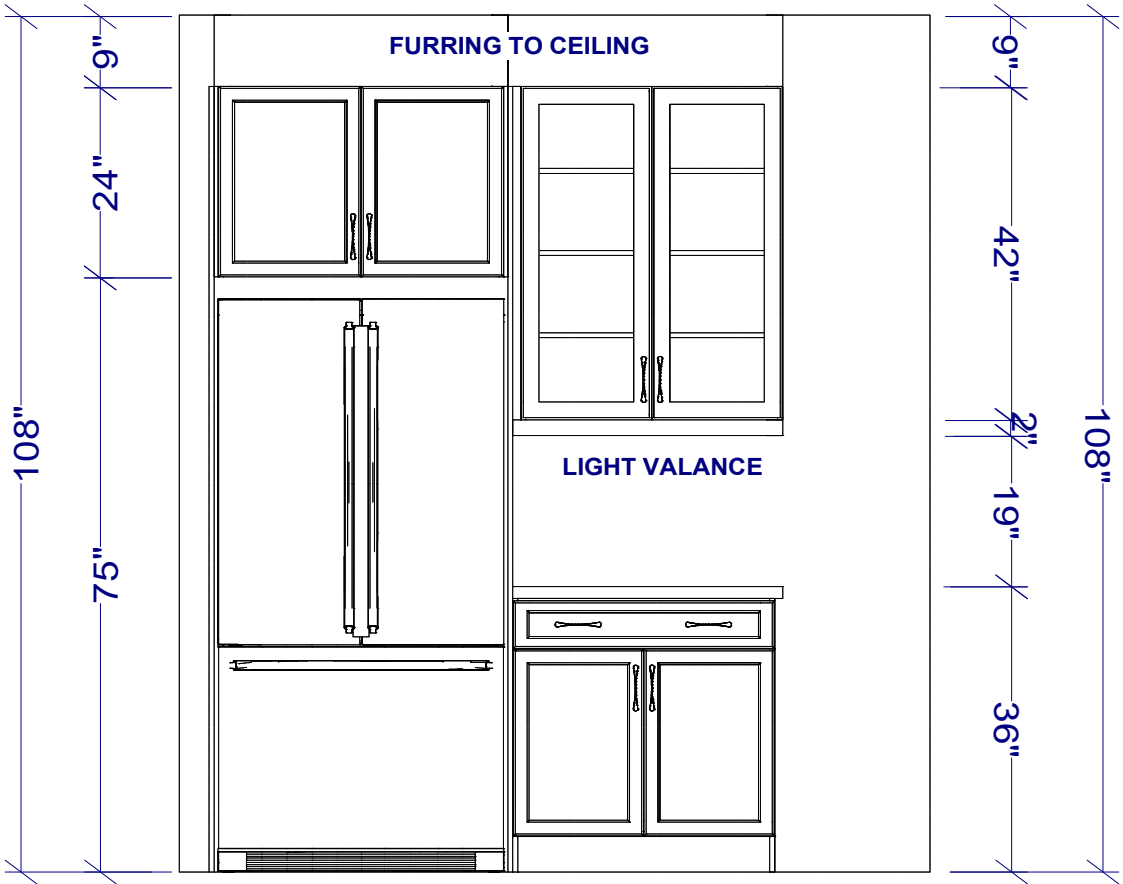


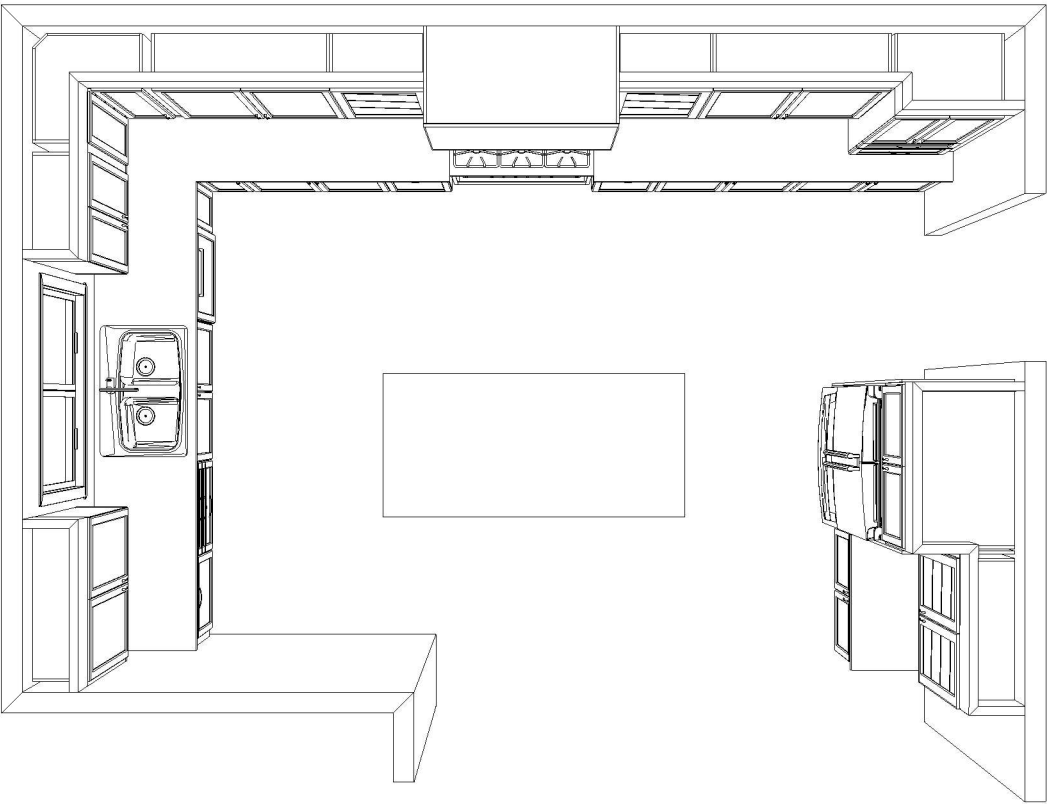
ELEVATION - FRIDGE WALL

All dimensions _size designations given are subject to verification on job site and adjustment to fit job conditions.		This is an original design and must not be released or copied unless applicable fee has been paid or job order placed.	Designed: 3/12/2024 Printed: 3/12/2024	



ISLAND ELEVATION

All dimensions _size designations given are subject to verification on job site and adjustment to fit job conditions.		This is an original design and must not be released or copied unless applicable fee has been paid or job order placed.	Designed: 3/12/2024 Printed: 3/12/2024		
DV3-94 - Kitchen Left - MAR 12 2024			EI 5	Drawing #: 1	No Scale.



Note: This drawing is an artistic interpretation of the general appearance of the design. It is not meant to be an exact rendition.




Designed: 3/12/2024
Printed: 3/12/2024



Note: This drawing is an artistic interpretation of the general appearance of the design. It is not meant to be an exact rendition.



Designed: 3/12/2024
Printed: 3/12/2024

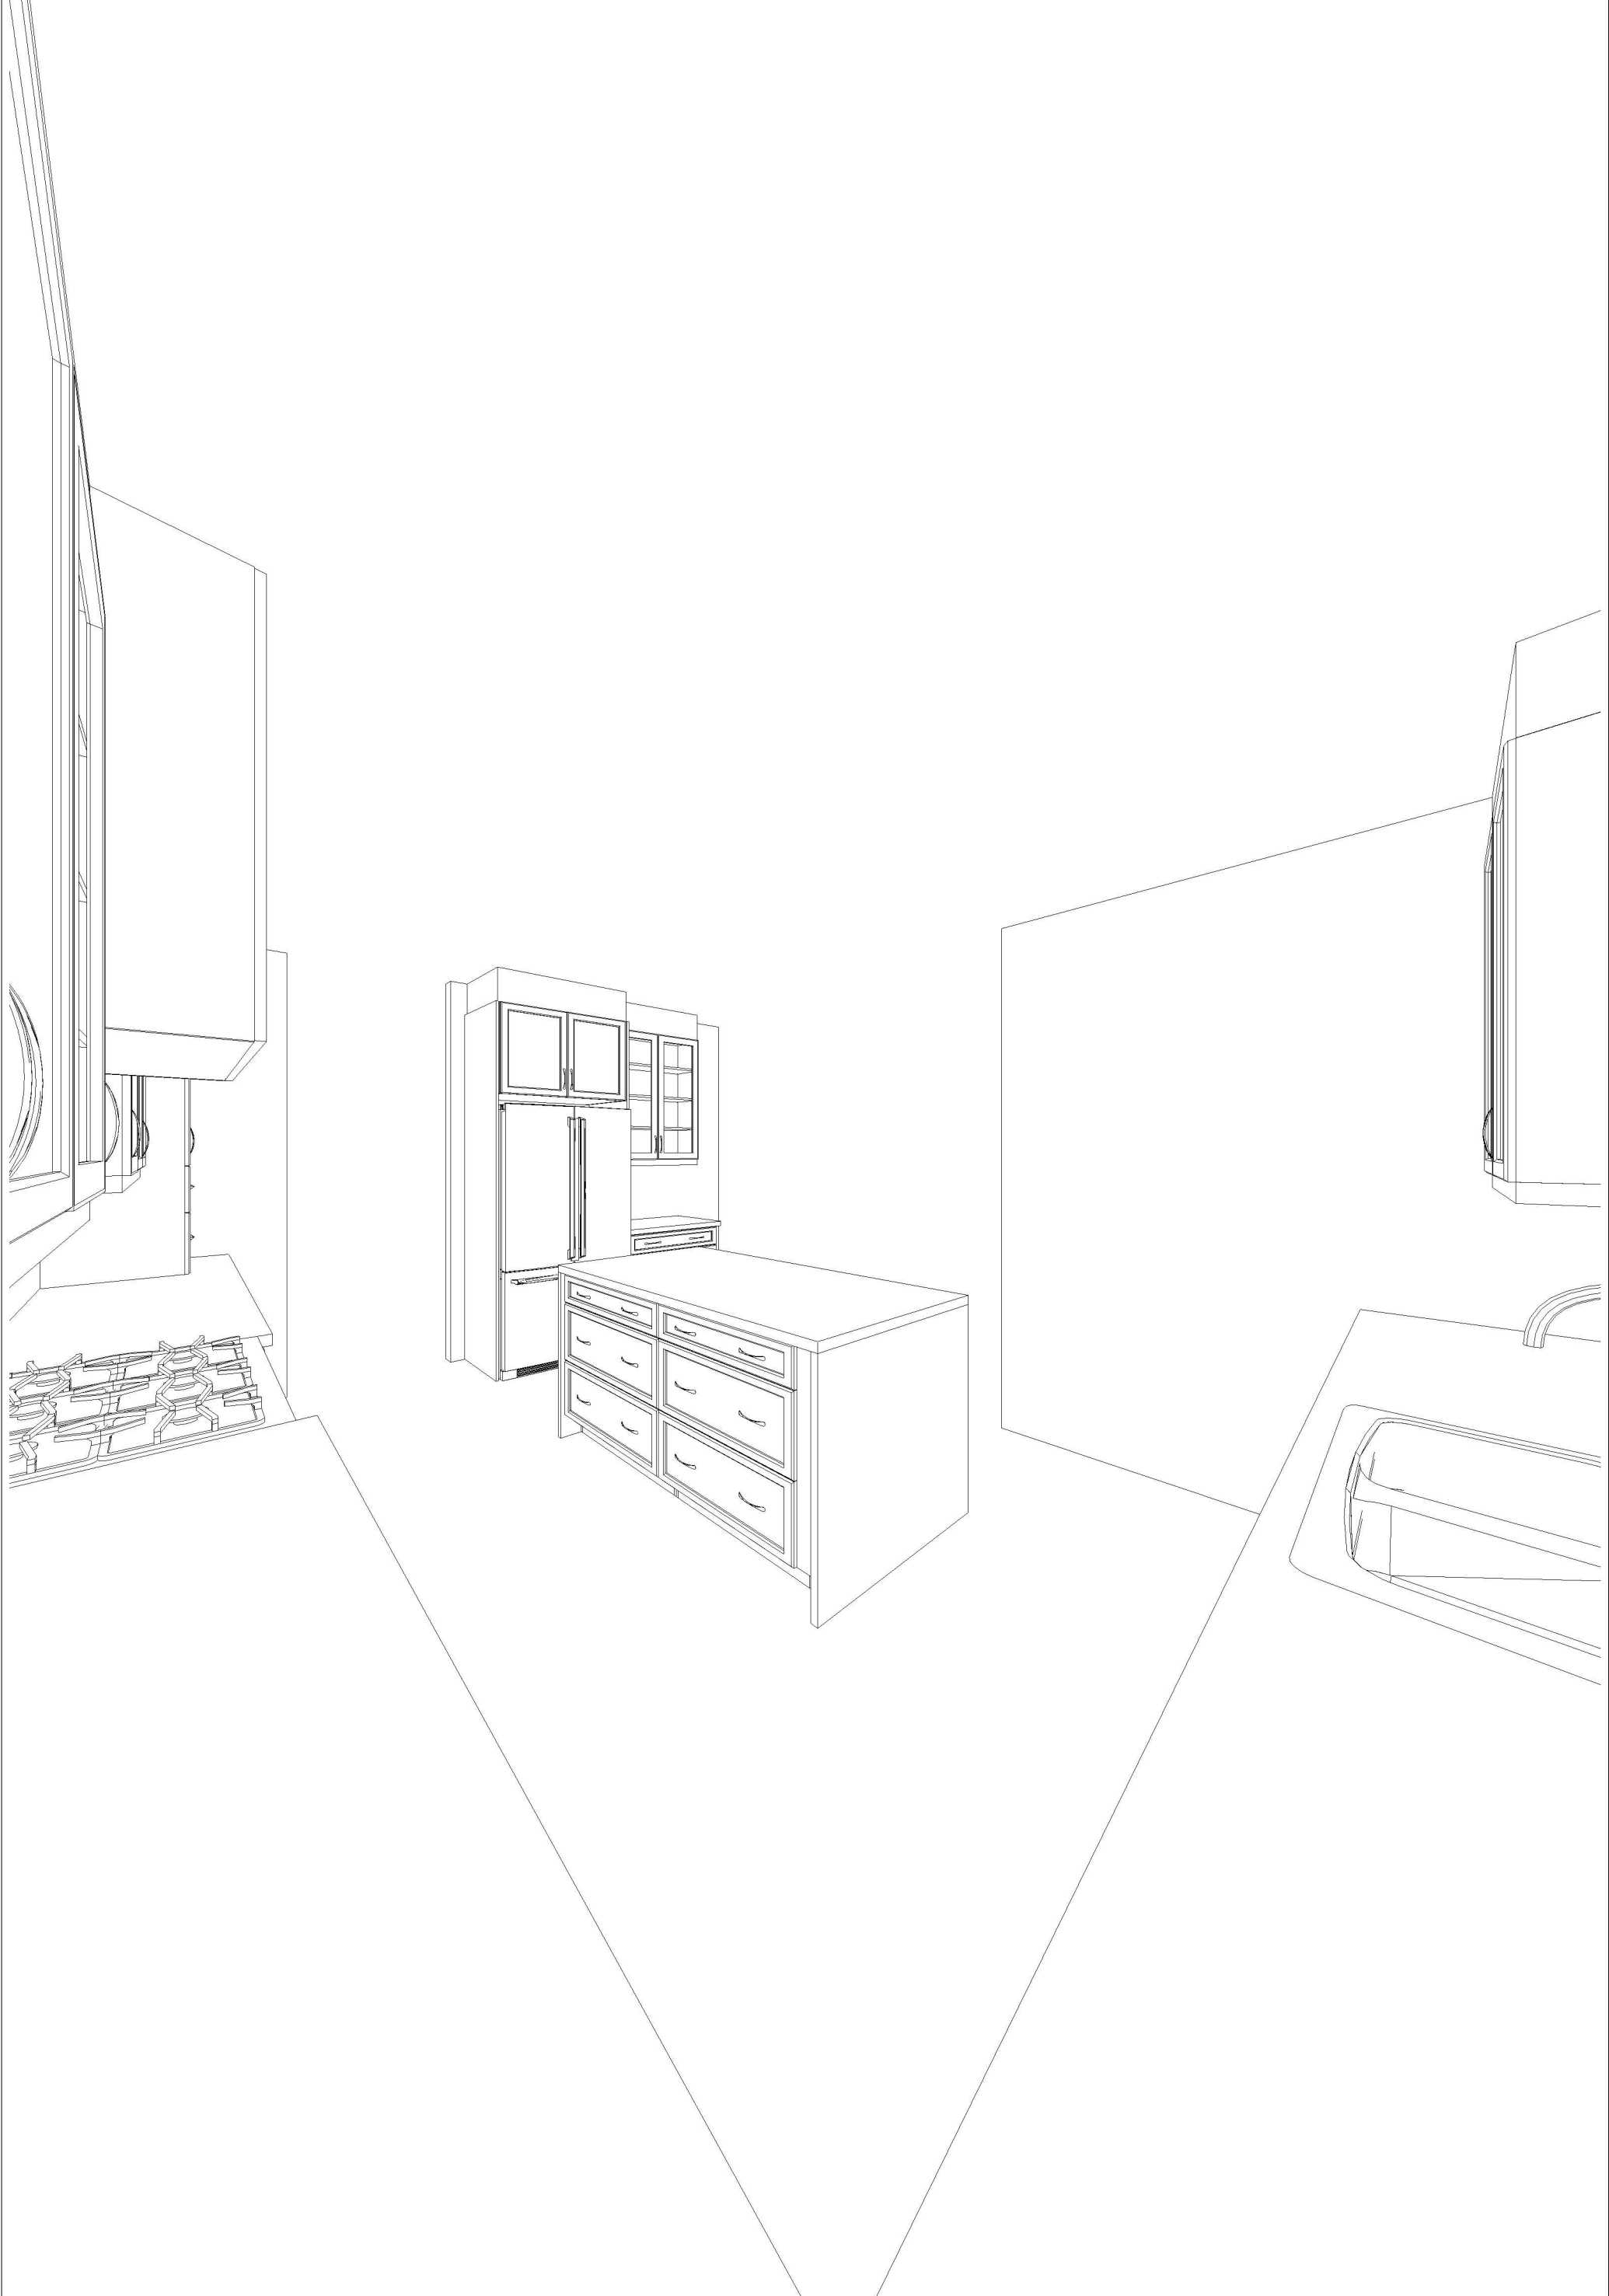

Note: This drawing is an artistic interpretation of the general appearance of the design. It is not meant to be an exact rendition.




Designed: 3/12/2024
Printed: 3/12/2024



Note: This drawing is an artistic interpretation of the general appearance of the design. It is not meant to be an exact rendition.



Designed: 3/12/2024
Printed: 3/12/2024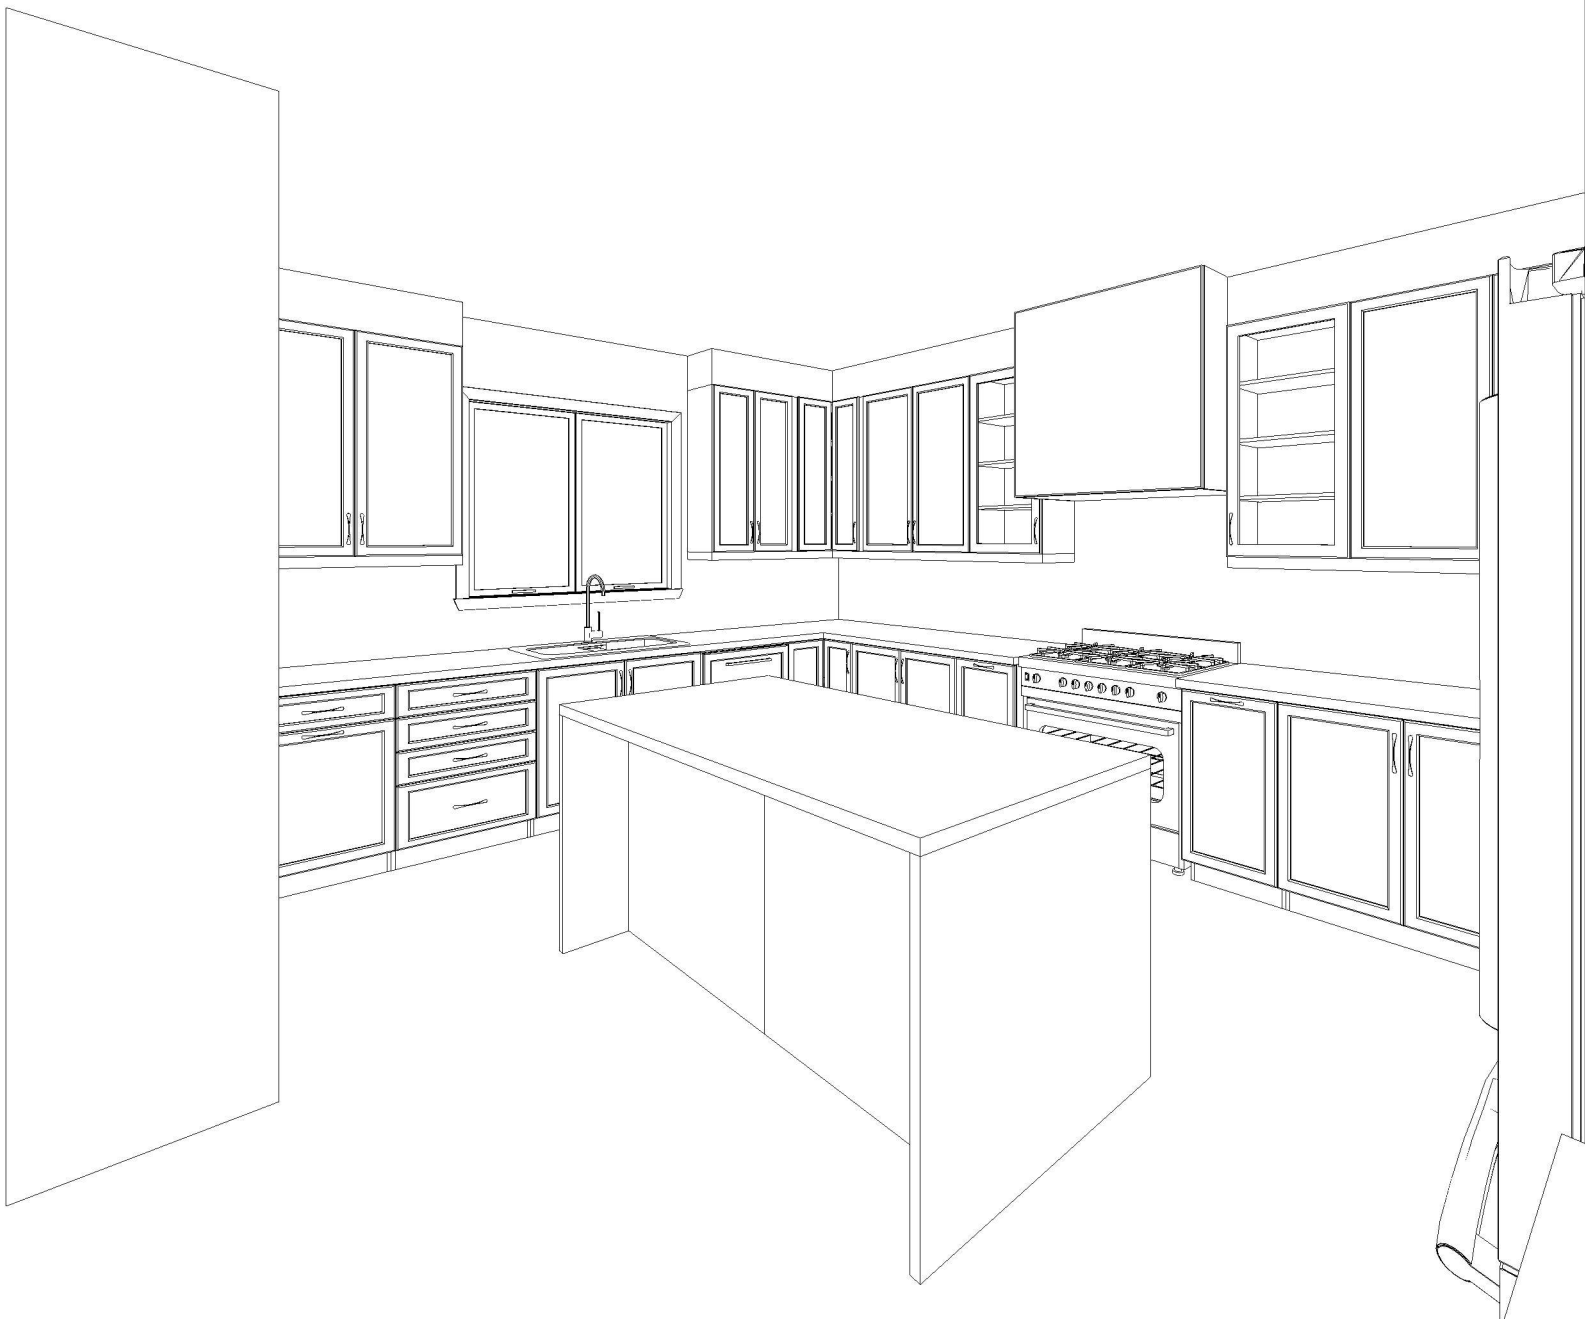

DCR PHOENIX HOMES


DIAMONDVIEW PHASE 3
LOT# 3-94

MODEL - KINGSWOOD (LEFT)

VANITIES
MAR. 21/24

- CABINETS- CARTIER LINE - 1 & 2
- HARDWARE - STD & 1ST UPGRADE
- STANDARD WHITE INTERIOR
- METAL DRAWER BOX
- 5/8" TOE KICK
- FLAT SHOE MOULDING


KITCHEN HEIGHT CABINETS

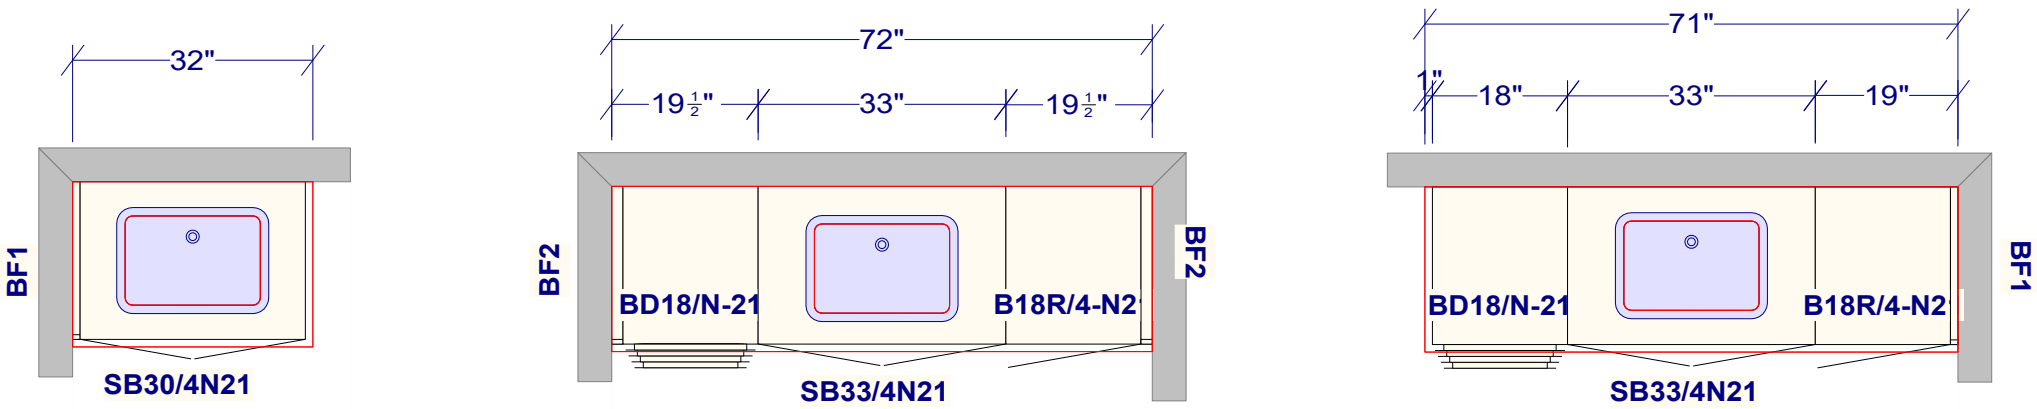


POWDER

SHARED BATH
BDRM 3 & 4


ENSUITE #2

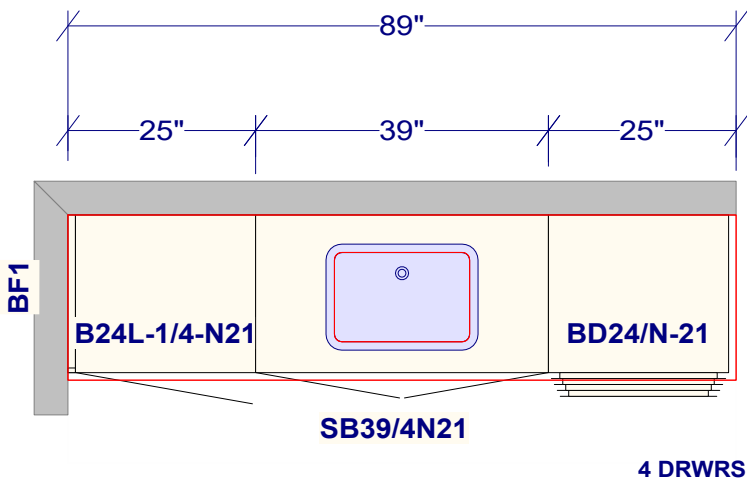


PRIMARY ENSUITE

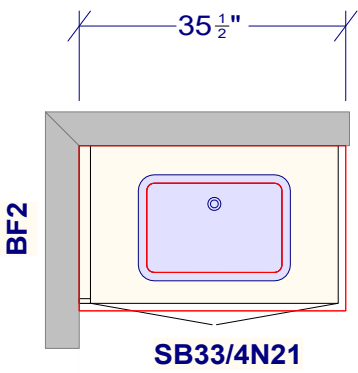


BASEMENT BATH

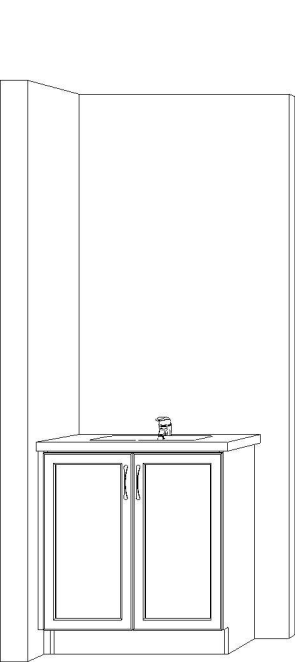

POWDER ROOM

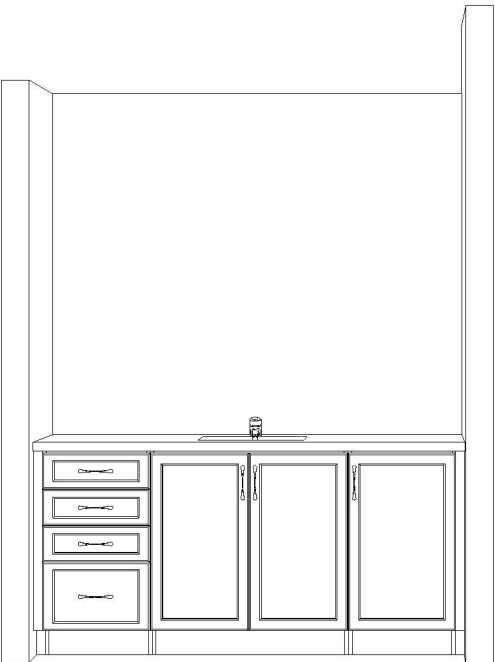

SHARED BATH

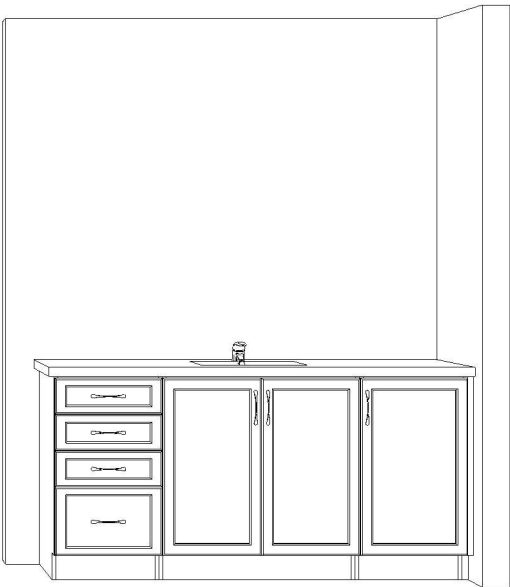


ENSUITE 2


Note: This drawing is an artistic interpretation of the general appearance of the design. It is not meant to be an exact rendition.



Designed: 1/23/2024
Printed: 1/26/2024

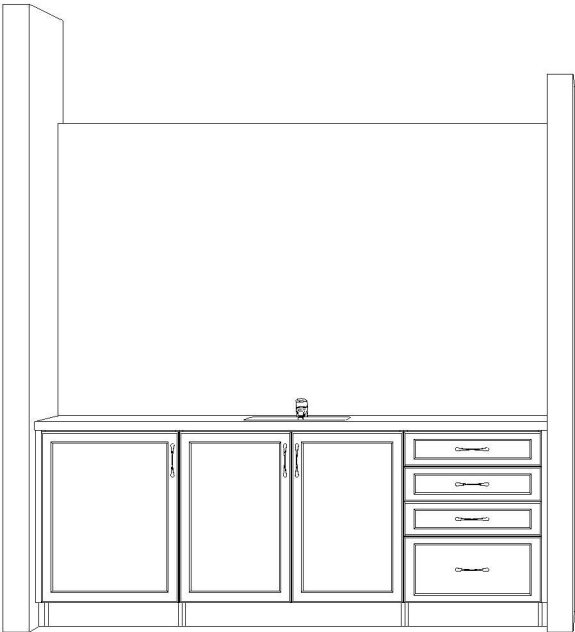

PRIMARY ENSUITE

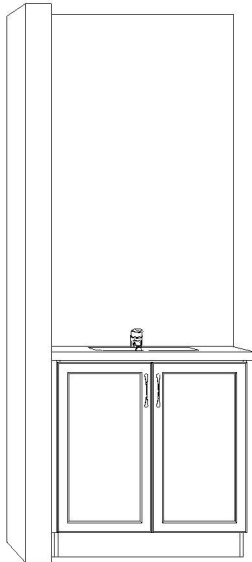

BASEMENT BATH

Note: This drawing is an artistic interpretation of the general appearance of the design. It is not meant to be an exact rendition.



Designed: 1/23/2024
Printed: 1/26/2024


DCR PHOENIX HOMES

DIAMONDVIEW PHASE 3
LOT# 3-94

MODEL - KINGSWOOD (LEFT)


LAUNDRY ROOM / BASEMENT BAR

MAR. 14/24

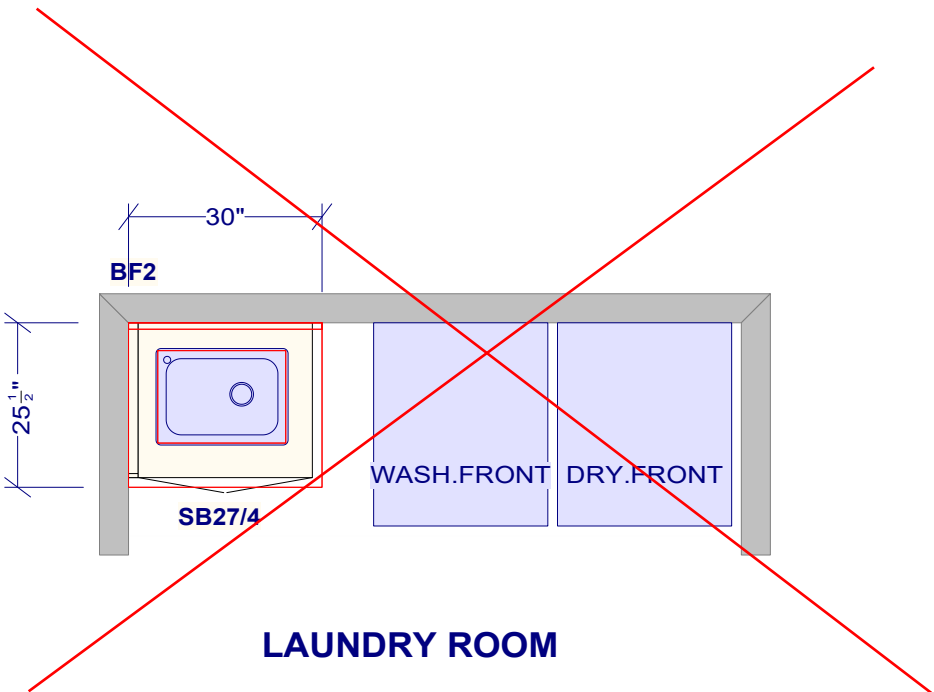


LAUNDRY ROOM


JC-8 F9: 9F HC F9J -G98 A

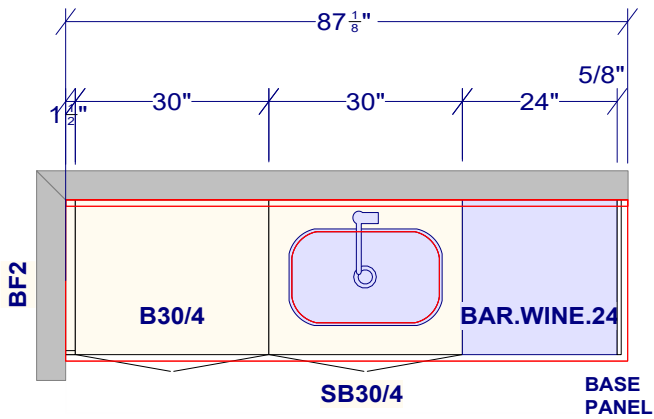

BASEMENT BAR

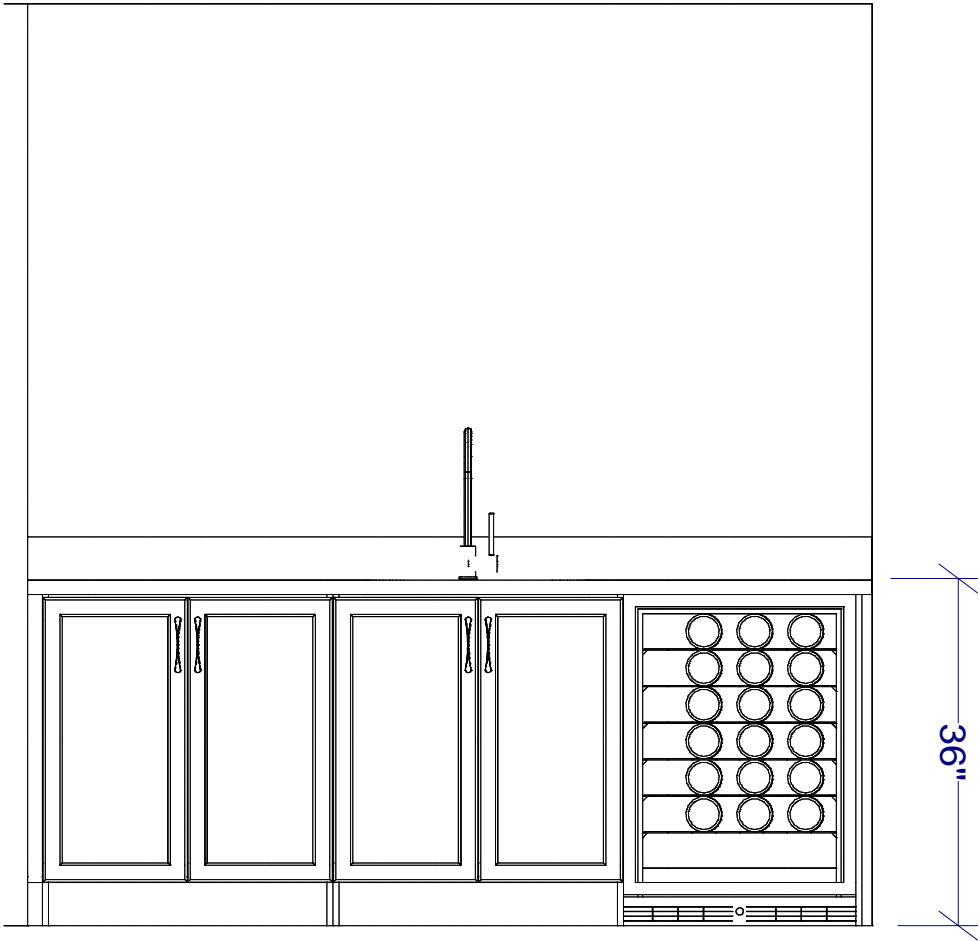

BASEMENT BAR - ELEVATION

All dimensions _size designations given are subject to verification on job site and adjustment to fit job conditions.		This is an original design and must not be released or copied unless applicable fee has been paid or job order placed.	Designed: 1/23/2024 Printed: 3/14/2024	


DCR PHOENIX HOMES

DIAMONDDVIEW PHASE 3
LOT# 3-94

MODEL - KINGSWOOD (LEFT)


LAUNDRY ROOM
QUARTZ SUPPORT PANELS
OVER WASHER / DRYER

SEPT. 9/24

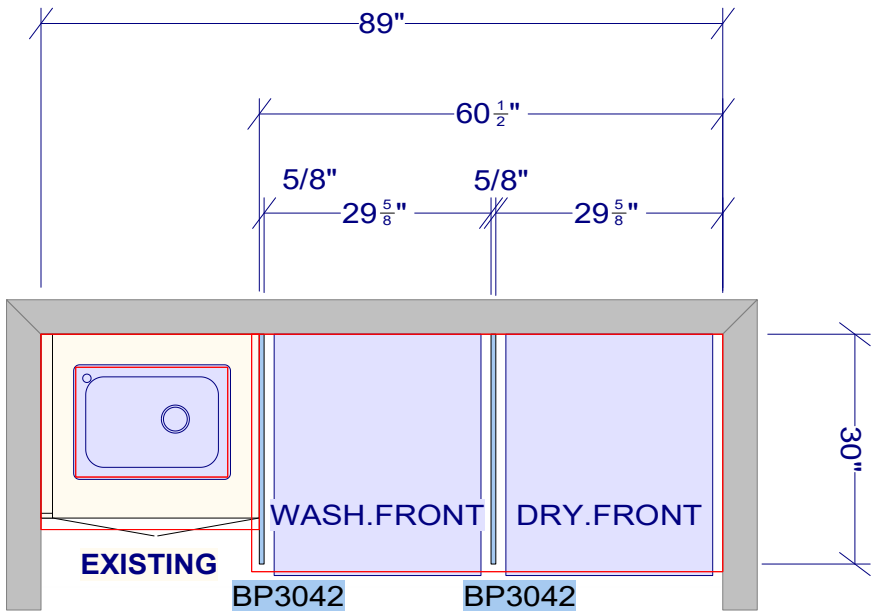

LAUNDRY ROOM - COUNTERTOP SUPPORT

All dimensions _size designations given are subject to verification on job site and adjustment to fit job conditions.		This is an original design and must not be released or copied unless applicable fee has been paid or job order placed.	Designed: 9/9/2024 Printed: 9/9/2024	

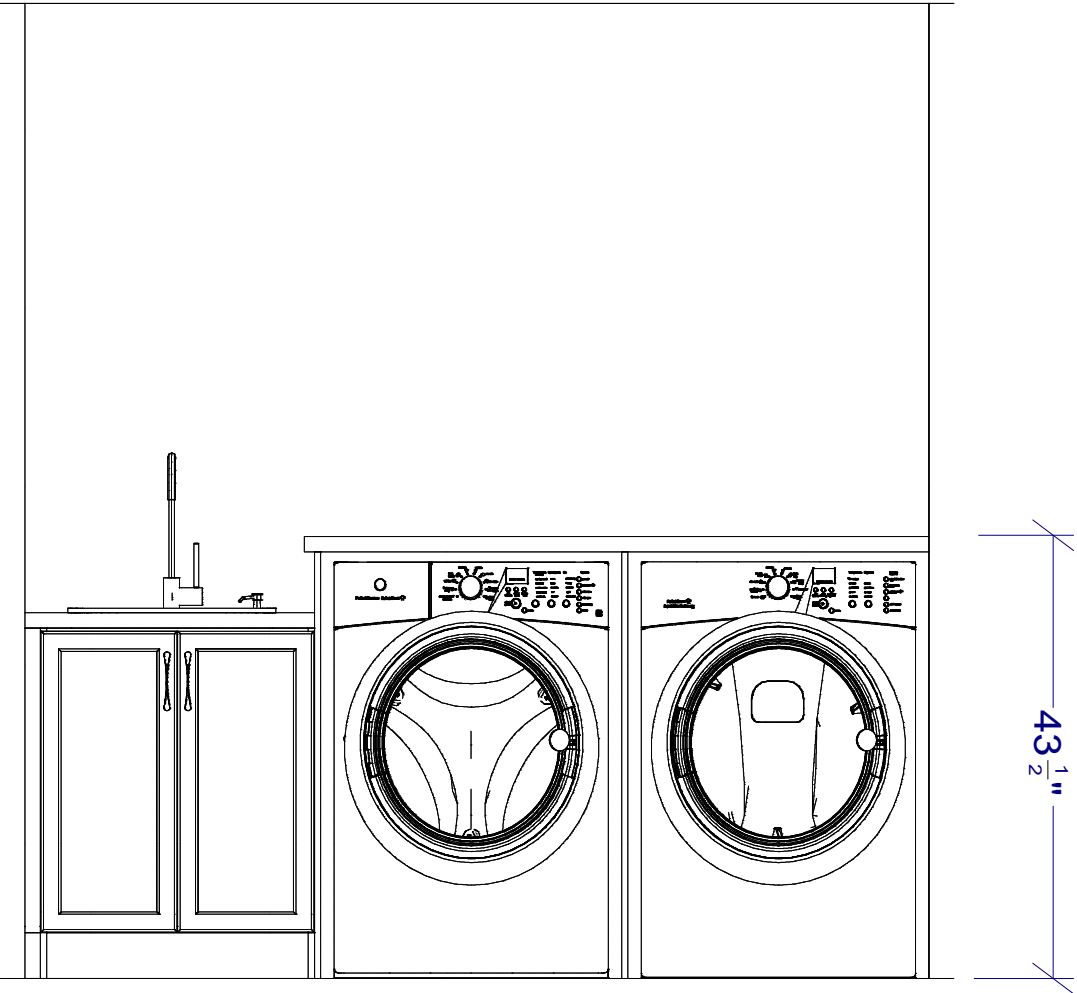

LAUNDRY ROOM - COUNTERTOP SUPPORT PANELS & CLEATING

All dimensions _size designations given are subject to verification on job site and adjustment to fit job conditions.		This is an original design and must not be released or copied unless applicable fee has been paid or job order placed.	Designed: 9/9/2024 Printed: 9/9/2024	