DCR PHOENIX HOMES

LOT #139

WHITE TAIL RIDGE 4

MODEL - OAKSIDE

(GARAGE RIGHT)

KITCHEN

MOUNTING HEIGHT - 96

conditions.

AS BUILT

42" UPPERS

PERIMETER - SOHO CHALK WHITE ISLAND - SOHO STONE

HARDWARE - HU66

STANDARD WHITE INTERIOR

METAL DRAWER BOX

4 PCS - 5/8" KICK - FIN. BOTH ENDS


1 PCS - 90 DEG. CORNER MOULD

1 PCS - T-MOULD

5 PCS - FLAT MOULD

FILL TO CEILING WITH 1" MOULDING, FURRING PANEL & CEILING CROWN

GLASS DOORS - PEBBLED GLASS

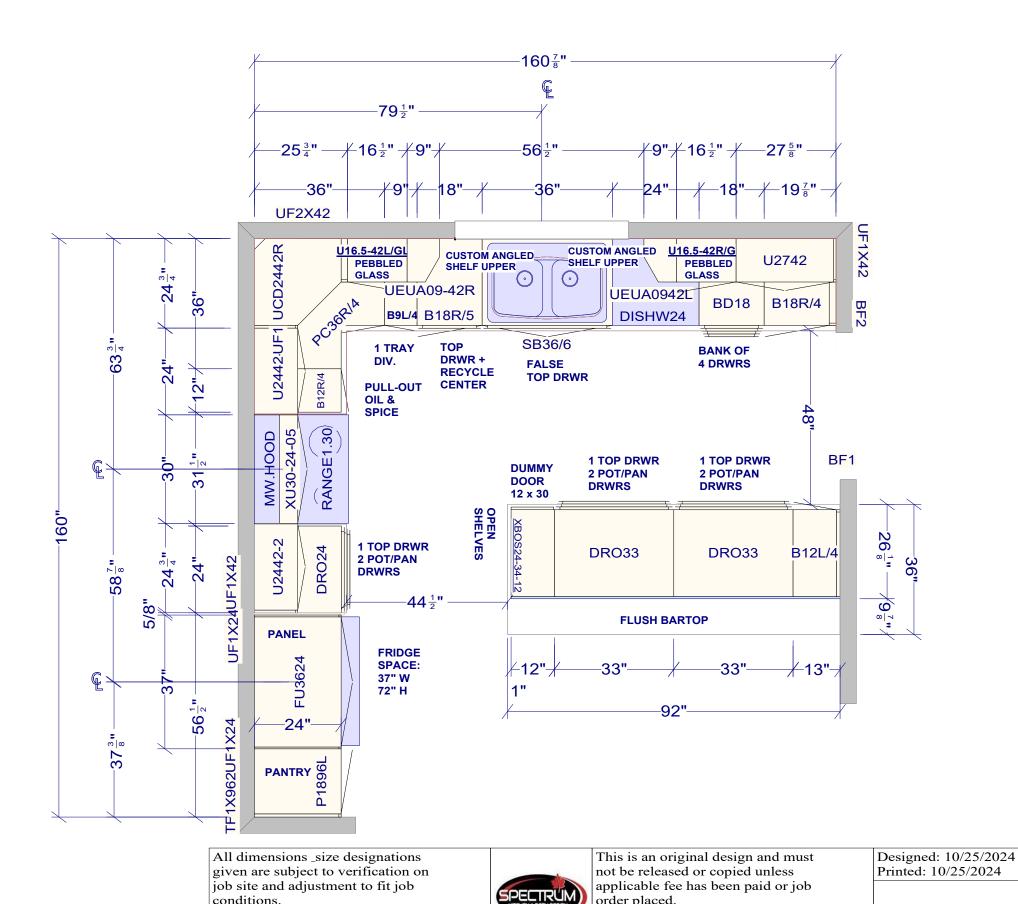

DCR - #139 White Tail Ridge 4- Oakside Kitchen (RIGHT) - NOV 6 2023 - AS PER

order placed.

All

Drawing #: 1 No Scale.