



WT4 LOT 135

DCR PHOENIX HOMES


NEWINGTON
(GARAGE LEFT)
VANITIES
5 BDRM

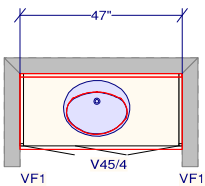


POWDER ROOM

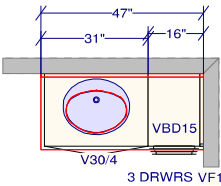


IN-LAW - BEDROOM #2 ENSUITE

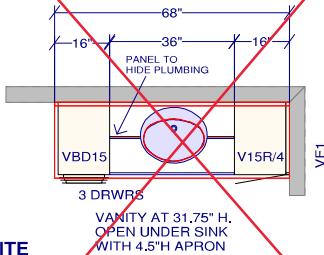


OPTIONAL IN-LAW SUITE
ACCESSIBLE ENSUITE

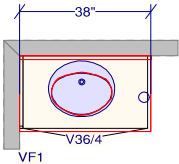

BEDROOM 4 ENSUITE

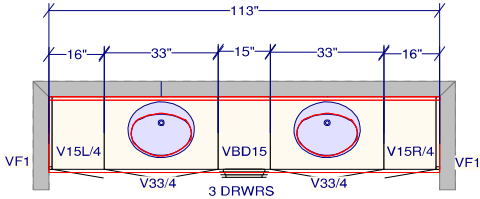

MAIN BATHROOM - JACK & JILL ENSUITE

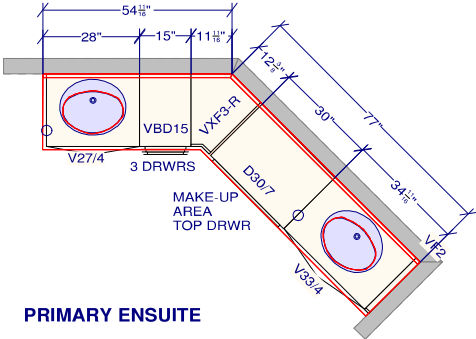

PRIMARY ENSUITE


DS
100
DS
100

All dimensions _size designations
given are subject to verification on
job site and adjustment to fit job
conditions.




This is an original design and must
not be released or copied unless
applicable fee has been paid or job
order placed.


Designed: 2023-01-20
Printed: 2023-03-27

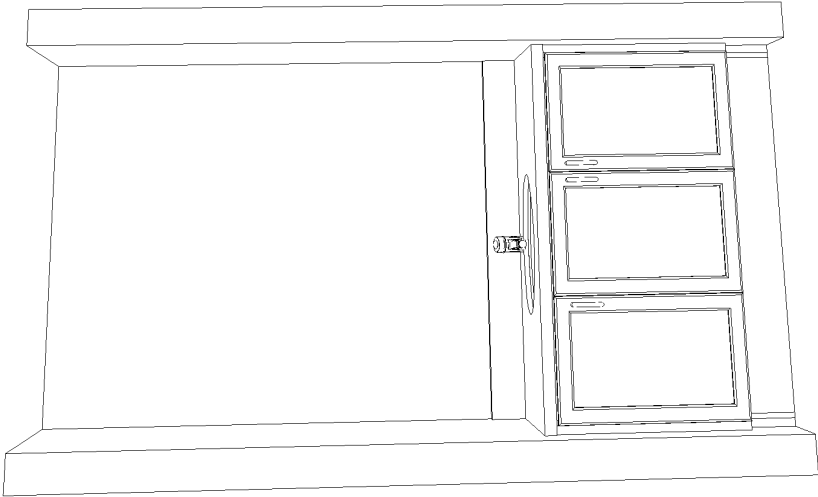

POWDER ROOM

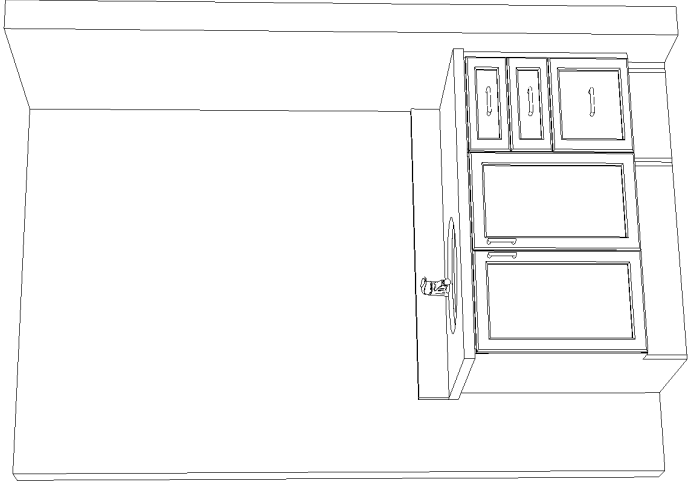

IN-LAW - BEDROOM
#2 ENSUITE

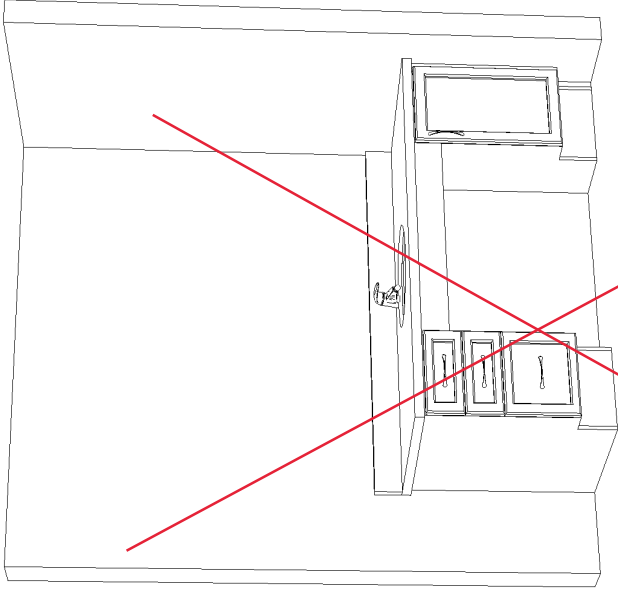

OPTIONAL
IN-LAW ENSUITE
(ACCESSIBLE)

CUSTOMER APPROVAL

I have reviewed these drawings and understand the details of the design and the CARTIER KITCHENS specifications.


Signature _____

Date _____


Designed: 2023-01-20
Printed: 2023-03-27




Note: This drawing is an artistic interpretation of the general appearance of the design. It is not meant to be an exact rendition.

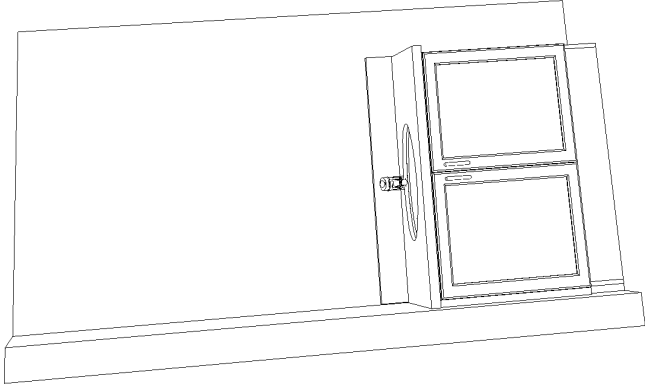

BDRM 4 ENSUITE

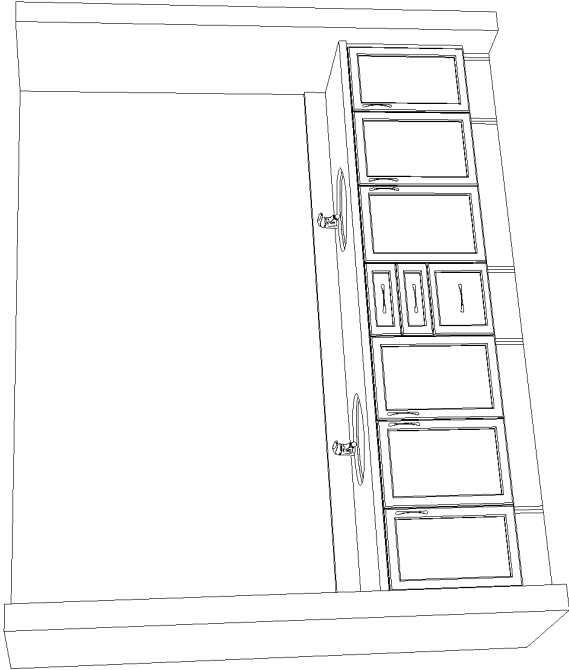

MAIN BATHROOM
(JACK & JILL)

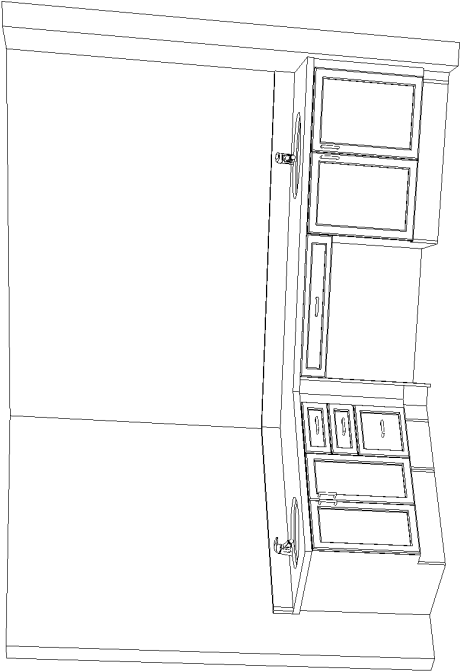

PRIMARY ENSUITE



CUSTOMER APPROVAL

I have reviewed these drawings and understand the details of the design and the CARTIER KITCHENS specifications.

Signature_____

Date_____

Note: This drawing is an artistic interpretation of the general appearance of the design. It is not meant to be an exact rendition.



Designed: 2023-01-20
Printed: 2023-03-27