


FLAT CEILINGS THROUGHOUT
NO STIPPLE

****NOTE****
ALL WINDOW LINTELS TO BE 2-2X10
W/ P2 POSTS ON EACH SIDE U.N.O.

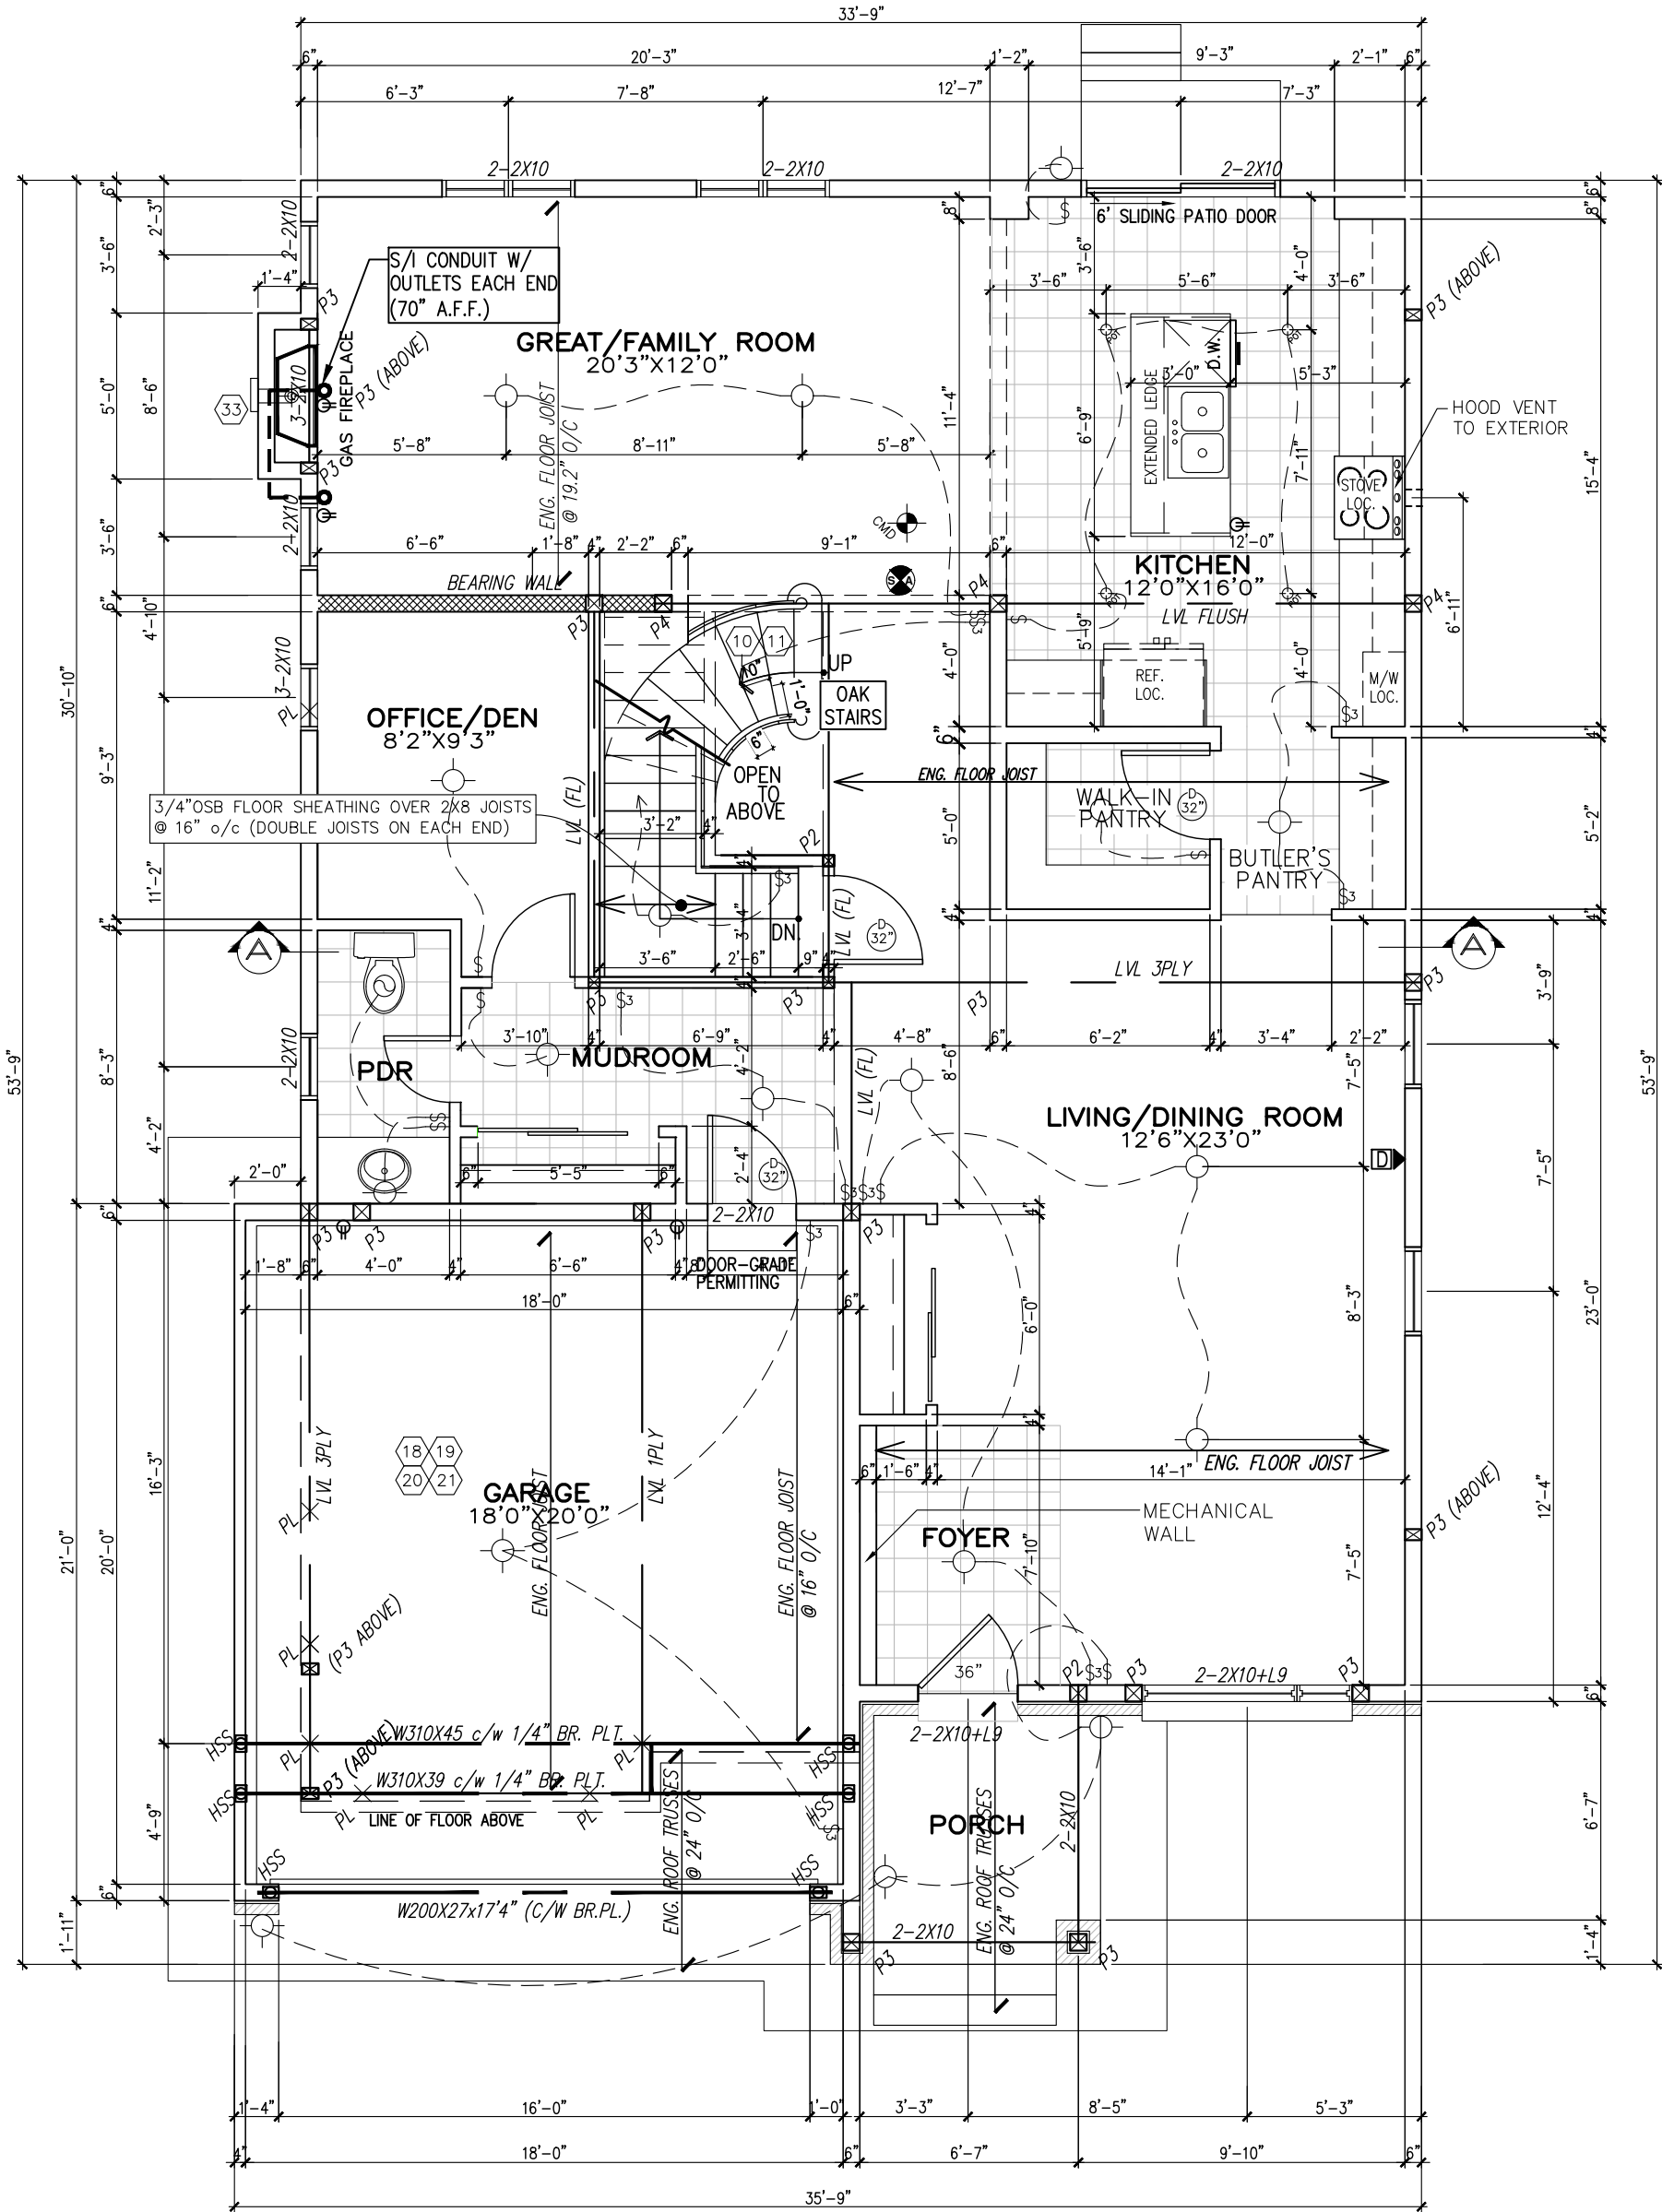

GROUND FLOOR PLAN EL. M
1310 SF

NOTE:
ALL LVL'S SUPPORTING FLOOR LOADS ARE FLUSH,
UNLESS NOTED OTHERWISE AND TO BE SPECIFIED
BY THE FLOOR TRUSS MANUFACTURER, SEE
MANUF. LAYOUT.



MADISON – 2020

SITE: **PATHWAYS**

LOT NUMBER: **348**

CIVIC ADDRESS:
621 MIIKANA ROAD

9	DELETE GROUND FLOOR SHOWER	NOV 13 2024	SP
8	FINAL FOR SITE – REVISED – 9' SEC. FLR.	SEP 24 2024	SP
7	FINAL FOR SITE	JUL 29 2024	SP
6	BEP FOR SITE	JUL 25 2024	SP
5	FINAL FOR SITE PREP	FEB 23 2024	CB
4	FINAL BLACKLINES – REV	JAN 10 2024	CB
No. Description		Date	By
REVISIONS			

footprint: 43–10

drawn by: SP


date: NOV/19

scale: 3/16"=1'–0"

sheet no: **3**


D.C.L. – A10 **8**

FLAT CEILINGS THROUGHOUT
NO STIPPLE

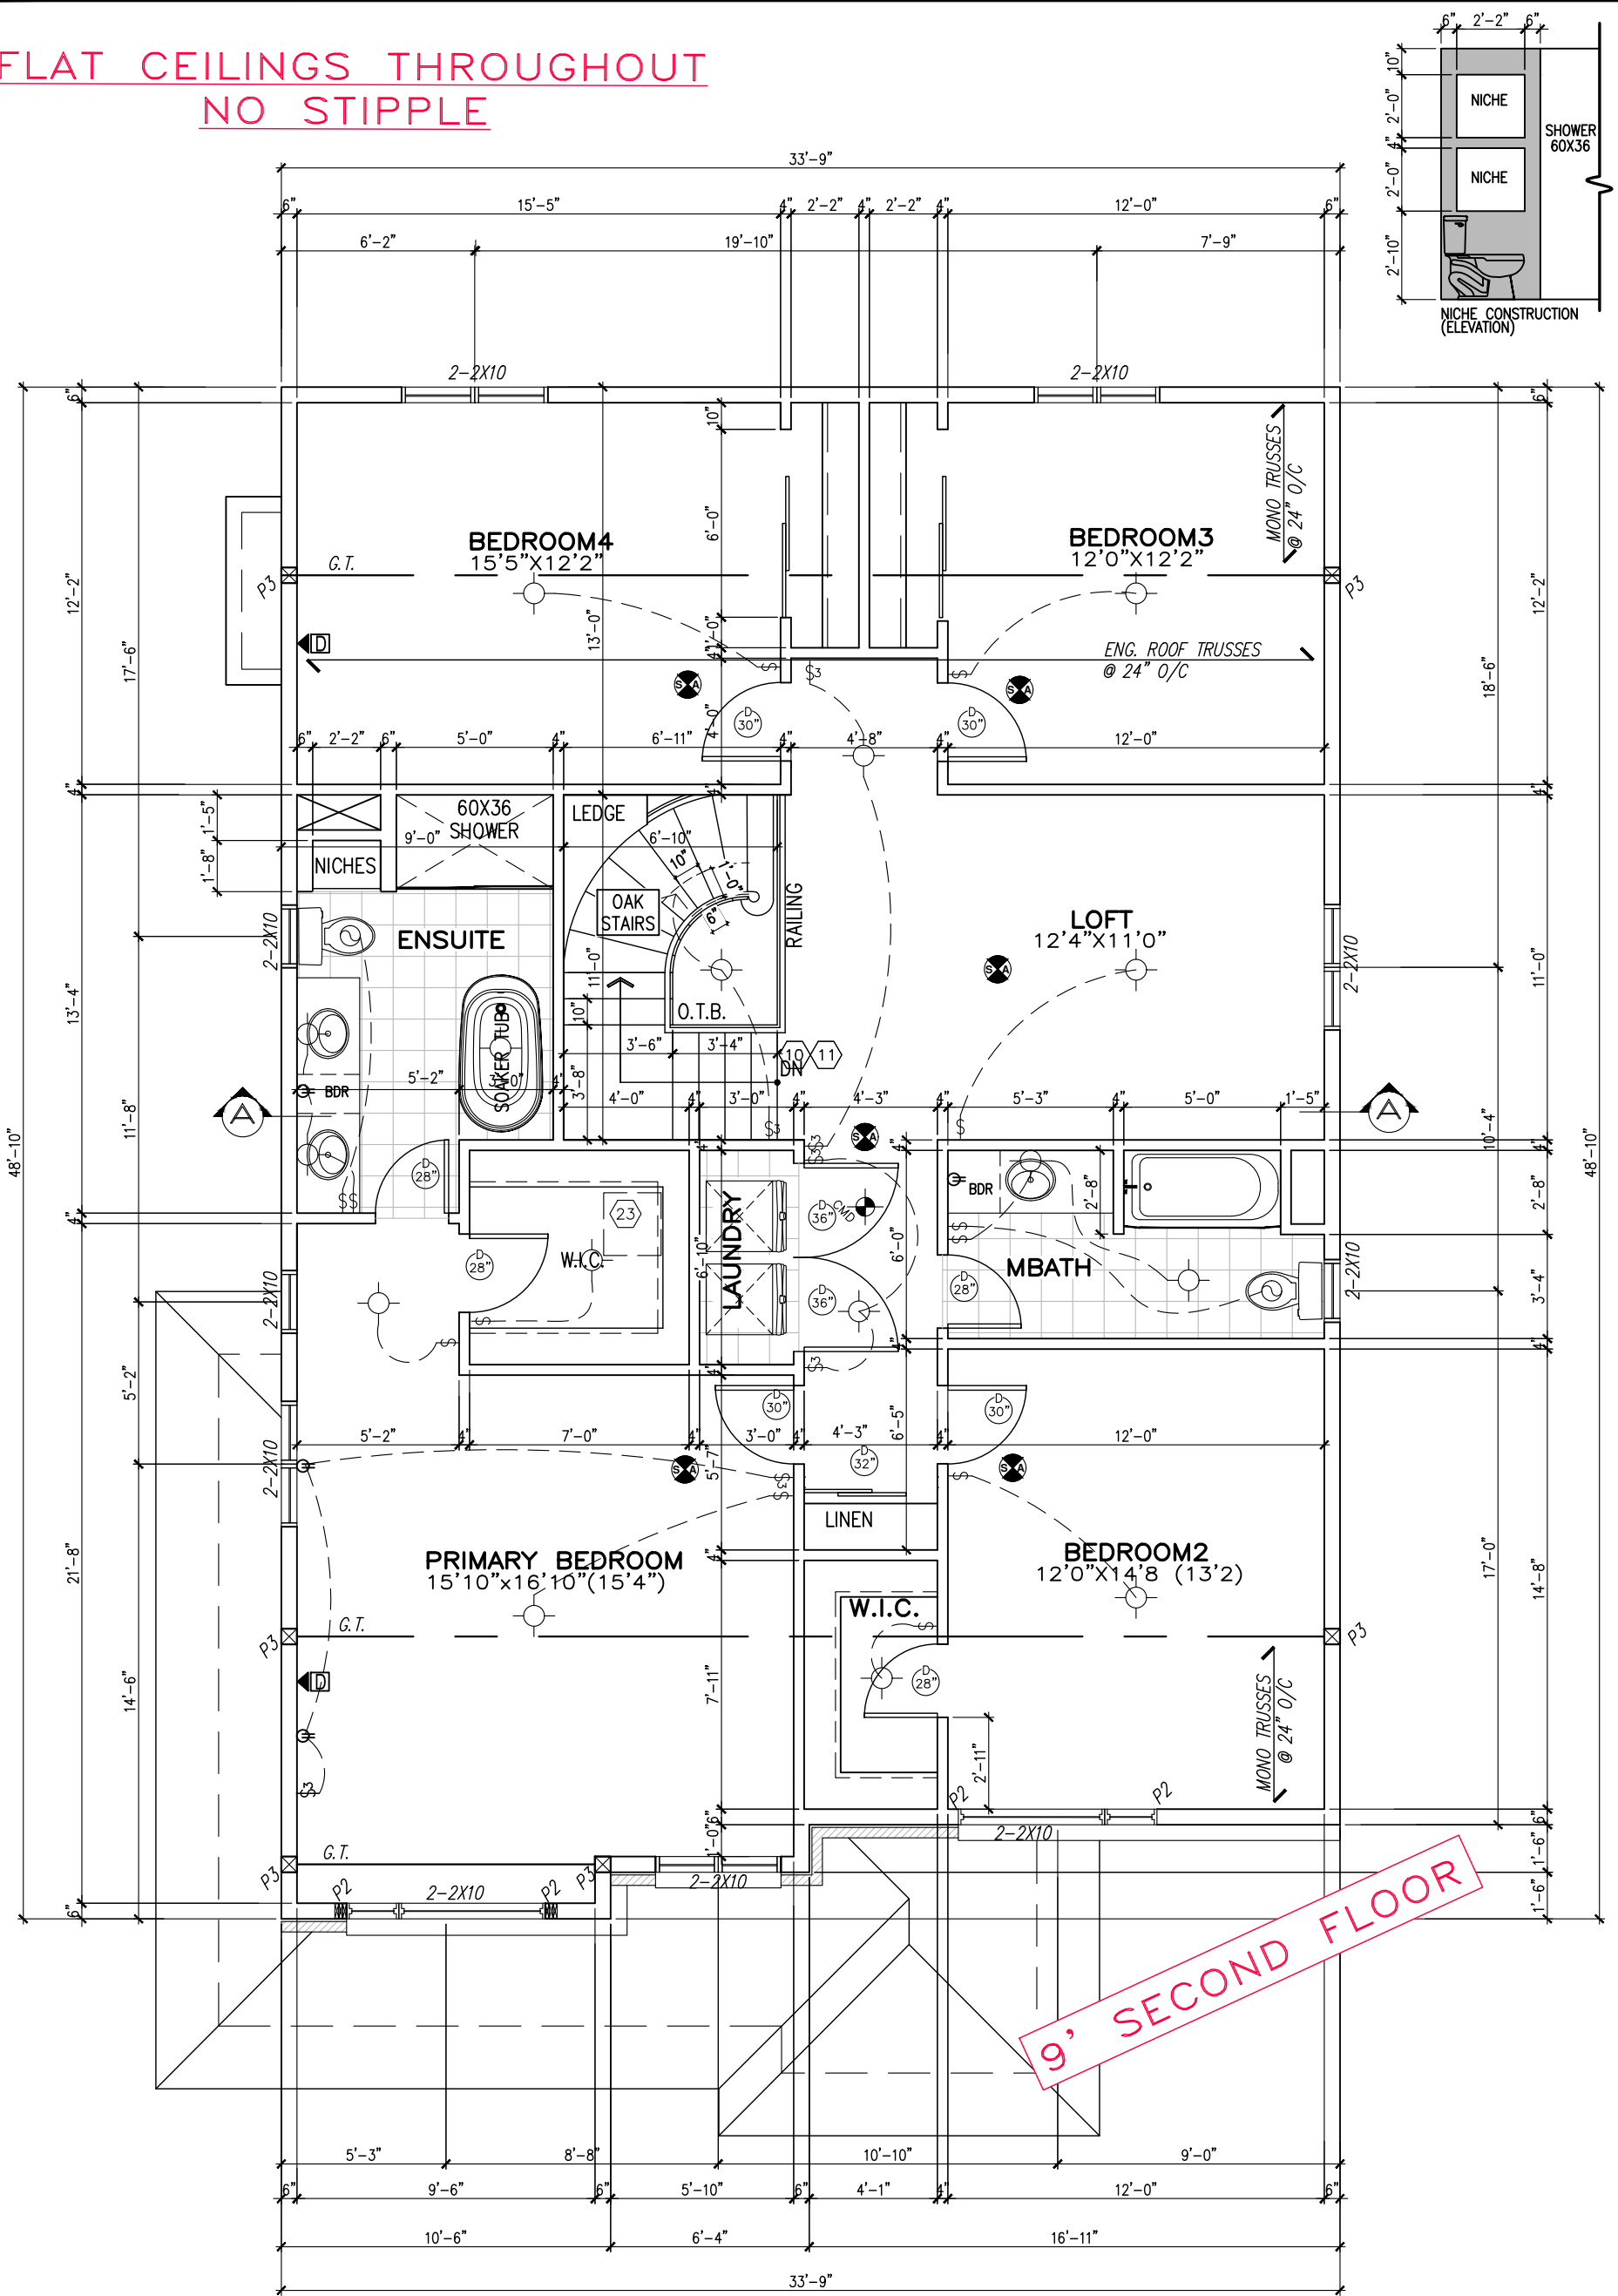

SECOND FLOOR PLAN EL. M
(4 BEDROOM+LOFT)
1524 sq. ft.

NOTE:
ALL LVL'S SUPPORTING FLOOR LOADS ARE FLUSH,
UNLESS NOTED OTHERWISE AND TO BE SPECIFIED
BY THE FLOOR TRUSS MANUFACTURER, SEE
MANUF. LAYOUT.

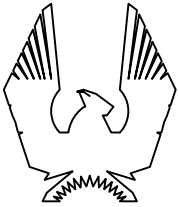

PHOENIX HOMES

MADISON – 2020

SITE: PATHWAYS

LOT NUMBER:

348

CIVIC ADDRESS:
621 MIKANA ROAD

9	DELETE GROUND FLOOR SHOWER	NOV 13 2024	SP
8	FINAL FOR SITE – REVISED – 9' SEC. FLR.	SEP 24 2024	SP
7	FINAL FOR SITE	JUL 29 2024	SP
6	BEP FOR SITE	JUL 25 2024	SP
5	FINAL FOR SITE PREP	FEB 23 2024	CB
4	FINAL BLACKLINES – REV	JAN 10 2024	CB
No. Description		Date	By
REVISIONS			


footprint:	43–10
drawn by:	SP
date:	NOV/19
scale:	3/16"=1'–0"
sheet no:	4
D.C.L. – A10	8

[illegible]

A diagram showing a cross-section of a building. A horizontal line represents the floor level. Above this line, there is a red rectangular stamp with the text "9' SECOND FLOOR" written diagonally. The stamp is tilted upwards from left to right. The text "9'" is on the left, and "SECOND FLOOR" is on the right. The stamp has a red border and a light red fill.

****ATTENTION SIDING CREW****
DO NOT INSTALL
DECORATIVE TRIM AROUND
WINDOWS

2'-0"

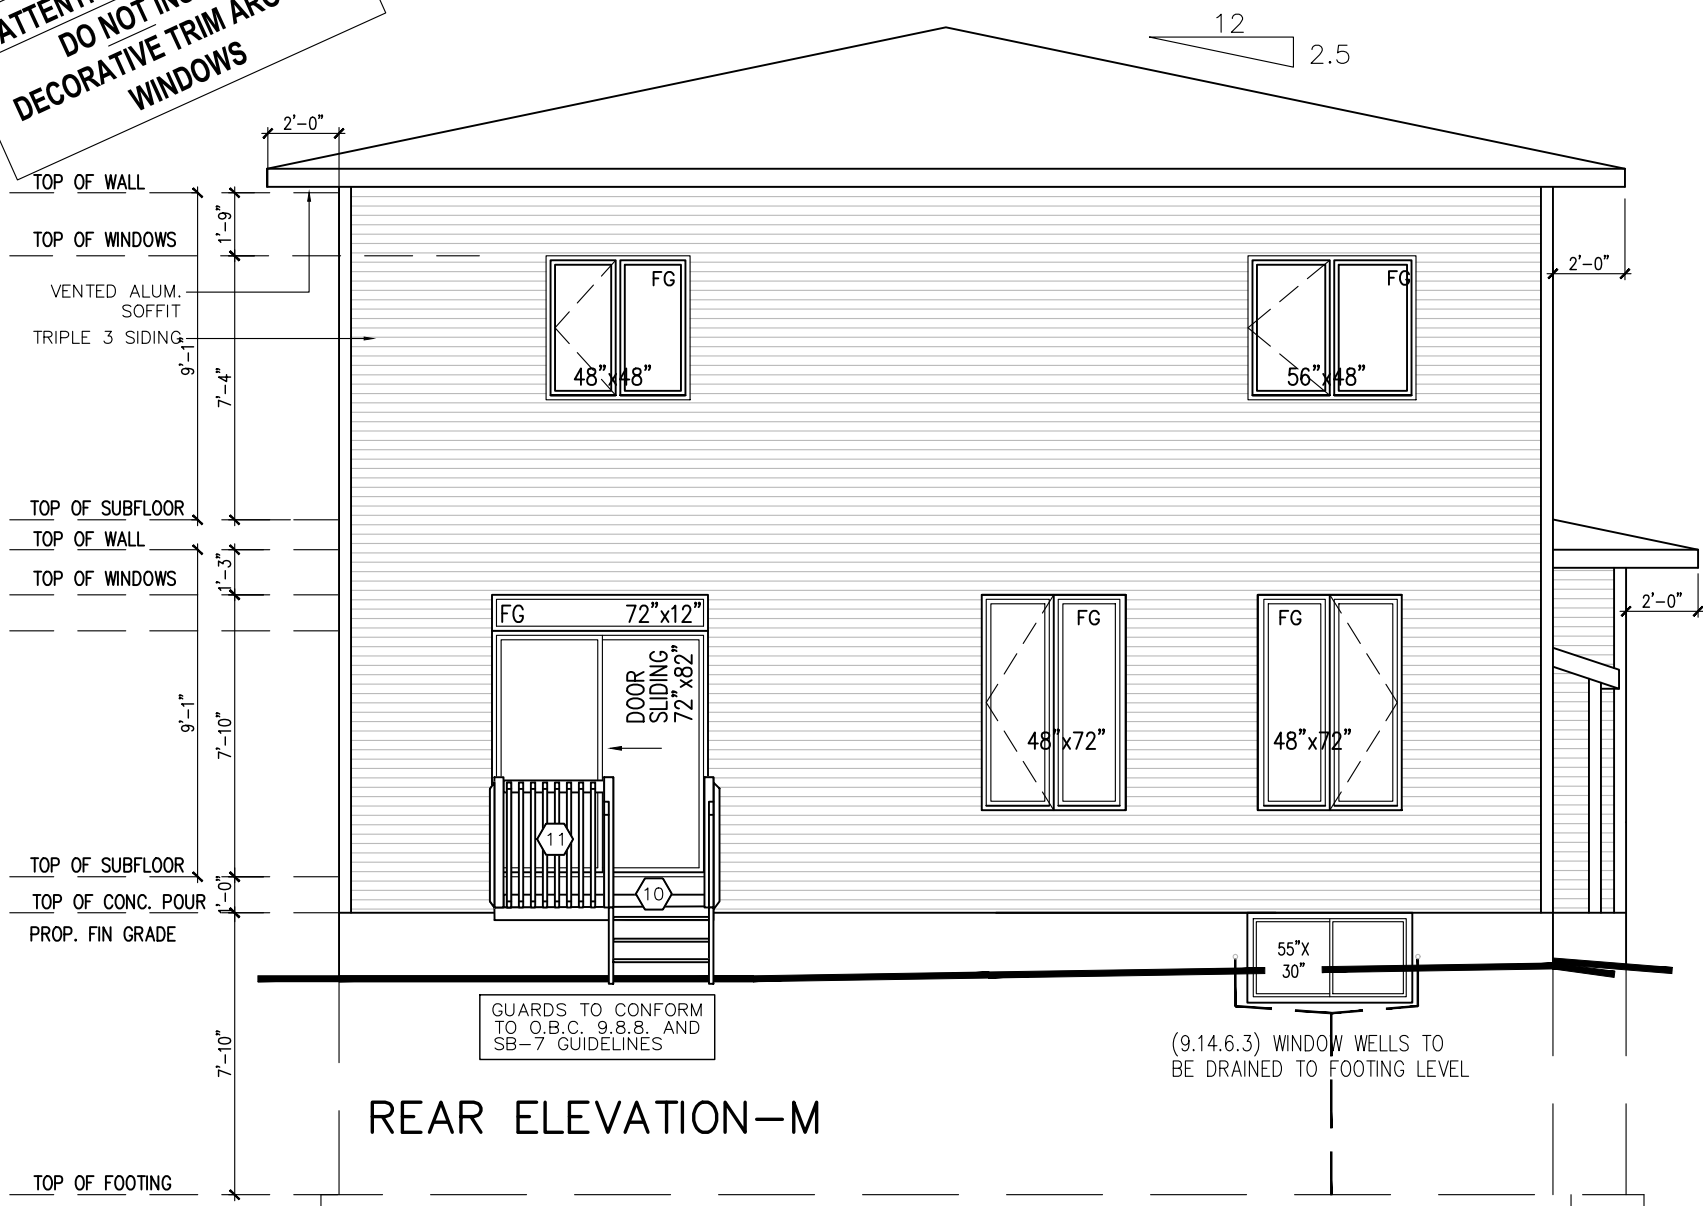

REAR ELEVATION—M




348


9	DELETE GROUND FLOOR SHOWER	NOV 13 2024	SP
8	FINAL FOR SITE – REVISED – 9’ SEC. FLR.	SEP 24 2024	SP
7	FINAL FOR SITE	JUL 29 2024	SP
6	BEP FOR SITE	JUL 25 2024	SP
5	FINAL FOR SITE PREP	FEB 23 2024	CB
4	FINAL BLACKLINES – REV	JAN 10 2024	CB
No.	Description	Date	By
REVISIONS			

footprint:	43-10
drawn by:	SP
date:	NOV/19
scale:	3/16"=1'-0"
sheet no:	
D.C.L. - A10	

CONTRACTOR MUST VERIFY ALL DIMENSIONS ON THE JOB AND REPORT ANY DISCREPANCY TO DCR/PHOENIX BEFORE PROCEEDING WITH THE WORK.
ALL DRAWINGS AND SPECIFICATIONS ARE INSTRUMENTS OF SERVICE AND THE PROPERTY OF THE DCR/PHOENIX WHICH MUST BE RETURNED AT THE COMPLETION OF THE WORK.
ALL DRAWINGS TO BE USED FOR CONSTRUCTION ONLY AFTER BUILDING PERMIT HAS BEEN ISSUED.
DO NOT SCALE DRAWINGS, USE DIMENSIONS PROVIDED.

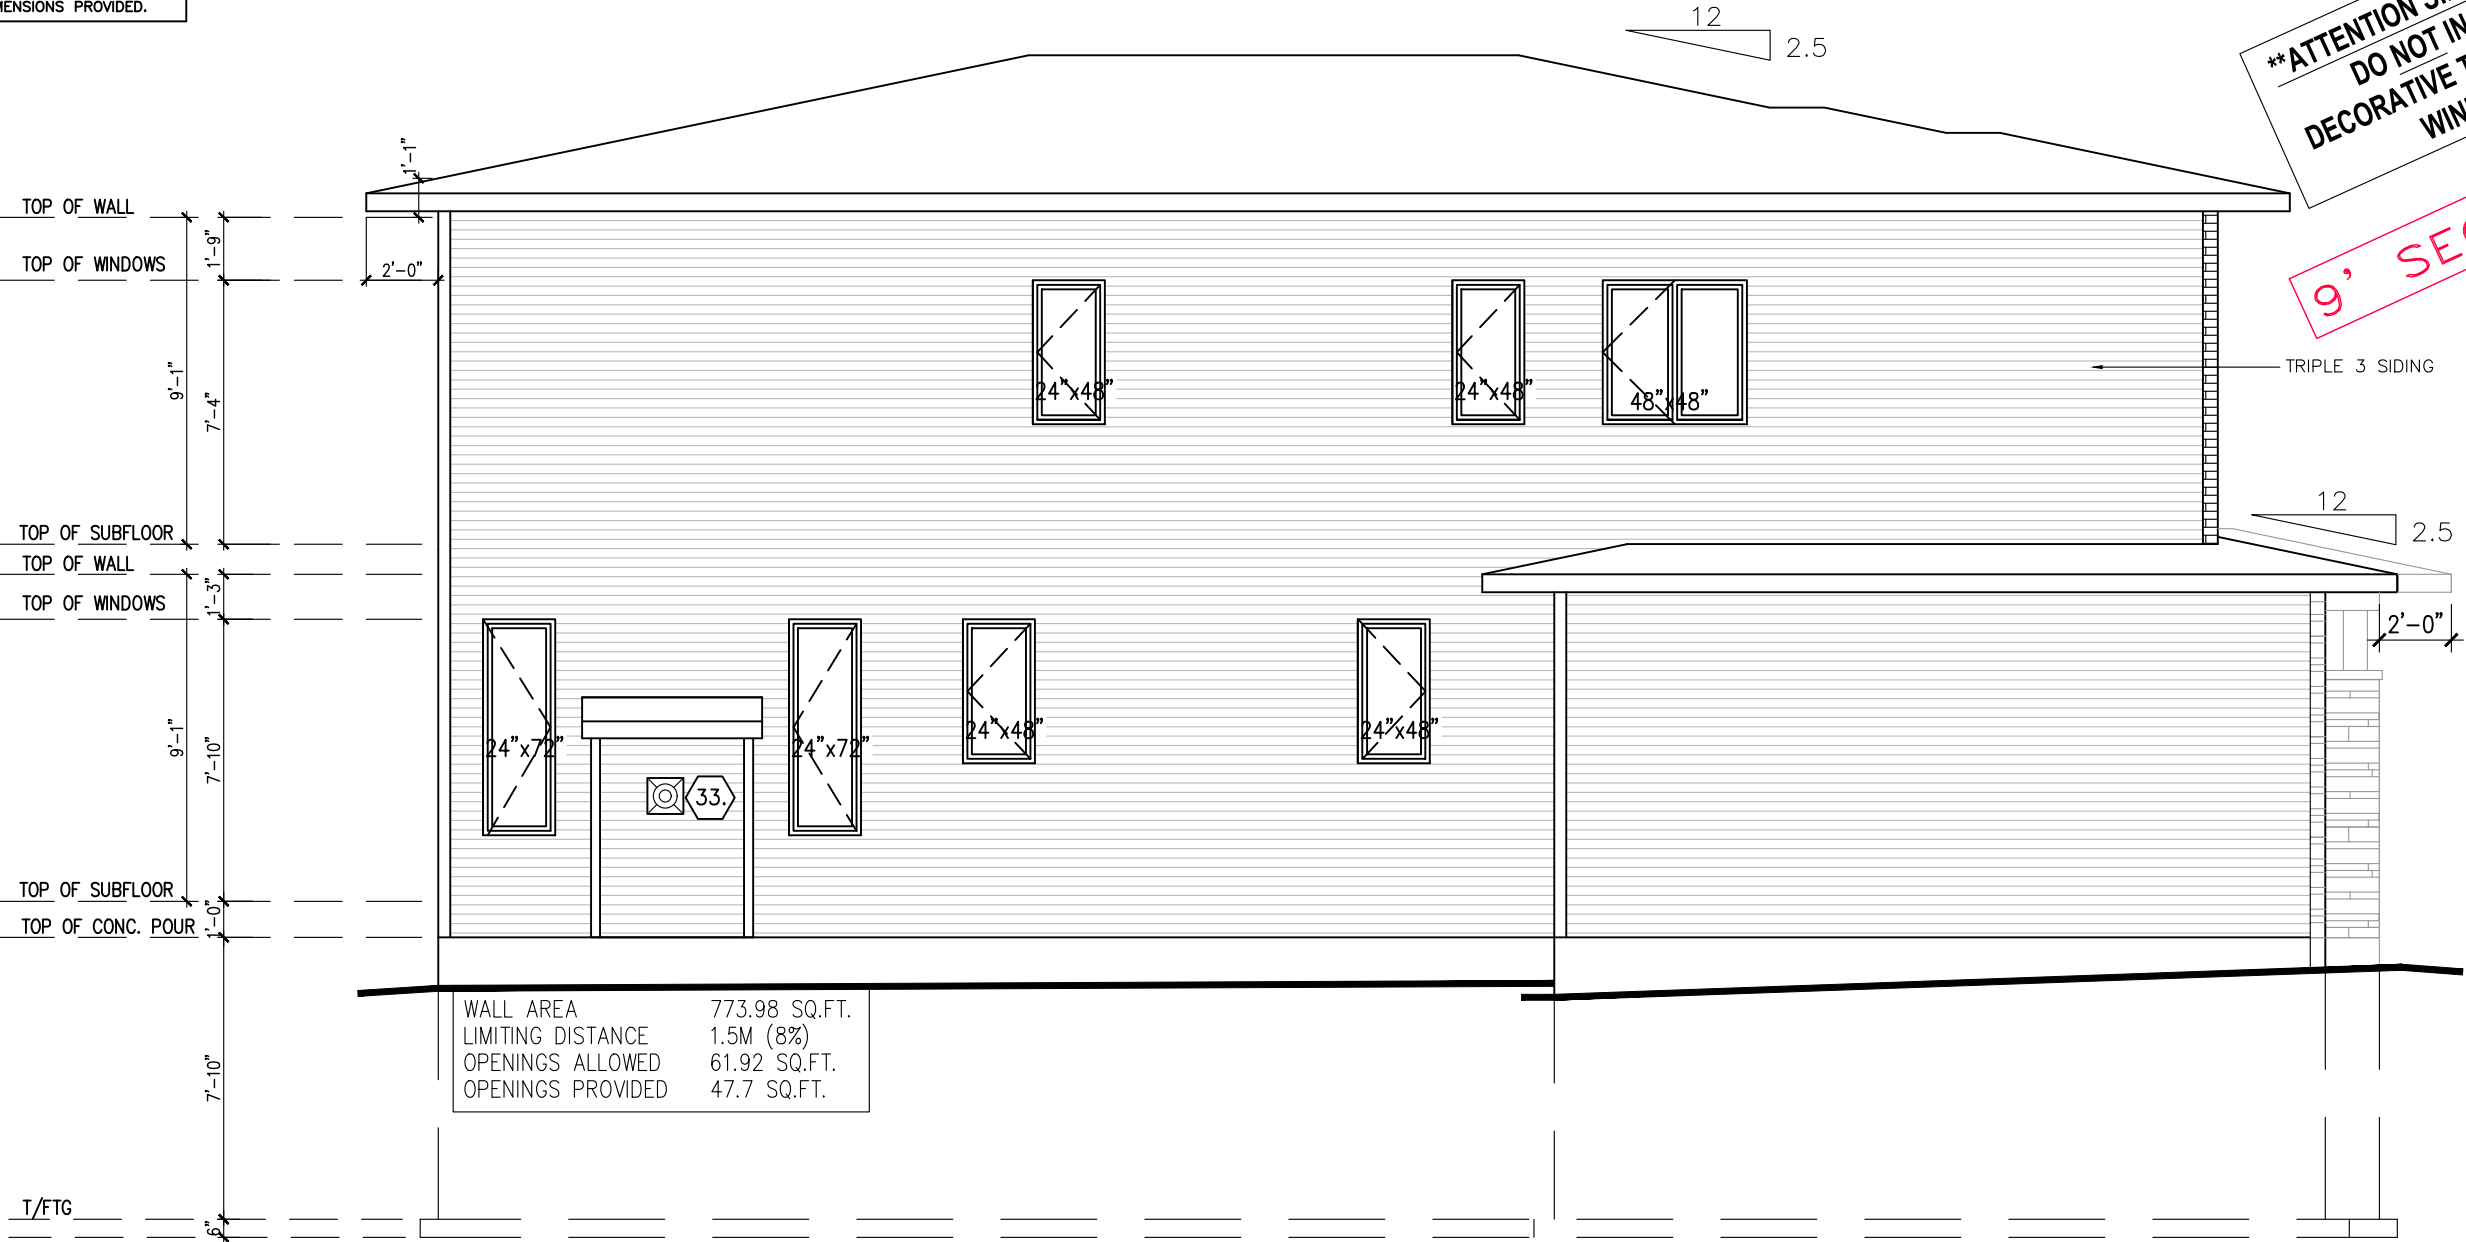

LEFT SIDE ELEVATION-M

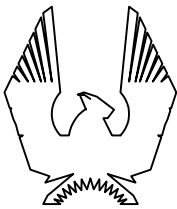

PHOENIX HOMES

MADISON - 2020

SITE: PATHWAYS

LOT NUMBER:

348

CIVIC ADDRESS:
621 MIKANA ROAD

9	DELETE GROUND FLOOR SHOWER	NOV 13 2024	SP
8	FINAL FOR SITE - REVISED - 9' SEC. FLR.	SEP 24 2024	SP
7	FINAL FOR SITE	JUL 29 2024	SP
6	BEP FOR SITE	JUL 25 2024	SP
5	FINAL FOR SITE PREP	FEB 23 2024	CB
4	FINAL BLACKLINES - REV	JAN 10 2024	CB
No.	Description	Date	By
REVISIONS			

footprint:	43-10
drawn by:	SP
date:	NOV/19
scale:	3/16"=1'-0"
sheet no:	6
D.C.L. - A10	8

CONTRACTOR MUST VERIFY ALL DIMENSIONS ON THE JOB AND REPORT ANY DISCREPANCY TO DCR/PHOENIX BEFORE PROCEEDING WITH THE WORK.
ALL DRAWINGS AND SPECIFICATIONS ARE INSTRUMENTS OF SERVICE AND THE PROPERTY OF THE DCR/PHOENIX WHICH MUST BE RETURNED AT THE COMPLETION OF THE WORK.
ALL DRAWINGS TO BE USED FOR CONSTRUCTION ONLY AFTER BUILDING PERMIT HAS BEEN ISSUED.
DO NOT SCALE DRAWINGS, USE DIMENSIONS PROVIDED.

****ATTENTION SIDING CREW****
DO NOT INSTALL
DECORATIVE TRIM AROUND
WINDOWS



RIGHT SIDE ELEVATION—M

9' SECOND FLOOR



MADISON — 2020

SITE: PATHWAYS

LOT NUMBER: 348

CIVIC ADDRESS:
621 MIKANA ROAD

9	DELETE GROUND FLOOR SHOWER	NOV 13 2024	SP
8	FINAL FOR SITE — REVISED — 9' SEC. FLR.	SEP 24 2024	SP
7	FINAL FOR SITE	JUL 29 2024	SP
6	BEP FOR SITE	JUL 25 2024	SP
5	FINAL FOR SITE PREP	FEB 23 2024	CB
4	FINAL BLACKLINES — REV	JAN 10 2024	CB
No.	Description	Date	By
REVISIONS			

footprint: 43—10


drawn by: SP

date: NOV/19

scale: 3/16"=1'—0"

sheet no:
D.C.L. — A10

7
8

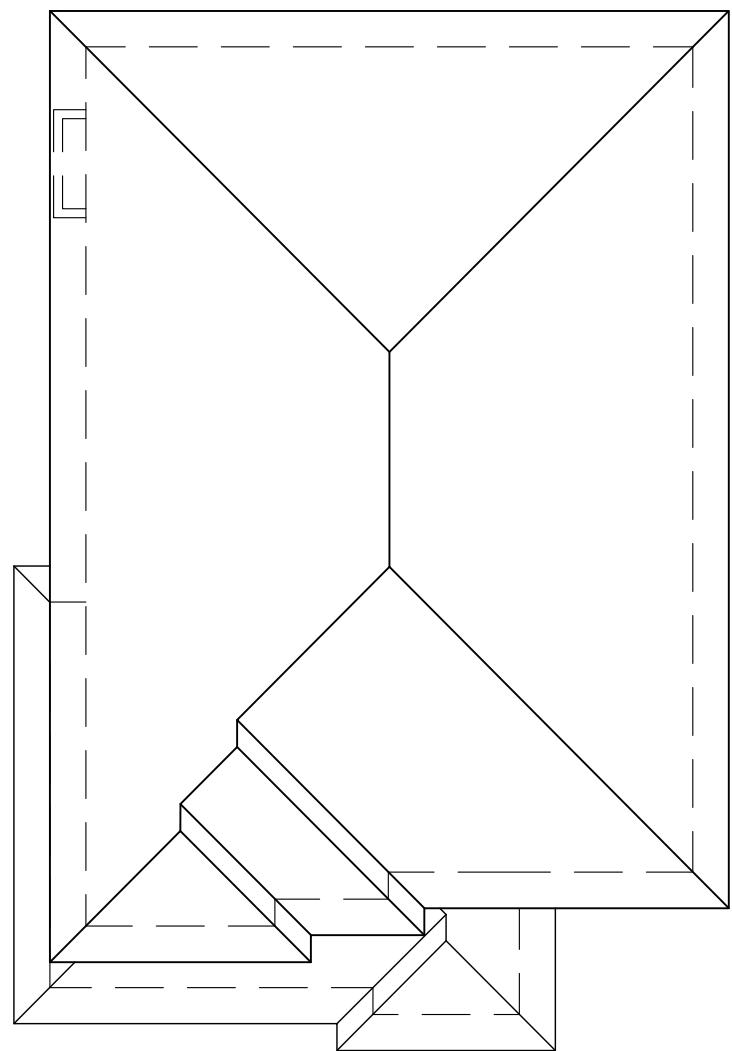

CONTRACTOR MUST VERIFY ALL DIMENSIONS ON THE JOB
AND REPORT ANY DISCREPANCY TO DCR/PHOENIX BEFORE
PROCEEDING WITH THE WORK.
ALL DRAWINGS AND SPECIFICATIONS ARE INSTRUMENTS OF
SERVICE AND THE PROPERTY OF THE DCR/PHOENIX WHICH
MUST BE RETURNED AT THE COMPLETION OF THE WORK.
ALL DRAWINGS TO BE USED FOR CONSTRUCTION ONLY
AFTER BUILDING PERMIT HAS BEEN ISSUED.
DO NOT SCALE DRAWINGS, USE DIMENSIONS PROVIDED.