


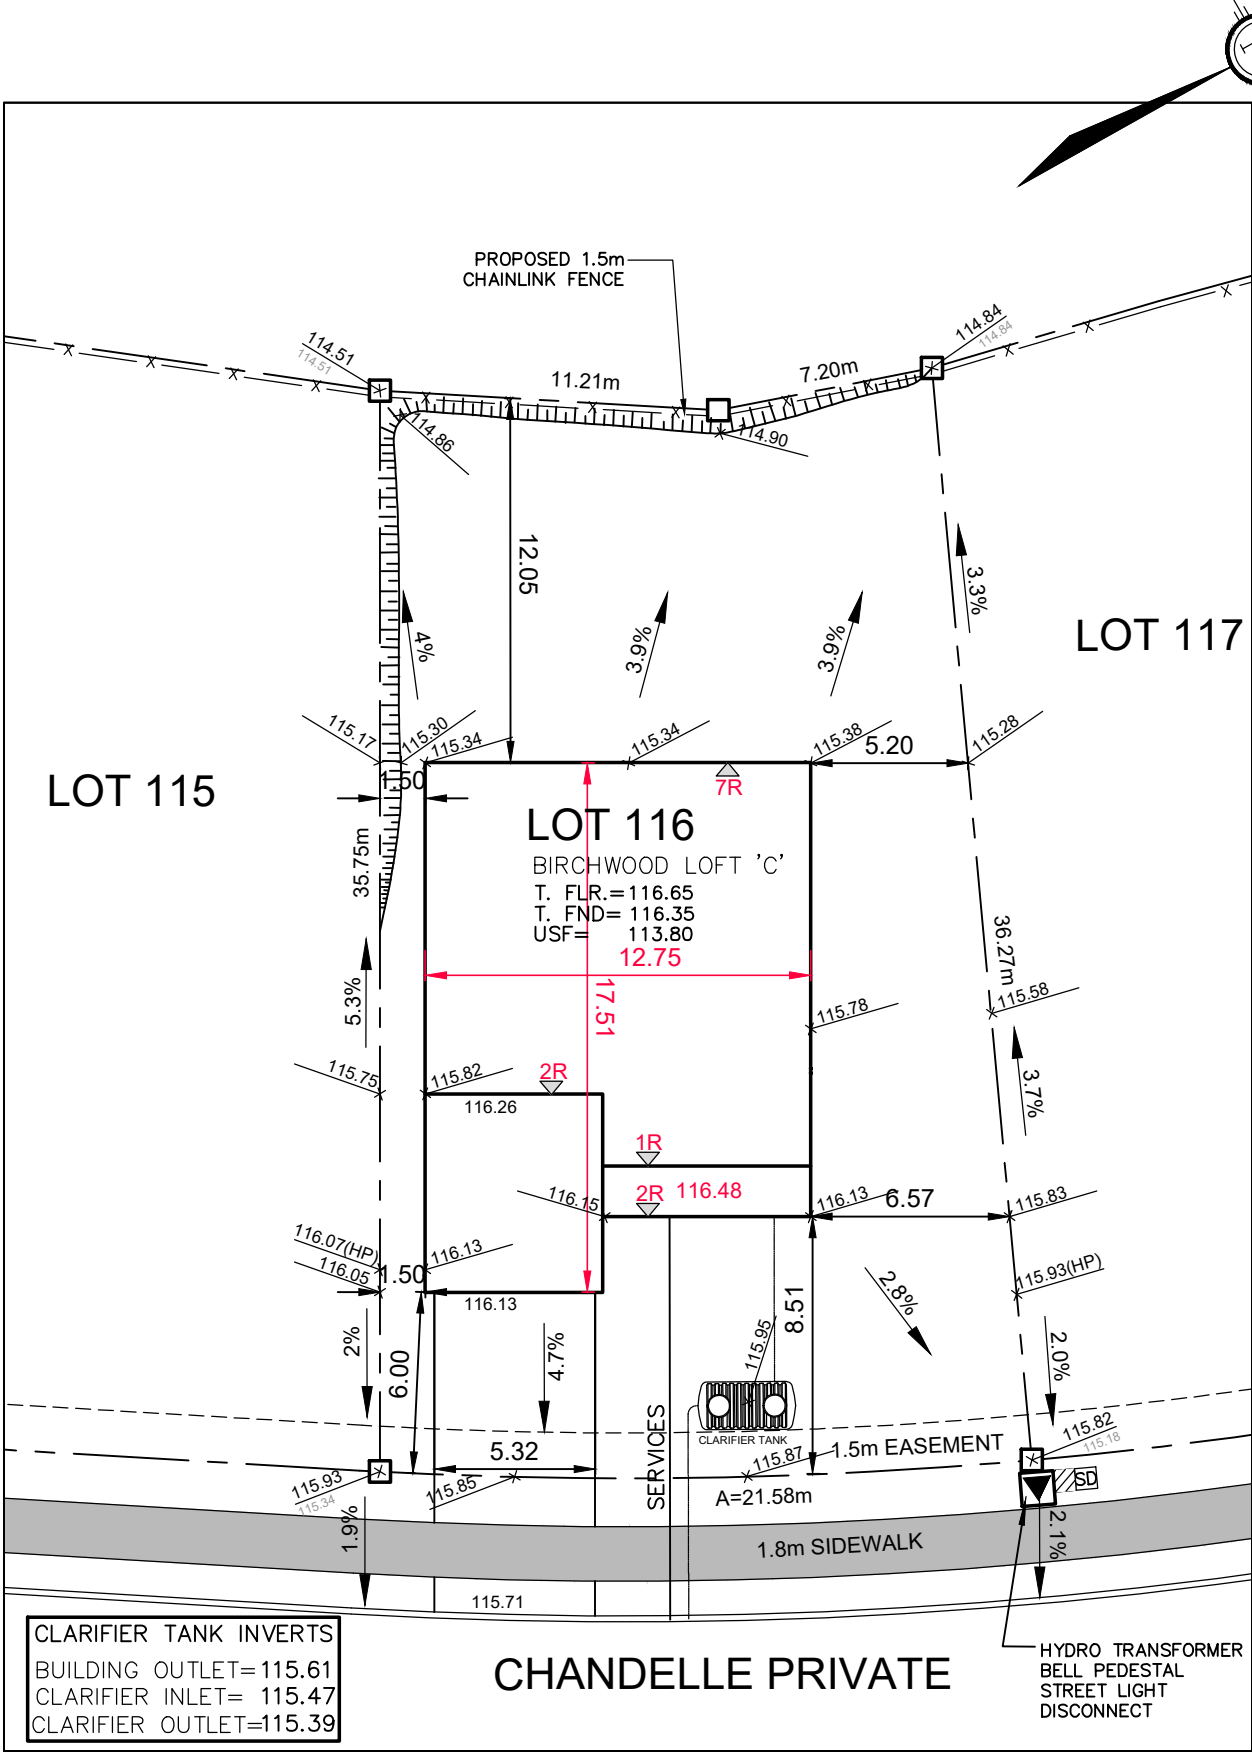

NOTE: HOUSE TYPE/GRADING HAVE NOT BEEN
FINALIZED - THIS PLAN SUBJECT TO FURTHER
CHANGES.

Owner/Applicant DCR/PHOENIX HOMES Telephone # <u>723-9227</u> Plan # <u>4M-1593</u> Project name: <u>DIAMONVIEW</u> Civic Address: <u>124 CHANDELLE PRIV.</u> House model: <u>BIRCHWOOD LOFT 'C'</u> Bldg. Ht. _____ m Lot coverage _____ % Scale <u>1:250</u> Sod Area _____ m² Asphalt Area _____ m² CHECKED/APPROVED BY: T.L.MAK ENG. AUG 9/24 SEP 30/24	 LOT 116 SITE/GRADING PLAN DIAMONVIEW PHASE 3 INDIVIDUAL LOT GRADING REVIEW SUMMARY FOR SITED HOUSE AS COMPARED WITH OVERALL SUBDIVISION PLAN NOTE: THIS PLAN IS NOT A SURVEY PLAN OR SUBDIVISION PLAN WITHIN THE MEANING OF PLANNING ACT. THIS PLAN IS FOR REFERENCE ONLY AND IS PRELIMINARY IN NATURE, ALL DIMENSIONS SHOWN ARE APPROXIMATE. E,O&E.
---	---