


STRATA: UPPER FLOOR  
FLOOR AREA: 621 ft<sup>2</sup>

FLOOR LAYOUT AND TILE  
PATTERN

JUN B8 UNIT 243 / CIVIC 605

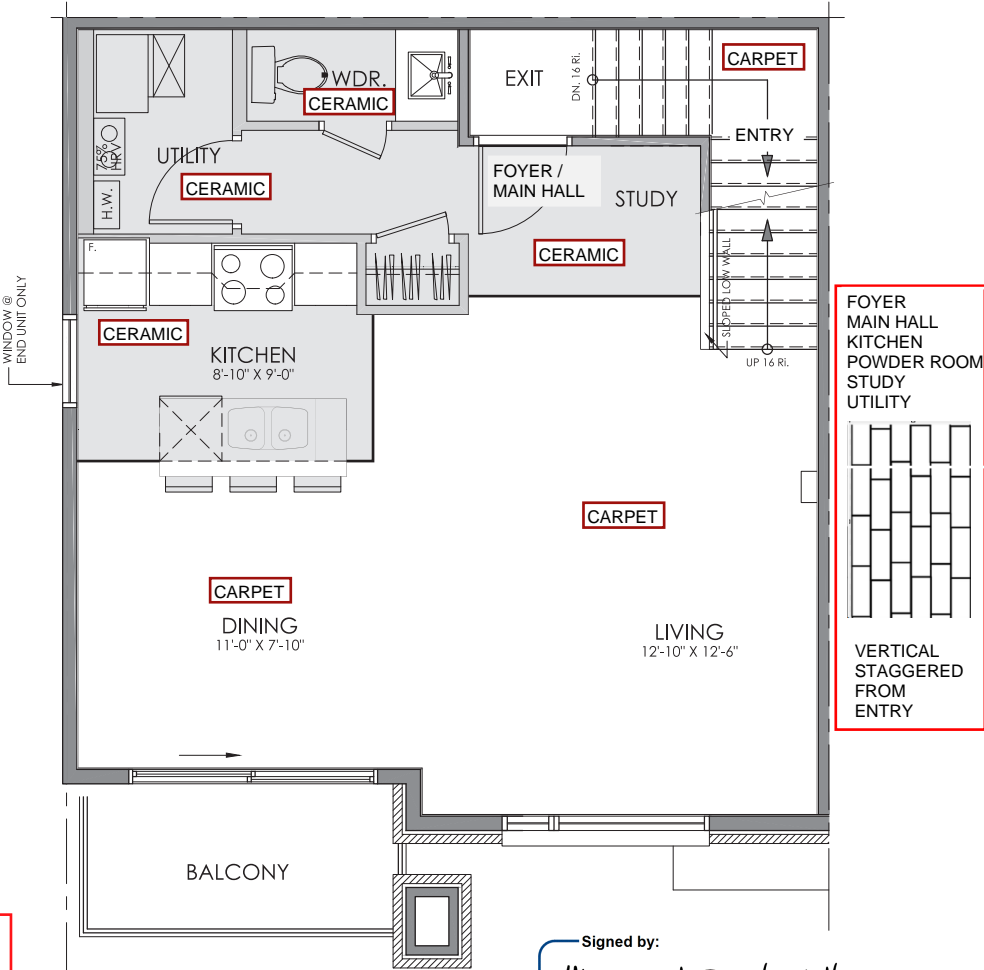

STRATA: MAIN FLOOR  
FLOOR AREA: 633 ft<sup>2</sup>

Signed by:  
*Winnejit Singh Rathor*  
DA8A5527006947D...

# Nuvo– upper unit

STANDARD CERAMIC LOCATION

\*Room dimensions may be reduced by service chases and bulkhead not shown. All floor plans are approximate dimensions. Specs and floor plans are subject to change without notice. Actual usable floor space may vary from stated floor area. E. & O.E.  
Note: Tile pattern dimensions are to be determined by Millwork Layout.

