

RAYWAL CABINETS

JUN BLD 8 - UNIT 141 - CIVIC 615

AS BUILT - MARCH 18 2025

NUVO - KITCHEN - LOWER UNIT


DOOR STYLE: MODENA
FINISH: COBBLESTONE
SPECIES: MAPLE
BOX INTERIOR: WHITE MELAMINE
DRAWER FRONT: FLAT
DRAWER BOX: METABOX
HINGE: STANDARD

HARDWARE: 116

COUNTERTOP: F7735-58

DWKIT X 1
VENT BOX X 1 (12"W x 9"D x 10 3/4")

KICKB96 X 2
SCRIBE96 X 3

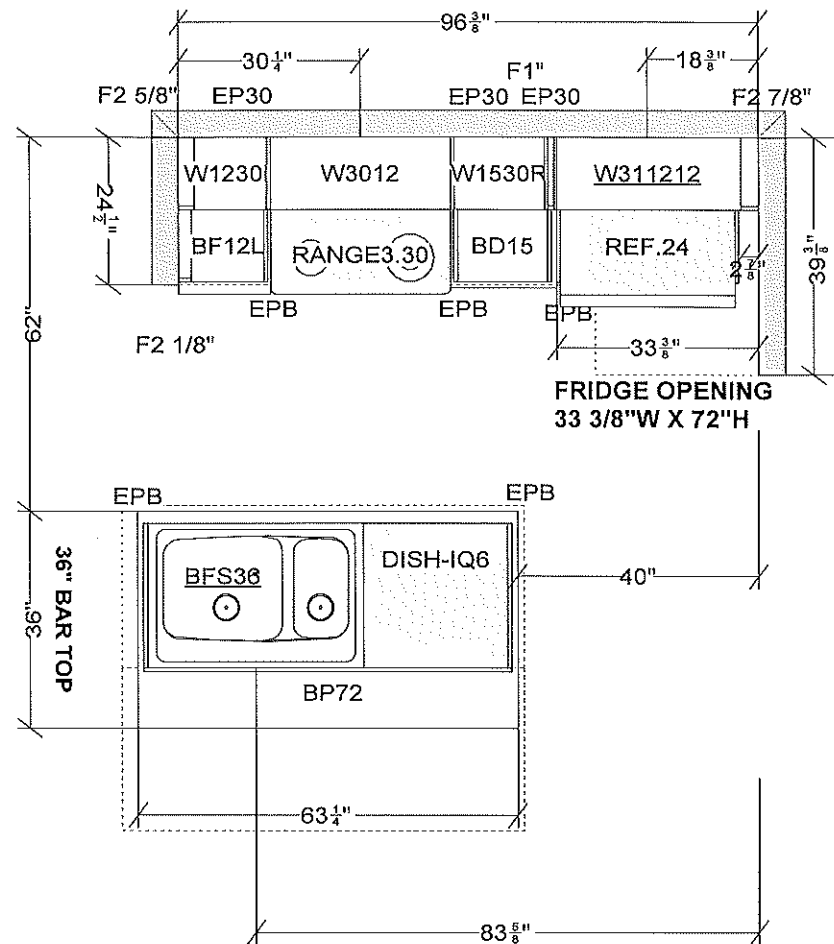

All dimensions size designations given are subject to verification on job site and adjustment to fit job conditions.

2020

This is an original design and must not be released or copied unless applicable fee has been paid or job order placed.


Designed: 3/18/2025
Printed: 3/18/2025

NUVO- LOWER UNIT (KITCHEN)

All

Drawing #: 1

Scale : 0 3/8" 1'

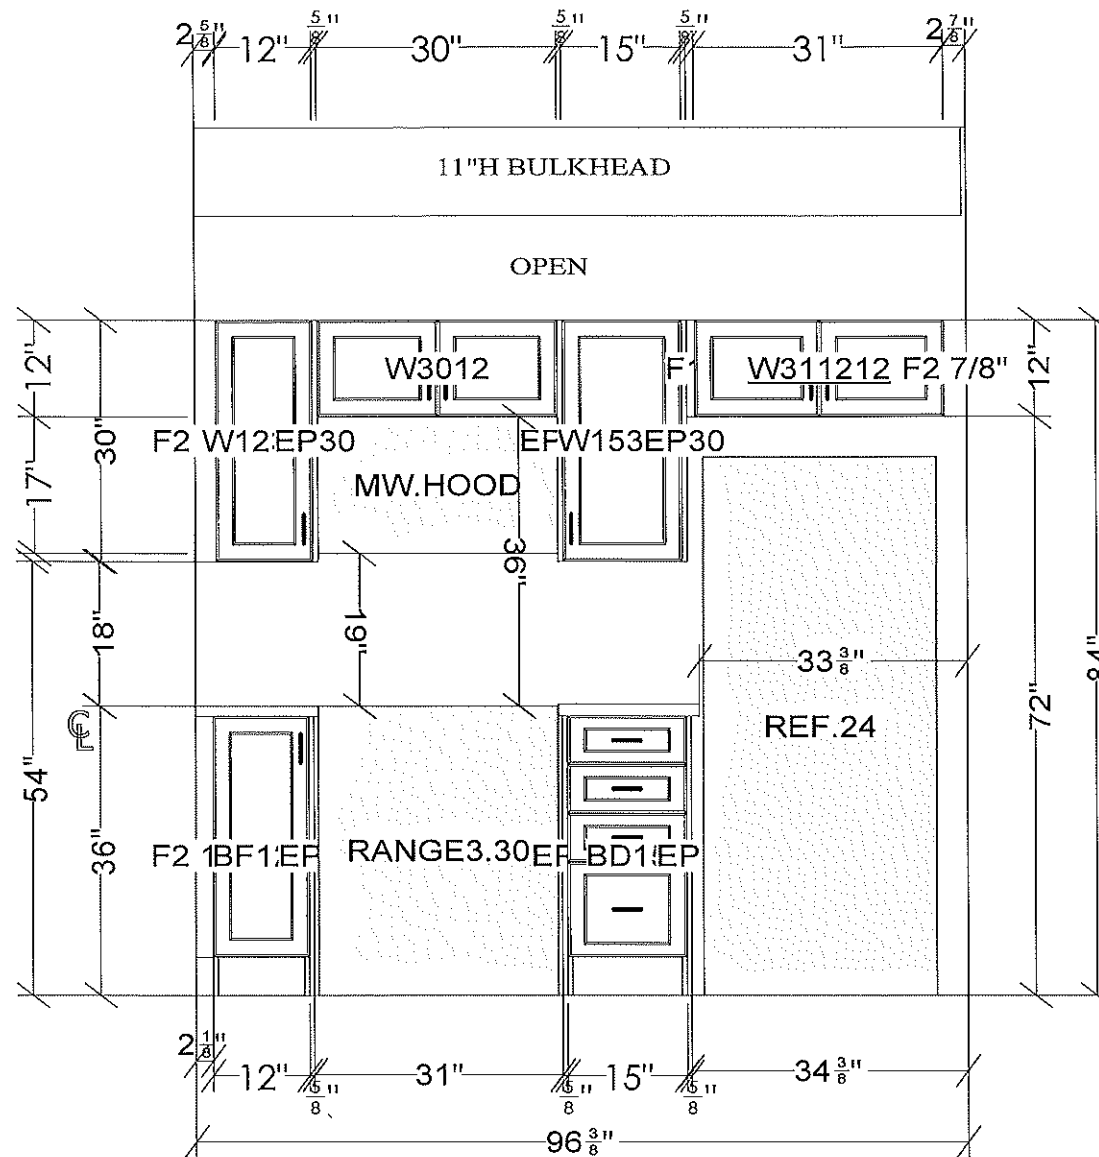


NO LIGHT VALANCE / NO CROWN/BUILD-UP

All dimensions .size designations given are subject to verification on job site and adjustment to fit job conditions.

2020

This is an original design and must not be released or copied unless applicable fee has been paid or job order placed.

Designed: 3/18/2025
Printed: 3/18/2025

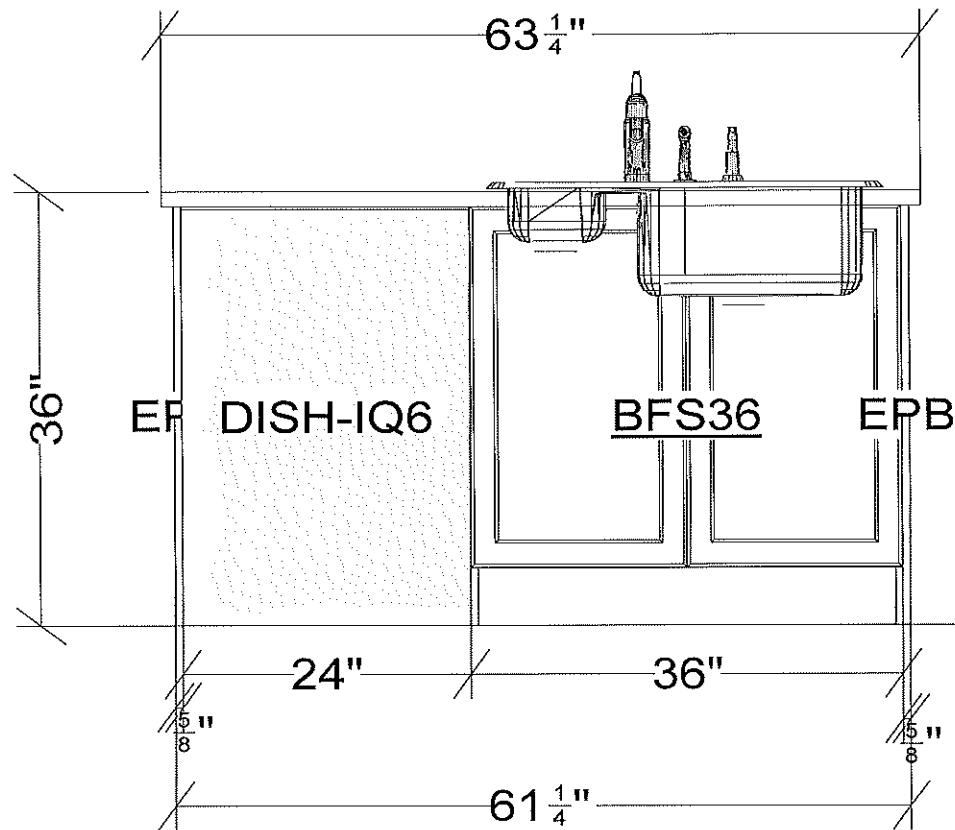

All dimensions size designations given are subject to verification on job site and adjustment to fit job conditions.

2020

This is an original design and must not be released or copied unless applicable fee has been paid or job order placed.

Designed: 3/18/2025
Printed: 3/18/2025

RAYWAL CABINETS

JUN BLD 8 - UNIT 141 - CIVIC 615


AS BUILT - MARCH 18 2025

NUVO - POWDER ROOM - LOWER UNIT

DOOR STYLE: MODENA
FINISH: COBBLESTONE
SPECIES: MAPLE
BOX INTERIOR: WHITE MELAMINE
HINGE: STANDARD

HARDWARE: 116


COUNTERTOP: F7735-58

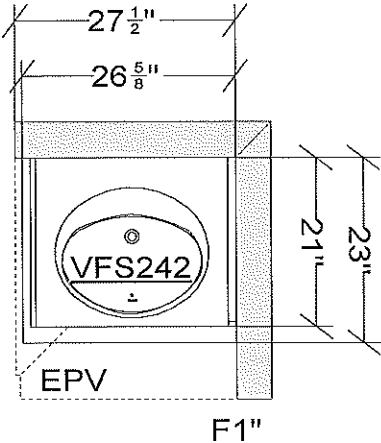

KICKB96 X 1
SCRIBE96 X 1

All dimensions _size designations given are subject to verification on job site and adjustment to fit job conditions.	2020	This is an original design and must not be released or copied unless applicable fee has been paid or job order placed.	Designed: 3/18/2025 Printed: 3/18/2025	
NUVO - LOWER UNIT (POWDER ROOM)		All	Drawing #: 1	Scale : 0 1/2" 1'

POWDER ROOM

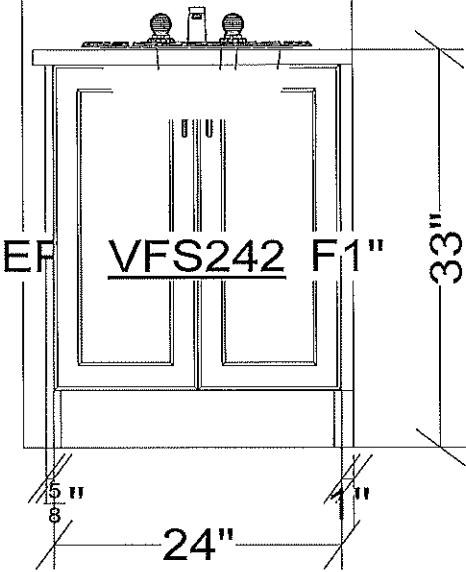

All dimensions size designations given are subject to verification on job site and adjustment to fit job conditions.	2020	This is an original design and must not be released or copied unless applicable fee has been paid or job order placed.	Designed: 3/18/2025 Printed: 3/18/2025	
NUVO - LOWER UNIT (POWDER ROOM)	El 1	Drawing #: 1	Scale : 0 3/4" 1'	

RAYWAL CABINETS


JUN BLD 8 - UNIT 141 - CIVIC 615
AS BUILT - MARCH 12 2025

NUVO - MAIN - LOWER UNIT


DOOR STYLE: RETRO
FINISH: DENIM
SPECIES: THERMOFOIL
BOX INTERIOR: WHITE MELAMINE
HINGE: STANDARD

HARDWARE: 116

COUNTERTOP: F66314-58

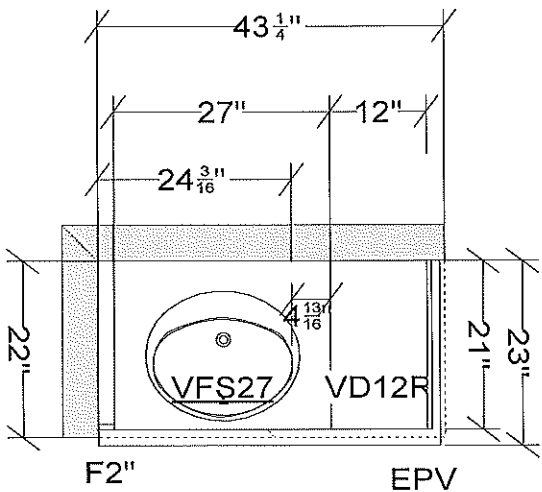


INSTALL 54" OVER TOILET

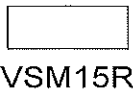

KICKB96 X 1
SCRIBE96 X 1

All dimensions .size designations given are subject to verification on job site and adjustment to fit job conditions.	2020	This is an original design and must not be released or copied unless applicable fee has been paid or job order placed.	Designed: 3/18/2025 Printed: 3/18/2025	
			NUVO- LOWER UNIT (MAIN)	All Drawing #: 1 Scale : 0 1/2" 1'

MAIN

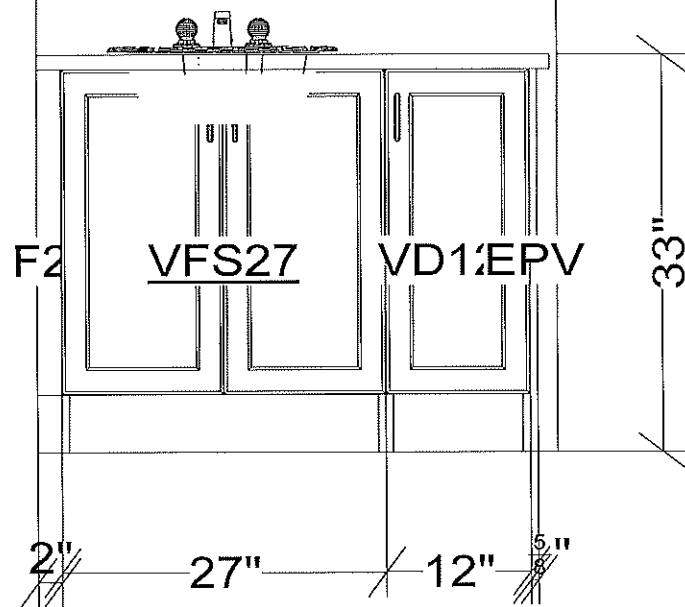

All dimensions size designations given are subject to verification on job site and adjustment to fit job conditions.

2020

This is an original design and must not be released or copied unless applicable fee has been paid or job order placed.

Designed: 3/18/2025
Printed: 3/18/2025

RAYWAL CABINETS

JUN BLD 8 - UNIT 141 - CIVIC 615

AS BUILT - MARCH 18 2025



NUVO - ENSUITE - LOWER UNIT

DOOR STYLE: RETRO
FINISH: IRON
SPECIES: THERMOFIL
BOX INTERIOR: WHITE MELAMINE
HINGE: STANDARD

HARDWARE: 116

COUNTERTOP: W4925K-07


INSTALL 54" OVER TOILET

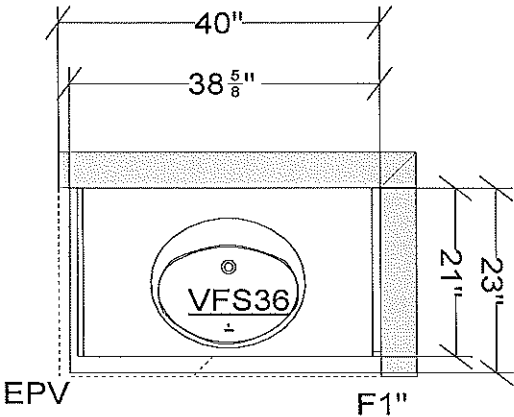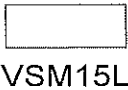

KICKB96 X 1
SCRIBE96 X 1

All dimensions size designations given are subject to verification on job site and adjustment to fit job conditions.	2020	This is an original design and must not be released or copied unless applicable fee has been paid or job order placed.	Designed: 3/18/2025 Printed: 3/18/2025	
			NUVO- LOWER UNIT (ENSUITE)	All Drawing #: 1 Scale : 0 1/2" 1'

ENSUITE

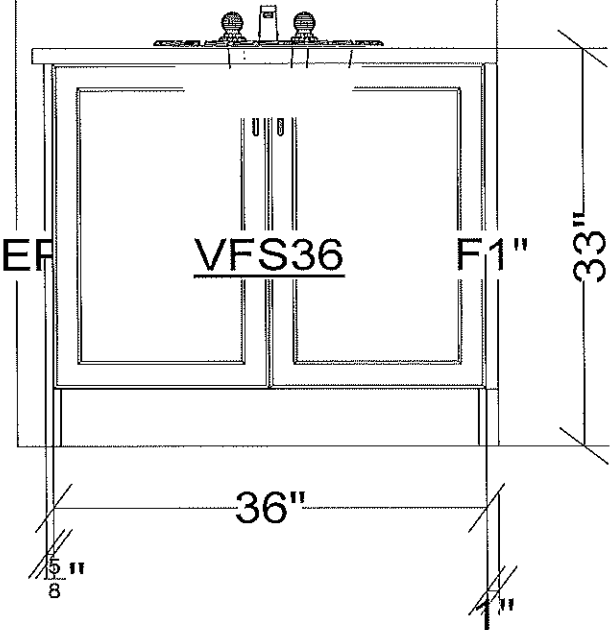

All dimensions size designations given are subject to verification on job site and adjustment to fit job conditions.

2020

This is an original design and must not be released or copied unless applicable fee has been paid or job order placed.

Designed: 3/18/2025
Printed: 3/18/2025