

RAYWAL CABINETS

JUN BLD 8 - UNIT 143 - CIVIC 607

AS BUILT - MARCH 12 2025

NUVO - KITCHEN - LOWER UNIT


DOOR STYLE: MANCINI
FINISH: ALGONQUIN
SPECIES: MELAMINE
BOX INTERIOR: WHITE MELAMINE
DRAWER FRONT: FLAT
DRAWER BOX: METABOX
HINGE: STANDARD

HARDWARE:140

COUNTERTOP: F6697-46

DWKIT X 1
VENT BOX X 1 (12"W x 9"D x 10 3/4")

KICKB96 X 2
SCRIBE96 X 3

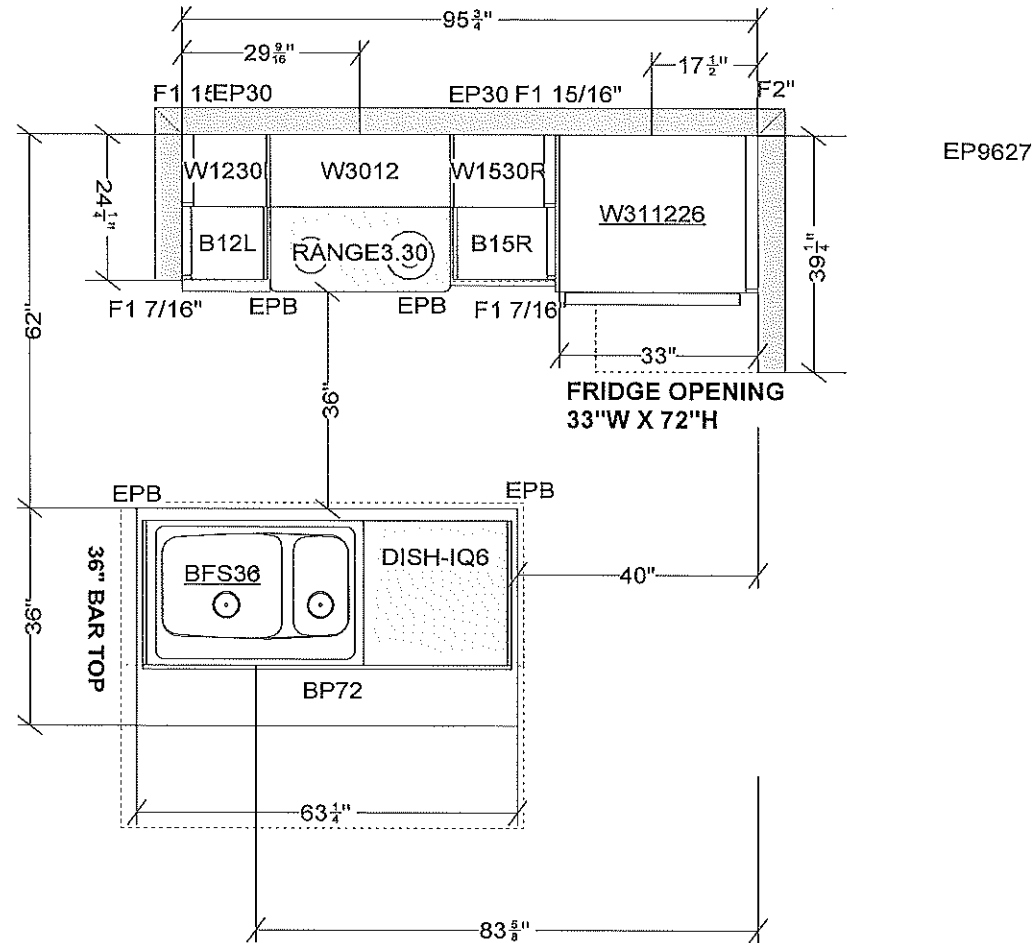


All dimensions and size designations given are subject to verification on job site and adjustment to fit job conditions.

2020

This is an original design and must not be released or copied unless applicable fee has been paid or job order placed.

Designed: 3/12/2025
Printed: 3/18/2025

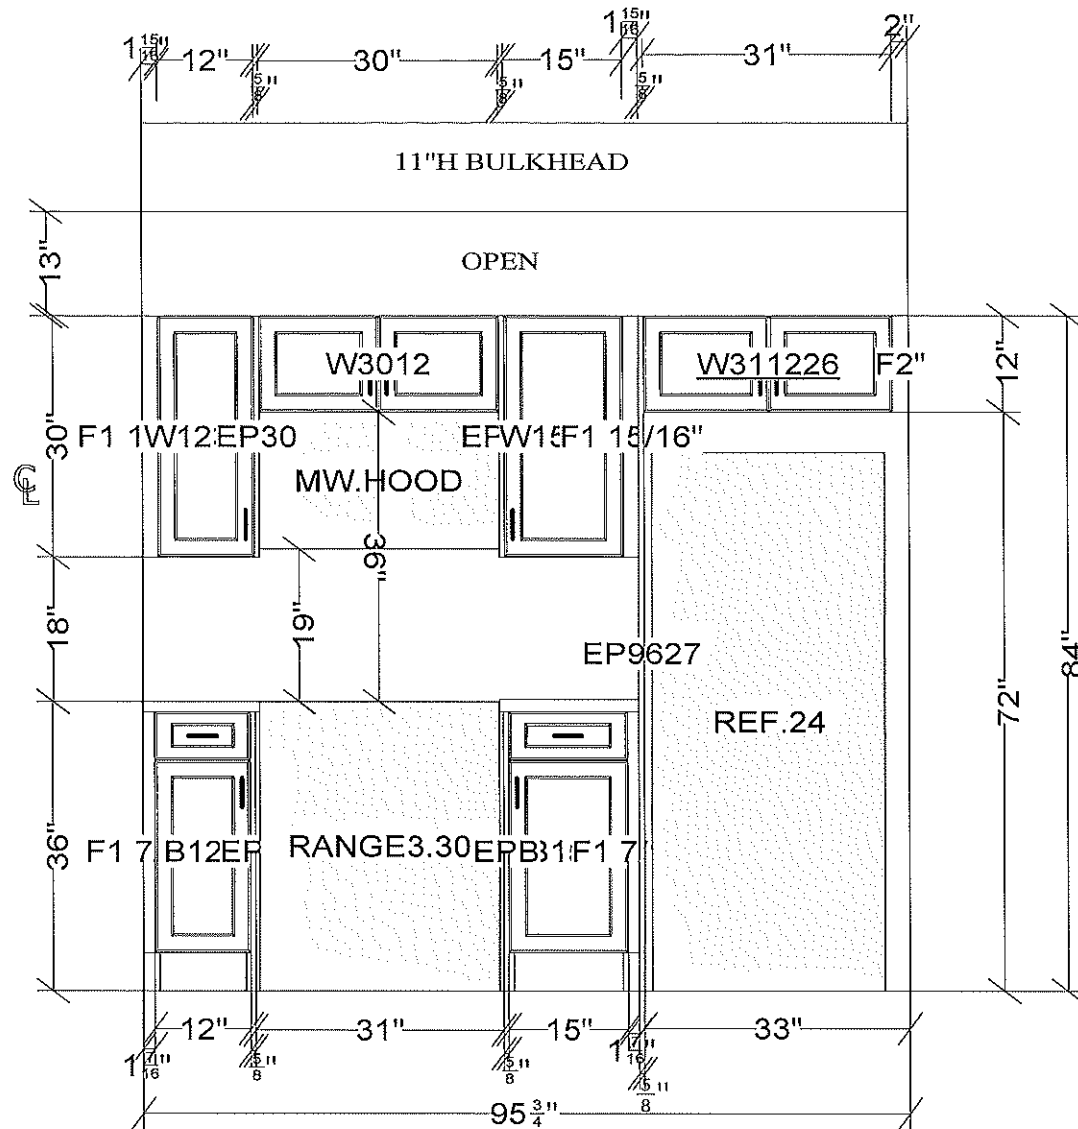

NO LIGHT VALANCE / NO CROWN/BUILD-UP

All dimensions size designations given are subject to verification on job site and adjustment to fit job conditions.

2020

This is an original design and must not be released or copied unless applicable fee has been paid or job order placed.


Designed: 3/12/2025
Printed: 3/18/2025

NUVO- LOWER UNIT (KITCHEN)

EI 1

Drawing #: 1

Scale : 0 1/2" 1'

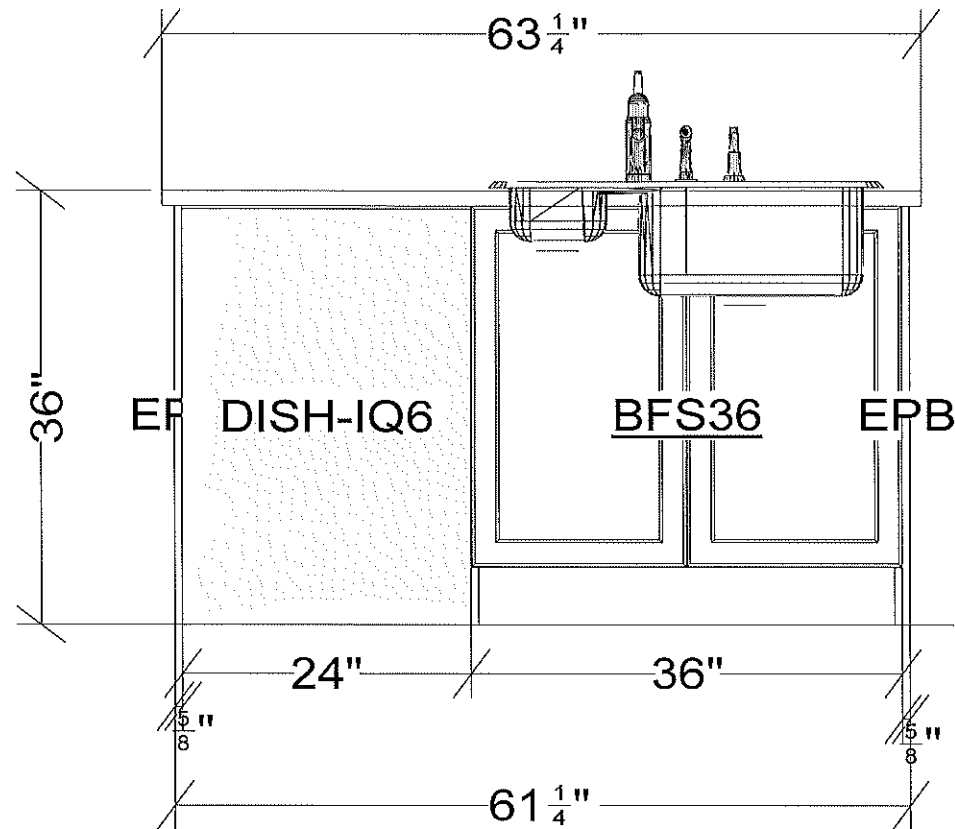

All dimensions and size designations given are subject to verification on job site and adjustment to fit job conditions.

2020

This is an original design and must not be released or copied unless applicable fee has been paid or job order placed.

Designed: 3/12/2025
Printed: 3/18/2025

RAYWAL CABINETS

JUN BLD 8 - UNIT 143 - CIVIC 607


AS BUILT - MARCH 12 2025

NUVO - POWDER ROOM - LOWER UNIT

DOOR STYLE: MANCINI
FINISH: LIMESTONE
SPECIES: MELAMINE
BOX INTERIOR: WHITE MELAMINE
HINGE: STANDARD

HARDWARE: 117 - DO NOT DRILL


COUNTERTOP: W4925K-07

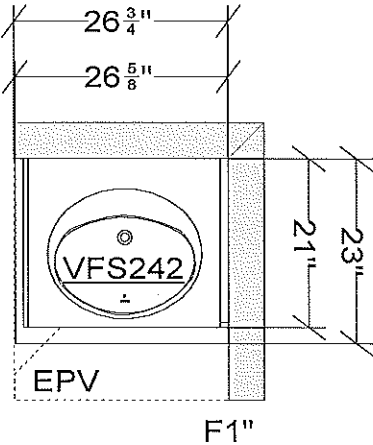

KICKB96 X 1
SCRIBE96 X 1

All dimensions _size designations given are subject to verification on job site and adjustment to fit job conditions.	2020	This is an original design and must not be released or copied unless applicable fee has been paid or job order placed.	Designed: 3/12/2025 Printed: 3/12/2025	
NUVO - LOWER UNIT (POWDER ROOM)		All	Drawing #: 1	Scale : 0 1/2" 1'

POWDER ROOM

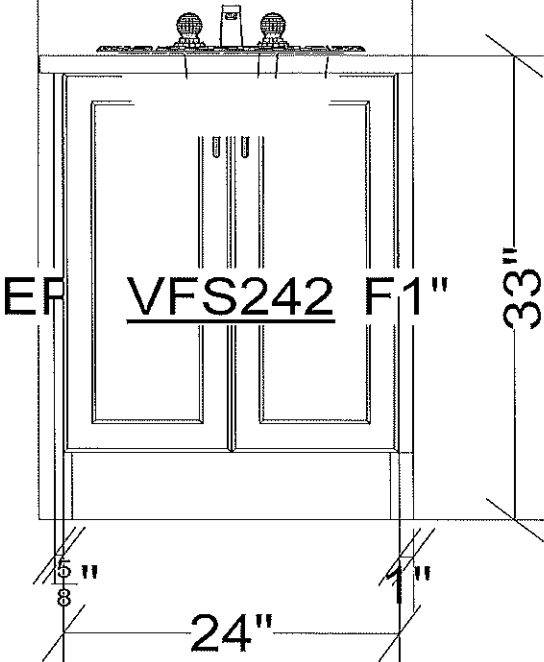

All dimensions size designations given are subject to verification on job site and adjustment to fit job conditions.	2020	This is an original design and must not be released or copied unless applicable fee has been paid or job order placed.	Designed: 3/12/2025 Printed: 3/12/2025
NUVO - LOWER UNIT (POWDER ROOM)	El 1	Drawing #: 1	Scale : 0 7/8" 1'

RAYWAL CABINETS

JUN BLD 8 - UNIT 143 - CIVIC 607

AS BUILT - MARCH 12 2025

NUVO - ENSUITE - LOWER UNIT

DOOR STYLE: MANCINI
FINISH: INK
SPECIES: MELAMINE
BOX INTERIOR: WHITE MELAMINE
HINGE: STANDARD


HARDWARE:144

COUNTERTOP: F6314-58

INSTALL 54" OVER TOILET



VSM15L

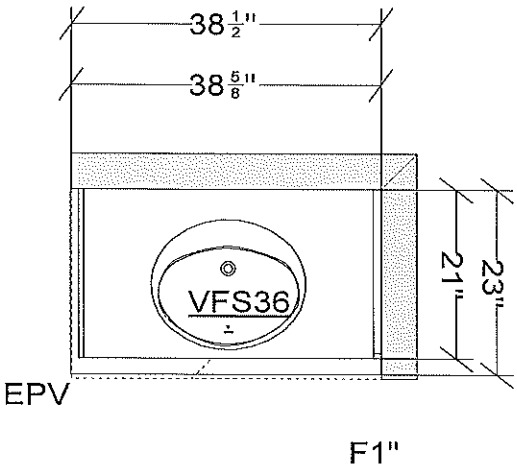

KICKB96 X 1
SCRIBE96 X 1


All dimensions _size designations
given are subject to verification on
job site and adjustment to fit job
conditions.

2020

This is an original design and must
not be released or copied unless
applicable fee has been paid or job
order placed.

Designed: 3/12/2025
Printed: 3/12/2025

ENSUITE

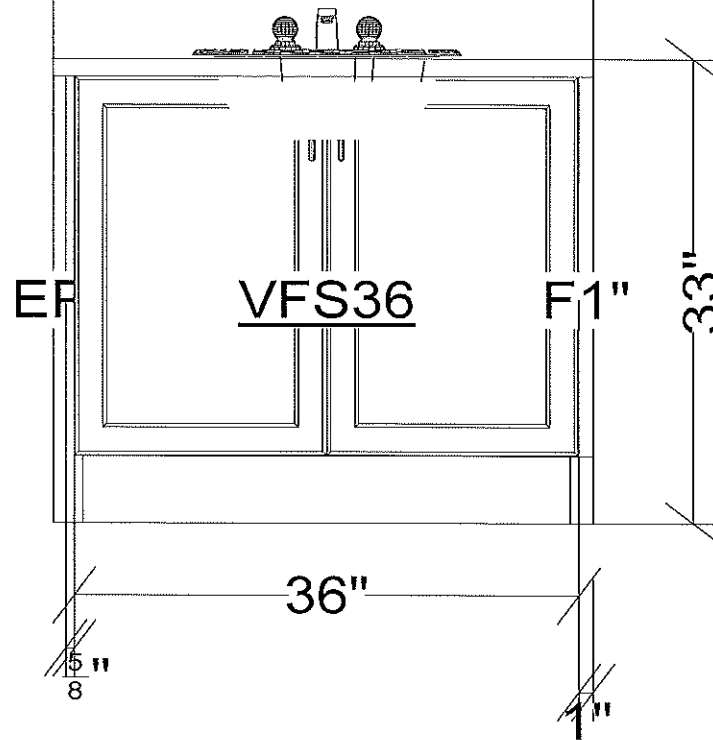

All dimensions and size designations given are subject to verification on job site and adjustment to fit job conditions.	2020	This is an original design and must not be released or copied unless applicable fee has been paid or job order placed.	Designed: 3/12/2025 Printed: 3/12/2025
NUVO- LOWER UNIT (ENSUITE)	El 1	Drawing #: 1	Scale : 0 7/8" 1'

RAYWAL CABINETS


JUN BLD 8 - UNIT 143 - CIVIC 607
AS BUILT - MARCH 12 2025

NUVO - MAIN - LOWER UNIT


DOOR STYLE: MANCINI
FINISH: INK
SPECIES: MELAMINE
BOX INTERIOR: WHITE MELAMINE
HINGE: STANDARD

HARDWARE:124

COUNTERTOP: A344CA

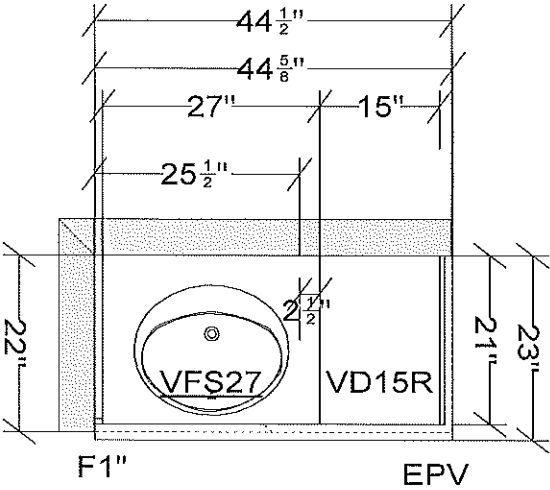

INSTALL 54" OVER TOILET

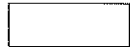

VSM15R

KICKB96 X 1
SCRIBE96 X 1

All dimensions and size designations given are subject to verification on job site and adjustment to fit job conditions.

2020

This is an original design and must not be released or copied unless applicable fee has been paid or job order placed.

Designed: 3/12/2025
Printed: 3/18/2025


NUVO- LOWER UNIT (MAIN)

All

Drawing #: 1

Scale : 0 1/2" 1'

MAIN

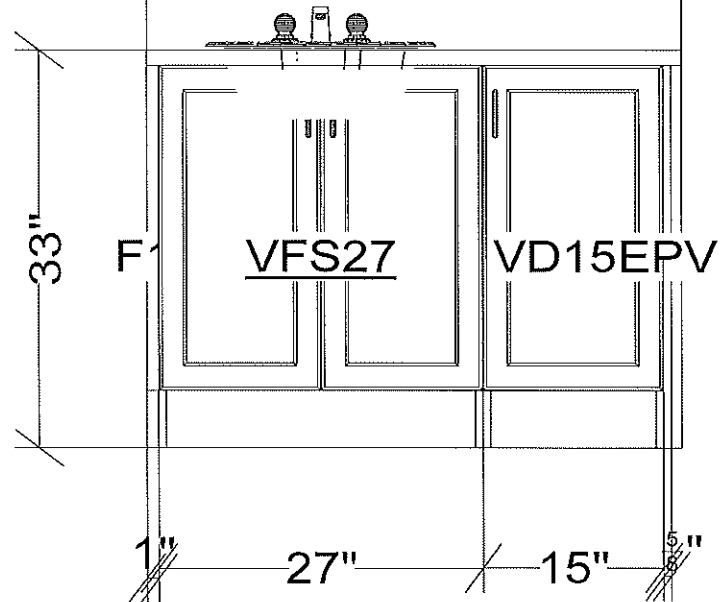

All dimensions size designations given are subject to verification on job site and adjustment to fit job conditions.

2020

This is an original design and must not be released or copied unless applicable fee has been paid or job order placed.

Designed: 3/12/2025
Printed: 3/18/2025

NUVO- LOWER UNIT (MAIN)

EI 1

Drawing #: 1

Scale : 0 3/4" 1'