

RAYWAL CABINETS

JUN BLD 8 - UNIT 144 - CIVIC 601

AS BUILT - MARCH 18 2025

NUVO - KITCHEN - LOWER UNIT


DOOR STYLE: MODENA
FINISH: OLIVE GREEN
SPECIES: MAPLE
BOX INTERIOR: WHITE MELAMINE
DRAWER FRONT: FLAT
DRAWER BOX: METABOX
HINGE: STANDARD

HARDWARE:137

COUNTERTOP: F6698-46

DWKIT X 1
VENT BOX X 1 (12"W x 9"D x 10 3/4")
VENT BOX X 1 (30"W x 12"D x 14"H)

KICKB96 X 2
SCRIBE96 X 3

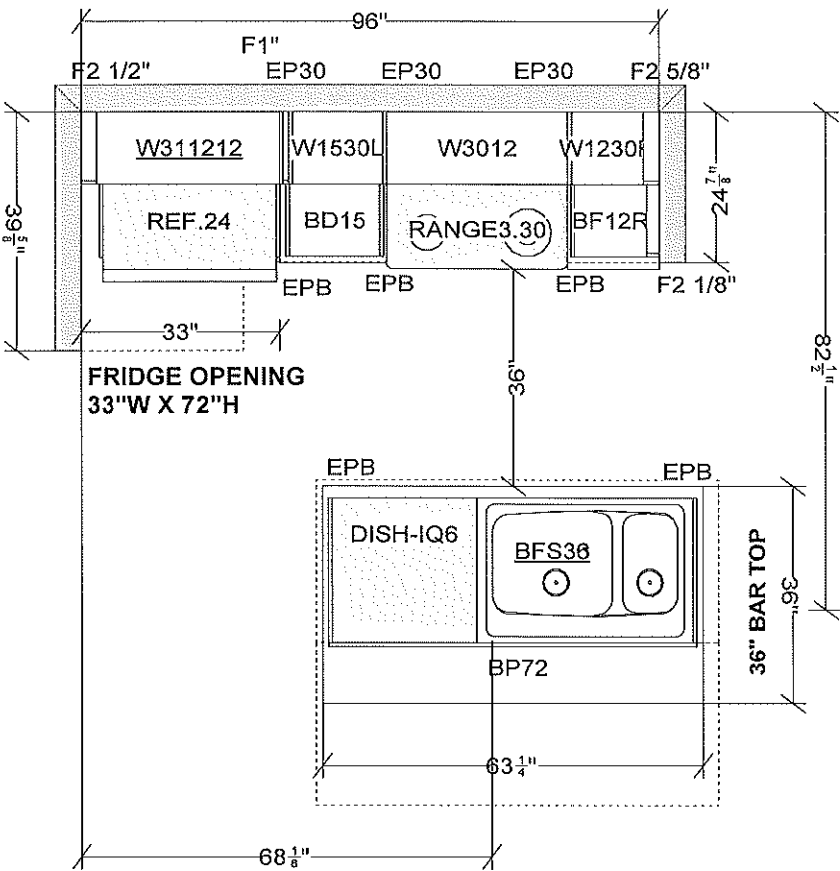


All dimensions _size designations given are subject to verification on job site and adjustment to fit job conditions.

2020

This is an original design and must not be released or copied unless applicable fee has been paid or job order placed.

Designed: 3/19/2025
Printed: 3/19/2025

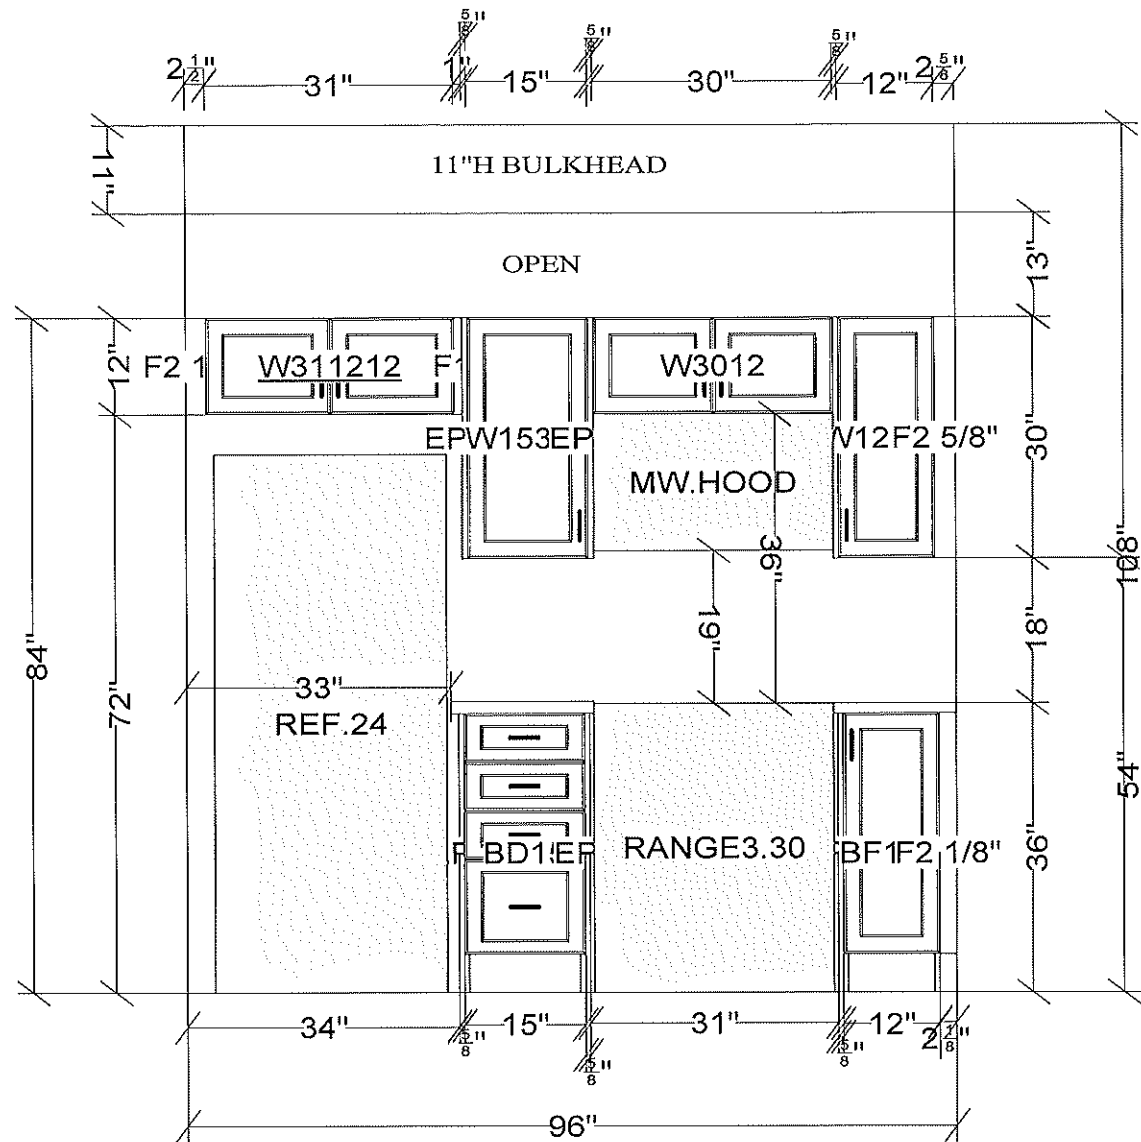


NO LIGHT VALANCE / NO CROWN/BUILD-UP

All dimensions size designations given are subject to verification on job site and adjustment to fit job conditions.

2020

This is an original design and must not be released or copied unless applicable fee has been paid or job order placed.

Designed: 3/19/2025
Printed: 3/19/2025

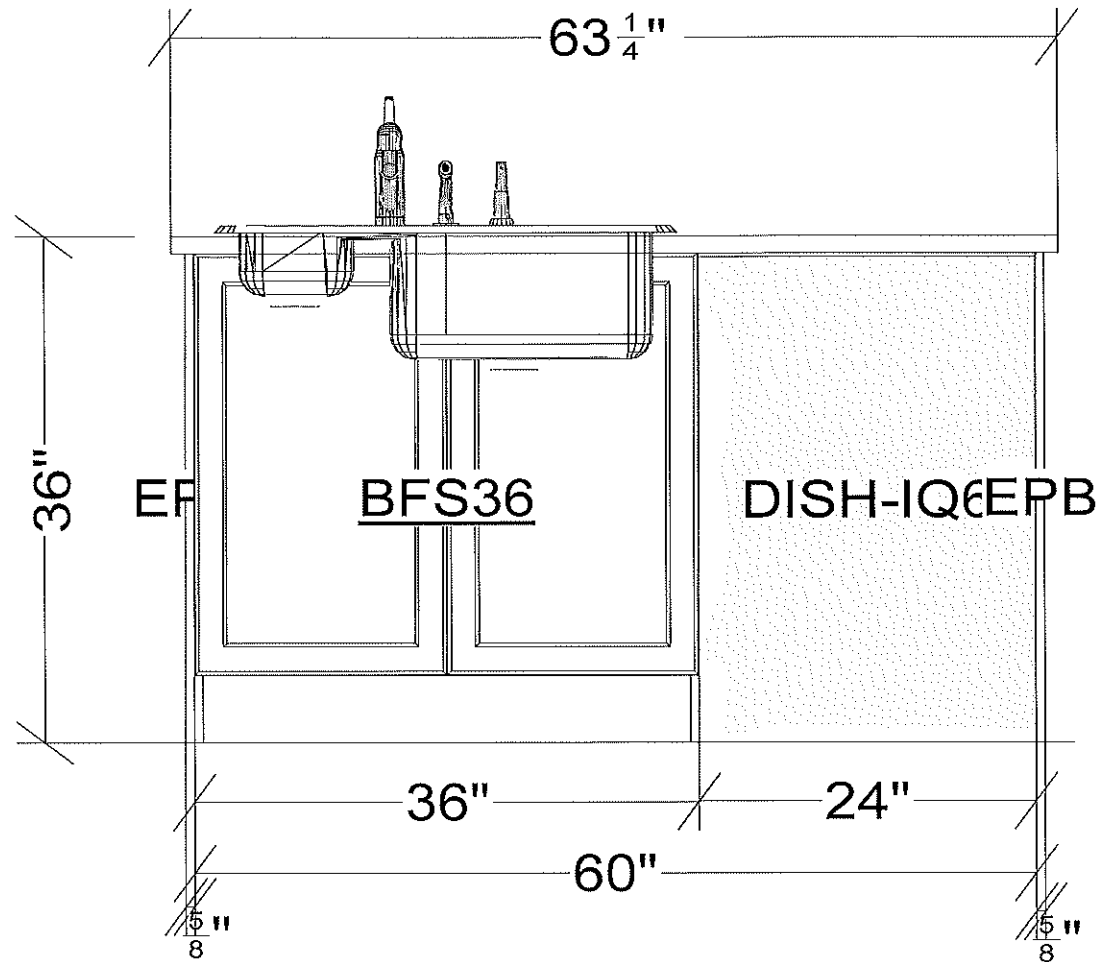

All dimensions size designations given are subject to verification on job site and adjustment to fit job conditions.

2020

This is an original design and must not be released or copied unless applicable fee has been paid or job order placed.

Designed: 3/19/2025
Printed: 3/19/2025

RAYWAL CABINETS

JUN BLD 8 - UNIT 144 - CIVIC 601


AS BUILT - MARCH 18 2025

NUVO - POWDER ROOM - LOWER UNIT

DOOR STYLE: MODENA
FINISH: OLIVE GREEN
SPECIES: MAPLE
BOX INTERIOR: WHITE MELAMINE
HINGE: STANDARD

HARDWARE:137


COUNTERTOP: F6698-46

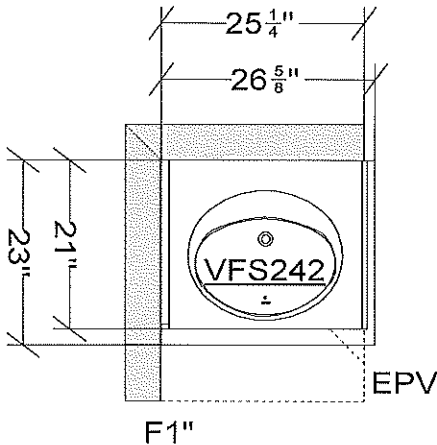

KICKB96 X 1
SCRIBE96 X 1

All dimensions _size designations given are subject to verification on job site and adjustment to fit job conditions.	2020	This is an original design and must not be released or copied unless applicable fee has been paid or job order placed.	Designed: 3/18/2025 Printed: 3/18/2025	
NUVO - LOWER UNIT (POWDER ROOM)		All	Drawing #: 1	Scale : 0 1/2" 1'

POWDER ROOM

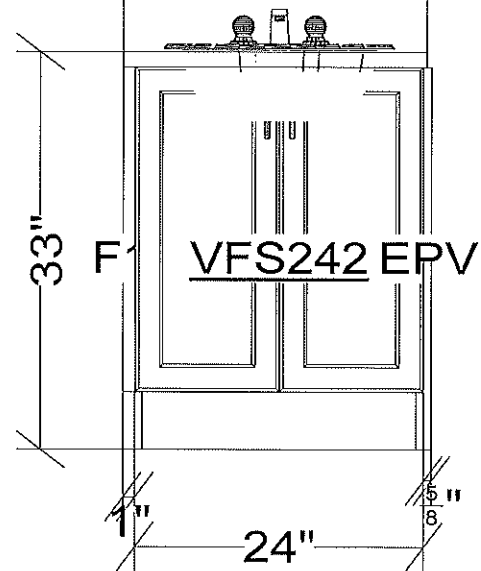

All dimensions _size designations given are subject to verification on job site and adjustment to fit job conditions.	2020	This is an original design and must not be released or copied unless applicable fee has been paid or job order placed.	Designed: 3/18/2025 Printed: 3/18/2025	
NUVO - LOWER UNIT (POWDER ROOM)		El 1	Drawing #: 1	Scale : 0 3/4" 1'

RAYWAL CABINETS

JUN BLD 8 - UNIT 144 - CIVIC 601

AS BUILT - MARCH 18 2025

NUVO - MAIN - LOWER UNIT

DOOR STYLE: MANCINI
FINISH: CINO
SPECIES: MELAMINE
BOX INTERIOR: WHITE MELAMINE
HINGE: STANDARD


HARDWARE:135

COUNTERTOP: W4925K-07

INSTALL 54" OVER TOILET



VSM15L

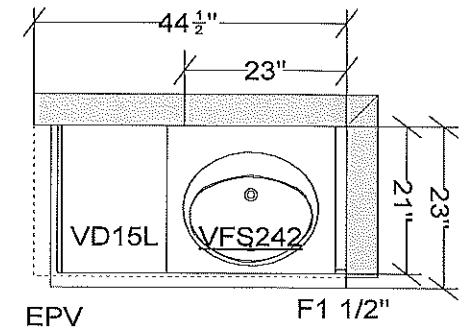

KICKB96 X 1
SCRIBE96 X 1

All dimensions _size designations
given are subject to verification on
job site and adjustment to fit job
conditions.

2020

This is an original design and must
not be released or copied unless
applicable fee has been paid or job
order placed.

Designed: 3/19/2025
Printed: 3/19/2025


NUVO- LOWER UNIT (MAIN)

All

Drawing #: 1

Scale : 0 7/16" 1'

MAIN

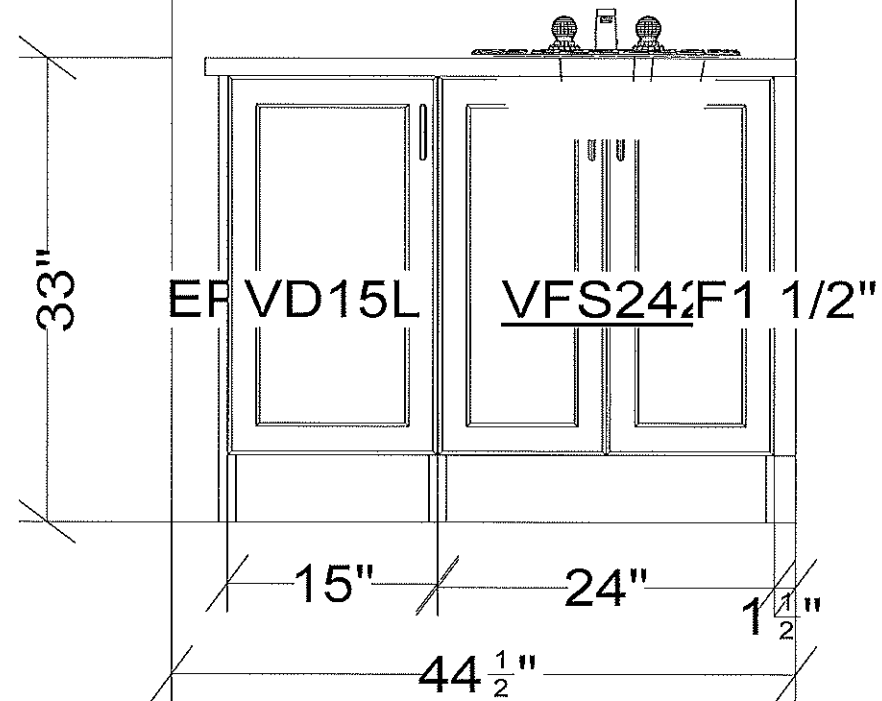

All dimensions size designations given are subject to verification on job site and adjustment to fit job conditions.

2020

This is an original design and must not be released or copied unless applicable fee has been paid or job order placed.

Designed: 3/19/2025
Printed: 3/19/2025

NUVO- LOWER UNIT (MAIN)

EI 1


Drawing #: 1

Scale : 0 7/8" 1'

RAYWAL CABINETS
JUN BLD 8 - UNIT 144 - CIVIC 601
AS BUILT - MARCH 18 2025
NUVO - ENSUITE - LOWER UNIT

DOOR STYLE: MANCINI
FINISH: CINO
SPECIES: MELAMINE
BOX INTERIOR: WHITE MELAMINE
HINGE: STANDARD

HARDWARE:135
COUNTERTOP: W4925K-07

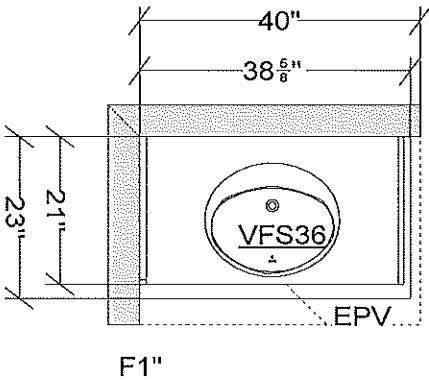


INSTALL 54" OVER TOILET

VSM15R

KICKB96 X 1
SCRIBE96 X 1

All dimensions & size designations given are subject to verification on job site and adjustment to fit job conditions.	2020	This is an original design and must not be released or copied unless applicable fee has been paid or job order placed.	Designed: 3/18/2025 Printed: 3/19/2025	
NUVO- LOWER UNIT (ENSUITE)		All	Drawing #: 1	Scale : 0 7/16" 1'

ENSUITE

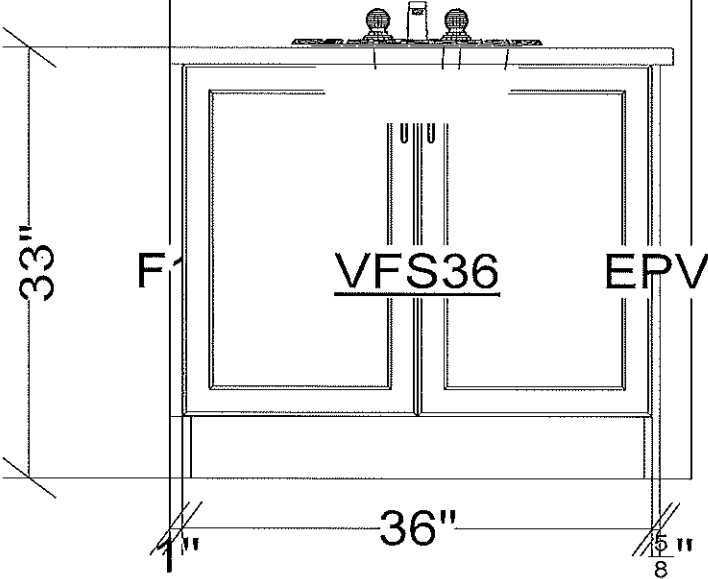

All dimensions _size designations given are subject to verification on job site and adjustment to fit job conditions.

2020

This is an original design and must not be released or copied unless applicable fee has been paid or job order placed.

Designed: 3/18/2025
Printed: 3/19/2025