JUN BLD 8 - UNIT 145 - CIVIC 631

AS BUILT - MARCH 19 2025

NUVO - KITCHEN - LOWER UNIT

DOOR STYLE: MODENA FINISH: OLIVE GREEN

SPECIES: MAPLE

BOX INTERIOR: WHITE MELAMINE

DRAWER FRONT: FLAT DRAWER BOX: METABOX


HINGE: STANDARD


HARDWARE: 137


COUNTERTOP: F6698-46

DWKIT X 1 VENT BOX X 1 (12"W x 9"D x 10 3/4") VENT BOX X 1 (30"W x 12"D x 14"H)

KICKB96 X 2 SCRIBE96 X 3

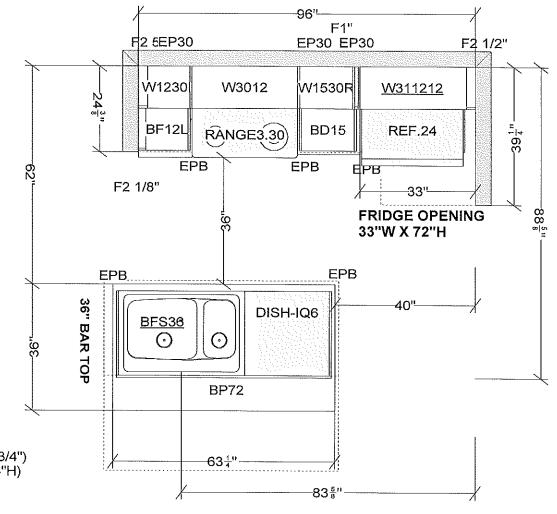


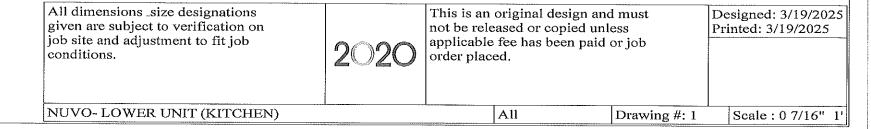

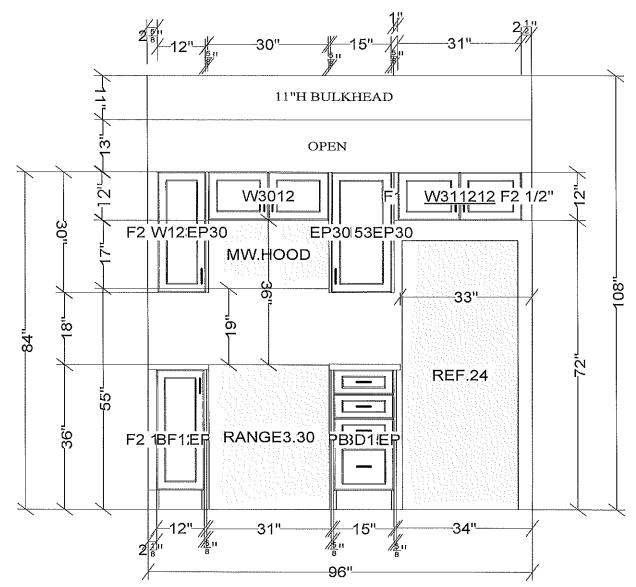

NO LIGHT VALANCE / NO CROWN/BUILD-UP

All dimensions _size designations given are subject to verification on job site and adjustment to fit job conditions.	0000	This is an original design and not be released or copied unle applicable fee has been paid o order placed.	SS	Designed: 3/19/2025 Printed: 3/19/2025
NUVO- LOWER UNIT (KITCHEN)		El 1	Drawing #:	Scale: 0 1/2" 1'

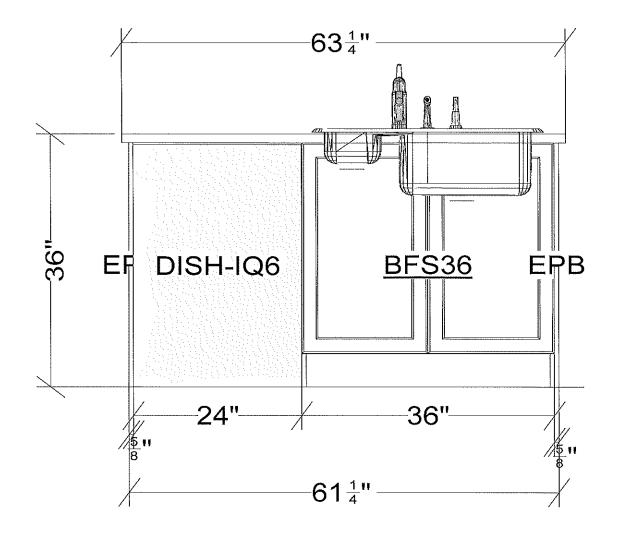

All dimensions size designations given are subject to verification on job site and adjustment to fit job conditions.

This is an original design and must not be released or copied unless applicable fee has been paid or job order placed.

Designed: 3/19/2025
Printed: 3/19/2025
Printed: 3/19/2025

Drawing #: 1 | Scale : 0 7/8" 1'

JUN BLD 8 - UNIT 145 - CIVIC 631

AS BUILT - MARCH 19 2025

NUVO - POWDER ROOM - LOWER UNIT

DOOR STYLE: MODENA FINISH: OLIVE GREEN SPECIES: MAPLE


BOX INTERIOR: WHITE MELAMINE

HINGE: STANDARD

HARDWARE:137

COUNTERTOP: F6698-46

KICKB96 X 1 SCRIBE96 X 1

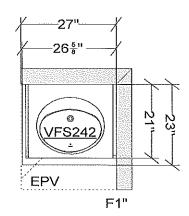

All dimensions size designations given are subject to verification on job site and adjustment to fit job conditions.

2020


This is an original design and must not be released or copied unless applicable fee has been paid or job order placed. Designed: 3/19/2025 Printed: 3/19/2025

NUVO - LOWER UNIT (POWDER ROOM)

All

Drawing #: 1

Scale: 0 7/16" 1'

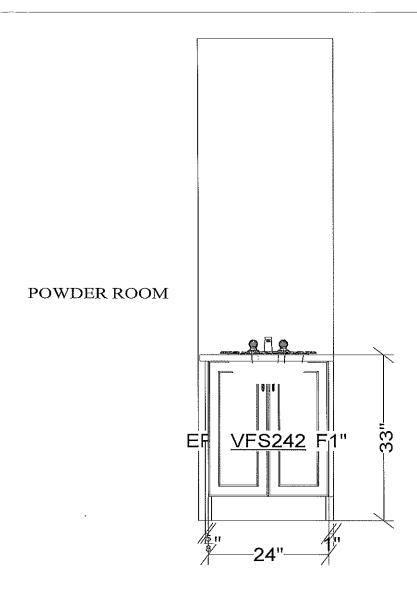

All dimensions size designations given are subject to verification on job site and adjustment to fit job conditions.

This is an original design and must not be released or copied unless applicable fee has been paid or job order placed.

Designed: 3/19/2025
Printed: 3/19/2025
Printed: 3/19/2025

Printed: 3/19/2025

Designed: 3/19/2025

Printed: 3/19/2025

Designed: 3/19/2025

Printed: 3/19/2025

Printed: 3/19/2025

JUN BLD 8 - UNIT 145 - CIVIC 631

AS BUILT - MARCH 19 2025

NUVO - MAIN - LOWER UNIT

DOOR STYLE: MANCINI

FINISH: CINO


SPECIES: MELAMINE

BOX INTERIOR: WHITE MELAMINE

HINGE: STANDARD

HARDWARE:135

COUNTERTOP: W4925K-07

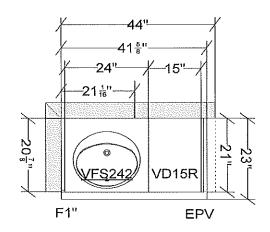

INSTALL 54" OVER TOILET

VSM15R

KICKB96 X 1 SCRIBE96 X 1

All dimensions _size designations given are subject to verification on job site and adjustment to fit job conditions.

2020

This is an original design and must not be released or copied unless applicable fee has been paid or job order placed.


Designed: 3/19/2025 Printed: 3/19/2025

NUVO- LOWER UNIT (MAIN)

All

Drawing #: 1

Scale: 0 7/16" 1'

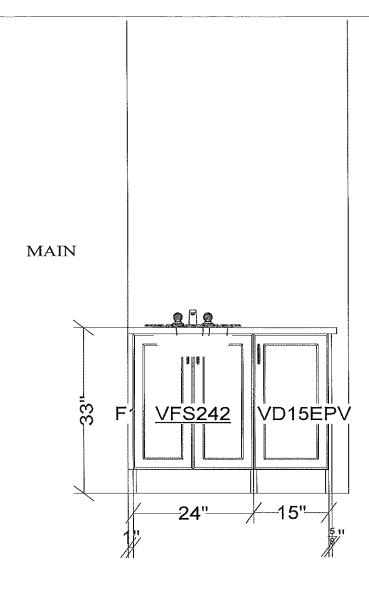

All dimensions size designations given are subject to verification on job site and adjustment to fit job conditions.

This is an original design and must not be released or copied unless applicable fee has been paid or job order placed.

Designed: 3/19/2025 Printed: 3/19/2025

NUVO- LOWER UNIT (MAIN)

El 1

Drawing #: 1

Scale: 0.5/8" 1'

JUN BLD 8 - UNIT 145 - CIVIC 631

AS BUILT - MARCH 19 2025

NUVO - ENSUITE - LOWER UNIT

DOOR STYLE: MANCINI

FINISH: CINO

SPECIES: MELAMINE

BOX INTERIOR: WHITE MELAMINE

HINGE: STANDARD

HARDWARE:135

COUNTERTOP: W4925K-07

INSTALL 54" OVER TOILET

VSM15L

40" -385″ EPV... F1"

KICKB96 X 1 SCRIBE96 X 1

All dimensions _size designations given are subject to verification on job site and adjustment to fit job conditions.

This is an original design and must not be released or copied unless applicable fee has been paid or job order placed.


Designed: 3/19/2025 Printed: 3/19/2025

NUVO-LOWER UNIT (ENSUITE)

All

Drawing #: 1

Scale: 0 7/16" 1'

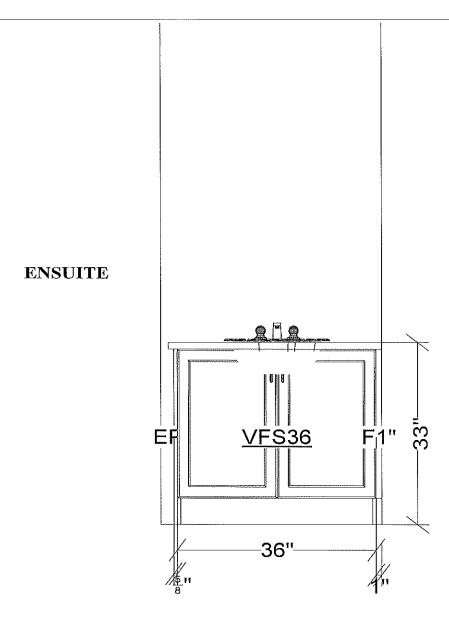

All dimensions _size designations given are subject to verification on job site and adjustment to fit job conditions.	2020	This is an original denot be released or cogapplicable fee has becorder placed.	oied unless	Designed: 3/19/2025 Printed: 3/19/2025
NUVO- LOWER UNIT (ENSUITE)		El 1	Drawing #: 1	Scale: 0 11/16" 1'