

RAYWAL CABINETS

JUN BLD 8 - UNIT 146 - CIVIC 625

AS BUILT - MARCH 19 2025


NUVO - KITCHEN - LOWER UNIT

DOOR STYLE: MODENA  
FINISH: OLIVE GREEN  
SPECIES: MAPLE  
BOX INTERIOR: WHITE MELAMINE  
DRAWER FRONT: FLAT  
DRAWER BOX: METABOX  
HINGE: STANDARD

HARDWARE:137

COUNTERTOP: N/A

- DWKIT X 1
- VENT BOX X 1 (12"W x 9"D x 10 3/4")
- VENT BOX X 1 (30"W x 12"D x 14"H)
- KICKB96 X 2
- SCRIBE96 X 3

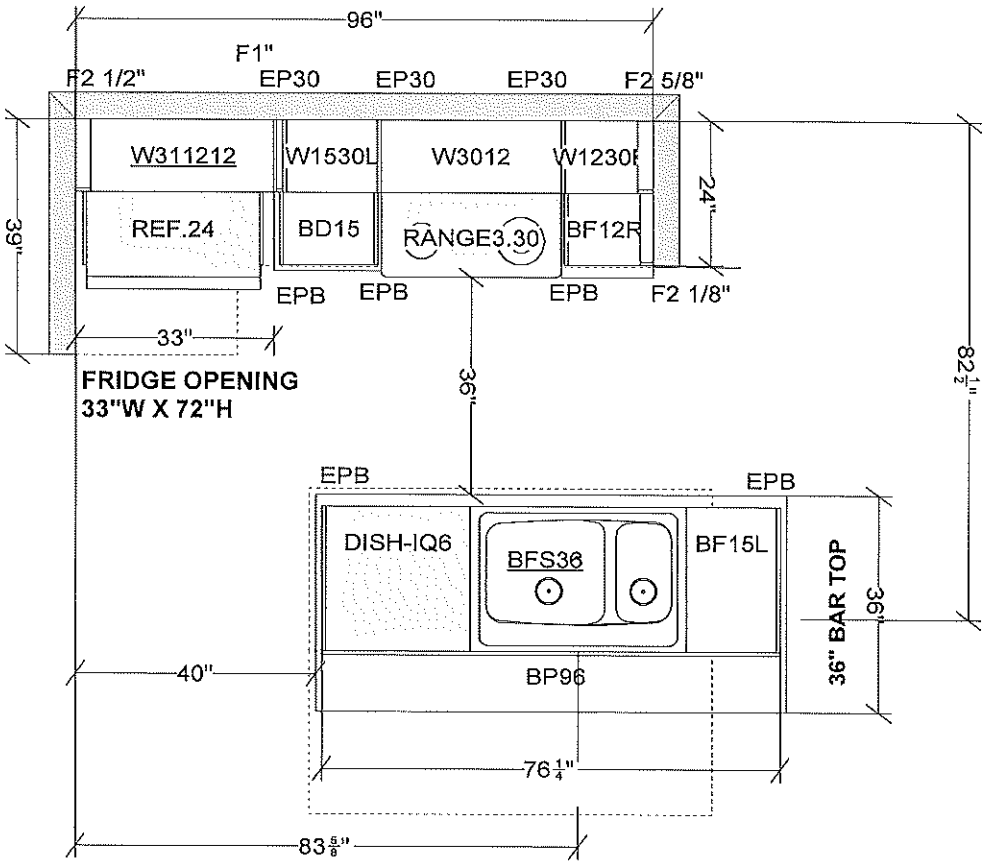


All dimensions \_size designations given are subject to verification on job site and adjustment to fit job conditions.

2020

This is an original design and must not be released or copied unless applicable fee has been paid or job order placed.

Designed: 3/19/2025  
Printed: 3/19/2025

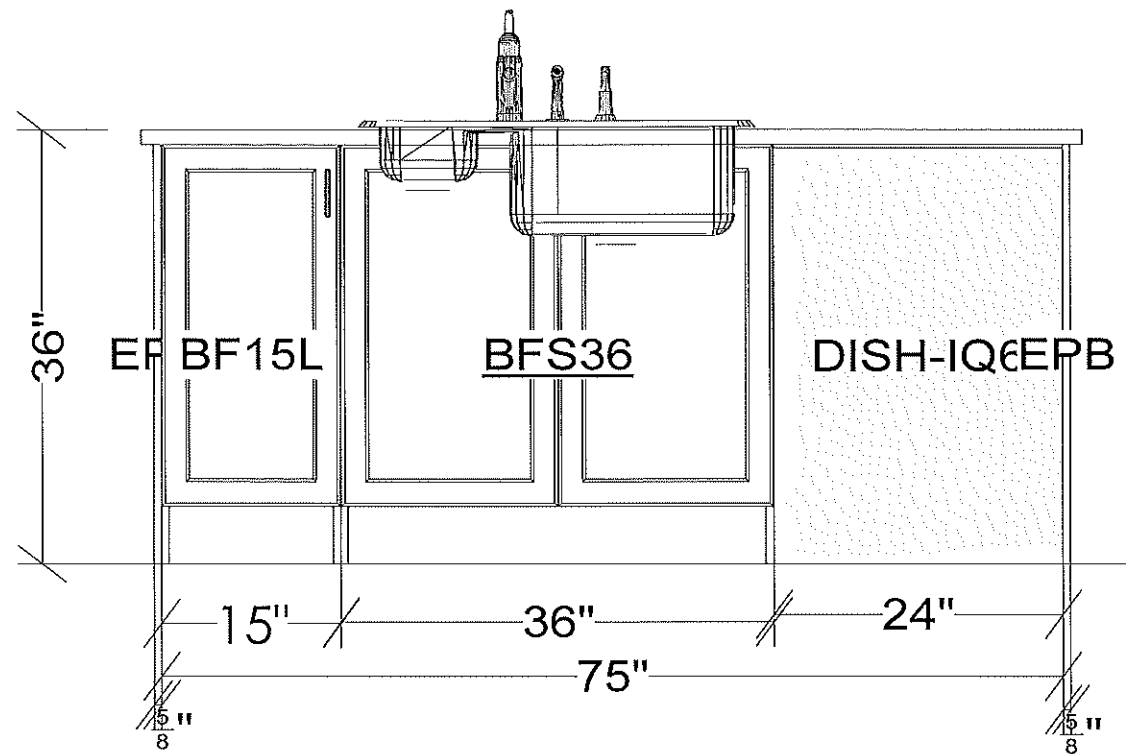


All dimensions and size designations given are subject to verification on job site and adjustment to fit job conditions.

2020

This is an original design and must not be released or copied unless applicable fee has been paid or job order placed.

 Designed: 3/19/2025  
Printed: 3/19/2025



Scale : 0 7/16" 1'

RAYWAL CABINETS

JUN BLD 8 - UNIT 146 - CIVIC 625


AS BUILT - MARCH 19 2025

NUVO - POWDER ROOM - LOWER UNIT

DOOR STYLE: MODENA  
FINISH: OLIVE GREEN  
SPECIES: MAPLE  
BOX INTERIOR: WHITE MELAMINE  
HINGE: STANDARD

HARDWARE:137

COUNTERTOP: F6698-46

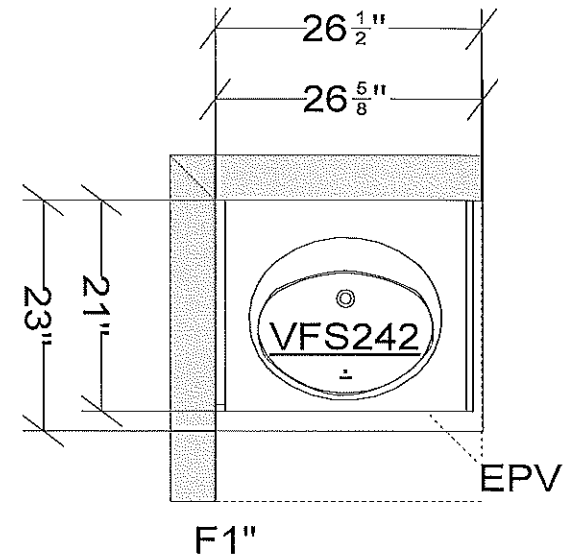

KICKB96 X 1  
SCRIBE96 X 1

All dimensions & size designations given are subject to verification on job site and adjustment to fit job conditions.

2020

This is an original design and must not be released or copied unless applicable fee has been paid or job order placed.

Designed: 3/19/2025  
Printed: 3/19/2025


NUVO - LOWER UNIT (POWDER ROOM)

All

Drawing #: 1

Scale : 0 5/8" 1'

POWDER ROOM

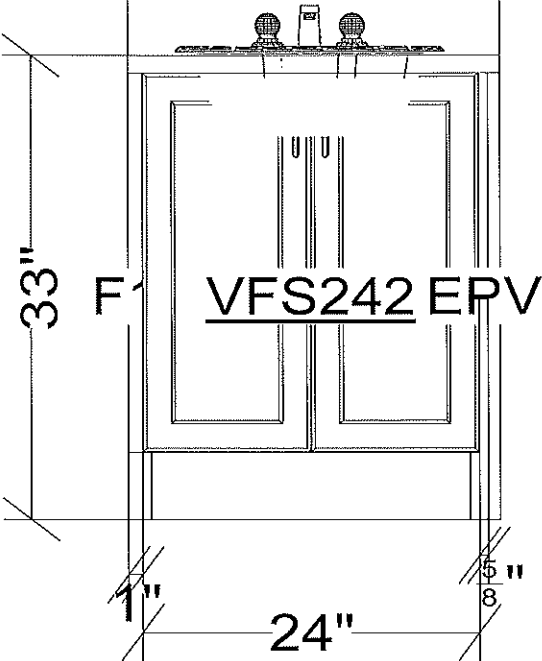

All dimensions size designations given are subject to verification on job site and adjustment to fit job conditions.	2020	This is an original design and must not be released or copied unless applicable fee has been paid or job order placed.	Designed: 3/19/2025 Printed: 3/19/2025
NUVO - LOWER UNIT (POWDER ROOM)	El 1	Drawing #: 1	Scale : 0 7/8" 1'

RAYWAL CABINETS

JUN BLD 8 - UNIT 146 - CIVIC 625

AS BUILT - MARCH 19 2025



NUVO - MAIN - LOWER UNIT

DOOR STYLE: MANCINI  
FINISH: CINO  
SPECIES: MELAMINE  
BOX INTERIOR: WHITE MELAMINE  
HINGE: STANDARD

HARDWARE:135

COUNTERTOP: W4925K-07


INSTALL 54" OVER TOILET

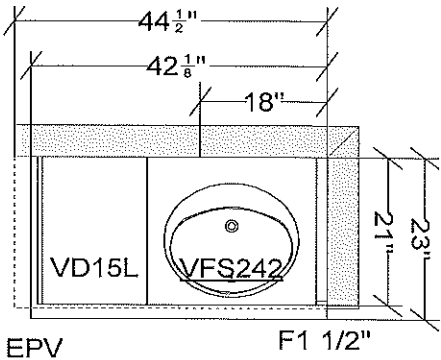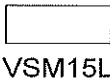

KICKB96 X 1  
SCRIBE96 X 1

All dimensions _size designations given are subject to verification on job site and adjustment to fit job conditions.	2020	This is an original design and must not be released or copied unless applicable fee has been paid or job order placed.	Designed: 3/19/2025 Printed: 3/19/2025	
NUVO- LOWER UNIT (MAIN)		All	Drawing #: 1	Scale : 0 7/16" 1'

MAIN

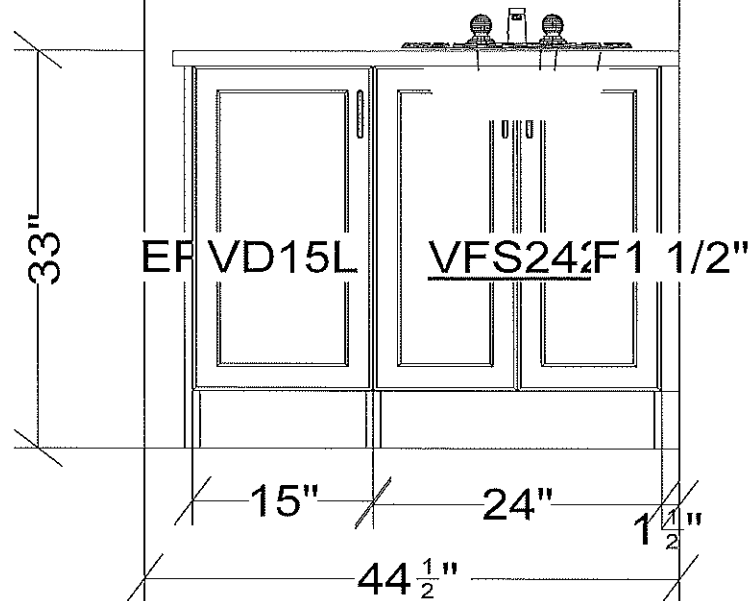

All dimensions and size designations given are subject to verification on job site and adjustment to fit job conditions.

2020

This is an original design and must not be released or copied unless applicable fee has been paid or job order placed.

Designed: 3/19/2025  
Printed: 3/19/2025

NUVO- LOWER UNIT (MAIN)

El 1

Drawing #: 1

Scale : 0 3/4" 1'


RAYWAL CABINETS

JUN BLD 8 - UNIT 146 - CIVIC 625


AS BUILT - MARCH 19 2025

NUVO - ENSUITE - LOWER UNIT

DOOR STYLE: MANCINI  
FINISH: CINO  
SPECIES: MELAMINE  
BOX INTERIOR: WHITE MELAMINE  
HINGE: STANDARD  
  
HARDWARE: 135  
COUNTERTOP: W4925K-07

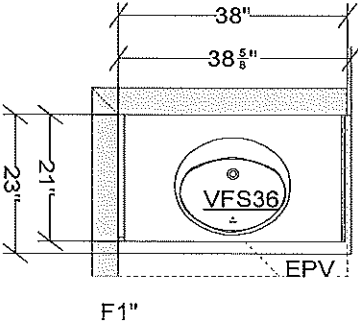

INSTALL 54" OVER TOILET

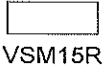


KICKB96 X 1  
SCRIBE96 X 1

All dimensions & size designations given are subject to verification on job site and adjustment to fit job conditions.	2020	This is an original design and must not be released or copied unless applicable fee has been paid or job order placed.	Designed: 3/19/2025 Printed: 3/19/2025	
NUVO- LOWER UNIT (ENSUITE)		All	Drawing #: 1	Scale : 0 3/8" 1'



# ENSUITE

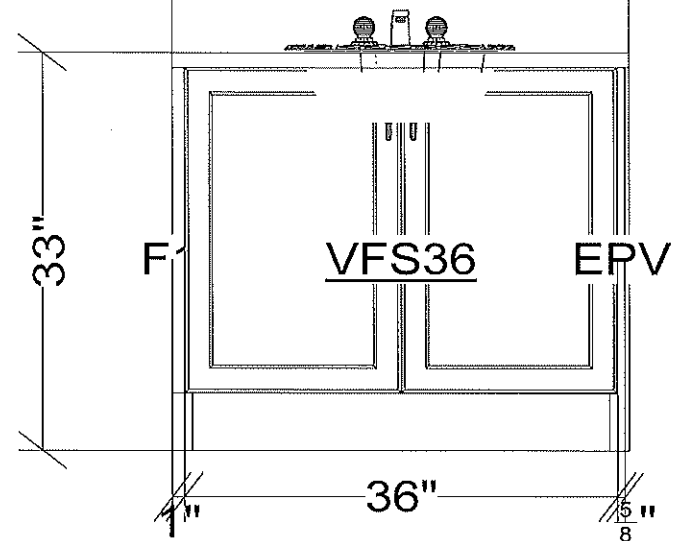

All dimensions size designations given are subject to verification on job site and adjustment to fit job conditions.

2020

This is an original design and must not be released or copied unless applicable fee has been paid or job order placed.

Designed: 3/19/2025  
Printed: 3/19/2025