

RAYWAL CABINETS

JUN BLD 8 - UNIT 148 - CIVIC 617

AS BUILT - MARCH 19 2025

NUVO - KITCHEN - LOWER UNIT


DOOR STYLE: MODENA
FINISH: OLIVE GREEN
SPECIES: MAPLE
BOX INTERIOR: WHITE MELAMINE
DRAWER FRONT: FLAT
DRAWER BOX: METABOX
HINGE: STANDARD

HARDWARE:137

COUNTERTOP: N/A

DWKIT X 1
VENT BOX X 1 (12"W x 9"D x 10 3/4")
VENT BOX X 1 (30"W x 12"D x 14"H)

KICKB96 X 2
SCRIBE96 X 3

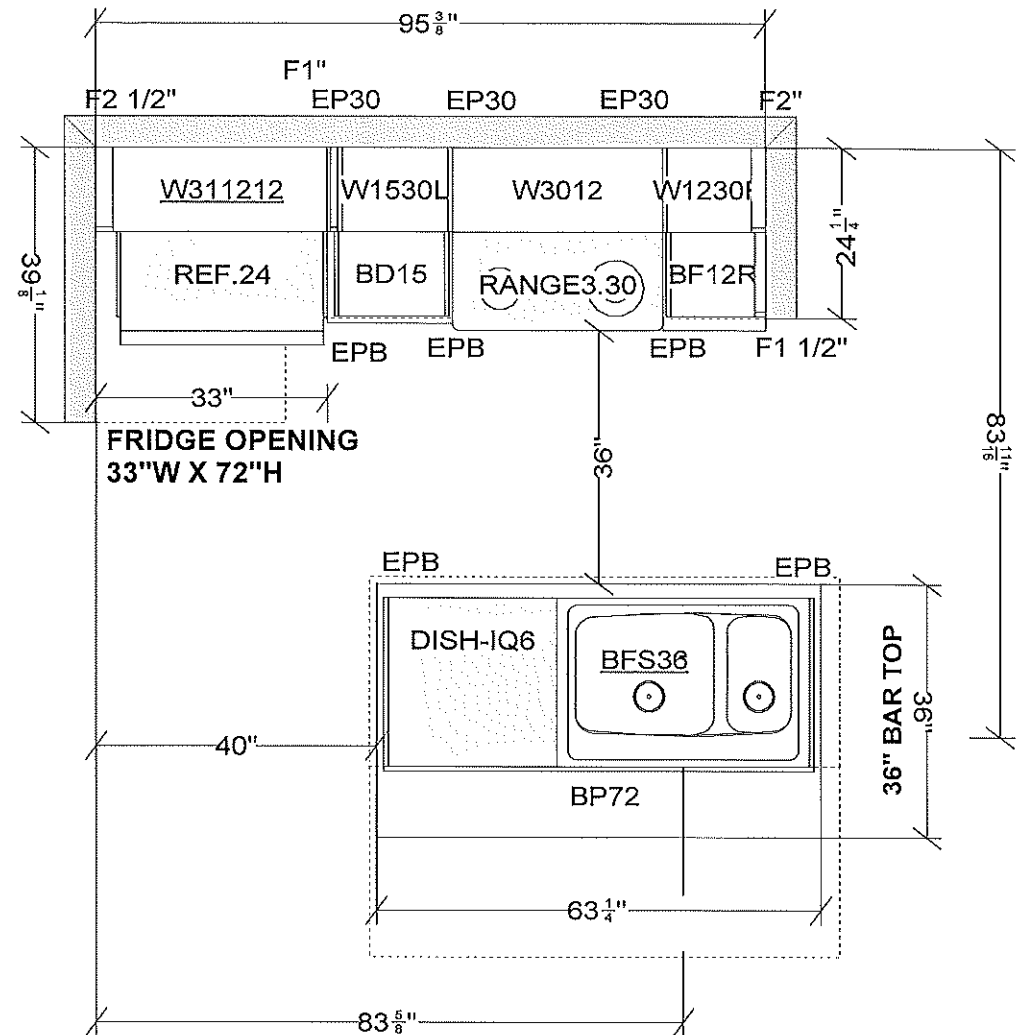

All dimensions size designations given are subject to verification on job site and adjustment to fit job conditions.

2020

This is an original design and must not be released or copied unless applicable fee has been paid or job order placed.


Designed: 3/19/2025
Printed: 3/19/2025

NUVO- LOWER UNIT (KITCHEN)

All

Drawing #: 1

Scale : 0 7/16" 1'

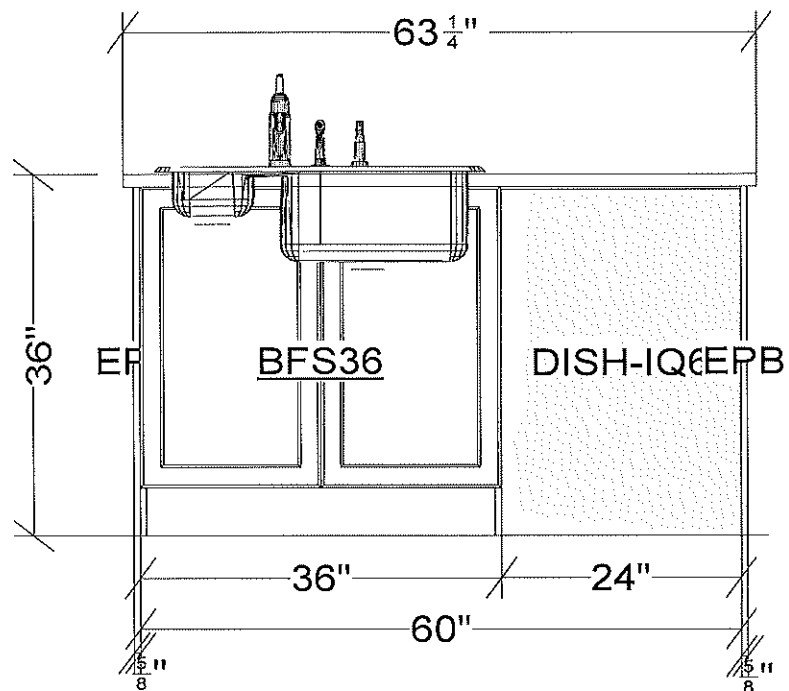


All dimensions and size designations given are subject to verification on job site and adjustment to fit job conditions.

2020

This is an original design and must not be released or copied unless applicable fee has been paid or job order placed.

Designed: 3/19/2025
Printed: 3/19/2025

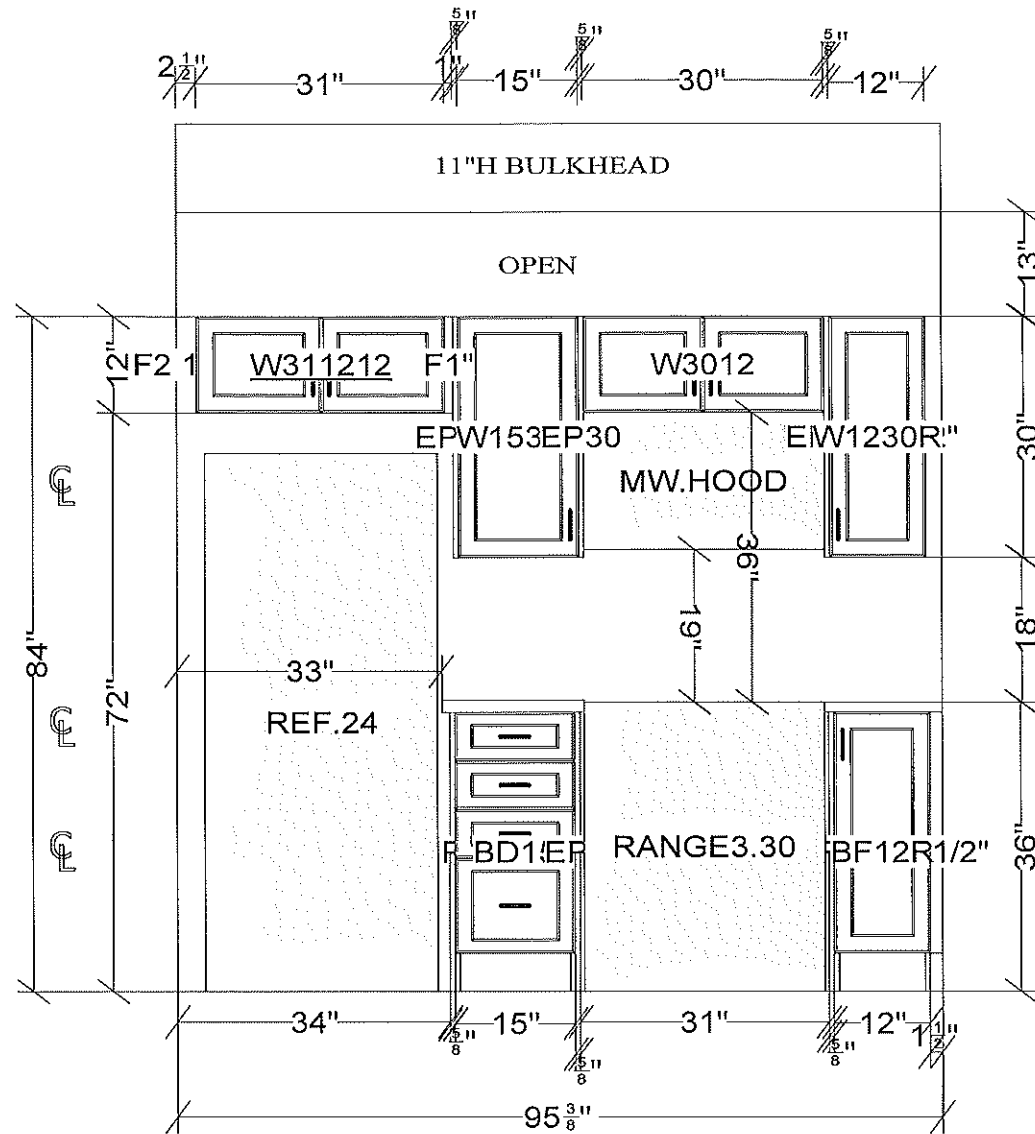

NO LIGHT VALANCE / NO CROWN/BUILD-UP

All dimensions & size designations given are subject to verification on job site and adjustment to fit job conditions.	2020	This is an original design and must not be released or copied unless applicable fee has been paid or job order placed.	Designed: 3/19/2025 Printed: 3/19/2025
NUVO- LOWER UNIT (KITCHEN)	El 1	Drawing #: 1	Scale : 0 1/2" 1'

RAYWAL CABINETS

JUN BLD 8 - UNIT 148 - CIVIC 617


AS BUILT - MARCH 19 2025

NUVO - POWDER ROOM - LOWER UNIT

DOOR STYLE: MODENA
FINISH: OLIVE GREEN
SPECIES: MAPLE
BOX INTERIOR: WHITE MELAMINE
HINGE: STANDARD

HARDWARE:137


COUNTERTOP: F6698-46

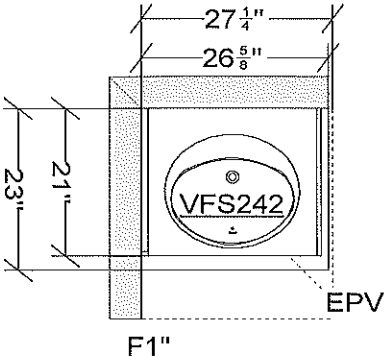

KICKB96 X 1
SCRIBE96 X 1

All dimensions size designations given are subject to verification on job site and adjustment to fit job conditions.	2020	This is an original design and must not be released or copied unless applicable fee has been paid or job order placed.	Designed: 3/19/2025 Printed: 3/19/2025	
NUVO - LOWER UNIT (POWDER ROOM)		All	Drawing #: 1	Scale : 0 7/16" 1'

POWDER ROOM

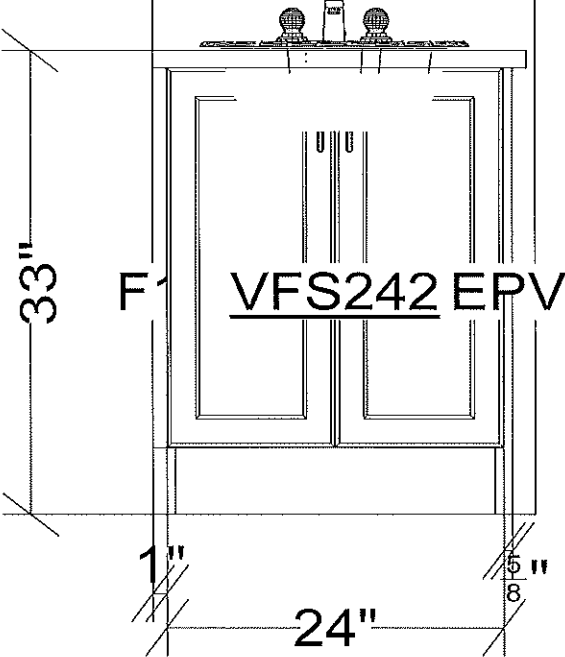


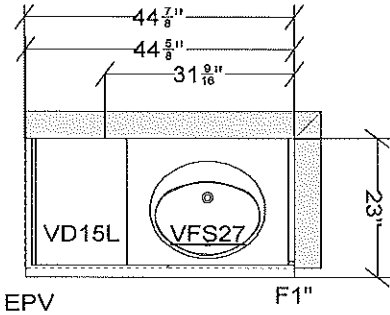
All dimensions size designations given are subject to verification on job site and adjustment to fit job conditions.	2020	This is an original design and must not be released or copied unless applicable fee has been paid or job order placed.	Designed: 3/19/2025 Printed: 3/19/2025	
			NUVO - LOWER UNIT (POWDER ROOM)	El 1 Drawing #: 1 Scale : 0 7/8" 1'

RAYWAL CABINETS
JUN BLD 8 - UNIT 148 - CIVIC 617
AS BUILT - MARCH 19 2025
NUVO - MAIN - LOWER UNIT

DOOR STYLE: MODENA
FINISH: OLIVE GREEN
SPECIES: MAPLE
BOX INTERIOR: WHITE MELAMINE
HINGE: STANDARD

HARDWARE:135
COUNTERTOP: F6698-46


INSTALL 54" OVER TOILET

VSM15L



KICKB96 X 1
SCRIBE96 X 1

All dimensions _size designations given are subject to verification on job site and adjustment to fit job conditions.	2020	This is an original design and must not be released or copied unless applicable fee has been paid or job order placed.	Designed: 3/19/2025 Printed: 3/19/2025	
NUVO- LOWER UNIT (MAIN)		All	Drawing #: 1	Scale : 0 3/8" 1'

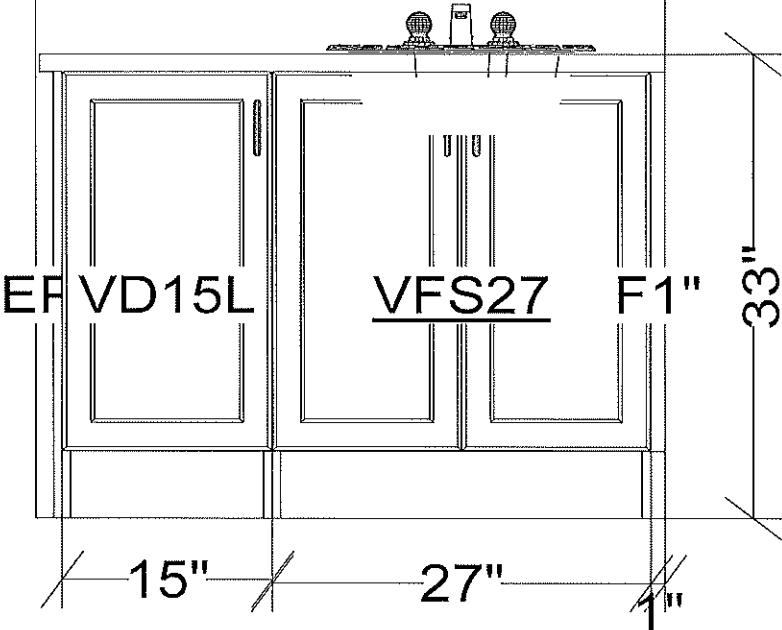MAIN



All dimensions .size designations given are subject to verification on job site and adjustment to fit job conditions.	2020	This is an original design and must not be released or copied unless applicable fee has been paid or job order placed.	Designed: 3/19/2025 Printed: 3/19/2025	
			NUVO- LOWER UNIT (MAIN)	El 1 Drawing #: 1 Scale : 0 7/8" 1'

RAYWAL CABINETS

JUN BLD 8 - UNIT 148 - CIVIC 617


AS BUILT - MARCH 19 2025

NUVO - ENSUITE - LOWER UNIT


DOOR STYLE: MODENA
FINISH: OLIVE GREEN
SPECIES: MAPLE
BOX INTERIOR: WHITE MELAMINE
HINGE: STANDARD

HARDWARE:135

COUNTERTOP: F6698-46

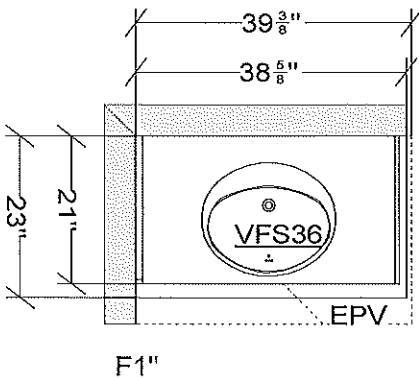


INSTALL 54" OVER TOILET

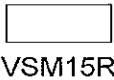

KICKB96 X 1
SCRIBE96 X 1

All dimensions .size designations given are subject to verification on job site and adjustment to fit job conditions.	2020	This is an original design and must not be released or copied unless applicable fee has been paid or job order placed.	Designed: 3/19/2025 Printed: 3/19/2025	
NUVO- LOWER UNIT (ENSUITE)		All	Drawing #: 1	Scale : 0 7/16" 1'

ENSUITE

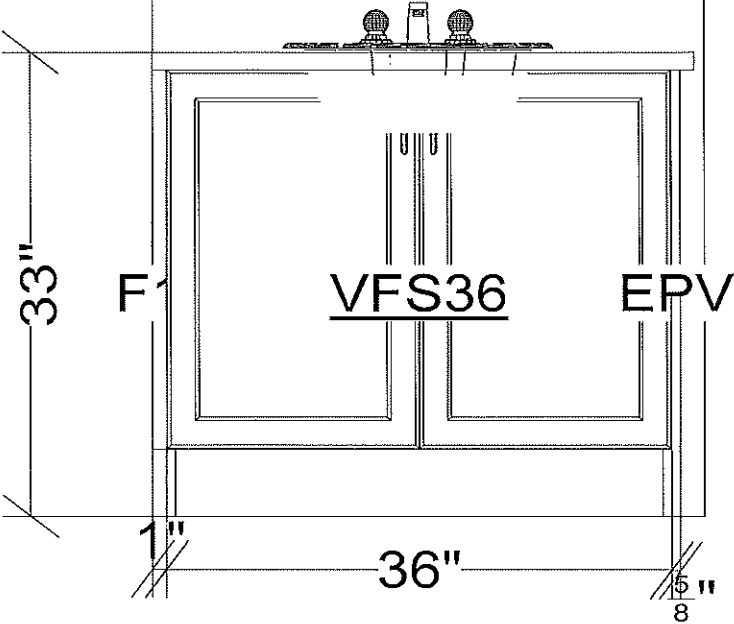

All dimensions size designations given are subject to verification on job site and adjustment to fit job conditions.

2020

This is an original design and must not be released or copied unless applicable fee has been paid or job order placed.

Designed: 3/19/2025
Printed: 3/19/2025