

RAYWAL CABINETS

JUN BLD 8 - UNIT 244 - CIVIC 603

AS BUILT - MARCH 19 2025

NUVO - KITCHEN - UPPER UNIT


DOOR STYLE: MODENA
FINISH: OLIVE GREEN
SPECIES: MAPLE
BOX INTERIOR: WHITE MELAMINE
HINGE: STANDARD

HARDWARE:137

COUNTERTOP: F6698-46

DWKIT X 1
VENT BOX X 1 (12"W x 9"D x 10 3/4")
VENT BOX X 1 (30"W x 12"D x 14"H)

KICKB96 X 2
SCRIBE96 X 3

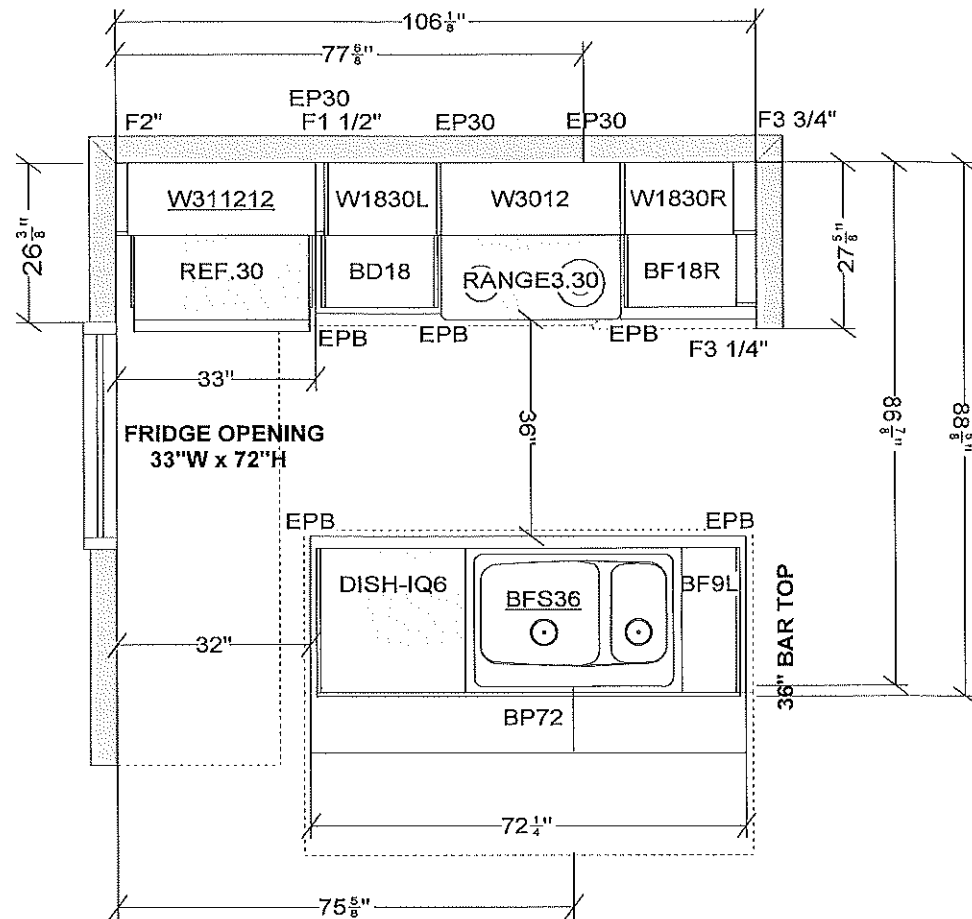

All dimensions size designations given are subject to verification on job site and adjustment to fit job conditions.

2020

This is an original design and must not be released or copied unless applicable fee has been paid or job order placed.


Designed: 3/19/2025
Printed: 3/20/2025

NUVO - UPPER UNIT (KITCHEN)

All

Drawing #: 1

Scale : 0 3/8" 1'

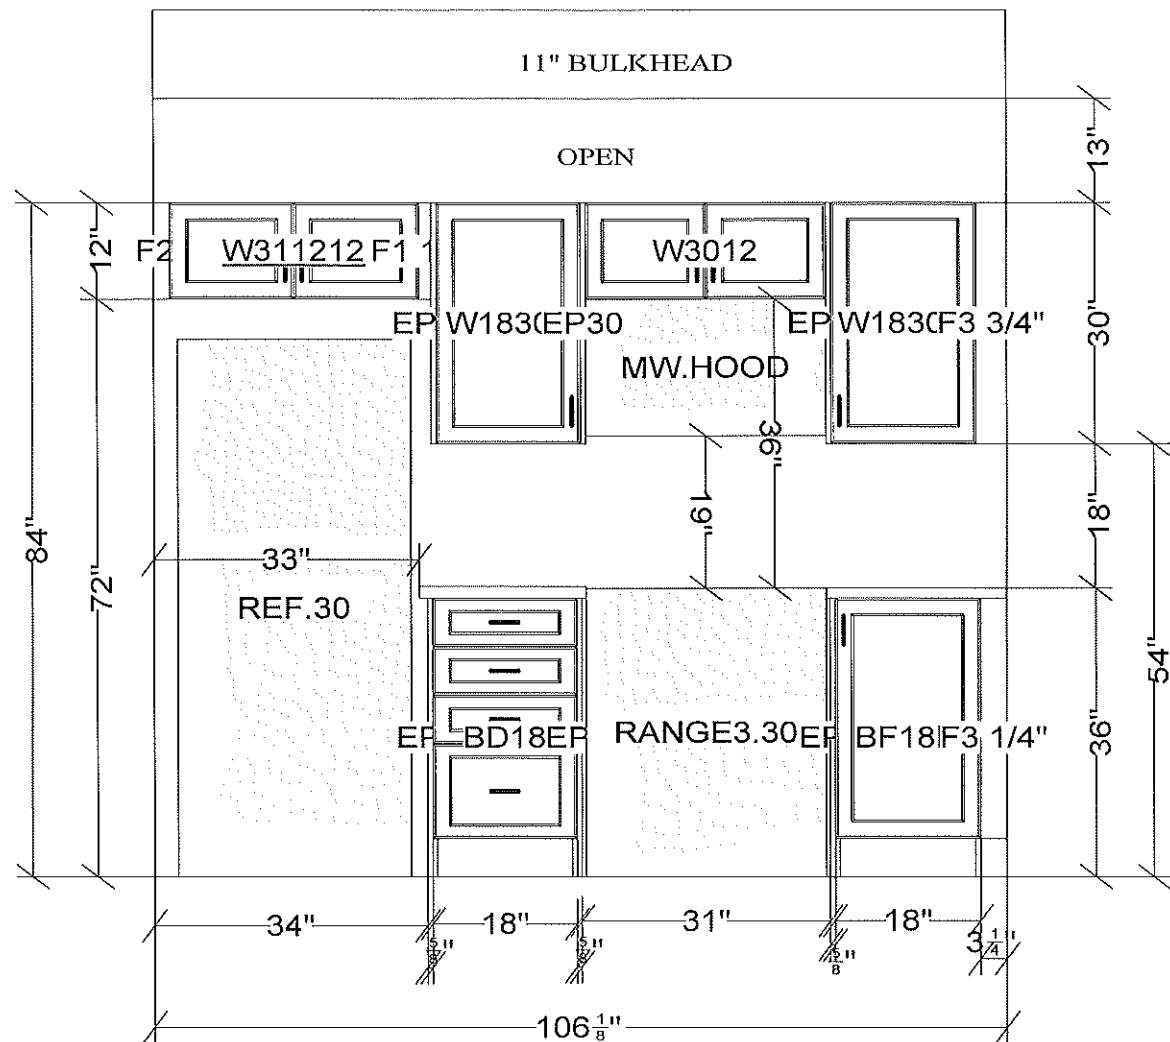


All dimensions .size designations given are subject to verification on job site and adjustment to fit job conditions.

2020

This is an original design and must not be released or copied unless applicable fee has been paid or job order placed.

Designed: 3/19/2025
Printed: 3/20/2025

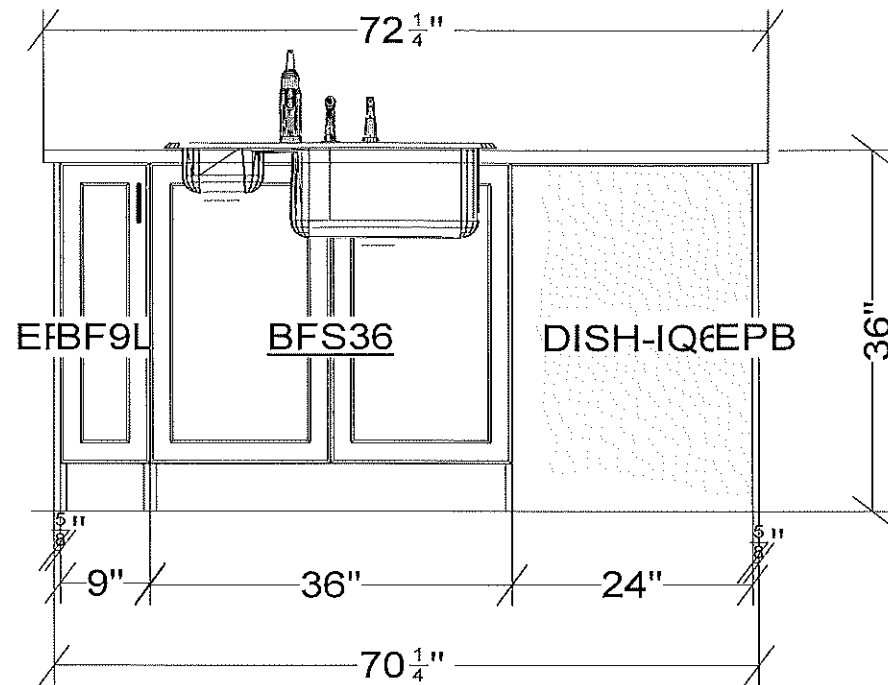

All dimensions size designations given are subject to verification on job site and adjustment to fit job conditions.

2020


This is an original design and must not be released or copied unless applicable fee has been paid or job order placed.

Designed: 3/19/2025
Printed: 3/20/2025

RAYWAL CABINETS
JUN BLD 8 - UNIT 244 - CIVIC 603
AS BUILT - MARCH 19 2025
NUVO - POWDER ROOM - UPPER UNIT

DOOR STYLE: MODENA
FINISH: OLIVE GREEN
SPECIES: MAPLE
BOX INTERIOR: WHITE MELAMINE
HINGE: STANDARD


HARDWARE: 137
COUNTERTOP: F6698-46

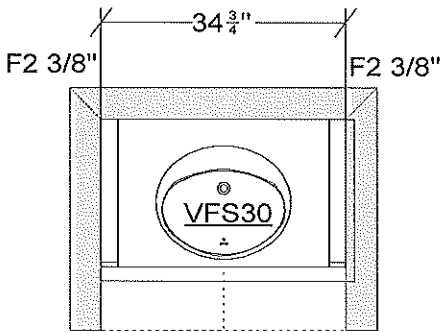

KICKB96 X 1
SCRIBE96 X 1

All dimensions & size designations given are subject to verification on job site and adjustment to fit job conditions.	2020	This is an original design and must not be released or copied unless applicable fee has been paid or job order placed.	Designed: 3/19/2025 Printed: 3/19/2025	
NUVO- UPPER UNIT (POWDER ROOM)		All	Drawing #: 1	Scale : 0 7/16" 1'

POWDER ROOM

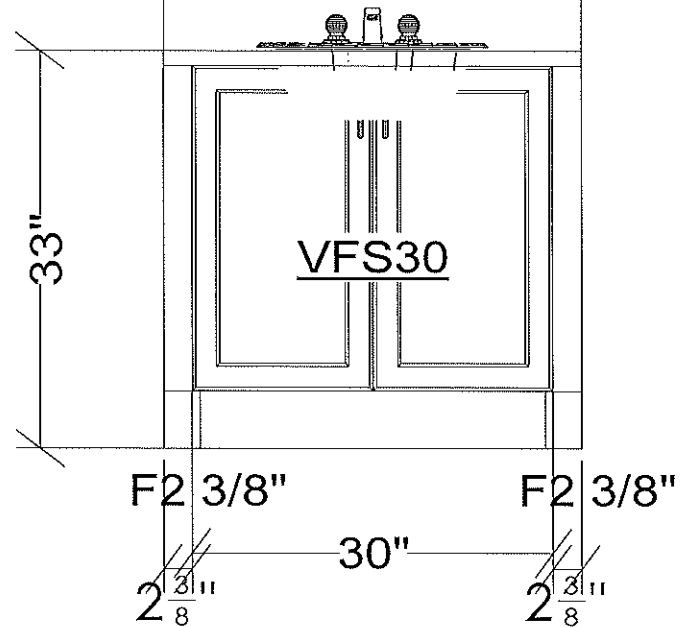

All dimensions size designations given are subject to verification on job site and adjustment to fit job conditions.

2020

This is an original design and must not be released or copied unless applicable fee has been paid or job order placed.

Designed: 3/19/2025
Printed: 3/19/2025

RAYWAL CABINETS

JUN BLD 8 - UNIT 244 - CIVIC 603

AS BUILT - MARCH 19 2025


NUVO - MAIN - UPPER UNIT

DOOR STYLE: MANCINI
FINISH: CINO
SPECIES: MELAMINE
BOX INTERIOR: WHITE MELAMINE
HINGE: STANDARD


HARDWARE: 135

COUNTERTOP: W4925K-07

INSTALL 54" OVER TOILET

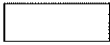

VSM15L

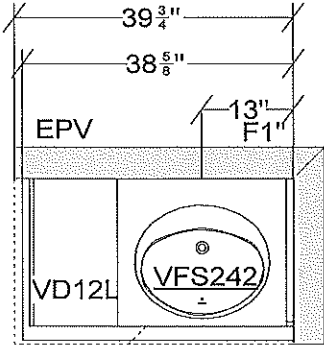

KICKB96 X 1
SCRIBE96 X 1

All dimensions and size designations given are subject to verification on job site and adjustment to fit job conditions.

2020

This is an original design and must not be released or copied unless applicable fee has been paid or job order placed.

Designed: 3/19/2025
Printed: 3/19/2025


NUVO- UPPER UNIT (MAIN BATH)

All

Drawing #: 1

Scale : 0 7/16" 1'

MAIN

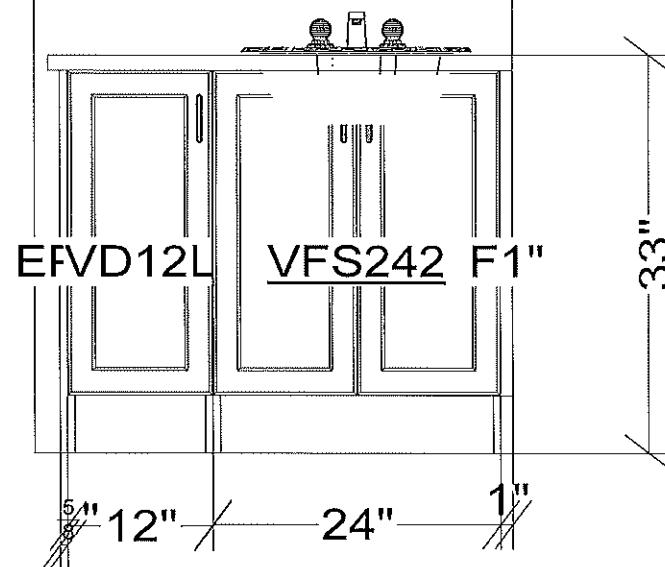

All dimensions size designations given are subject to verification on job site and adjustment to fit job conditions.

2020

This is an original design and must not be released or copied unless applicable fee has been paid or job order placed.

Designed: 3/19/2025
Printed: 3/19/2025

NUVO- UPPER UNIT (MAIN BATH)

El 1

Drawing #: 1

Scale : 0 3/4" 1'

RAYWAL CABINETS

JUN BLD 8 - UNIT 244 - CIVIC 603


AS BUILT - MARCH 19 2025

NUVO - ENSUITE - UPPER UNIT


DOOR STYLE: MANCINI
FINISH: CINO
SPECIES: MELAMINE
BOX INTERIOR: WHITE MELAMINE
HINGE: STANDARD

HARDWARE:135

COUNTERTOP: W4925K-07

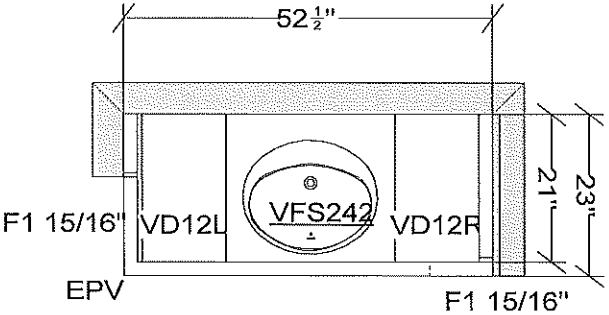


INSTALL 54" OVER TOILET

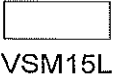

KICKB96 X 1
SCRIBE96 X 1

All dimensions and size designations given are subject to verification on job site and adjustment to fit job conditions.	2020	This is an original design and must not be released or copied unless applicable fee has been paid or job order placed.	Designed: 3/19/2025 Printed: 3/19/2025	
NUVO- UPPER UNIT (ENSUITE)		All	Drawing #: 1	Scale : 0 7/16" 1'

ENSUITE

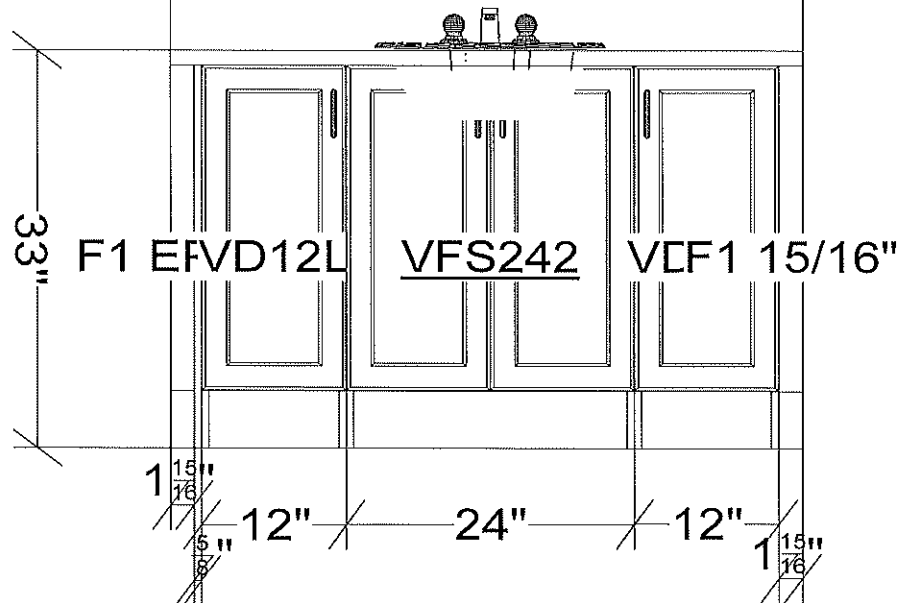

All dimensions size designations given are subject to verification on job site and adjustment to fit job conditions.

2020

This is an original design and must not be released or copied unless applicable fee has been paid or job order placed.

Designed: 3/19/2025
Printed: 3/19/2025

NUVO- UPPER UNIT (ENSUITE)

El 1

Drawing #: 1

Scale : 0 3/4" 1'