

RAYWAL CABINETS

JUN BLD 8 - UNIT 242 - CIVIC 611

AS BUILT - MARCH 19 2025

NUVO - KITCHEN - UPPER UNIT


DOOR STYLE: RETRO
FINISH: CONCRETE
SPECIES: THERMOFOIL
BOX INTERIOR: WHITE MELAMINE
HINGE: STANDARD
DRAWER BOX: METABOX

HARDWARE:146

COUNTERTOP: N/A

DWKIT X 1
VENT BOX X 1 (12"W x 9"D x 10 3/4")
VENT BOX X 1 (30"W x 12"D x 14"H)

KICKB96 X 2
SCRIBE96 X 3

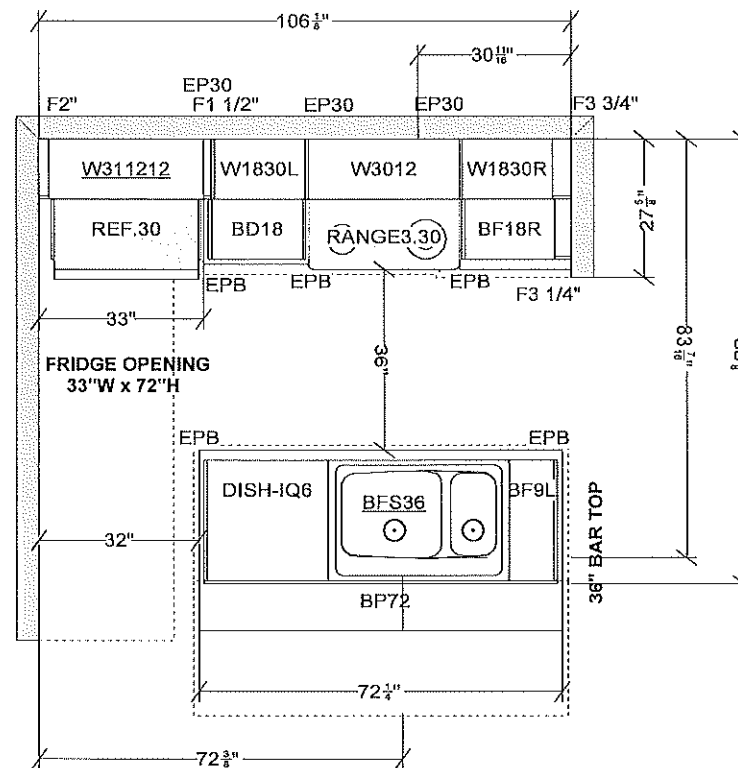

All dimensions size designations given are subject to verification on job site and adjustment to fit job conditions.

2020

This is an original design and must not be released or copied unless applicable fee has been paid or job order placed.


Designed: 3/21/2025
Printed: 3/21/2025

NUVO - UPPER UNIT (KITCHEN)

All

Drawing #: 1

Scale : 0 5/16" 1'

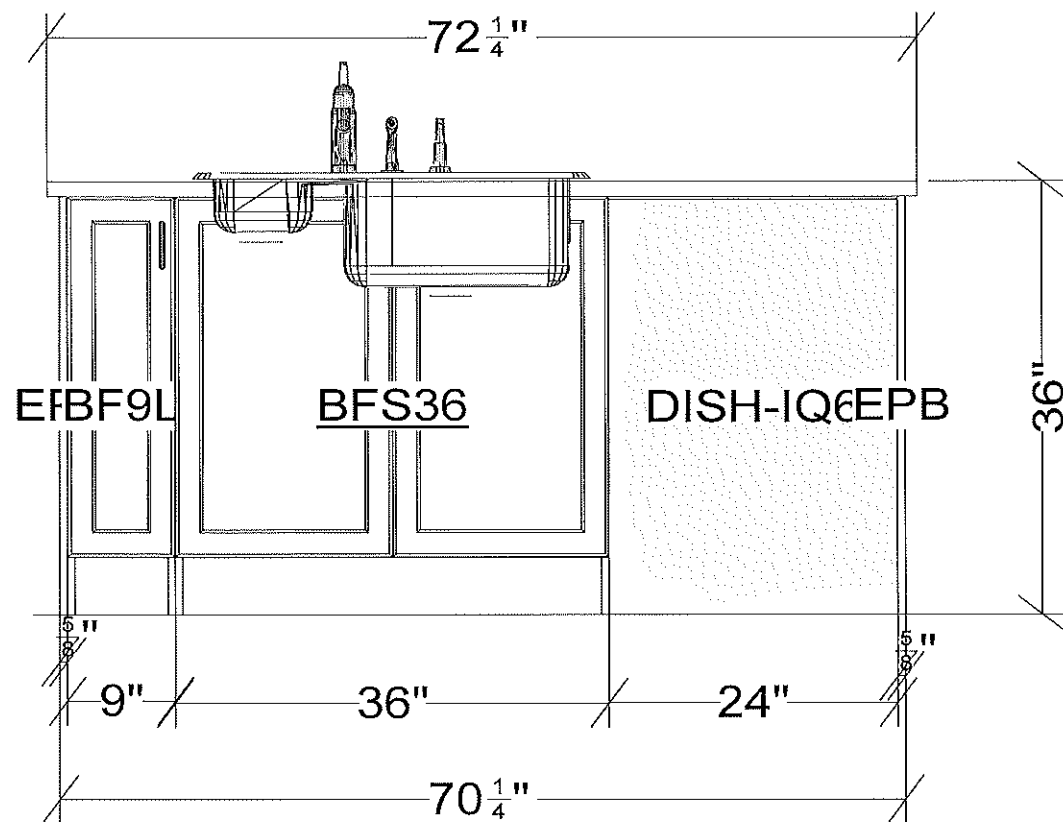


All dimensions size designations given are subject to verification on job site and adjustment to fit job conditions.

2020

This is an original design and must not be released or copied unless applicable fee has been paid or job order placed.

Designed: 3/21/2025
Printed: 3/21/2025

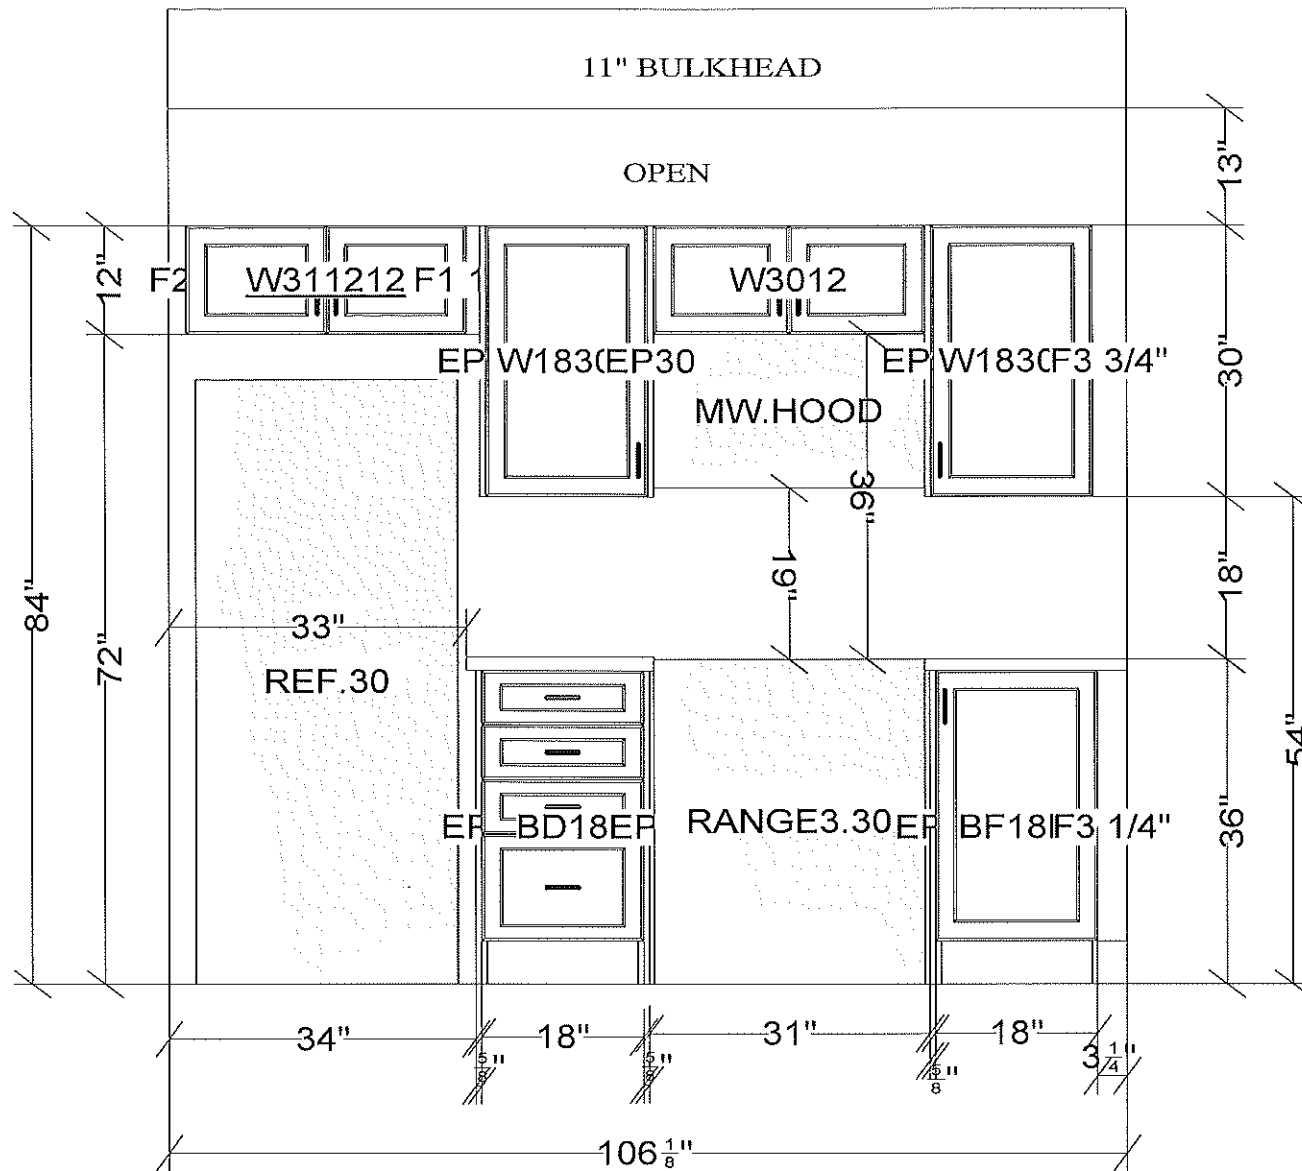

All dimensions _size designations given are subject to verification on job site and adjustment to fit job conditions.	2020	This is an original design and must not be released or copied unless applicable fee has been paid or job order placed.	Designed: 3/21/2025 Printed: 3/21/2025
NUVO - UPPER UNIT (KITCHEN)	El 1	Drawing #: 1	Scale : 0 9/16" 1'

RAYWAL CABINETS

JUN BLD 8 - UNIT 242 - CIVIC 611


AS BUILT - MARCH 20 2025

NUVO - POWDER ROOM - UPPER UNIT

DOOR STYLE: RETRO
FINISH: CHARCOAL
SPECIES: THERMOFOIL
BOX INTERIOR: WHITE MELAMINE
HINGE: STANDARD

HARDWARE:143


COUNTERTOP: N/A

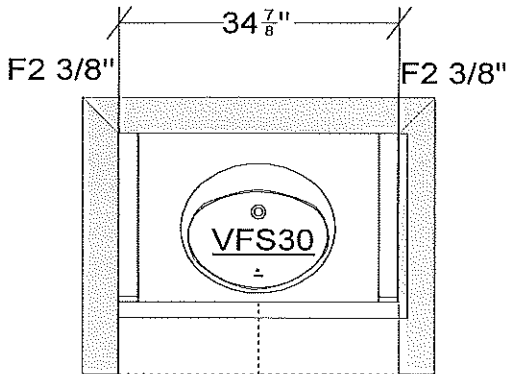

KICKB96 X 1
SCRIBE96 X 1

All dimensions and size designations given are subject to verification on job site and adjustment to fit job conditions.	2020	This is an original design and must not be released or copied unless applicable fee has been paid or job order placed.	Designed: 3/20/2025 Printed: 3/21/2025	
NUVO- UPPER UNIT (POWDER ROOM)		All	Drawing #: 1	Scale : 0 1/2" 1'

POWDER ROOM

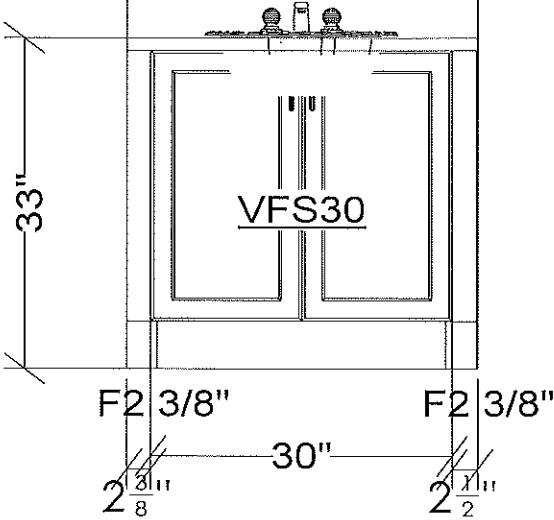

All dimensions size designations given are subject to verification on job site and adjustment to fit job conditions.

2020

This is an original design and must not be released or copied unless applicable fee has been paid or job order placed.

Designed: 3/20/2025
Printed: 3/21/2025

RAYWAL CABINETS


JUN BLD 8 - UNIT 242 - CIVIC 611

AS BUILT - MARCH 19 2025


NUVO - ENSUITE - UPPER UNIT

DOOR STYLE: MANCINI
FINISH: HAZEL
SPECIES: MELAMINE
BOX INTERIOR: WHITE MELAMINE
HINGE: STANDARD

HARDWARE:144
COUNTERTOP: N/A

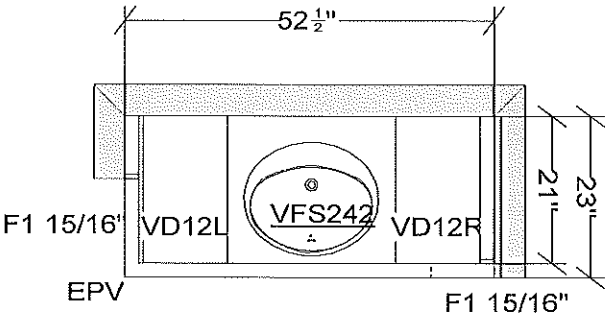


INSTALL 54" OVER TOILET

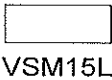

KICKB96 X 1
SCRIBE96 X 1

All dimensions _size designations given are subject to verification on job site and adjustment to fit job conditions.	2020	This is an original design and must not be released or copied unless applicable fee has been paid or job order placed.	Designed: 3/21/2025 Printed: 3/21/2025	
NUVO- UPPER UNIT (ENSUITE)		All	Drawing #: 1	Scale : 0 7/16" 1'

ENSUITE

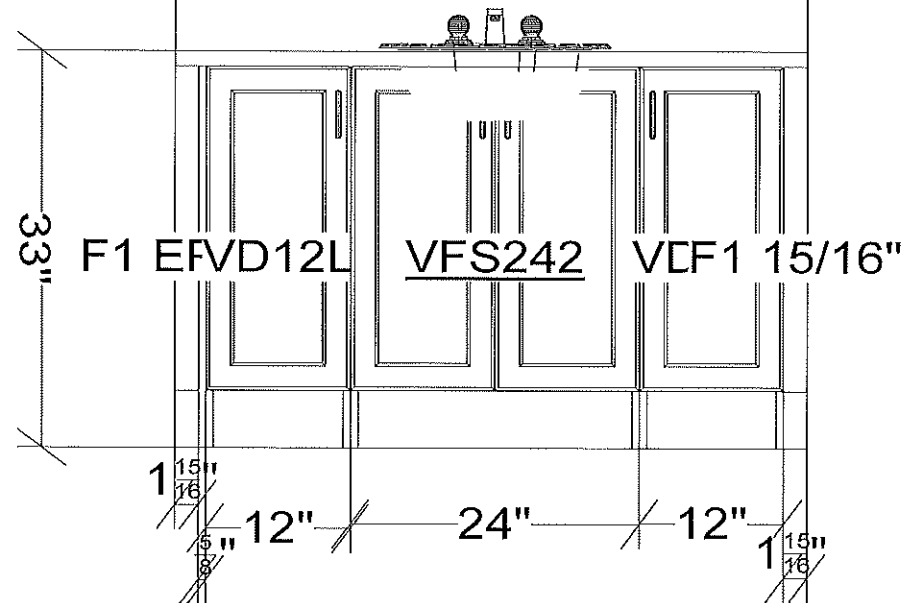

All dimensions .size designations given are subject to verification on job site and adjustment to fit job conditions.	2020	This is an original design and must not be released or copied unless applicable fee has been paid or job order placed.	Designed: 3/21/2025 Printed: 3/21/2025	
NUVO- UPPER UNIT (ENSUITE)			El 1	Drawing #: 1 Scale : 0 3/4" 1'

RAYWAL CABINETS

JUN BLD 8 - UNIT242 - CIVIC 611

AS BUILT - MARCH 20 2025


NUVO - MAIN - UPPER UNIT

DOOR STYLE: MANCINI
FINISH: HAZEL
SPECIES: MELAMINE
BOX INTERIOR: WHITE MELAMINE
HINGE: STANDARD


HARDWARE:144

COUNTERTOP: N/A

INSTALL 54" OVER TOILET

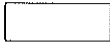


VSM15L

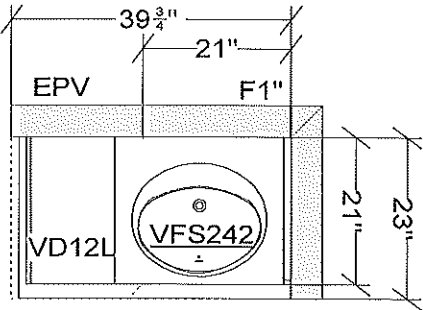

KICKB96 X 1
SCRIBE96 X 1

All dimensions _size designations given are subject to verification on job site and adjustment to fit job conditions.	2020	This is an original design and must not be released or copied unless applicable fee has been paid or job order placed.	Designed: 3/21/2025 Printed: 3/21/2025	
NUVO- UPPER UNIT (MAIN BATH)		All	Drawing #: 1	Scale : 0 7/16" 1'

MAIN

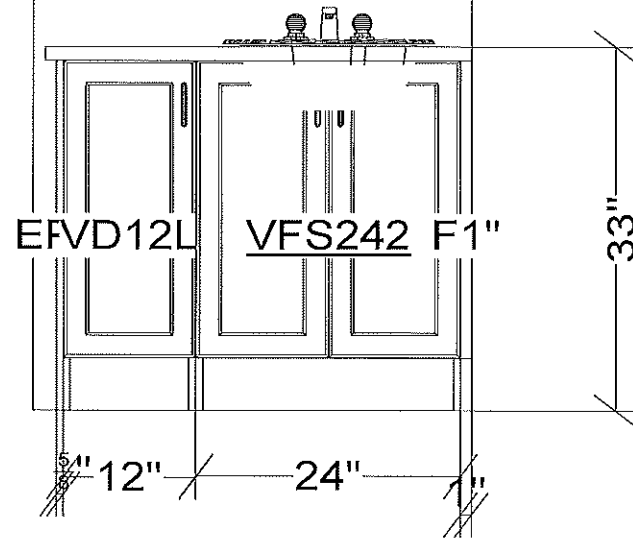

All dimensions & size designations given are subject to verification on job site and adjustment to fit job conditions.

2020

This is an original design and must not be released or copied unless applicable fee has been paid or job order placed.

Designed: 3/21/2025
Printed: 3/21/2025