

RAYWAL CABINETS

JUN BLD 8 - UNIT 241 - CIVIC 613

AS BUILT - MARCH 20 2025


NUVO - KITCHEN - UPPER UNIT

DOOR STYLE: MODENA
FINISH: COBBLESTONE
SPECIES: MAPLE
BOX INTERIOR: WHITE MELAMINE
HINGE: STANDARD


HARDWARE:116

COUNTERTOP: F7735-58

- DWKIT X 1
- VENT BOX X 1 (12"W x 9"D x 10 3/4")
- VENT BOX X 1 (30"W x 12"D x 14"H)
- KICKB96 X 2
- SCRIBE96 X 3

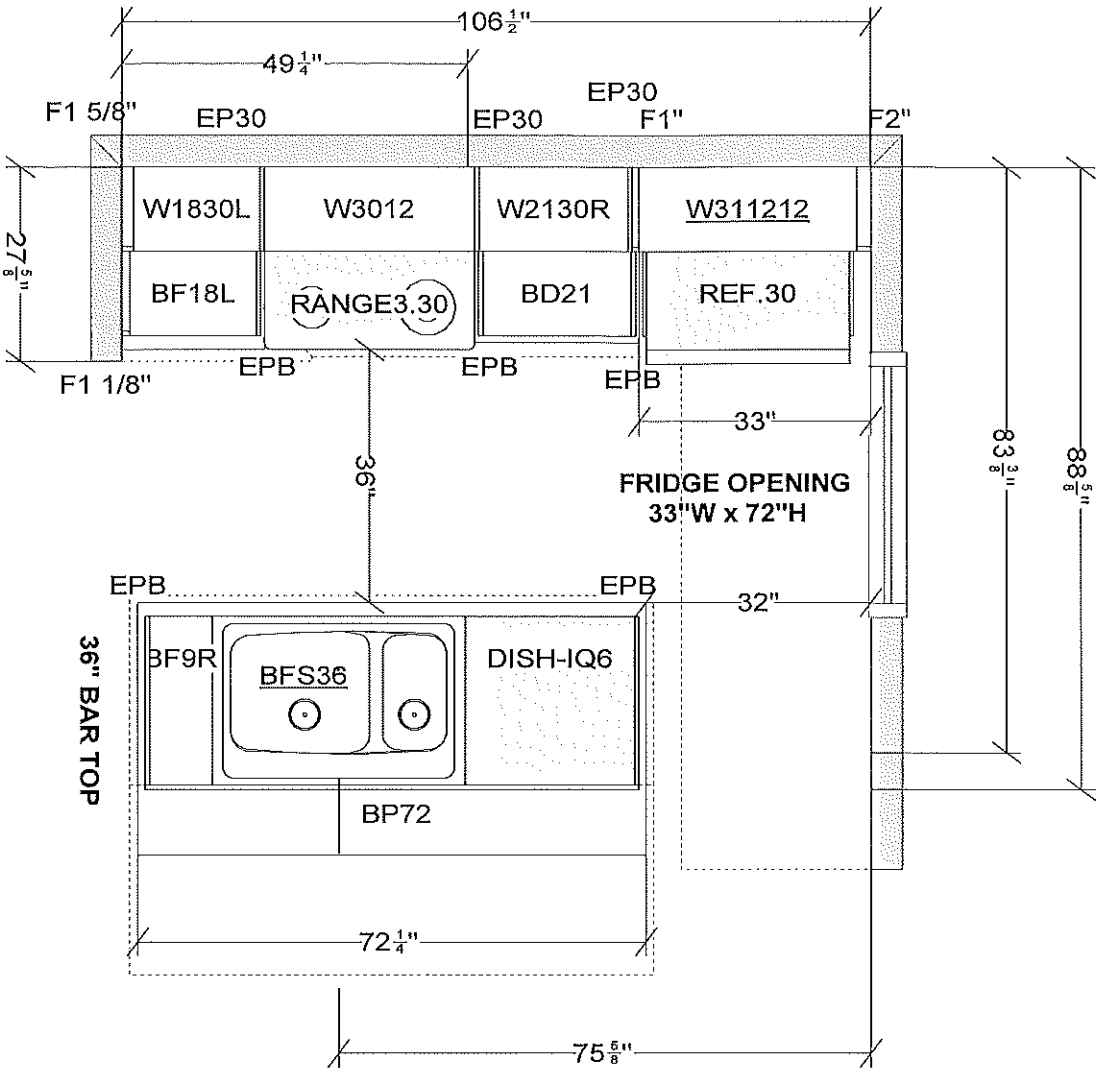

All dimensions size designations given are subject to verification on job site and adjustment to fit job conditions.	2020	This is an original design and must not be released or copied unless applicable fee has been paid or job order placed.	Designed: 3/20/2025 Printed: 3/20/2025	
NUVO - UPPER UNIT (KITCHEN)		All	Drawing #: 1	Scale : 0 7/16" 1'

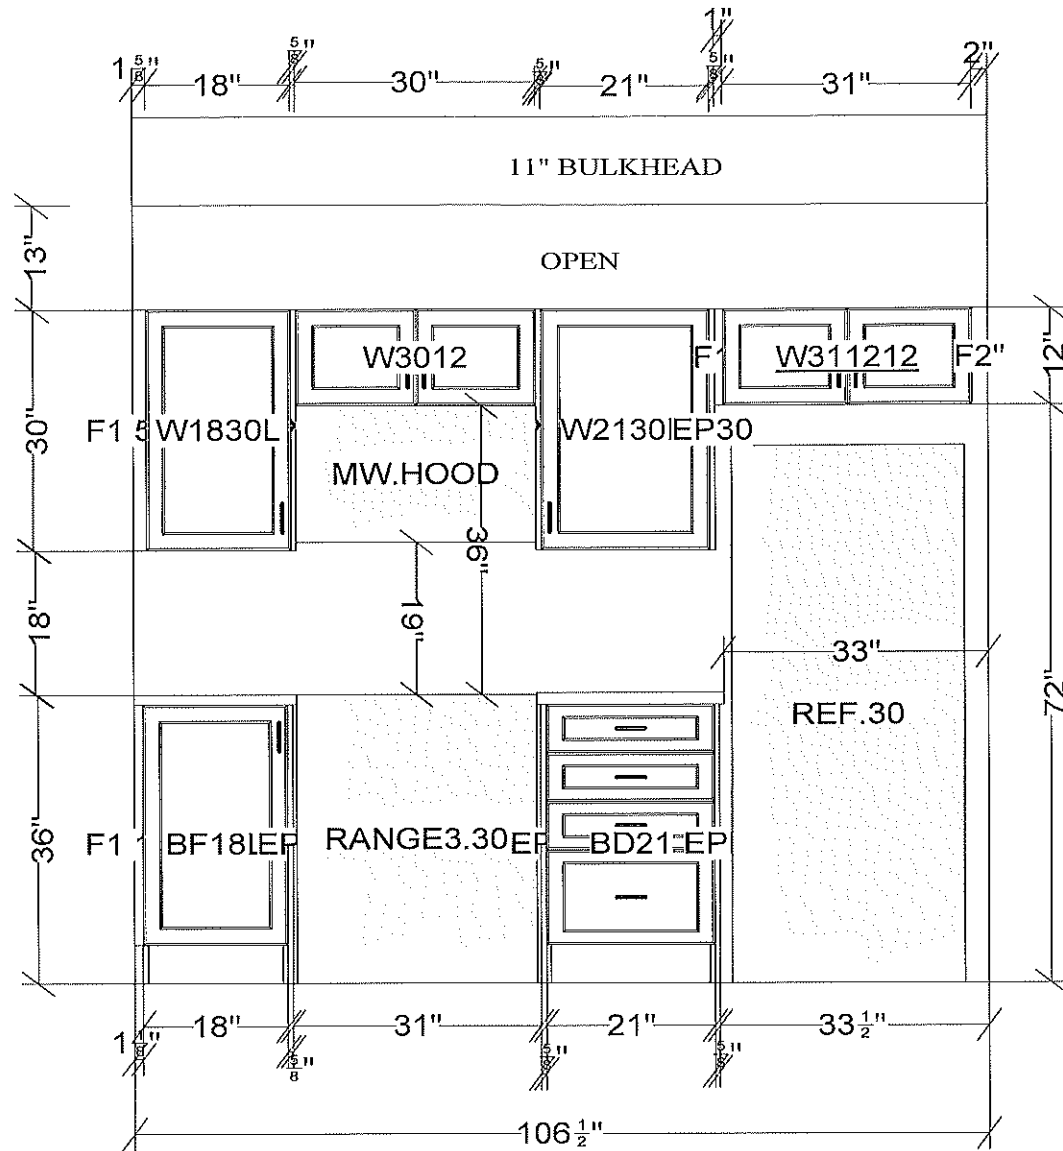


NO CROWN/BUILD UP - NO LIGHT VALANCE

All dimensions size designations given are subject to verification on job site and adjustment to fit job conditions.

2020

This is an original design and must not be released or copied unless applicable fee has been paid or job order placed.

Designed: 3/20/2025
Printed: 3/20/2025

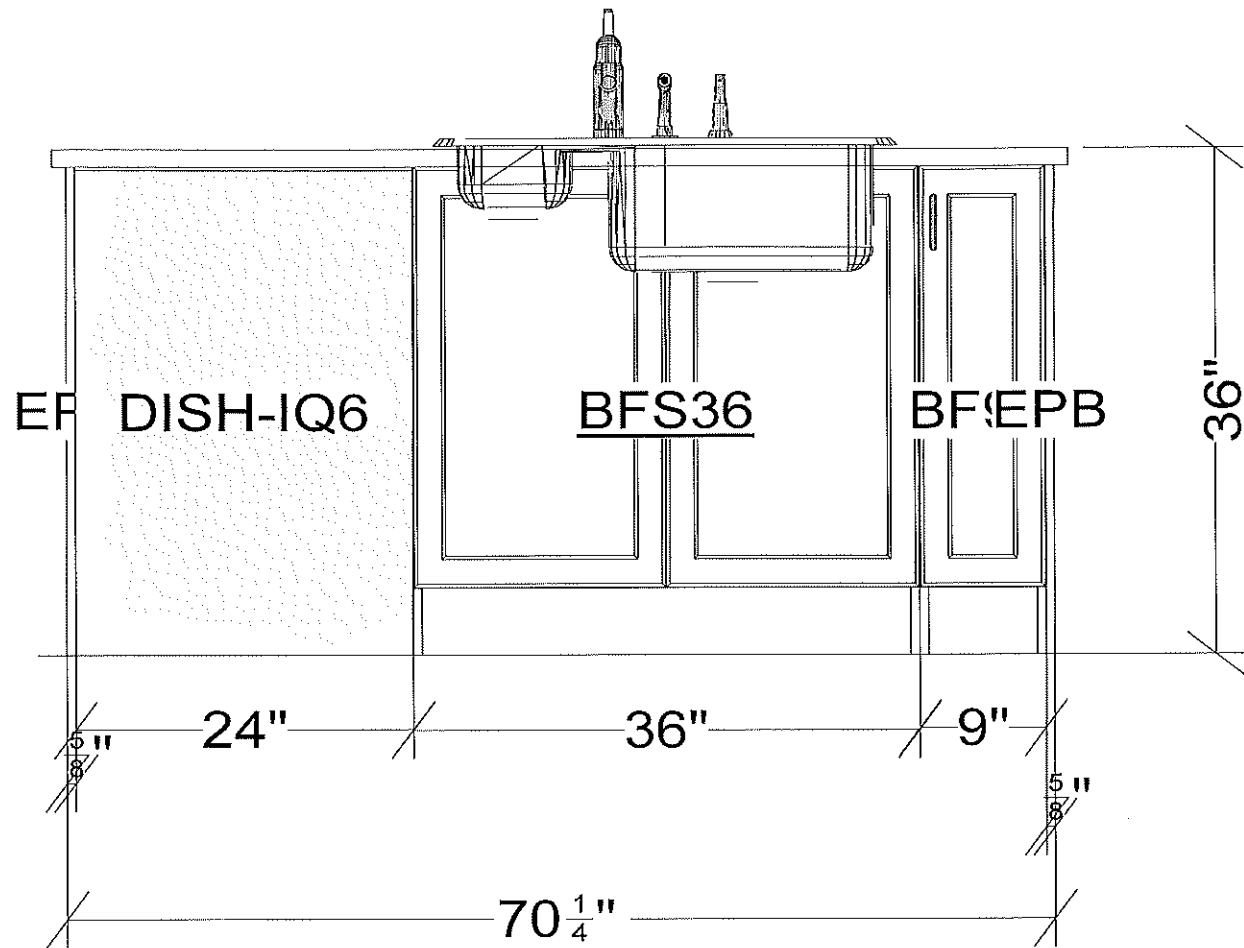

All dimensions, size designations given are subject to verification on job site and adjustment to fit job conditions.

2020

This is an original design and must not be released or copied unless applicable fee has been paid or job order placed.

Designed: 3/20/2025
Printed: 3/20/2025

RAYWAL CABINETS

JUN BLD 8 - UNIT 241 - CIVIC 613


AS BUILT - MARCH 20 2025

NUVO - POWDER ROOM - UPPER UNIT

DOOR STYLE: MODENA
FINISH: COBBLESTONE
SPECIES: MAPLE
BOX INTERIOR: WHITE MELAMINE
HINGE: STANDARD

HARDWARE: 116


COUNTERTOP: F7735-58

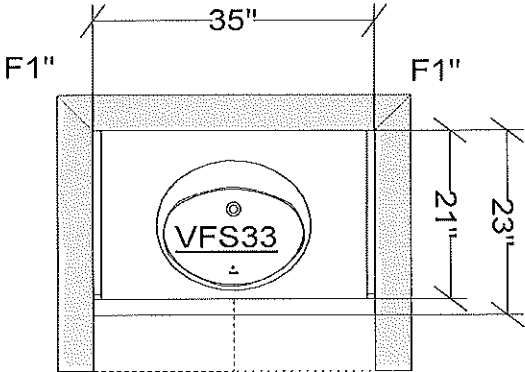

KICKB96 X 1
SCRIBE96 X 1

All dimensions size designations given are subject to verification on job site and adjustment to fit job conditions.	2020	This is an original design and must not be released or copied unless applicable fee has been paid or job order placed.	Designed: 3/20/2025 Printed: 3/20/2025	
NUVO- UPPER UNIT (POWDER ROOM)		All	Drawing #: 1	Scale : 0 1/2" 1'

POWDER ROOM

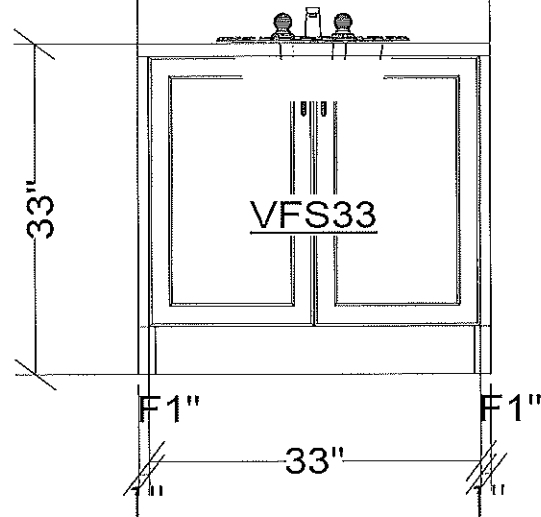

All dimensions size designations given are subject to verification on job site and adjustment to fit job conditions.

2020

This is an original design and must not be released or copied unless applicable fee has been paid or job order placed.

Designed: 3/20/2025
Printed: 3/20/2025

RAYWAL CABINETS

JUN BLD 8 - UNIT241 - CIVIC 613


AS BUILT - MARCH 20 2025

NUVO - MAIN - UPPER UNIT


DOOR STYLE: RETRO
FINISH: IRON
SPECIES: THERMOFOIL
BOX INTERIOR: WHITE MELAMINE
HINGE: STANDARD

HARDWARE:116

COUNTERTOP: W4925K-07

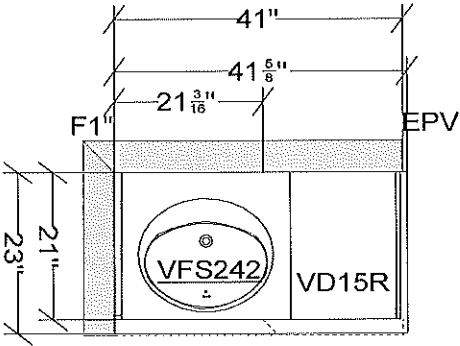


INSTALL 54" OVER TOILET

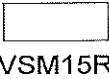

KICKB96 X 1
SCRIBE96 X 1

All dimensions .size designations given are subject to verification on job site and adjustment to fit job conditions.	2020	This is an original design and must not be released or copied unless applicable fee has been paid or job order placed.	Designed: 3/20/2025 Printed: 3/20/2025	
NUVO- UPPER UNIT (MAIN BATH)		All	Drawing #: 1	Scale : 0 7/16" 1'

MAIN

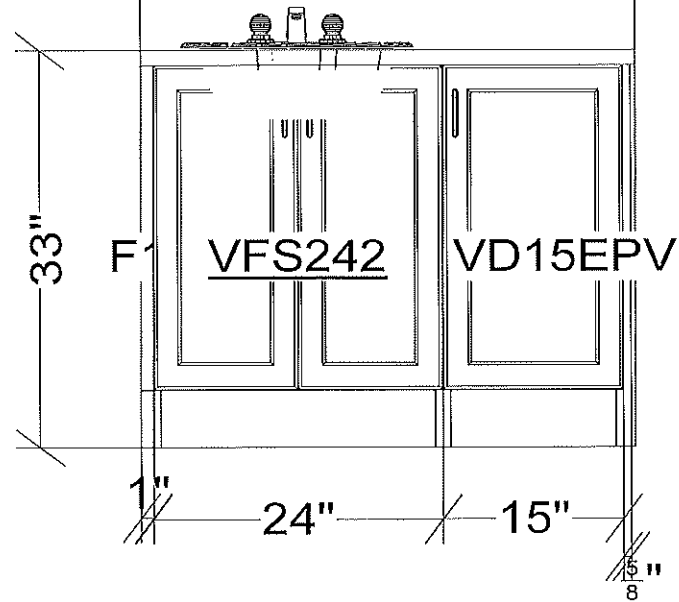

All dimensions size designations given are subject to verification on job site and adjustment to fit job conditions.

2020

This is an original design and must not be released or copied unless applicable fee has been paid or job order placed.

Designed: 3/20/2025
Printed: 3/20/2025

RAYWAL CABINETS
JUN BLD 8 - UNIT 241 - CIVIC 613
AS BUILT - MARCH 20 2025
NUVO - ENSUITE - UPPER UNIT


DOOR STYLE: RETRO
FINISH: DENIM
SPECIES: THERMOFOIL
BOX INTERIOR: WHITE MELAMINE
HINGE: STANDARD

HARDWARE:116
COUNTERTOP: F6314-58

INSTALL 54" OVER TOILET




VSM15R

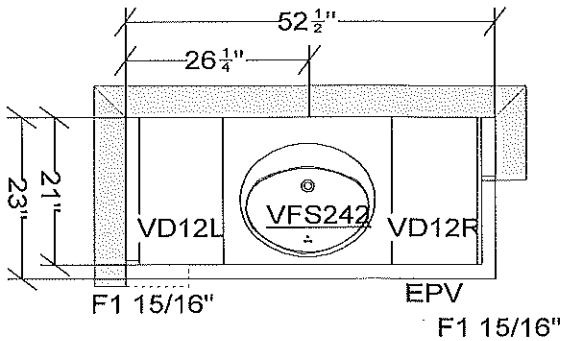

KICKB96 X 1
SCRIBE96 X 1

All dimensions _size designations given are subject to verification on job site and adjustment to fit job conditions.	2020	This is an original design and must not be released or copied unless applicable fee has been paid or job order placed.	Designed: 3/20/2025 Printed: 3/20/2025	
NUVO- UPPER UNIT (ENSUITE)		All	Drawing #: 1	Scale : 0 7/16" 1'

ENSUITE

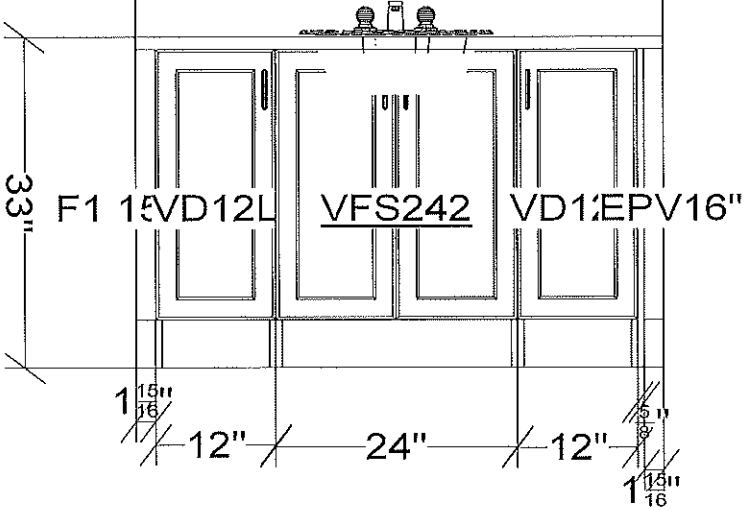

All dimensions _size designations given are subject to verification on job site and adjustment to fit job conditions.	2020	This is an original design and must not be released or copied unless applicable fee has been paid or job order placed.	Designed: 3/20/2025 Printed: 3/20/2025	
NUVO- UPPER UNIT (ENSUITE)		EI 1	Drawing #: 1	Scale : 0 5/8" 1'