

RAYWAL CABINETS

JUN BLD 8 - UNIT 245 - CIVIC 629


AS BUILT - MARCH 20 2025

NUVO - POWDER ROOM - UPPER UNIT

DOOR STYLE: RETRO
FINISH: DENIM
SPECIES: THERMOFOIL
BOX INTERIOR: WHITE MELAMINE
HINGE: STANDARD

HARDWARE:117


COUNTERTOP: N/A

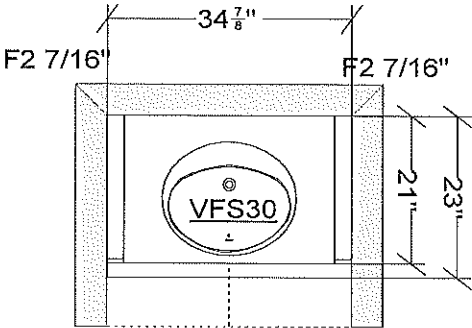

KICKB96 X 1
SCRIBE96 X 1

All dimensions _size designations given are subject to verification on job site and adjustment to fit job conditions.	2020	This is an original design and must not be released or copied unless applicable fee has been paid or job order placed.	Designed: 3/20/2025 Printed: 3/21/2025	
NUVO- UPPER UNIT (POWDER ROOM)		All	Drawing #: 1	Scale : 0 7/16" 1'

POWDER ROOM

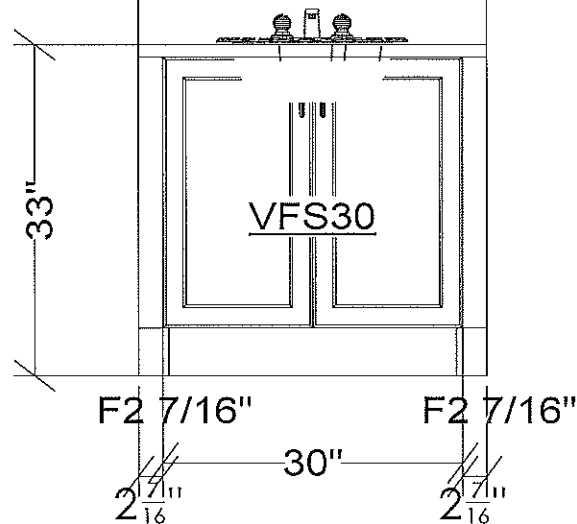

All dimensions .size designations
given are subject to verification on
job site and adjustment to fit job
conditions.

2020

This is an original design and must
not be released or copied unless
applicable fee has been paid or job
order placed.

Designed: 3/20/2025
Printed: 3/21/2025

RAYWAL CABINETS

JUN BLD 8 - UNIT245 - CIVIC 629


AS BUILT - MARCH 20 2025

NUVO - MAIN - UPPER UNIT


DOOR STYLE: RETRO
FINISH: COTTON
SPECIES: THERMOFOIL
BOX INTERIOR: WHITE MELAMINE
HINGE: STANDARD

HARDWARE:117

COUNTERTOP: N/A

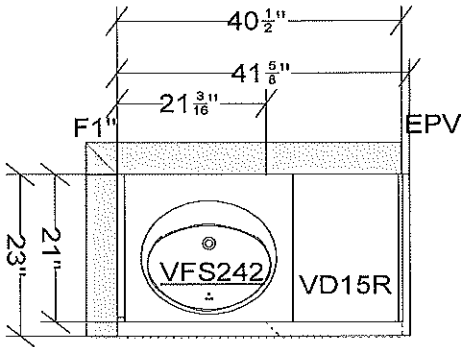


INSTALL 54" OVER TOILET

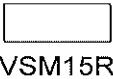

KICKB96 X 1
SCRIBE96 X 1

All dimensions .size designations given are subject to verification on job site and adjustment to fit job conditions.	2020	This is an original design and must not be released or copied unless applicable fee has been paid or job order placed.	Designed: 3/20/2025 Printed: 3/21/2025
NUVO- UPPER UNIT (MAIN BATH)	All	Drawing #: 1	Scale : 0 7/16" 1'

MAIN

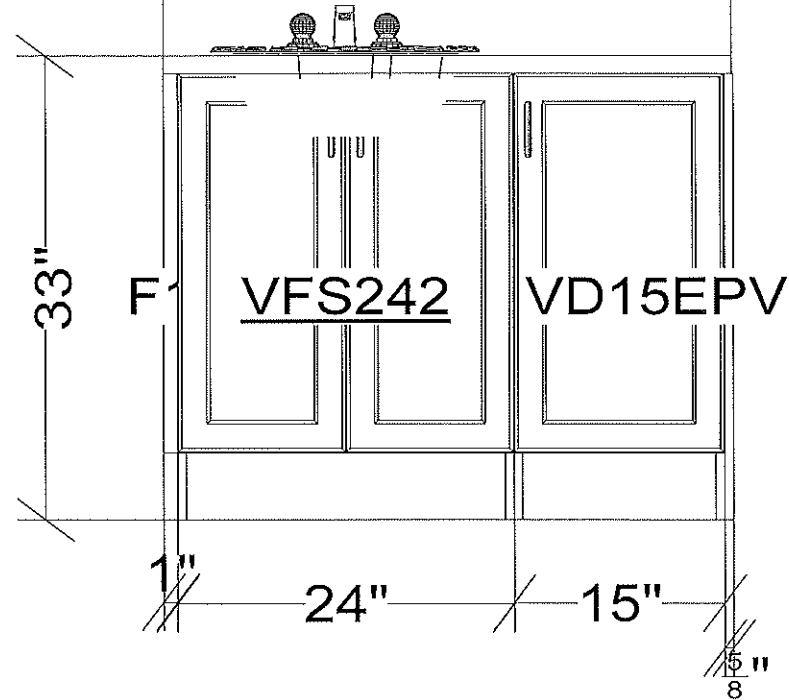

All dimensions .size designations
given are subject to verification on
job site and adjustment to fit job
conditions.

2020

This is an original design and must
not be released or copied unless
applicable fee has been paid or job
order placed.

Designed: 3/20/2025
Printed: 3/21/2025

NUVO- UPPER UNIT (MAIN BATH)

EI 1

Drawing #: 1

Scale : 0 7/8" 1'

RAYWAL CABINETS

JUN BLD 8 - UNIT 245 - CIVIC 629

AS BUILT - MARCH 20 2025



NUVO - ENSUITE - UPPER UNIT

DOOR STYLE: RETRO
FINISH: COTTON
SPECIES: THERMOFOIL
BOX INTERIOR: WHITE MELAMINE
HINGE: STANDARD

HARDWARE:117

COUNTERTOP: N/A


INSTALL 54" OVER TOILET

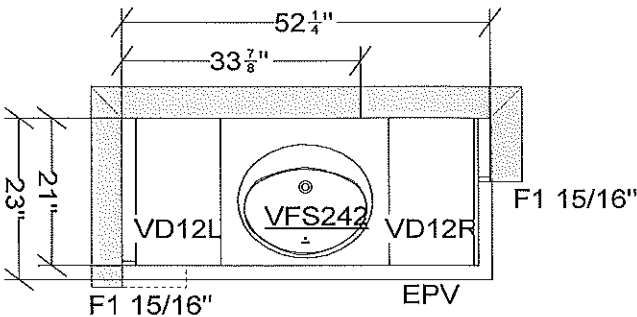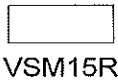

KICKB96 X 1
SCRIBE96 X 1

All dimensions .size designations given are subject to verification on job site and adjustment to fit job conditions.	2020	This is an original design and must not be released or copied unless applicable fee has been paid or job order placed.	Designed: 3/20/2025 Printed: 3/21/2025	
NUVO- UPPER UNIT (ENSUITE)		All	Drawing #: 1	Scale : 0 7/16" 1'

ENSUITE

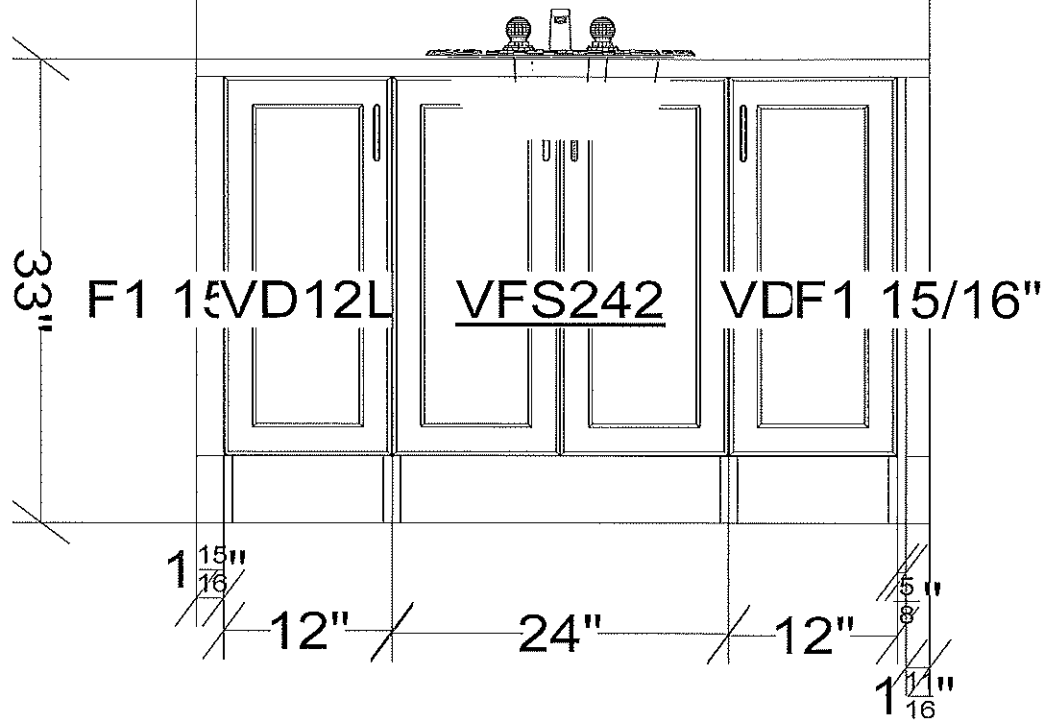

All dimensions .size designations given are subject to verification on job site and adjustment to fit job conditions.	2020	This is an original design and must not be released or copied unless applicable fee has been paid or job order placed.	Designed: 3/20/2025 Printed: 3/21/2025
NUVO- UPPER UNIT (ENSUITE)	El 1	Drawing #: 1	Scale : 0 7/8" 1'


RAYWAL CABINETS
JUN BLD 8 - UNIT 245 - CIVIC 629
AS BUILT - MARCH 20 2025
NUVO - KITCHEN - UPPER UNIT

DOOR STYLE: RETRO
FINISH: COTTON
SPECIES: THERMOFOIL
BOX INTERIOR: WHITE MELAMINE
HINGE: STANDARD

HARDWARE:117
COUNTERTOP:N/A

DWKIT X 1
VENT BOX X 1 (12"W x 9"D x 10 3/4")
VENT BOX X 1 (30"W x 12"D x 14"H)

KICKB96 X 2
SCRIBE96 X 3

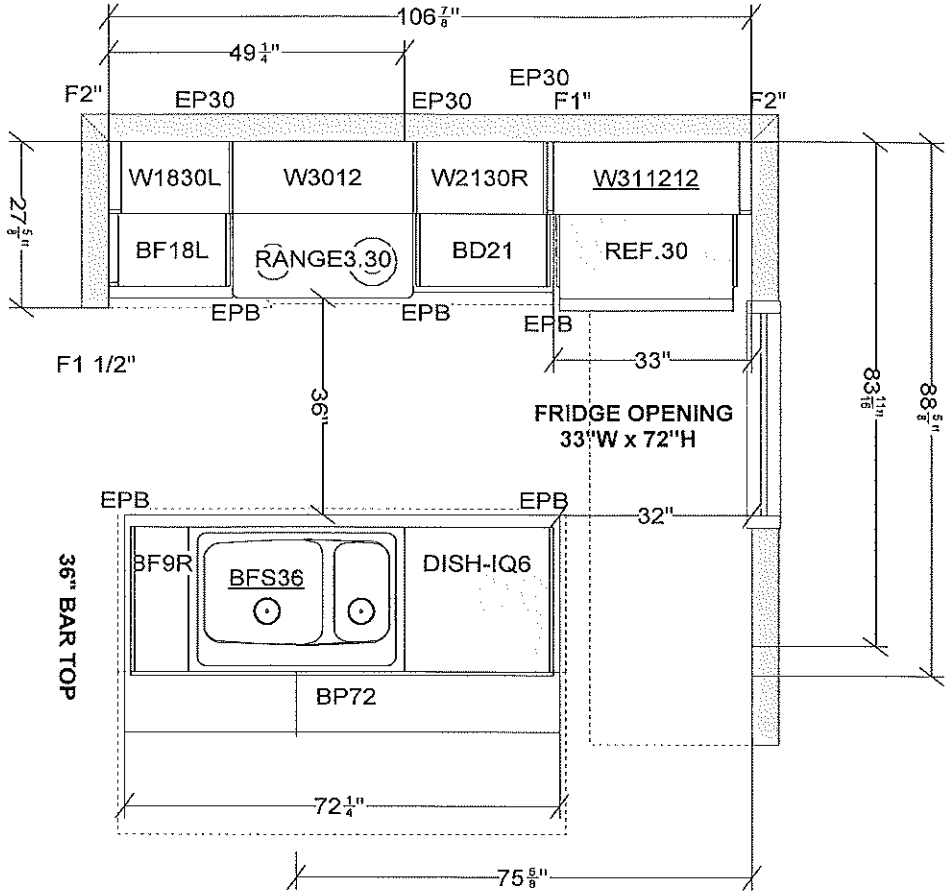


All dimensions size designations
given are subject to verification on
job site and adjustment to fit job
conditions.


2020

This is an original design and must
not be released or copied unless
applicable fee has been paid or job
order placed.

Designed: 3/20/2025
Printed: 3/21/2025

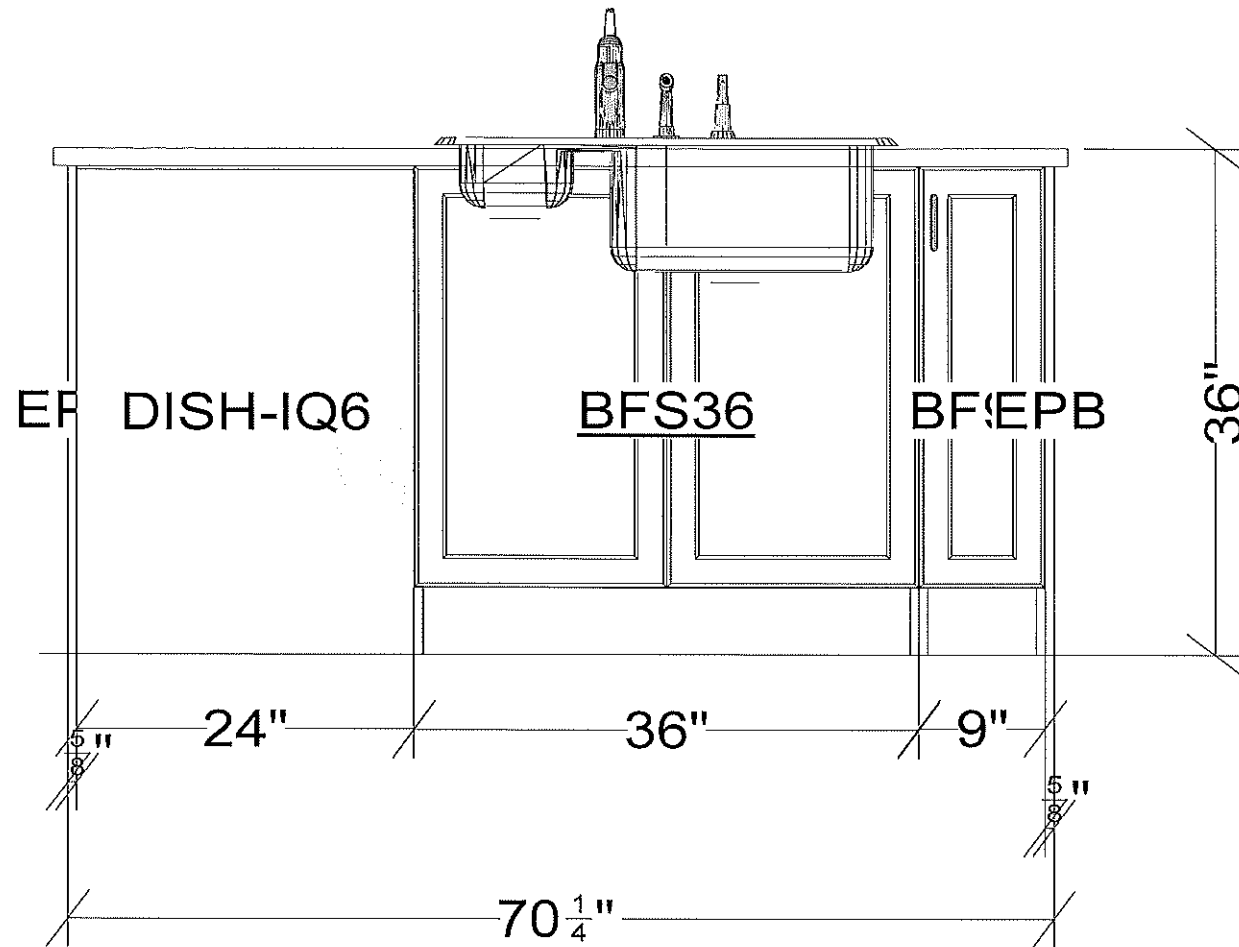

All dimensions and size designations given are subject to verification on job site and adjustment to fit job conditions.	2020	This is an original design and must not be released or copied unless applicable fee has been paid or job order placed.	Designed: 3/20/2025 Printed: 3/21/2025
NUVO - UPPER UNIT (KITCHEN)	El 2	Drawing #: 1	Scale : 0 7/8" 1'

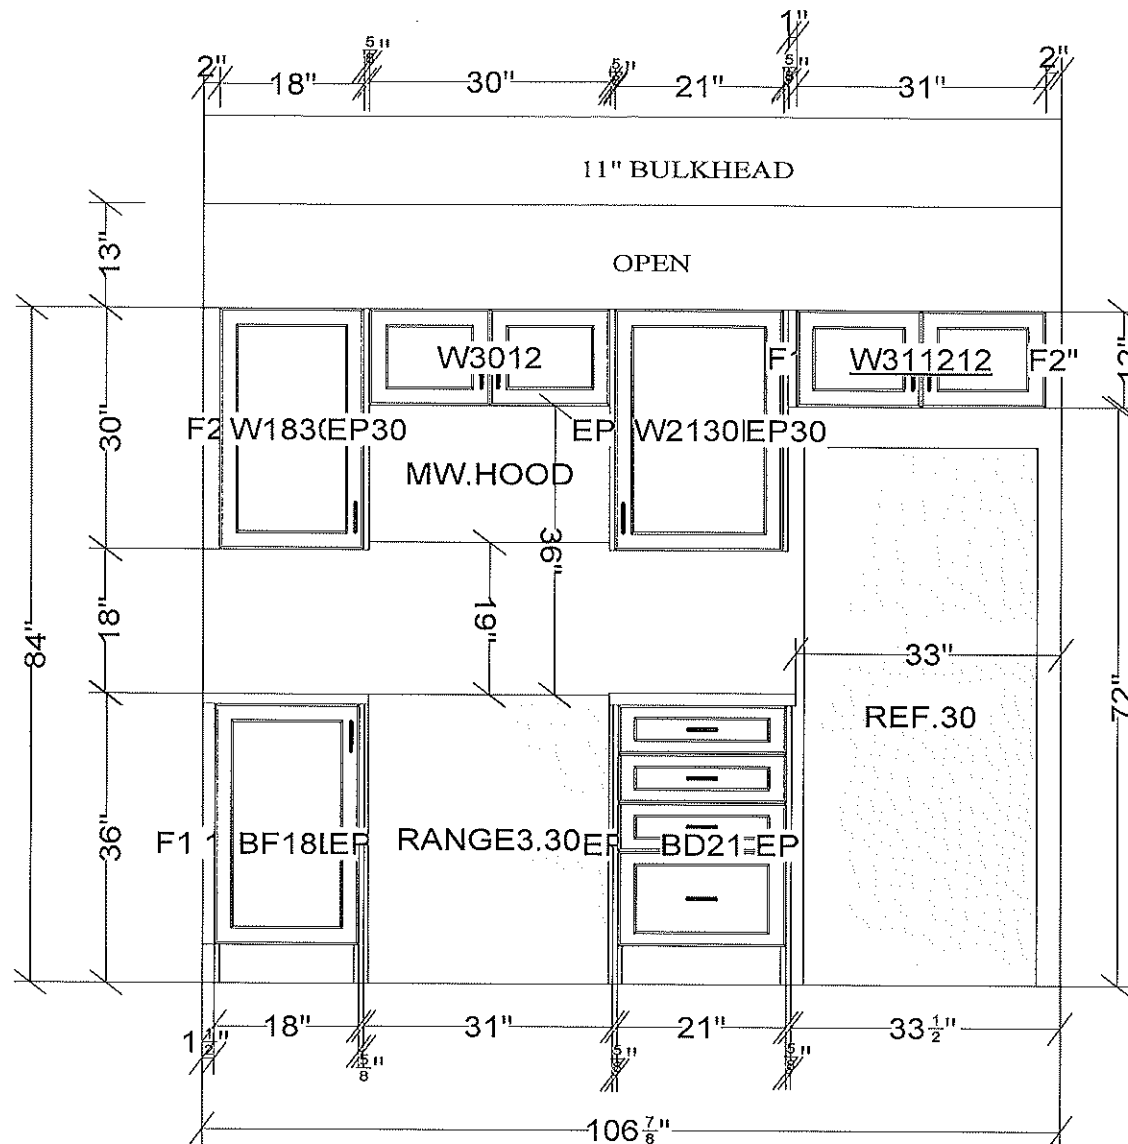

NO CROWN/BUILD UP - NO LIGHT VALANCE

All dimensions, size designations given are subject to verification on job site and adjustment to fit job conditions.

2020

This is an original design and must not be released or copied unless applicable fee has been paid or job order placed.

Designed: 3/20/2025
Printed: 3/21/2025