

RAYWAL CABINETS

JUN BLD 8 - UNIT 246 - CIVIC 627

AS BUILT - MARCH 20 2025

NUVO - KITCHEN - UPPER UNIT


DOOR STYLE: MANCINI
FINISH: ALPINE
SPECIES: MELAMINE
BOX INTERIOR: WHITE MELAMINE
HINGE: STANDARD

HARDWARE: 143

COUNTERTOP: N/A

DWKIT X 1
VENT BOX X 1 (12"W x 9"D x 10 3/4")
VENT BOX X 1 (30"W x 12"D x 14"H)

KICKB96 X 2
SCRIBE96 X 3

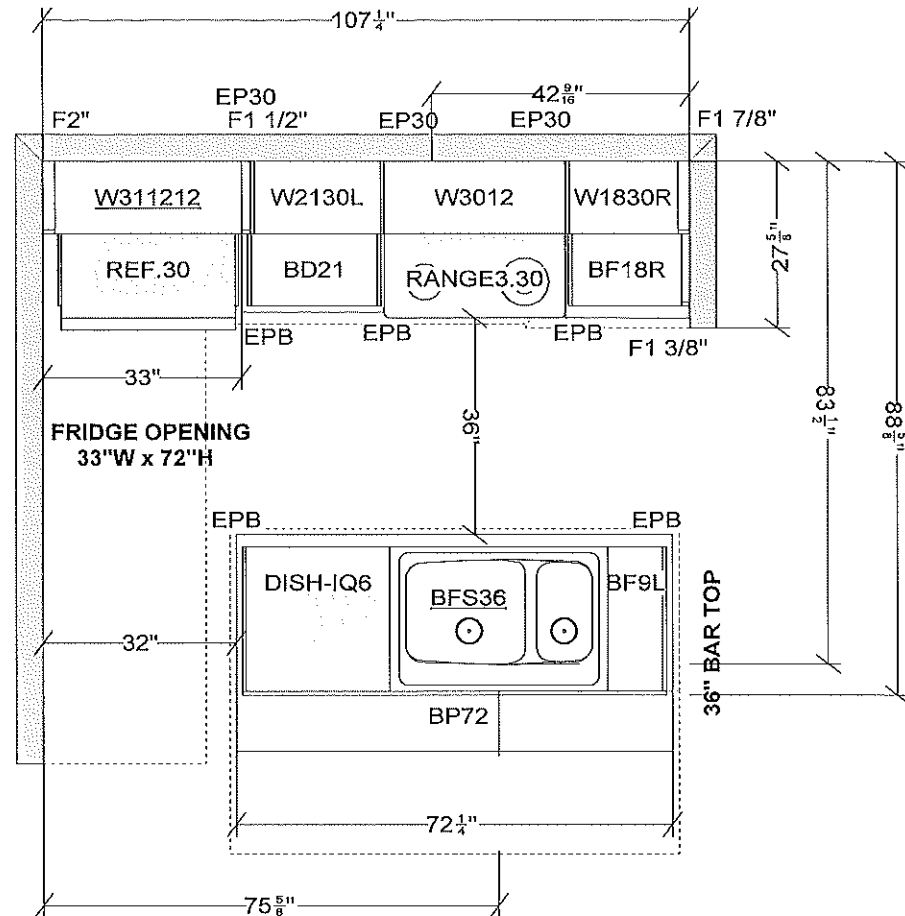

All dimensions and size designations given are subject to verification on job site and adjustment to fit job conditions.

2020

This is an original design and must not be released or copied unless applicable fee has been paid or job order placed.


Designed: 3/20/2025
Printed: 3/20/2025

NUVO - UPPER UNIT (KITCHEN)

All

Drawing #: 1

Scale : 0 3/8" 1'

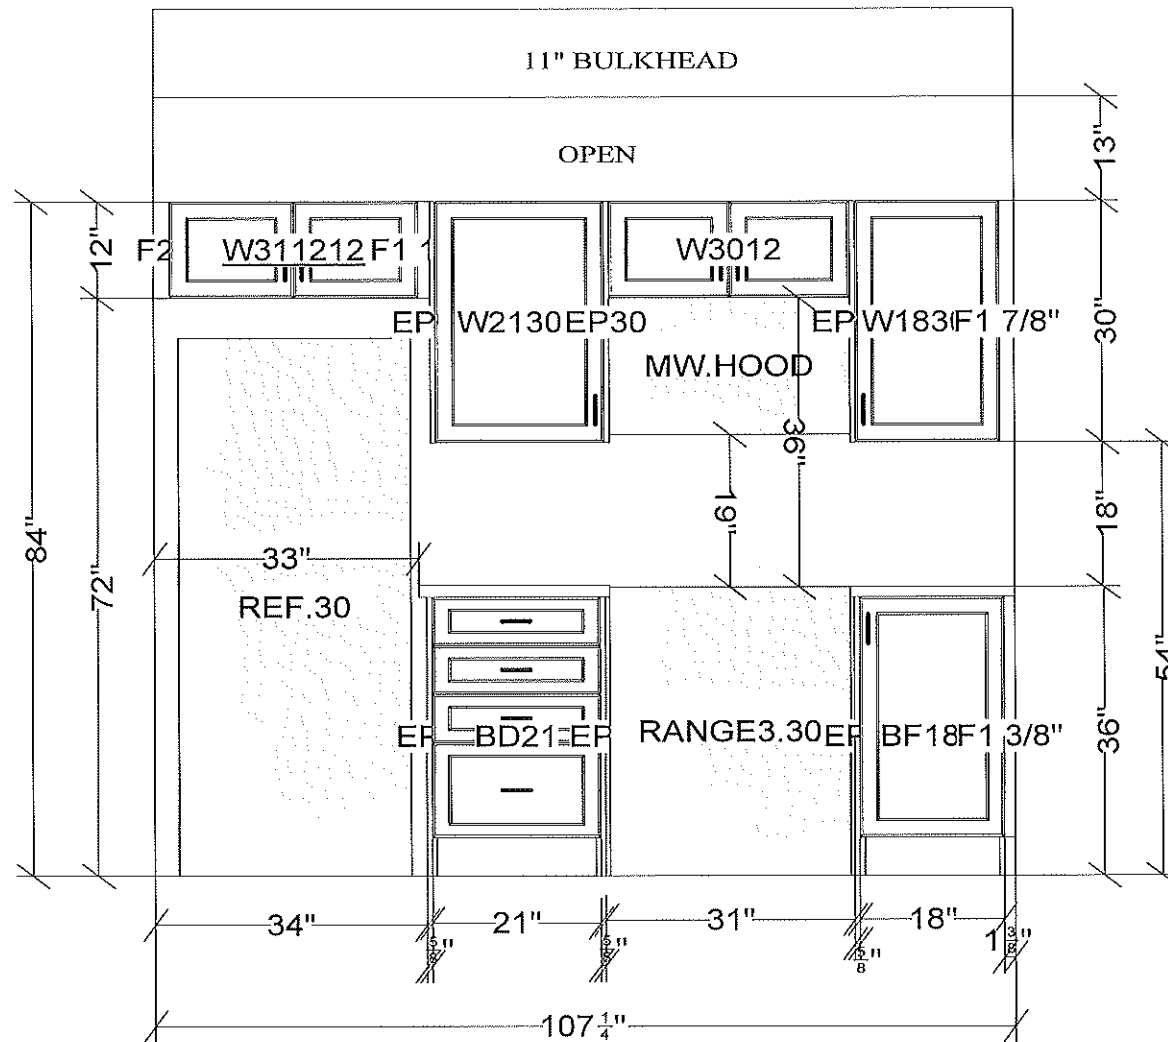

NO CROWN - NO BUILD-UP - NO LIGHT VALANCE

All dimensions, size designations given are subject to verification on job site and adjustment to fit job conditions.

2020

This is an original design and must not be released or copied unless applicable fee has been paid or job order placed.


Designed: 3/20/2025
Printed: 3/20/2025

NUVO - UPPER UNIT (KITCHEN)

EI 1

Drawing #: 1

Scale : 0 1/2" 1'

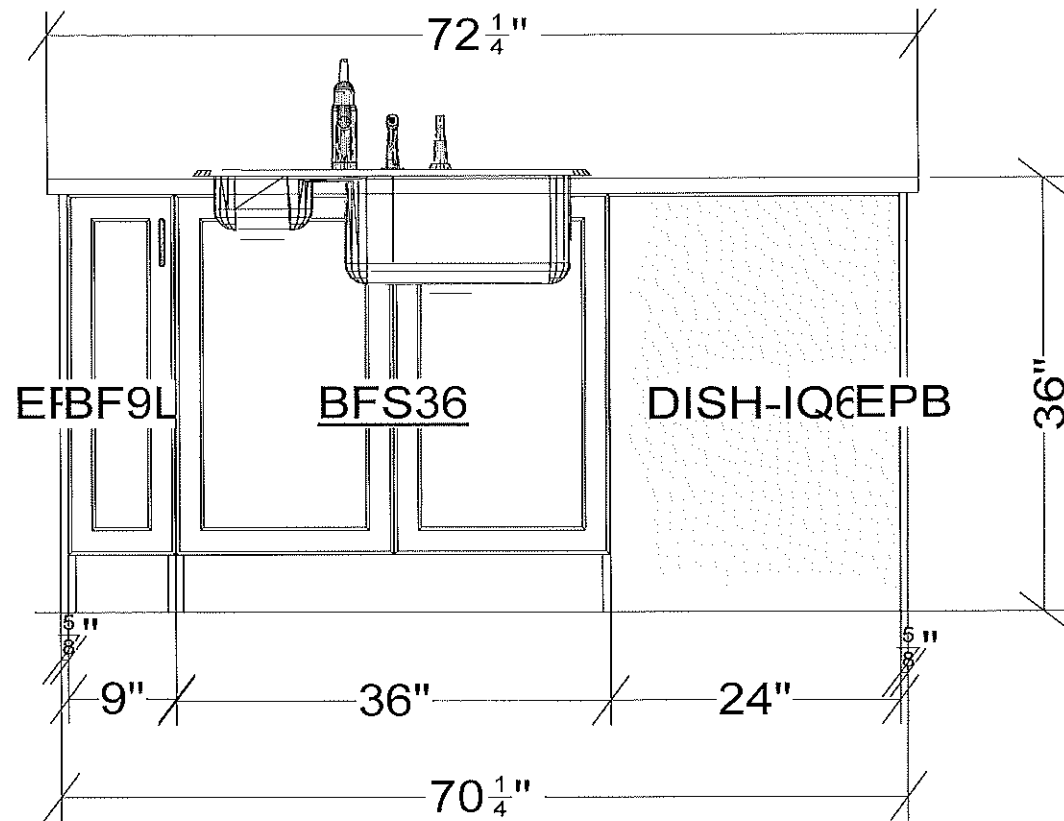

All dimensions and size designations given are subject to verification on job site and adjustment to fit job conditions.

2020

This is an original design and must not be released or copied unless applicable fee has been paid or job order placed.


Designed: 3/20/2025
Printed: 3/20/2025

RAYWAL CABINETS
JUN BLD 8 - UNIT 246 - CIVIC 627
AS BUILT - MARCH 20 2025
NUVO - POWDER ROOM - UPPER UNIT

DOOR STYLE: MANCINI
FINISH: ALPINE
SPECIES: MELAMINE
BOX INTERIOR: WHITE MELAMINE
HINGE: STANDARD

HARDWARE:143


COUNTERTOP: N/A

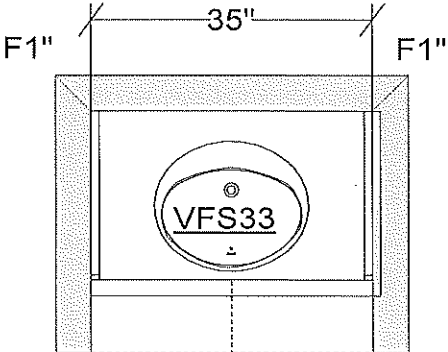

KICKB96 X 1
SCRIBE96 X 1

All dimensions _size designations given are subject to verification on job site and adjustment to fit job conditions.	2020	This is an original design and must not be released or copied unless applicable fee has been paid or job order placed.	Designed: 3/20/2025 Printed: 3/20/2025	
NUVO- UPPER UNIT (POWDER ROOM)		All	Drawing #: 1	Scale : 0 1/2" 1'

POWDER ROOM

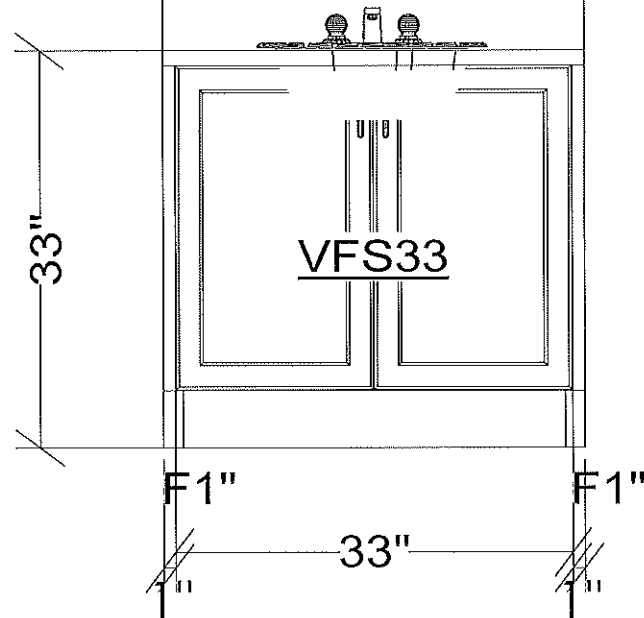

All dimensions and size designations given are subject to verification on job site and adjustment to fit job conditions.	2020	This is an original design and must not be released or copied unless applicable fee has been paid or job order placed.	Designed: 3/20/2025 Printed: 3/20/2025
NUVO- UPPER UNIT (POWDER ROOM)			Scale : 0 3/4" 1'



RAYWAL CABINETS
JUN BLD 8 - UNIT246 - CIVIC 627
AS BUILT - MARCH 20 2025
NUVO - MAIN - UPPER UNIT

DOOR STYLE: MANCINI
FINISH: ALPINE
SPECIES: MELAMINE
BOX INTERIOR: WHITE MELAMINE
HINGE: STANDARD

HARDWARE:143

COUNTERTOP: N/A


INSTALL 54" OVER TOILET

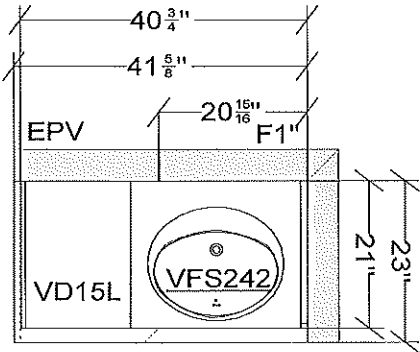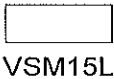

KICKB96 X 1
SCRIBE96 X 1

All dimensions and size designations given are subject to verification on job site and adjustment to fit job conditions.	2020	This is an original design and must not be released or copied unless applicable fee has been paid or job order placed.	Designed: 3/19/2025 Printed: 3/20/2025	
NUVO- UPPER UNIT (MAIN BATH)		All	Drawing #: 1	Scale : 0 7/16" 1'

MAIN

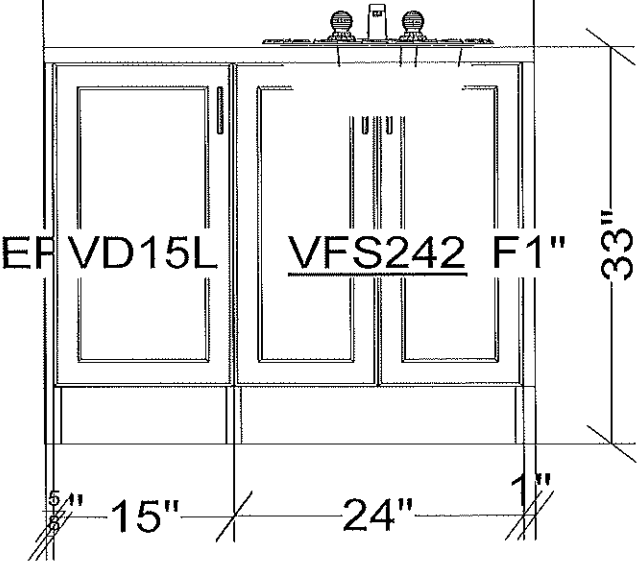

All dimensions size designations given are subject to verification on job site and adjustment to fit job conditions.	2020	This is an original design and must not be released or copied unless applicable fee has been paid or job order placed.	Designed: 3/19/2025 Printed: 3/20/2025	
NUVO- UPPER UNIT (MAIN BATH)		El 1	Drawing #: 1	Scale : 0 3/4" 1'

RAYWAL CABINETS

JUN BLD 8 - UNIT 246 - CIVIC 627


AS BUILT - MARCH 20 2025

NUVO - ENSUITE - UPPER UNIT


DOOR STYLE: MANCINI
FINISH: ALPINE
SPECIES: MELAMINE
BOX INTERIOR: WHITE MELAMINE
HINGE: STANDARD

HARDWARE: 143

COUNTERTOP: N/A

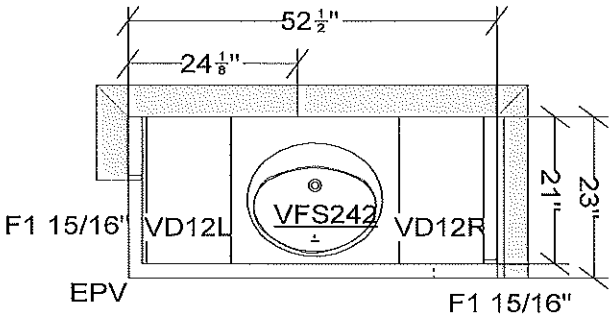

INSTALL 54" OVER TOILET

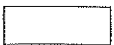


VSM15L

KICKB96 X 1
SCRIBE96 X 1

All dimensions .size designations given are subject to verification on job site and adjustment to fit job conditions.	2020	This is an original design and must not be released or copied unless applicable fee has been paid or job order placed.	Designed: 3/20/2025 Printed: 3/20/2025	
NUVO- UPPER UNIT (ENSUITE)		All	Drawing #: 1	Scale : 0 7/16" 1'

ENSUITE

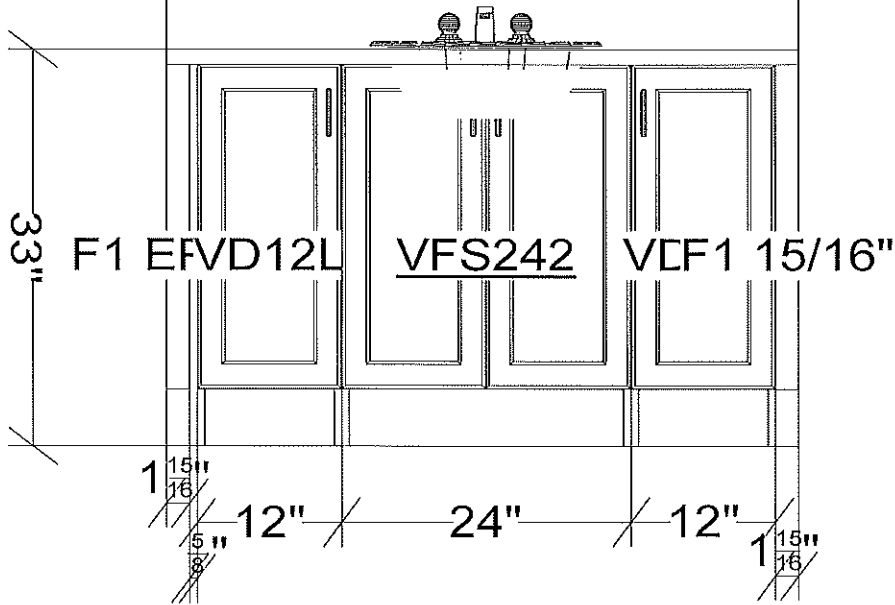

All dimensions _size designations given are subject to verification on job site and adjustment to fit job conditions.	2020	This is an original design and must not be released or copied unless applicable fee has been paid or job order placed.	Designed: 3/20/2025 Printed: 3/20/2025	
NUVO- UPPER UNIT (ENSUITE)		EI 1	Drawing #: 1	Scale : 0 3/4" 1'