

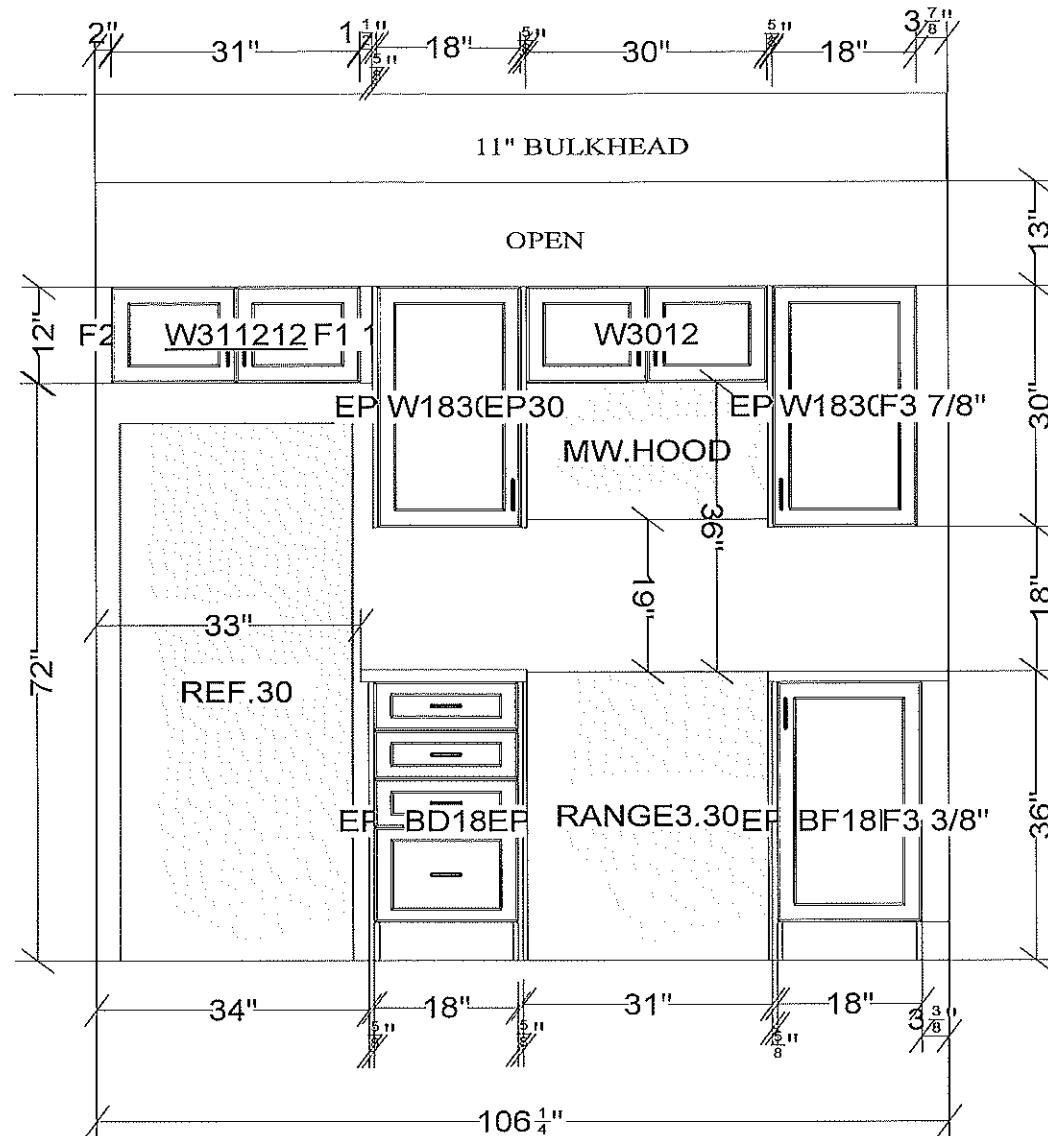


NUVO - KITCHEN - UPPER UNIT

KICKB96 X 2  
SCRIBE96 X 3



All dimensions & size designations given are subject to verification on job site and adjustment to fit job conditions.		This is an original design and must not be released or copied unless applicable fee has been paid or job order placed.	Designed: 3/20/2025 Printed: 3/20/2025	
NUVO - UPPER UNIT (KITCHEN)	All	Drawing #: 1	Scale : 0 3/8" 1'	

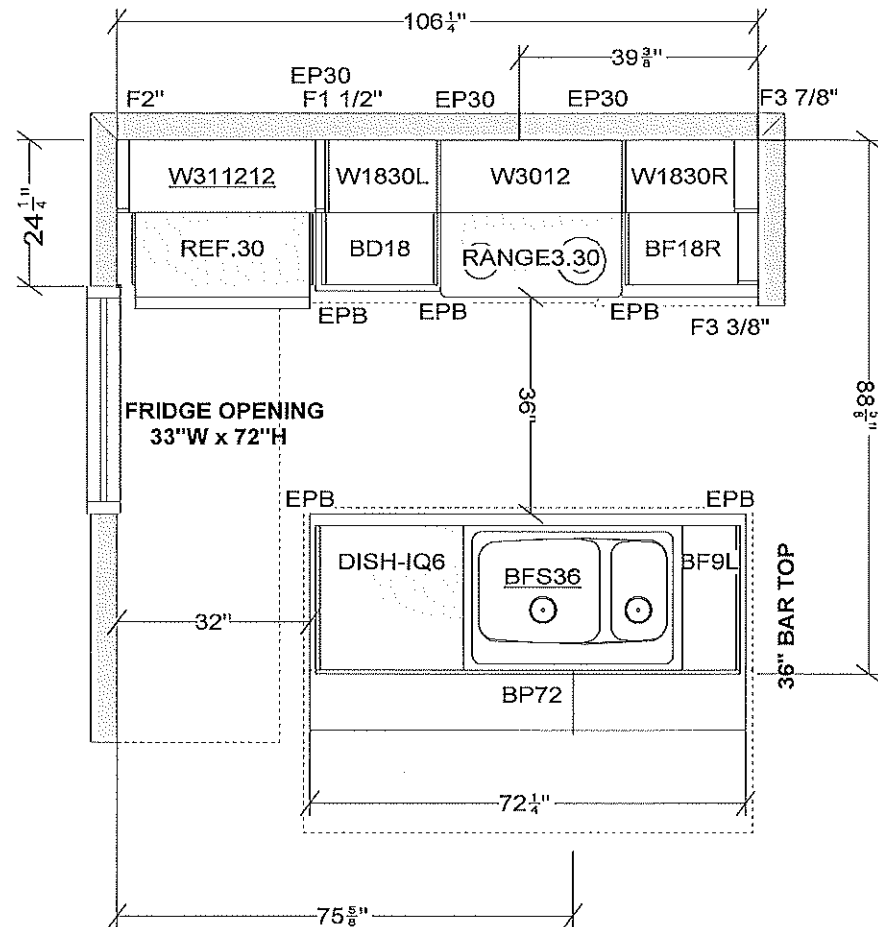


NO CROWN OR BUILD-UP / NO LIGHT VALANCE

All dimensions, size designations given are subject to verification on job site and adjustment to fit job conditions.

2020

This is an original design and must not be released or copied unless applicable fee has been paid or job order placed.


Designed: 3/20/2025  
Printed: 3/20/2025

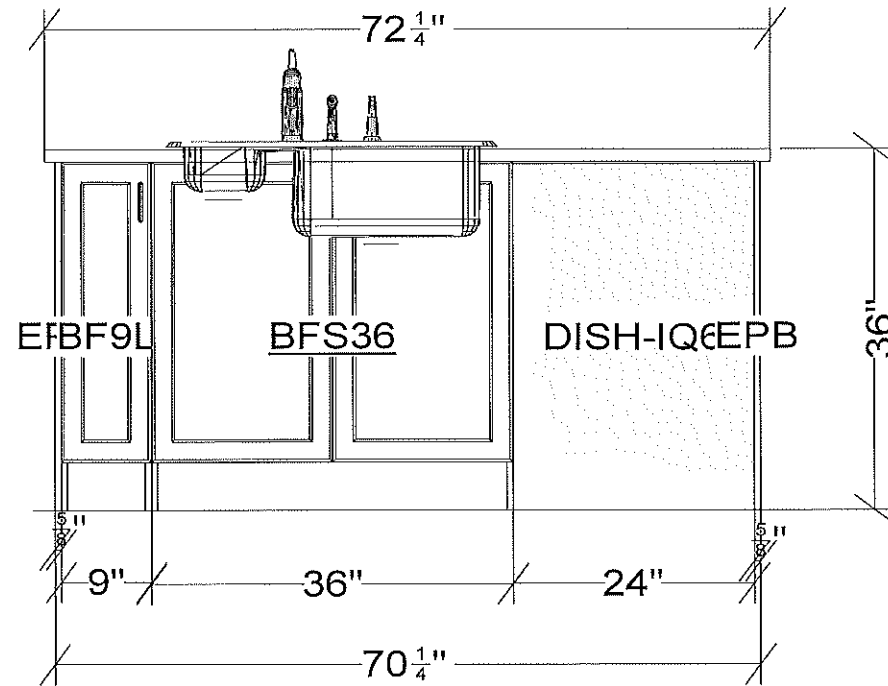

All dimensions _size designations given are subject to verification on job site and adjustment to fit job conditions.	2020	This is an original design and must not be released or copied unless applicable fee has been paid or job order placed.	Designed: 3/20/2025 Printed: 3/20/2025
NUVO - UPPER UNIT (KITCHEN)	El 2	Drawing #: 1	Scale : 0 5/8" 1'

RAYWAL CABINETS  
JUN BLD 8 - UNIT 248 - CIVIC 619  
AS BUILT - MARCH 19 2025  
NUVO - POWDER ROOM - UPPER UNIT


DOOR STYLE: MANCINI  
FINISH: ASHLAND  
SPECIES: MELAMINE  
BOX INTERIOR: WHITE MELAMINE  
HINGE: STANDARD  
  
HARDWARE:143  
COUNTERTOP: W4925K-07

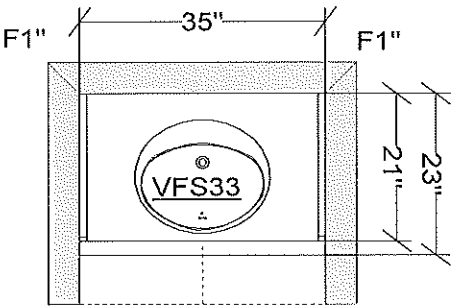

KICKB96 X 1  
SCRIBE96 X 1

All dimensions _size designations given are subject to verification on job site and adjustment to fit job conditions.	2020	This is an original design and must not be released or copied unless applicable fee has been paid or job order placed.	Designed: 3/20/2025 Printed: 3/20/2025	
NUVO- UPPER UNIT (POWDER ROOM)		All	Drawing #: 1	Scale : 0 7/16" 1'

POWDER ROOM

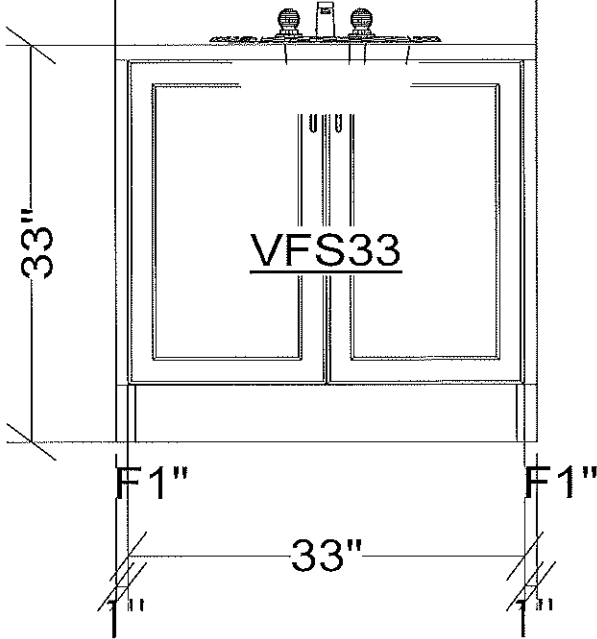

All dimensions _size designations given are subject to verification on job site and adjustment to fit job conditions.	2020	This is an original design and must not be released or copied unless applicable fee has been paid or job order placed.	Designed: 3/20/2025 Printed: 3/20/2025	
NUVO- UPPER UNIT (POWDER ROOM)		E1 4	Drawing #: 1	Scale : 0 3/4" 1'

RAYWAL CABINETS

JUN BLD 8 - UNIT248 - CIVIC 619

AS BUILT - MARCH 20 2025

NUVO - MAIN - UPPER UNIT

DOOR STYLE: RETRO  
FINISH: DENIM  
SPECIES: THERMOFOIL  
BOX INTERIOR: WHITE MELAMINE  
HINGE: STANDARD


HARDWARE:143

COUNTERTOP: F9306-58

INSTALL 54" OVER TOILET




VSM15L

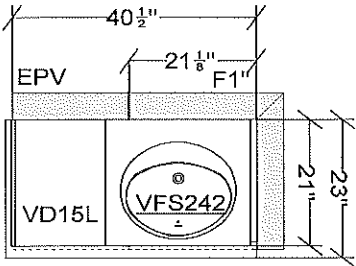

KICKB96 X 1  
SCRIBE96 X 1

All dimensions _size designations given are subject to verification on job site and adjustment to fit job conditions.	2020	This is an original design and must not be released or copied unless applicable fee has been paid or job order placed.	Designed: 3/20/2025 Printed: 3/20/2025	
NUVO- UPPER UNIT (MAIN BATH)		All	Drawing #: 1	Scale : 0 3/8" 1'

MAIN

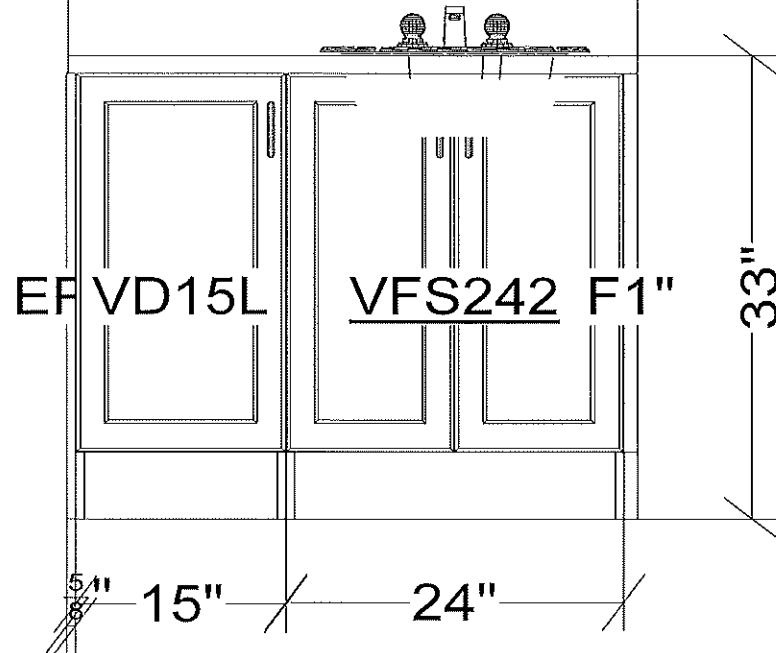

All dimensions \_size designations given are subject to verification on job site and adjustment to fit job conditions.

2020

This is an original design and must not be released or copied unless applicable fee has been paid or job order placed.

Designed: 3/20/2025  
Printed: 3/20/2025

RAYWAL CABINETS


JUN BLD 8 - UNIT 248 - CIVIC 619

AS BUILT - MARCH 19 2025

NUVO - ENSUITE - UPPER UNIT

DOOR STYLE: RETRO  
FINISH: DENIM  
SPECIES: THERMOFOIL  
BOX INTERIOR: WHITE MELAMINE  
HINGE: STANDARD

HARDWARE:143  
COUNTERTOP: F9306-58

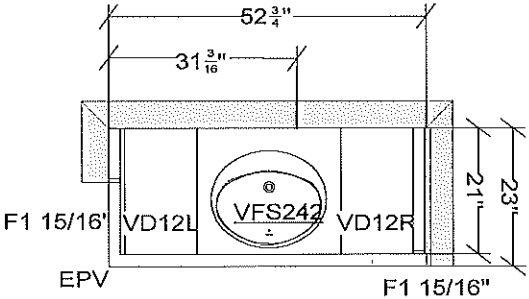


INSTALL 54" OVER TOILET



KICKB96 X 1  
SCRIBE96 X 1

All dimensions _size designations given are subject to verification on job site and adjustment to fit job conditions.	2020	This is an original design and must not be released or copied unless applicable fee has been paid or job order placed.	Designed: 3/20/2025 Printed: 3/20/2025	
NUVO- UPPER UNIT (ENSUITE)		All	Drawing #: 1	Scale : 0 3/8" 1'

ENSUITE

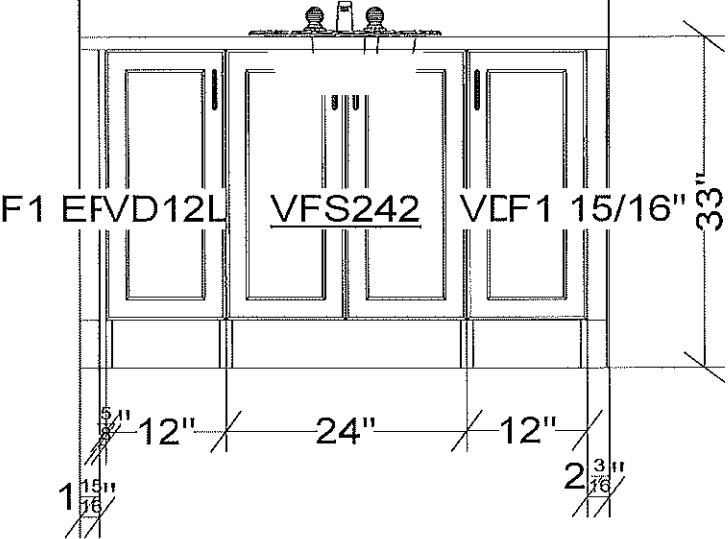

All dimensions size designations given are subject to verification on job site and adjustment to fit job conditions.	2020	This is an original design and must not be released or copied unless applicable fee has been paid or job order placed.	Designed: 3/20/2025 Printed: 3/20/2025	
			NUVO- UPPER UNIT (ENSUITE)	El 1      Drawing #: 1      Scale : 0 5/8" 1'