

RAYWAL CABINETS

JUN BLD 8 - UNIT 247 - CIVIC 621

AS BUILT - MARCH 20 2025

NUVO - KITCHEN - UPPER UNIT


DOOR STYLE: MODENA  
FINISH: OLIVE GREEN  
SPECIES: MAPLE  
BOX INTERIOR: WHITE MELAMINE  
HINGE: STANDARD

HARDWARE:137

COUNTERTOP: N/A

DWKIT X 1  
VENT BOX X 1 (12"W x 9"D x 10 3/4")  
VENT BOX X 1 (30"W x 12"D x 14"H)

KICKB96 X 2  
SCRIBE96 X 3

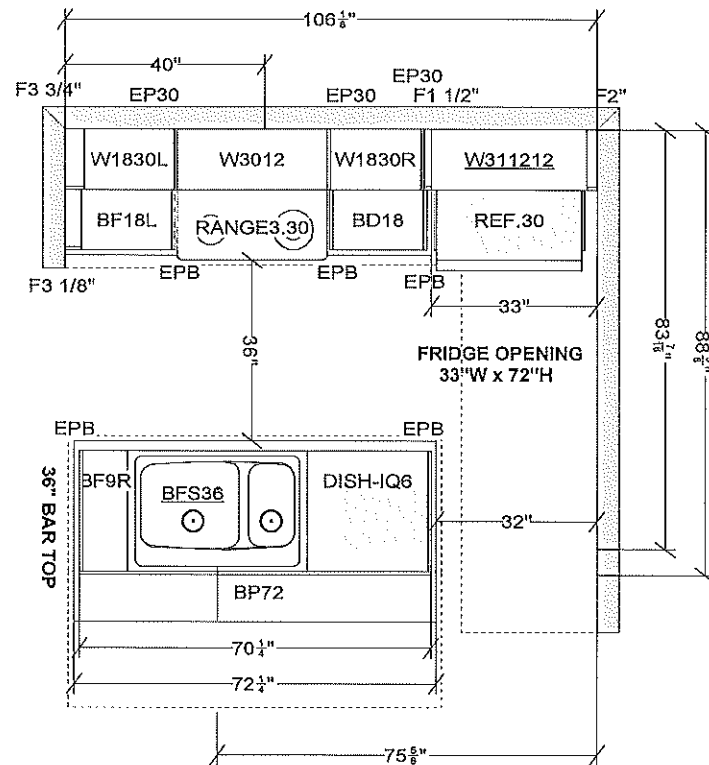

All dimensions and size designations given are subject to verification on job site and adjustment to fit job conditions.

2020

This is an original design and must not be released or copied unless applicable fee has been paid or job order placed.


Designed: 3/21/2025  
Printed: 4/3/2025

NUVO - UPPER UNIT (KITCHEN)

All

Drawing #: 1

Scale : 0 5/16" 1'

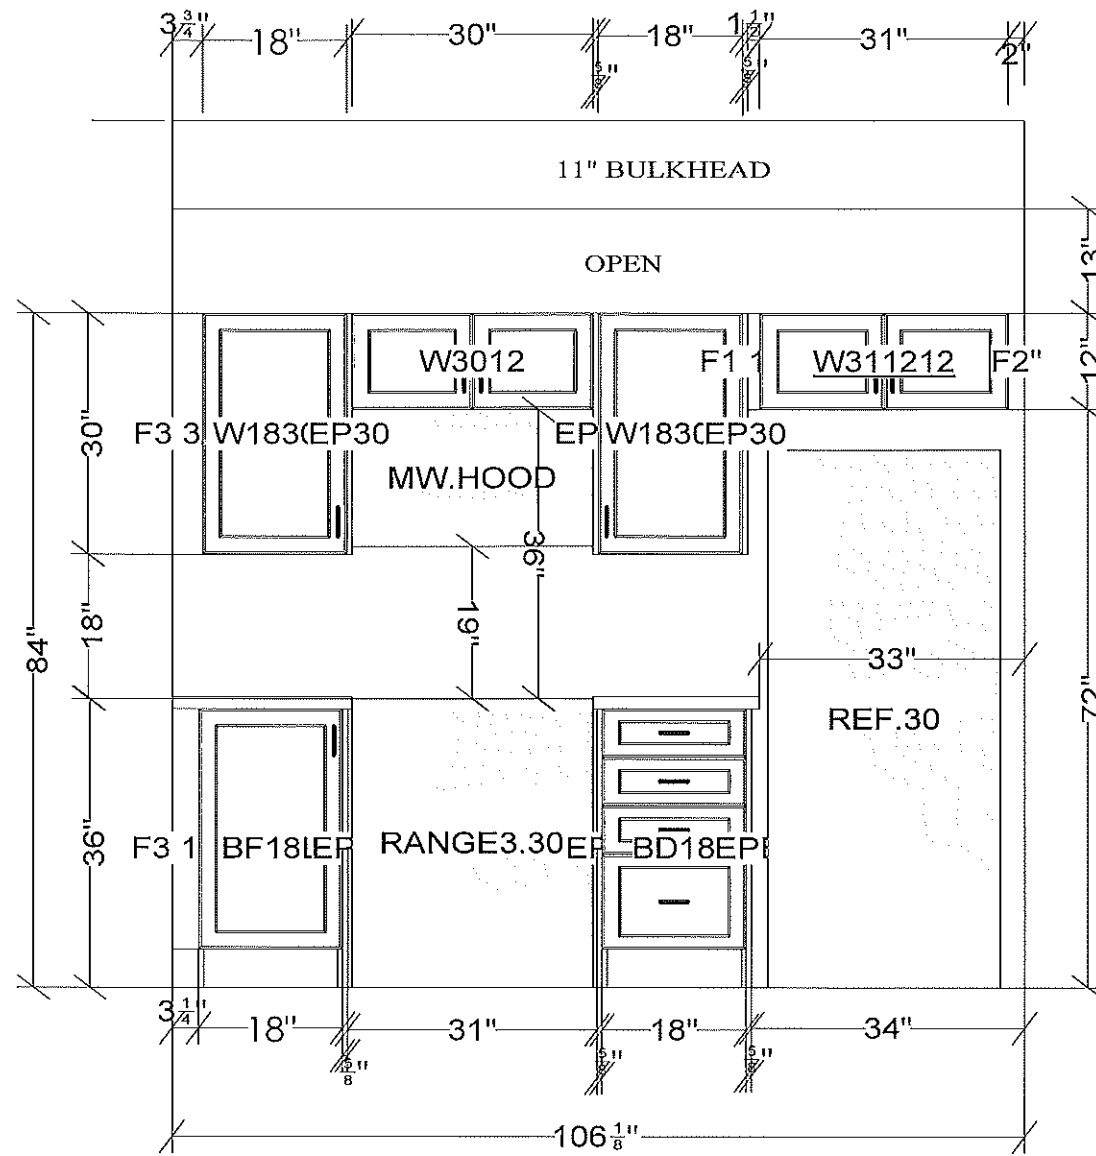


NO CROWN/BUILD UP - NO LIGHT VALANCE

All dimensions size designations given are subject to verification on job site and adjustment to fit job conditions.

2020

This is an original design and must not be released or copied unless applicable fee has been paid or job order placed.

Designed: 3/21/2025  
Printed: 3/21/2025

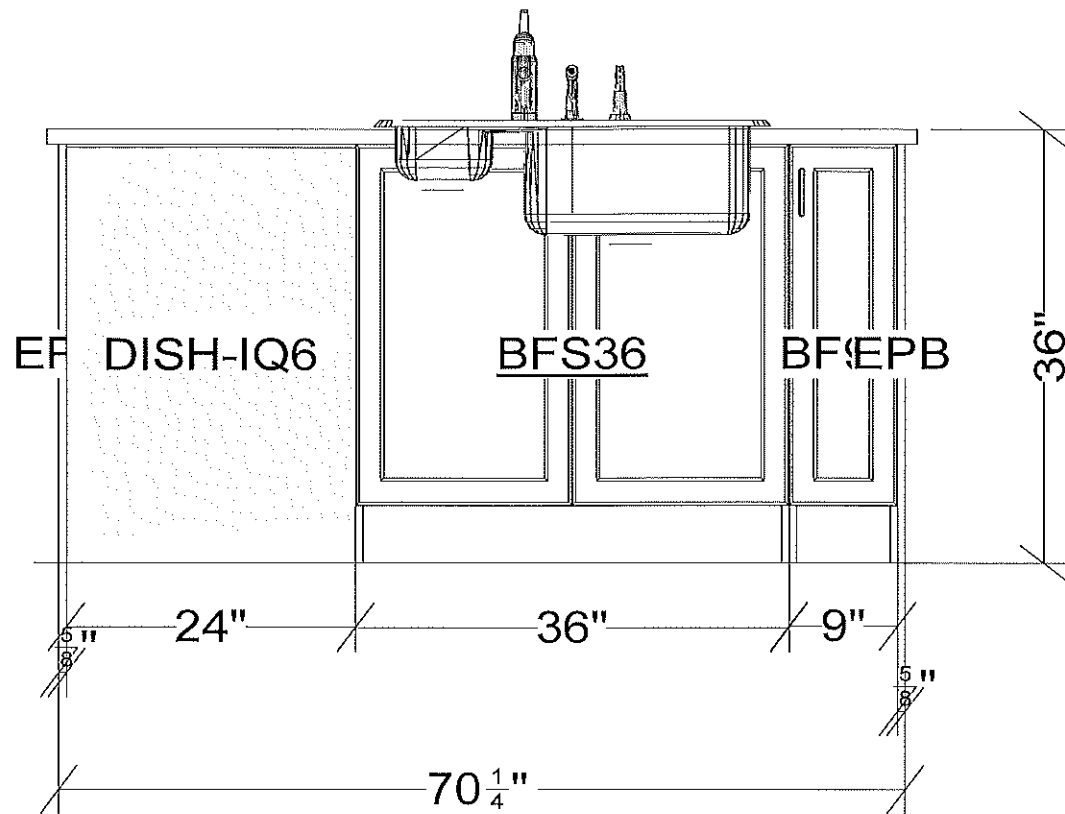

All dimensions \_size designations given are subject to verification on job site and adjustment to fit job conditions.

2020

This is an original design and must not be released or copied unless applicable fee has been paid or job order placed.

Designed: 3/21/2025  
Printed: 3/21/2025

RAYWAL CABINETS

JUN BLD 8 - UNIT 247 - CIVIC 621


AS BUILT - MARCH 19 2025

NUVO - POWDER ROOM - UPPER UNIT

DOOR STYLE: MODENA  
FINISH: OLIVE GREEN  
SPECIES: MAPLE  
BOX INTERIOR: WHITE MELAMINE  
HINGE: STANDARD

HARDWARE:137


COUNTERTOP: F6698-46

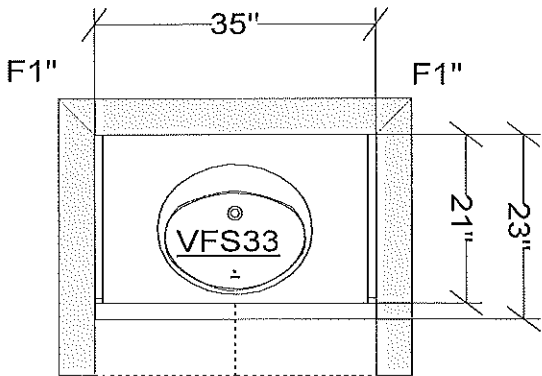

KICKB96 X 1  
SCRIBE96 X 1

All dimensions _size designations given are subject to verification on job site and adjustment to fit job conditions.	2020	This is an original design and must not be released or copied unless applicable fee has been paid or job order placed.	Designed: 3/21/2025 Printed: 3/21/2025	
NUVO- UPPER UNIT (POWDER ROOM)		All	Drawing #: 1	Scale : 0 1/2" 1'

# POWDER ROOM

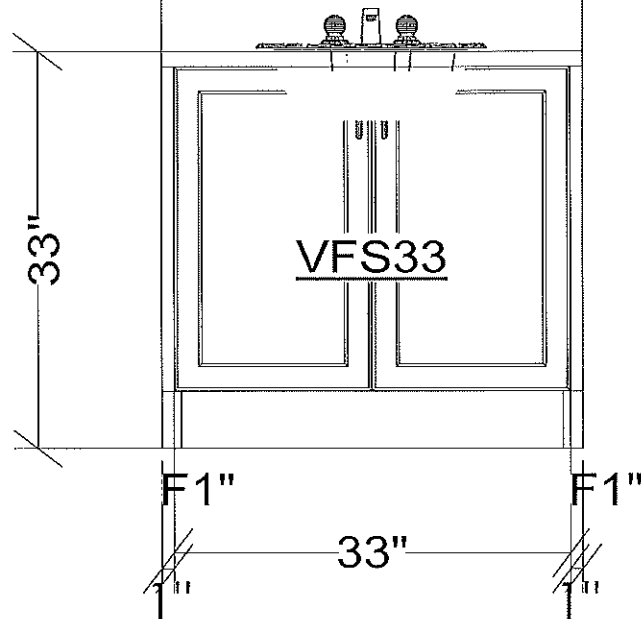

All dimensions \_size designations given are subject to verification on job site and adjustment to fit job conditions.

2020

This is an original design and must not be released or copied unless applicable fee has been paid or job order placed.

Designed: 3/21/2025  
Printed: 3/21/2025

RAYWAL CABINETS

JUN BLD 8 - UNIT247 - CIVIC 621


AS BUILT - MARCH 20 2025

NUVO - MAIN - UPPER UNIT


DOOR STYLE: MODENA  
FINISH: OLIVE GREEN  
SPECIES: MAPLE  
BOX INTERIOR: WHITE MELAMINE  
HINGE: STANDARD

HARDWARE:135

COUNTERTOP: F6698-46

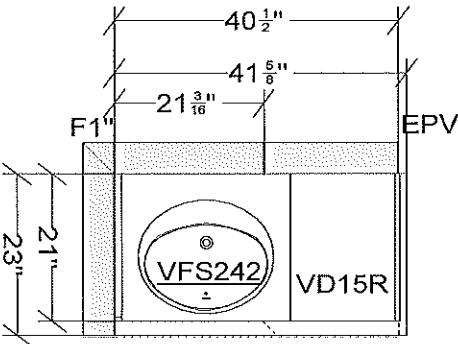

INSTALL 54" OVER TOILET

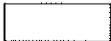


VSM15R

KICKB96 X 1  
SCRIBE96 X 1

All dimensions _size designations given are subject to verification on job site and adjustment to fit job conditions.	2020	This is an original design and must not be released or copied unless applicable fee has been paid or job order placed.	Designed: 3/21/2025 Printed: 3/21/2025	
NUVO- UPPER UNIT (MAIN BATH)		All	Drawing #: 1	Scale : 0 7/16" 1'

MAIN

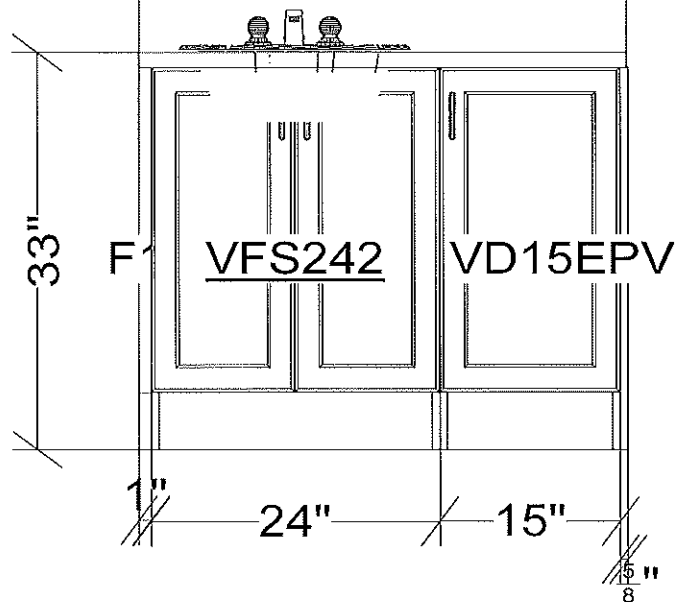

All dimensions size designations given are subject to verification on job site and adjustment to fit job conditions.

2020

This is an original design and must not be released or copied unless applicable fee has been paid or job order placed.

Designed: 3/21/2025  
Printed: 3/21/2025

NUVO- UPPER UNIT (MAIN BATH)

El 1

Drawing #: 1

Scale : 0 3/4" 1'

RAYWAL CABINETS

JUN BLD 8 - UNIT 247 - CIVIC 621

AS BUILT - MARCH 20 2025

NUVO - ENSUITE - UPPER UNIT

DOOR STYLE: MODENA  
FINISH: OLIVE GREEN  
SPECIES: MAPLE  
BOX INTERIOR: WHITE MELAMINE  
HINGE: STANDARD


HARDWARE:135

COUNTERTOP: F6698-46

INSTALL 54" OVER TOILET



VSM15R

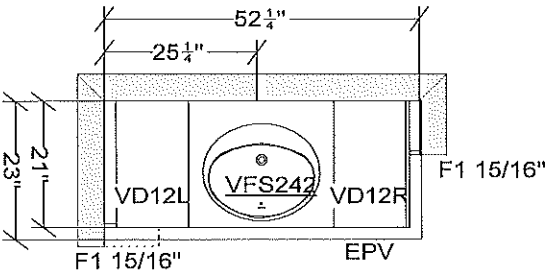

KICKB96 X 1  
SCRIBE96 X 1

All dimensions and size designations given are subject to verification on job site and adjustment to fit job conditions.


2020

This is an original design and must not be released or copied unless applicable fee has been paid or job order placed.

Designed: 3/21/2025  
Printed: 3/21/2025



ENSUITE

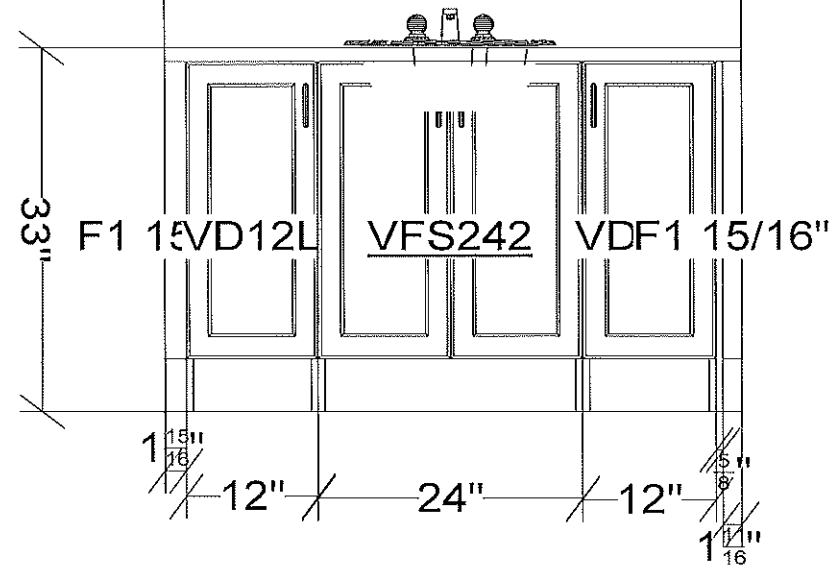

All dimensions size designations given are subject to verification on job site and adjustment to fit job conditions.	2020	This is an original design and must not be released or copied unless applicable fee has been paid or job order placed.	Designed: 3/21/2025 Printed: 3/21/2025
NUVO- UPPER UNIT (ENSUITE)			Scale : 0 11/16" 1'
	El 1	Drawing #: 1	