

UCK PHOENIX HOMES

WHITE TAIL RIDGE 4

39"H UPpers

LOT# 126

DOOR PROFILE LIGHT VALANCE

MODEL - KINGSWOOD

12" Furring Panel + 1" Moulding

(GARAGE RIGHT)

LARGE CEILING CROWN

KITCHEN


MOUNTING HEIGHT - 96

REVISED APR. 2/25


** OUTLETS BACK IN BACKSPLASH - VALANCE ADDED BACK AND SHELF FOR LIGHTING IN UPPER CABINET DELETED

Initial
all

Initial
ICM

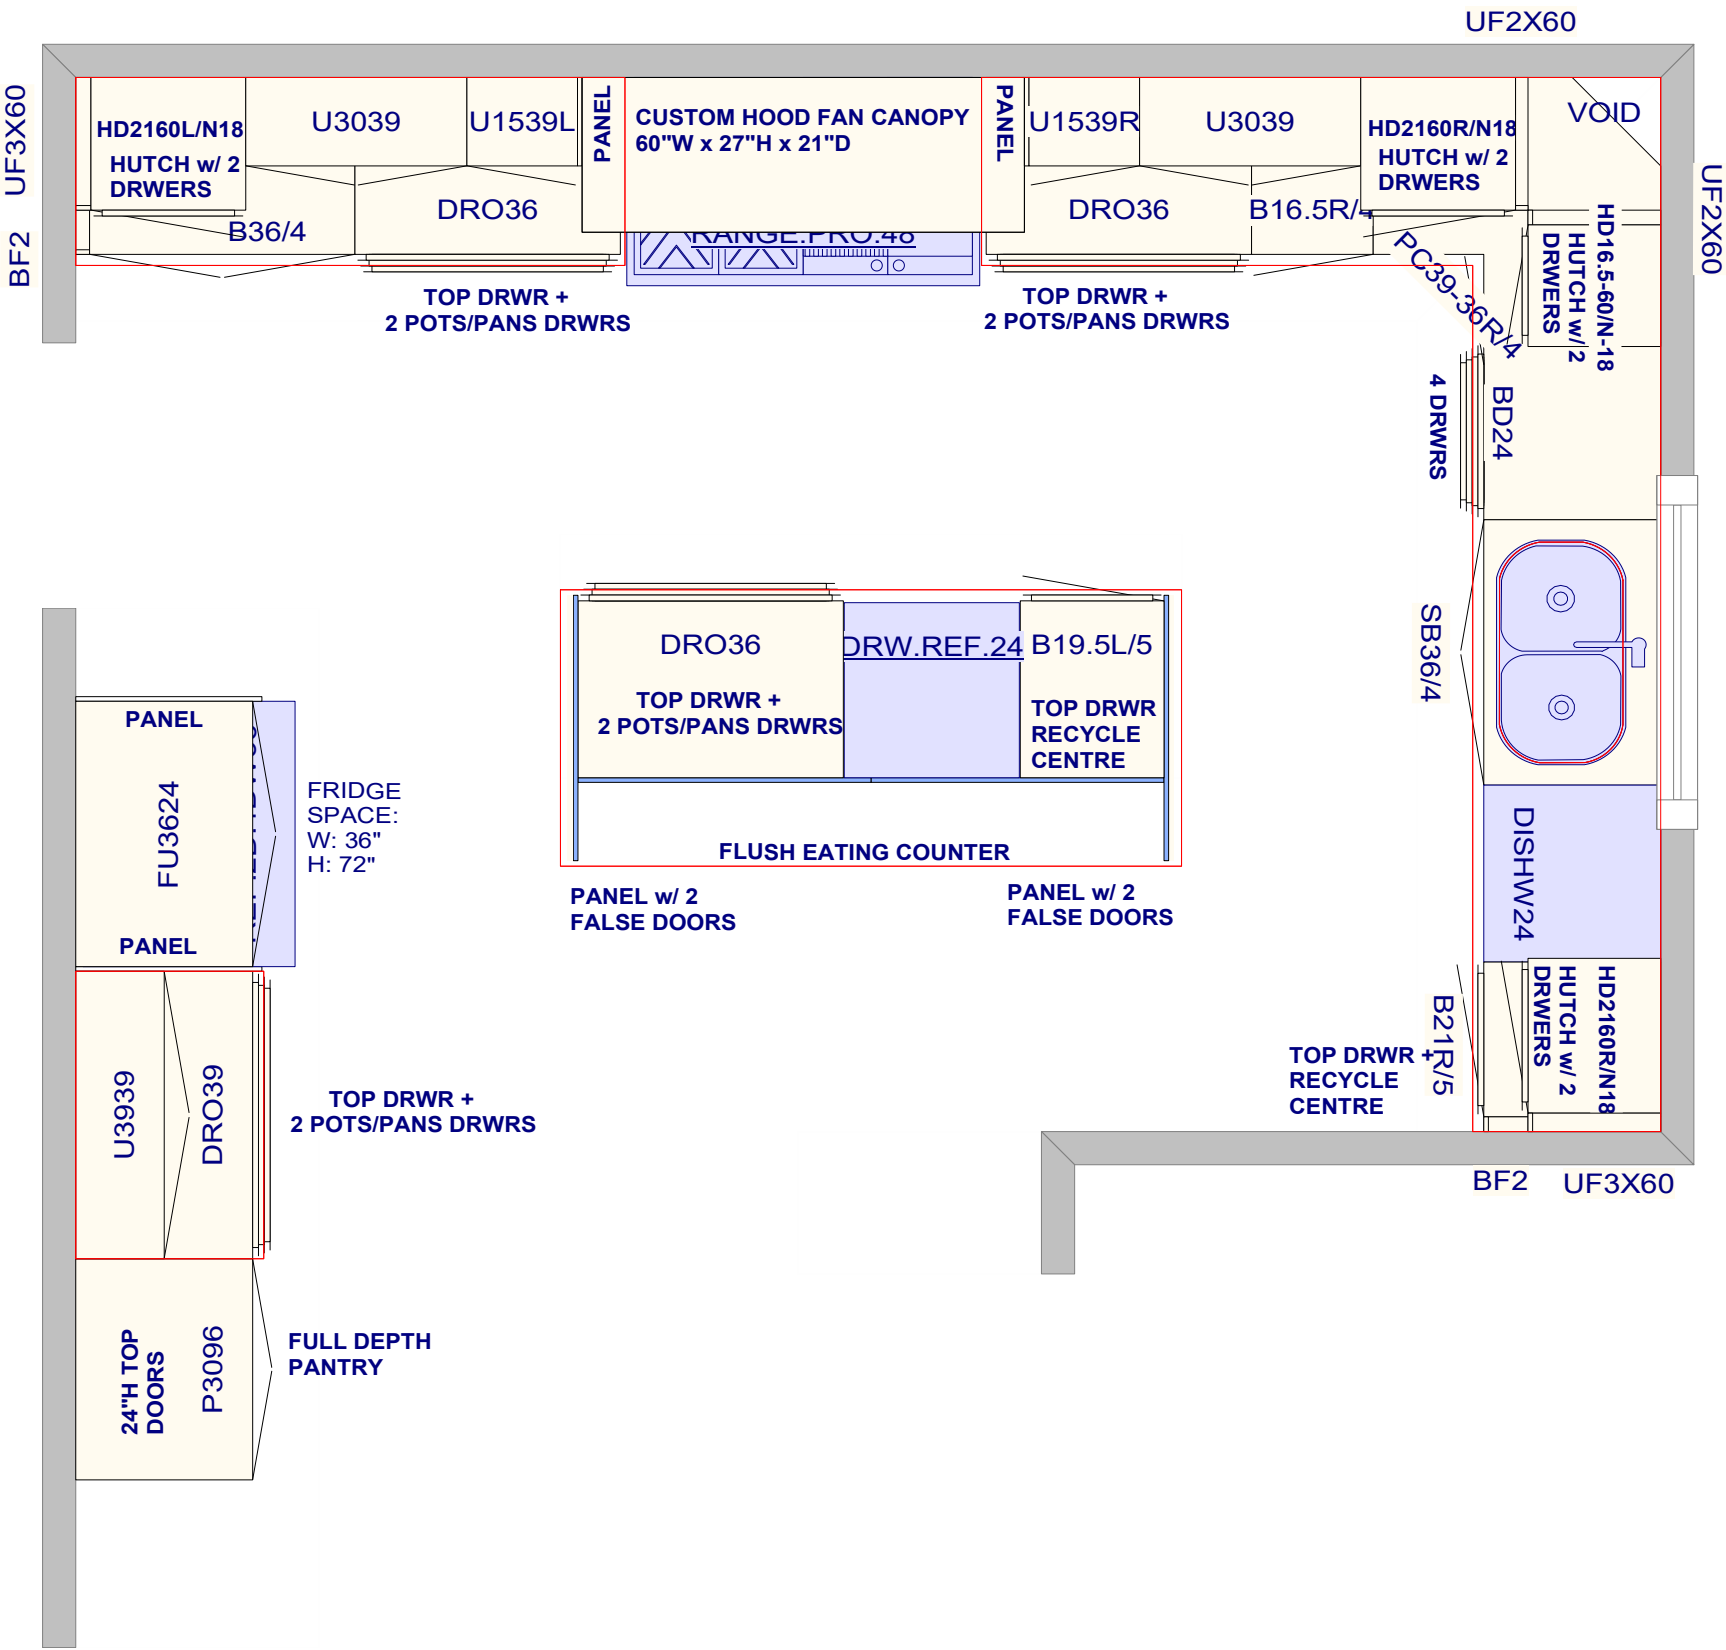


All dimensions & size designations given are subject to verification on job site and adjustment to fit job conditions.		This is an original design and must not be released or copied unless applicable fee has been paid or job order placed.	Designed: 2/25/2025 Printed: 4/2/2025	
			WTR4 126 - KITKCHEN - revised APR 2 2025	Drawing #: 1 No Scale.

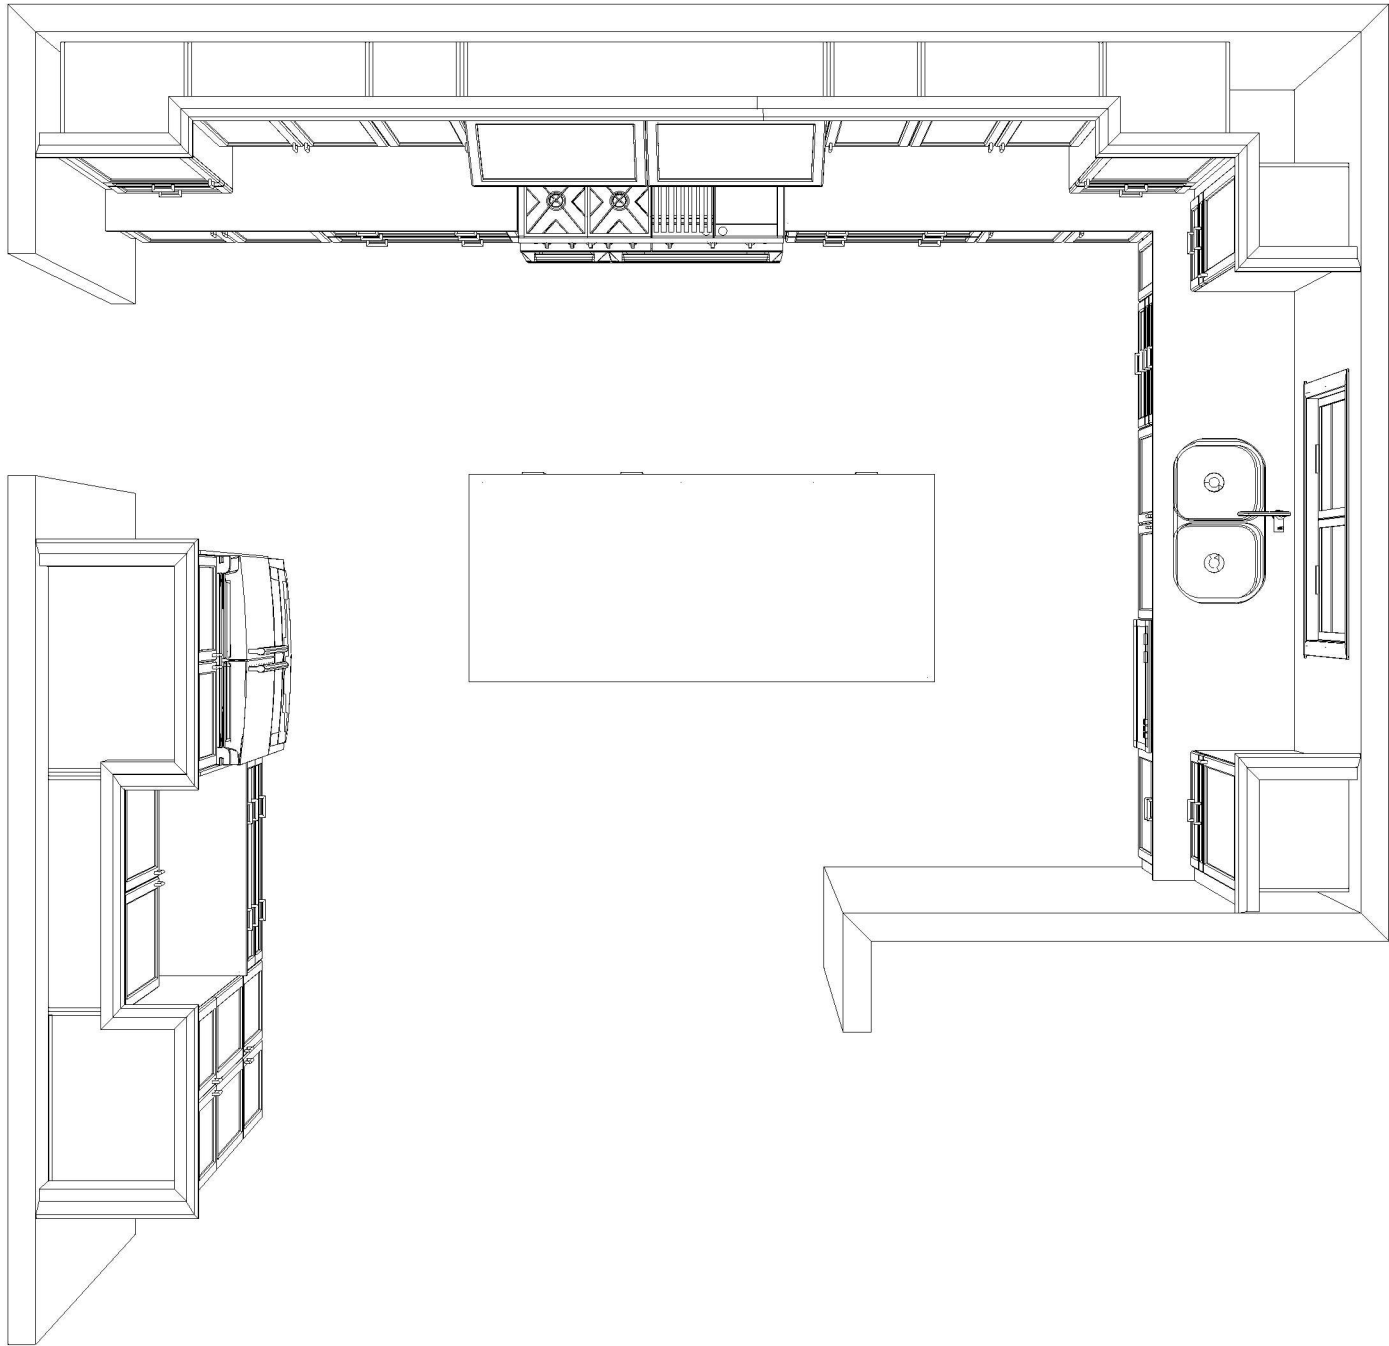
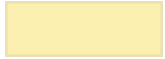


Note: This drawing is an artistic interpretation of the general appearance of the design. It is not meant to be an exact rendition.



Designed: 2/25/2025
Printed: 4/2/2025

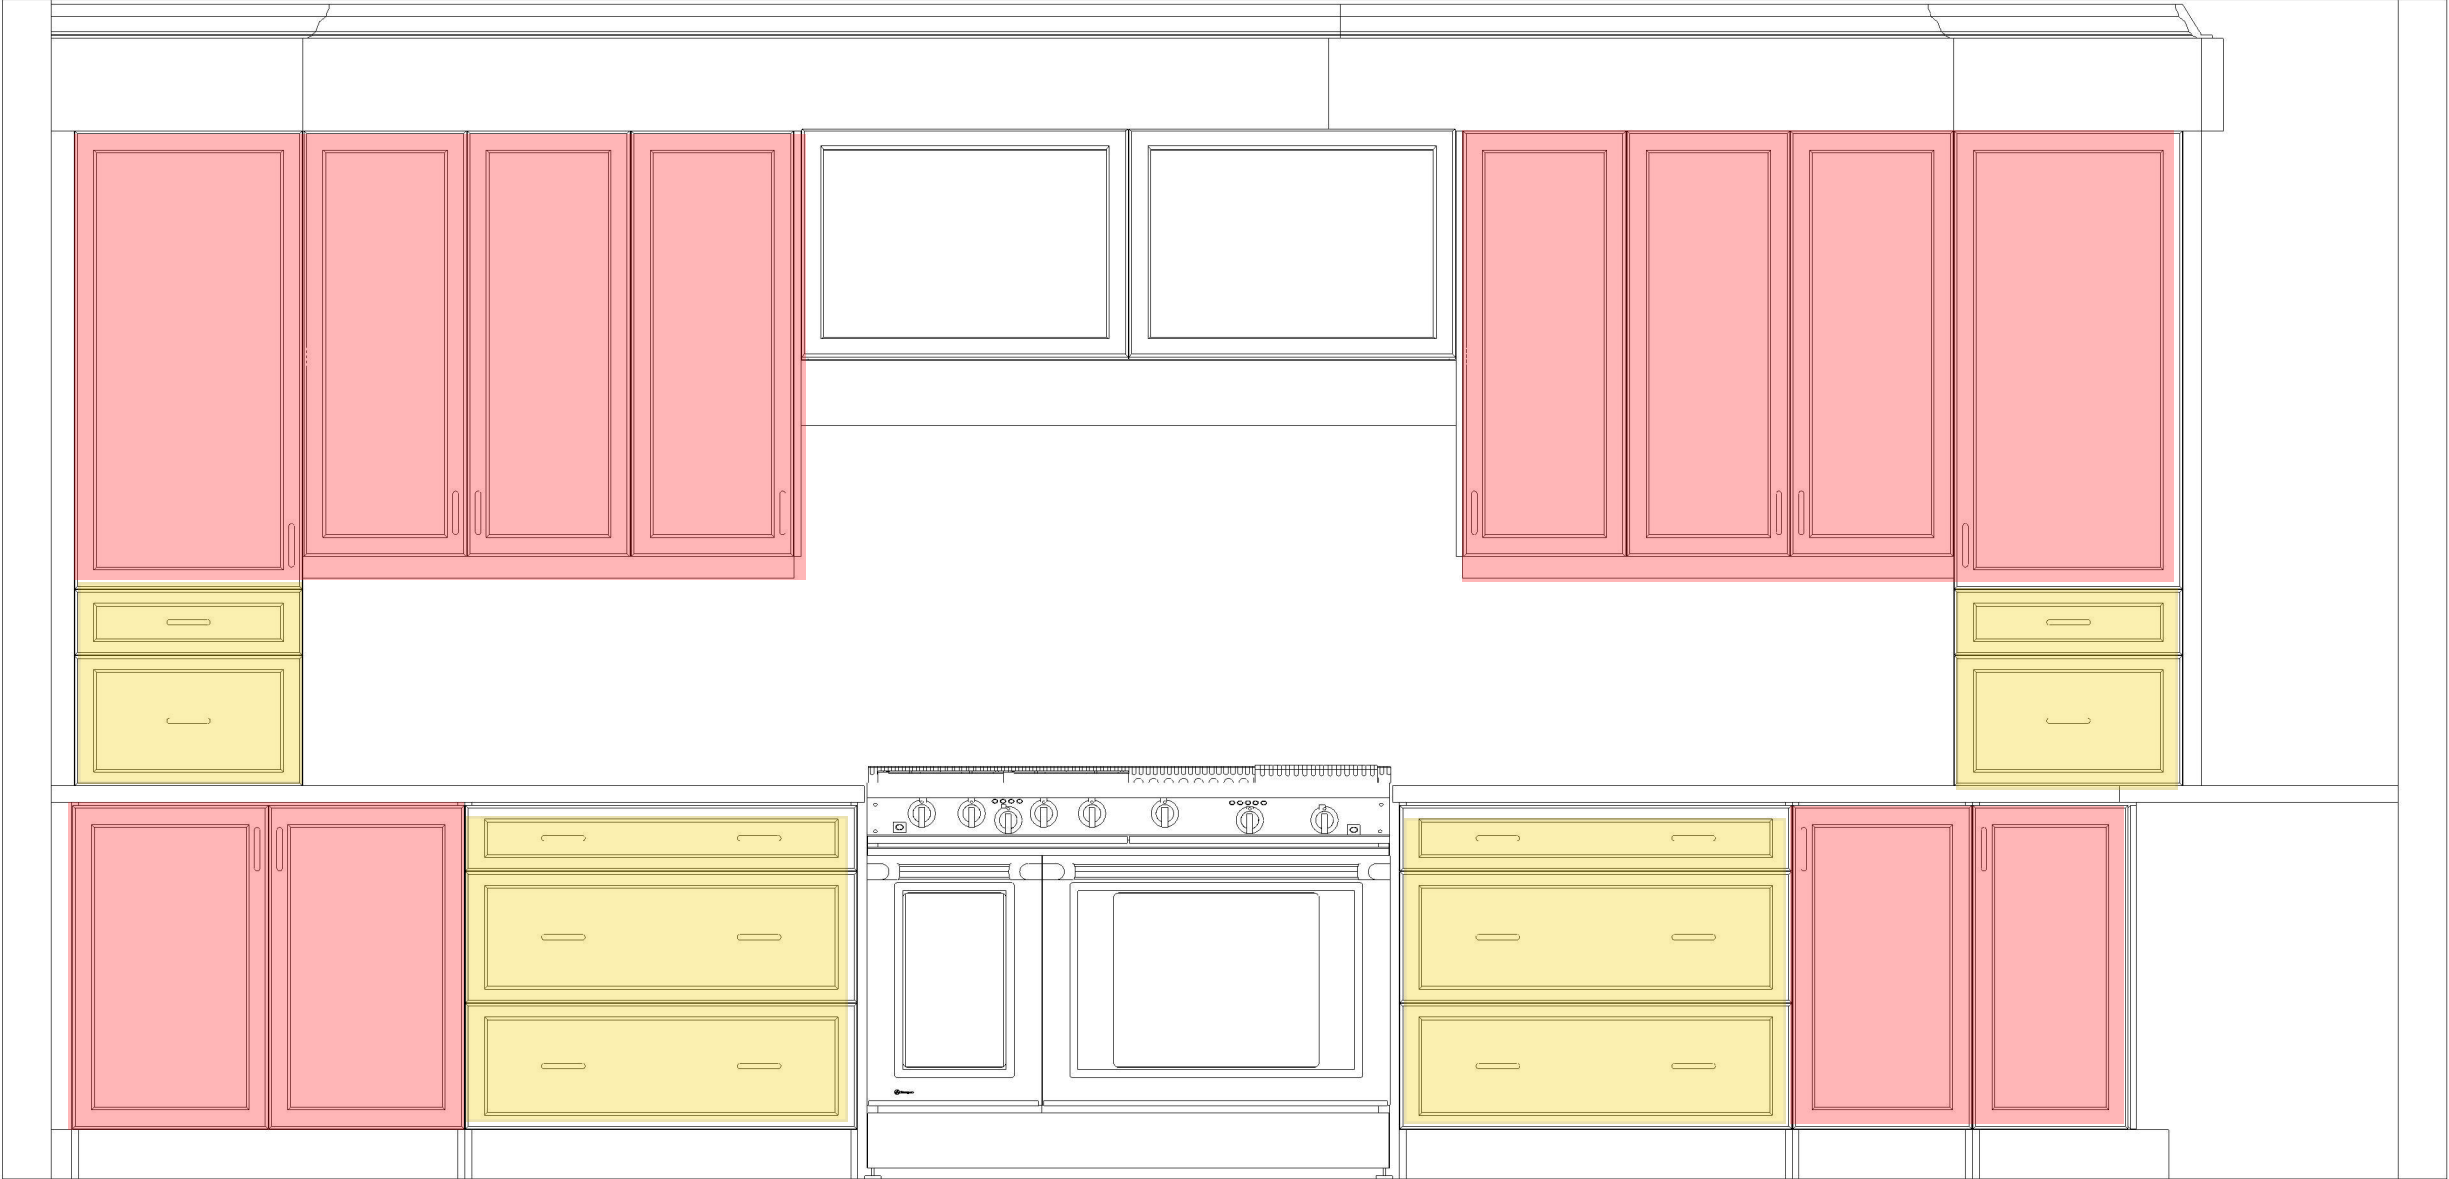
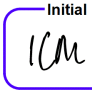



 HU64
 HN52

Note: This drawing is an artistic interpretation of the general appearance of the design. It is not meant to be an exact rendition.



Designed: 2/25/2025
Printed: 4/2/2025

Initial Initial
 

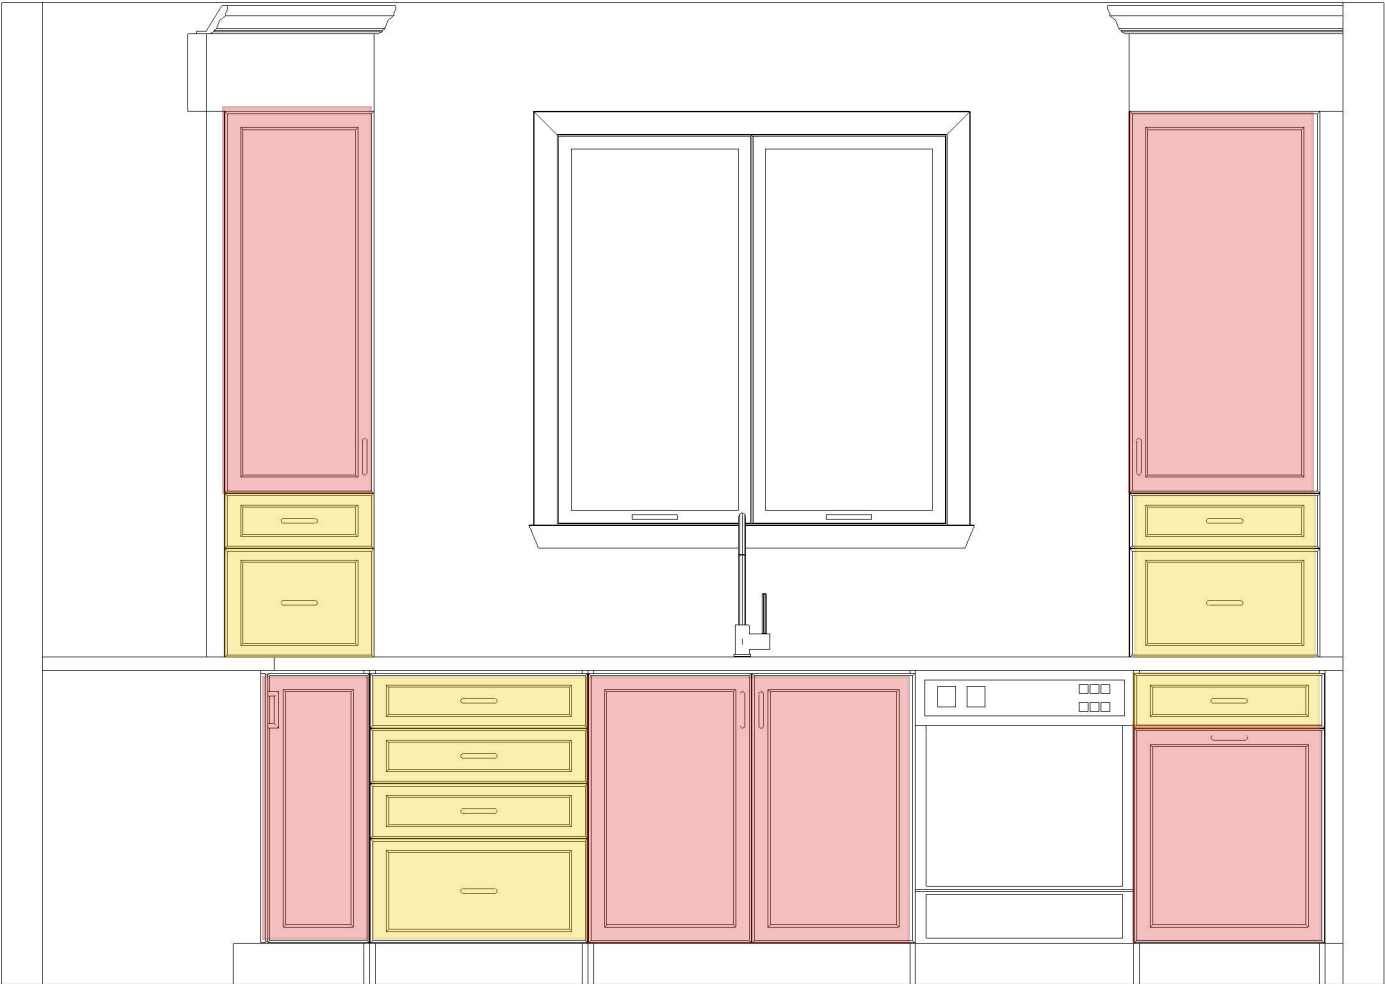

HU64
 HN52


Note: This drawing is an artistic interpretation of the general appearance of the design. It is not meant to be an exact rendition.



Designed: 2/25/2025
Printed: 4/2/2025

Initial


Initial

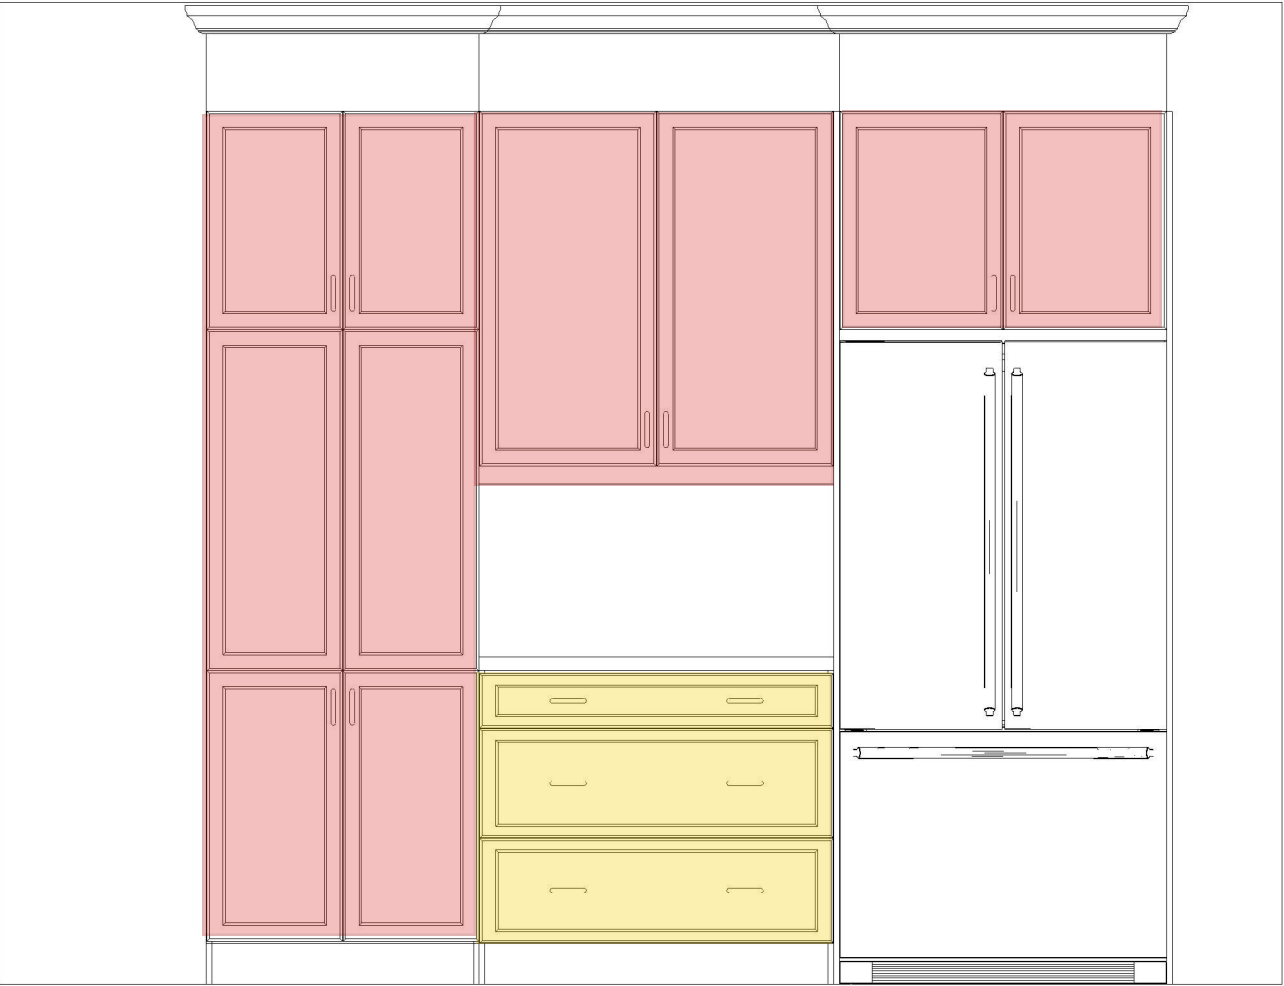- HU64
- HN52

Note: This drawing is an artistic interpretation of the general appearance of the design. It is not meant to be an exact rendition.



Designed: 2/25/2025
Printed: 4/2/2025

Initial

all


Initial

ICM

WTR4 126 - KITKCHEN - revised APR 2 2025

All

Drawing #: 1

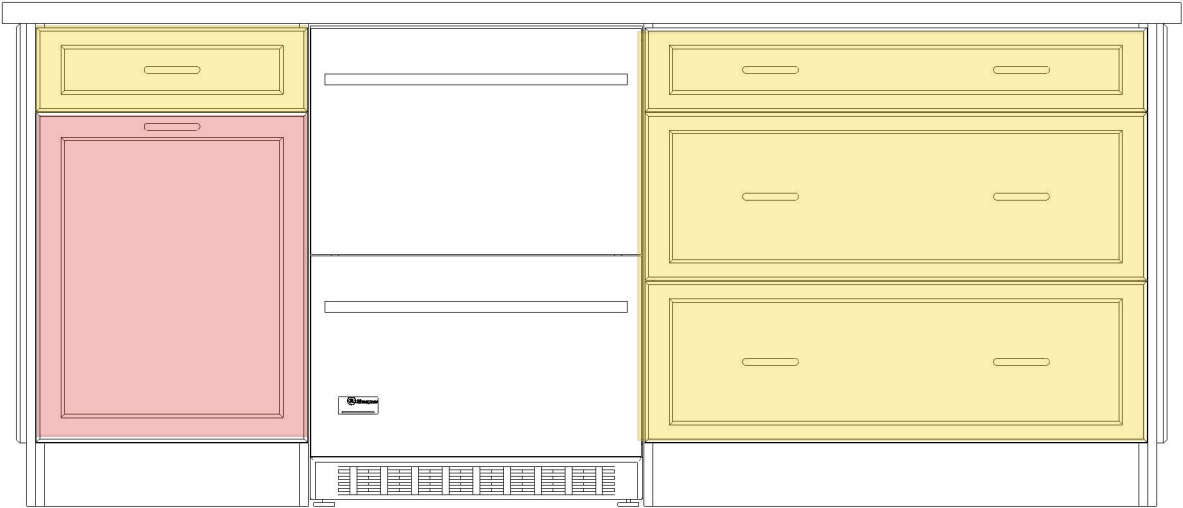

- HU64
- HN52

Note: This drawing is an artistic interpretation of the general appearance of the design. It is not meant to be an exact rendition.



Designed: 2/25/2025
Printed: 4/2/2025

Initial Initial
all *ICM*



Note: This drawing is an artistic interpretation of the general appearance of the design. It is not meant to be an exact rendition.




Designed: 2/25/2025
Printed: 4/2/2025



Note: This drawing is an artistic interpretation of the general appearance of the design. It is not meant to be an exact rendition.



Designed: 2/25/2025
Printed: 4/2/2025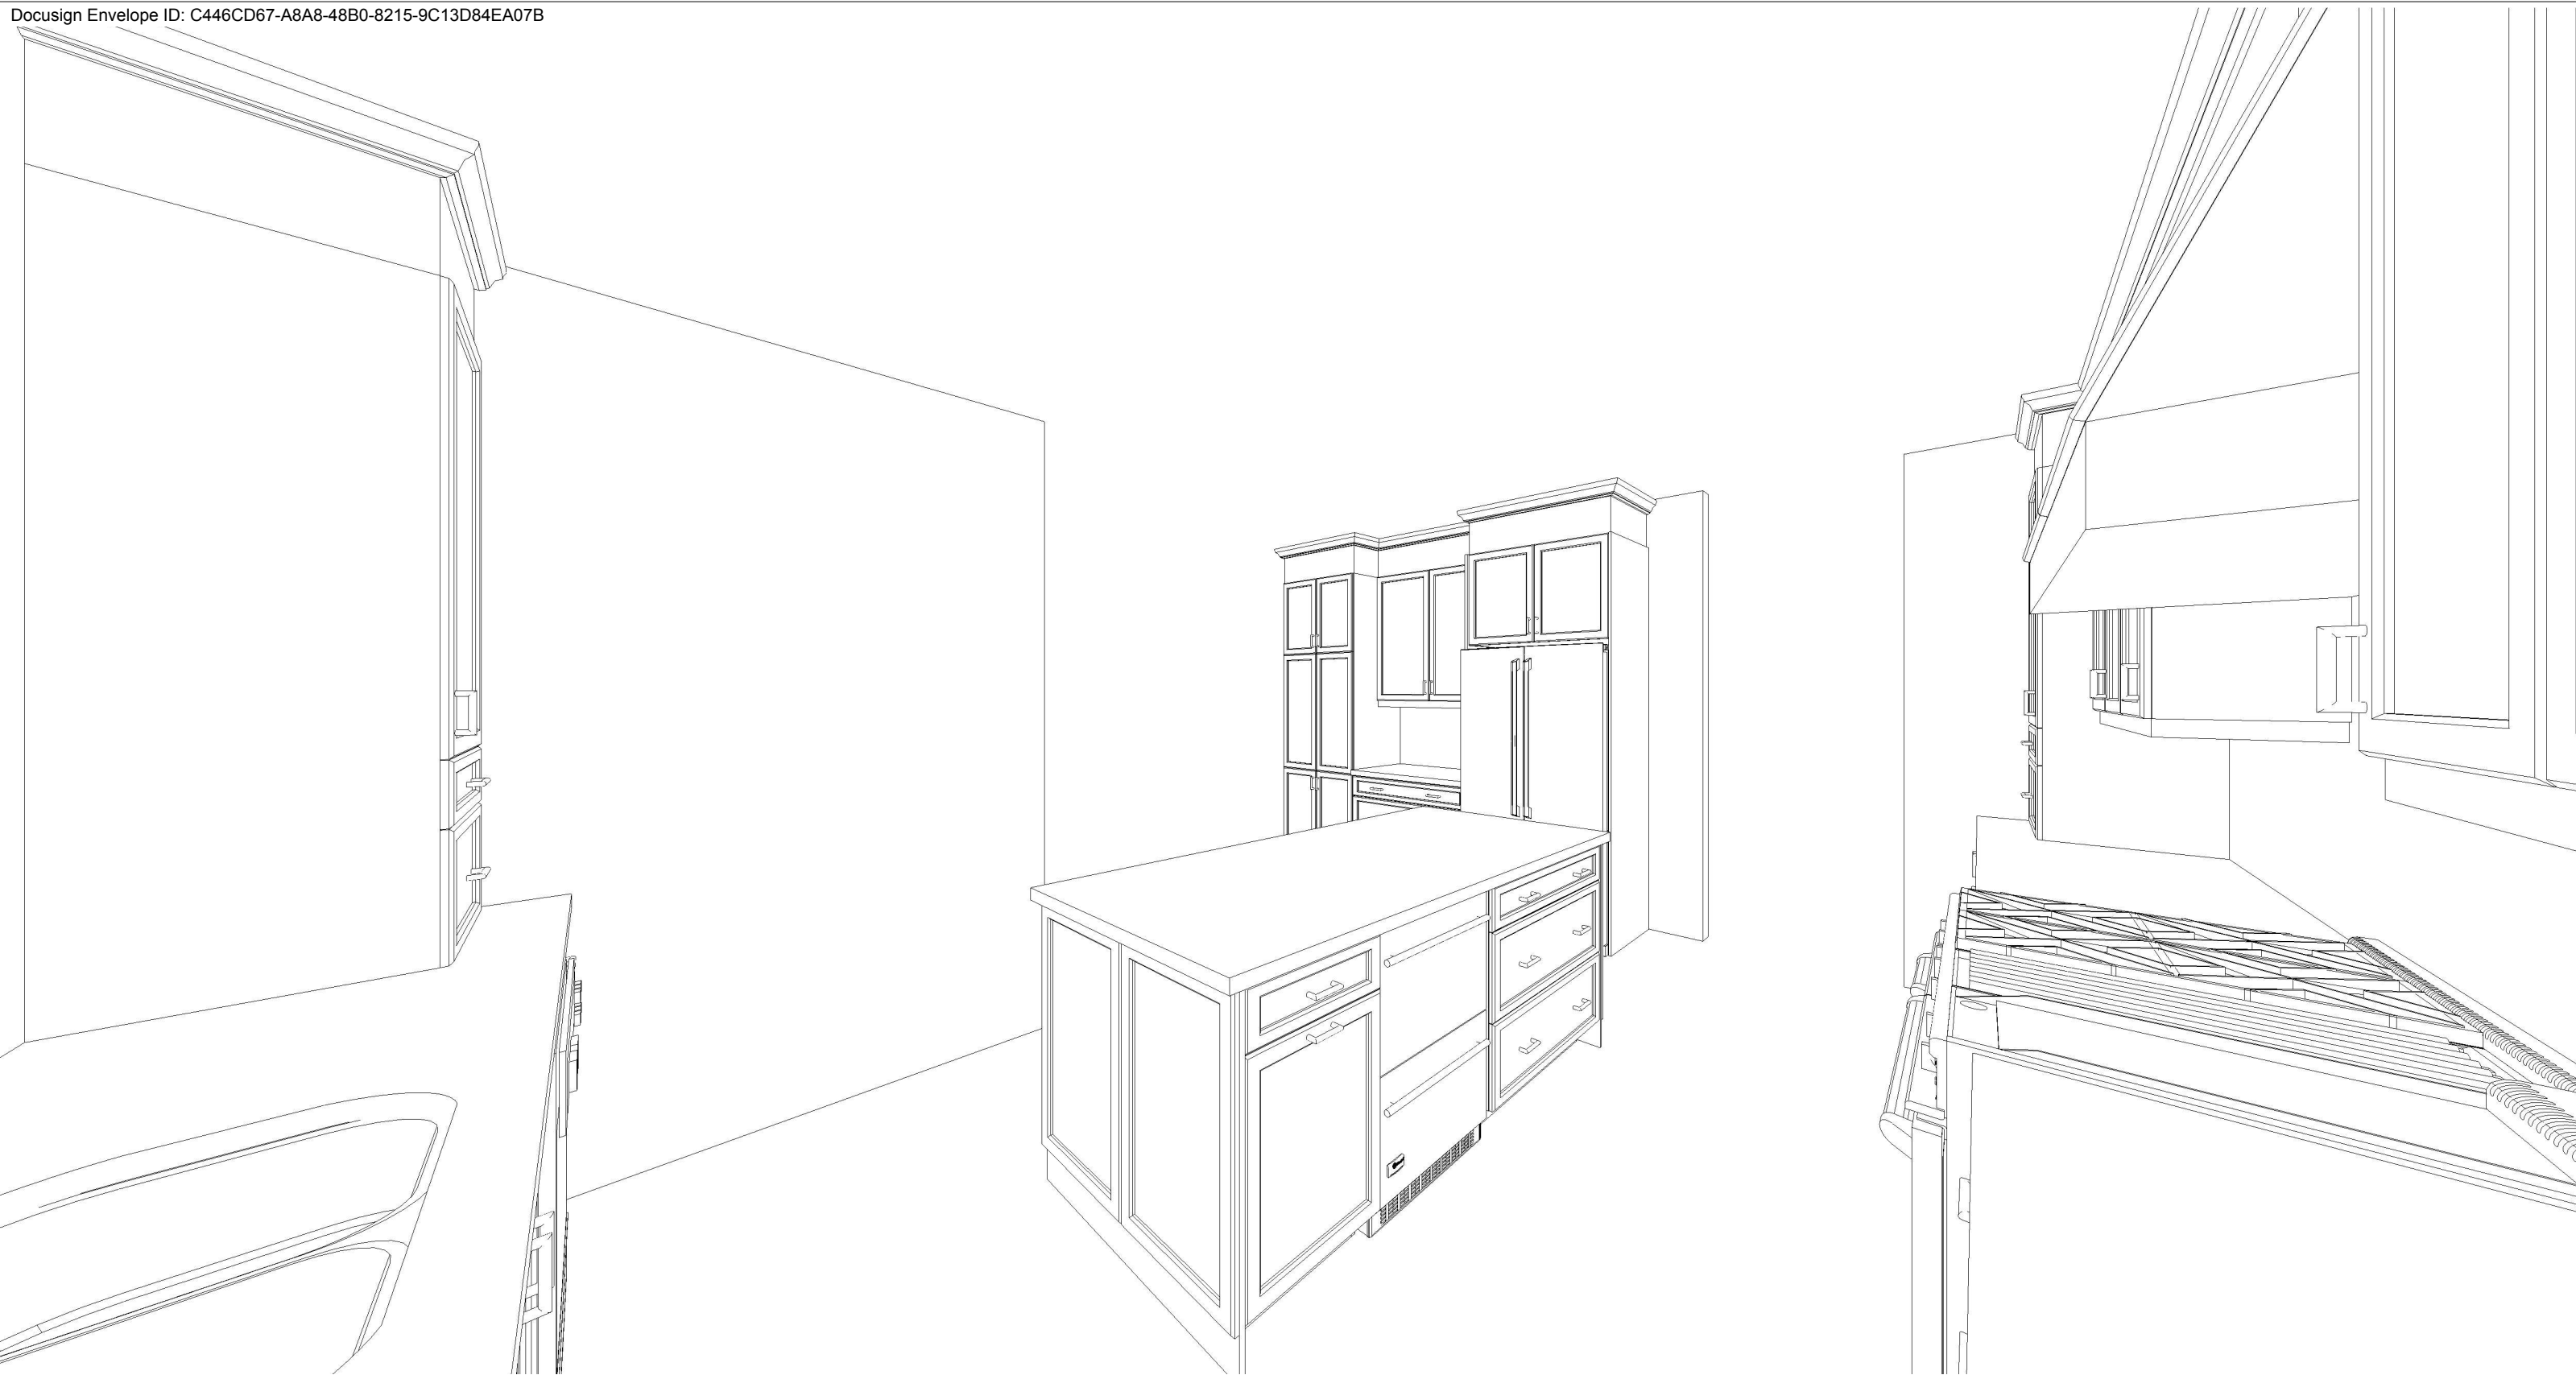