

RAYWAL CABINETS

JUN BLD 7 - UNIT 239 - CIVIC 205

AS BUILT - MAY 13 2025

NUVO - KITCHEN - UPPER UNIT

KITCHEN UPPERS

DOOR STYLE: RETRO
FINISH: COTTON
SPECIES: THERMOFOIL
BOX INTERIOR: WHITE MELAMINE
HINGE: STANDARD

KITCHEN LOWERS AND ISLAND


DOOR STYLE: RETRO
FINISH: IRON
SPECIES: THERMOFOIL
BOX INTERIOR: WHITE MELAMINE
HINGE: STANDARD

HARDWARE:116

COUNTERTOP: F6698-46
WITH 4"H BACKSPLASH

DWKIT X 1
VENT BOX X 1 (12"W x 9"D x 10 3/4")
VENT BOX X 1 (30"W x 12"D x 14"H)

KICKB96 X 2
SCRIBE96 X 3

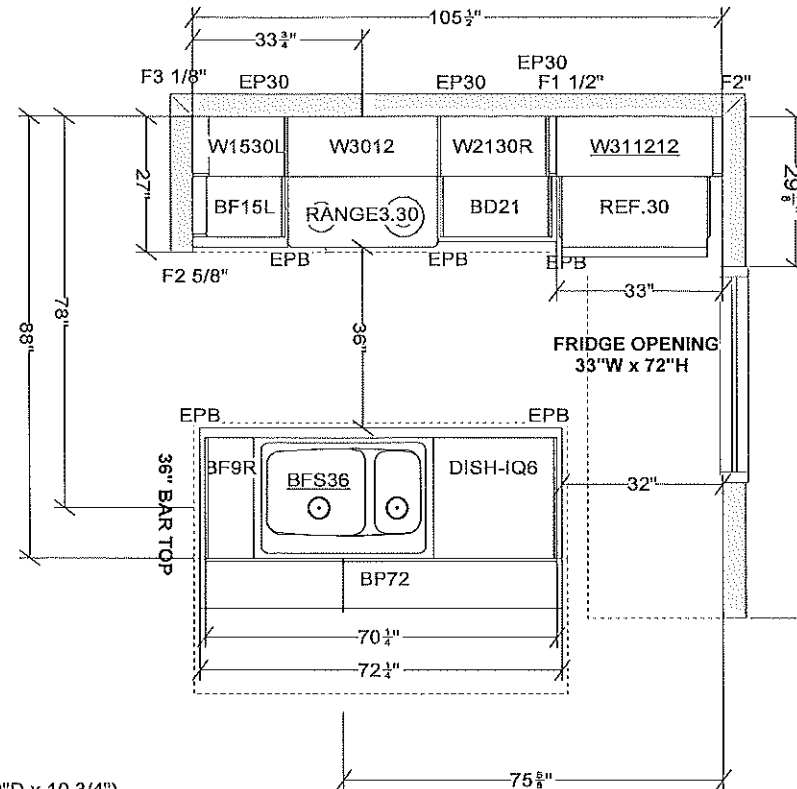

All dimensions size designations given are subject to verification on job site and adjustment to fit job conditions.

2020

This is an original design and must not be released or copied unless applicable fee has been paid or job order placed.


Designed: 5/13/2025
Printed: 5/13/2025

NUVO - UPPER UNIT (KITCHEN)

All

Drawing #: 1

Scale : 0 5/16" 1'

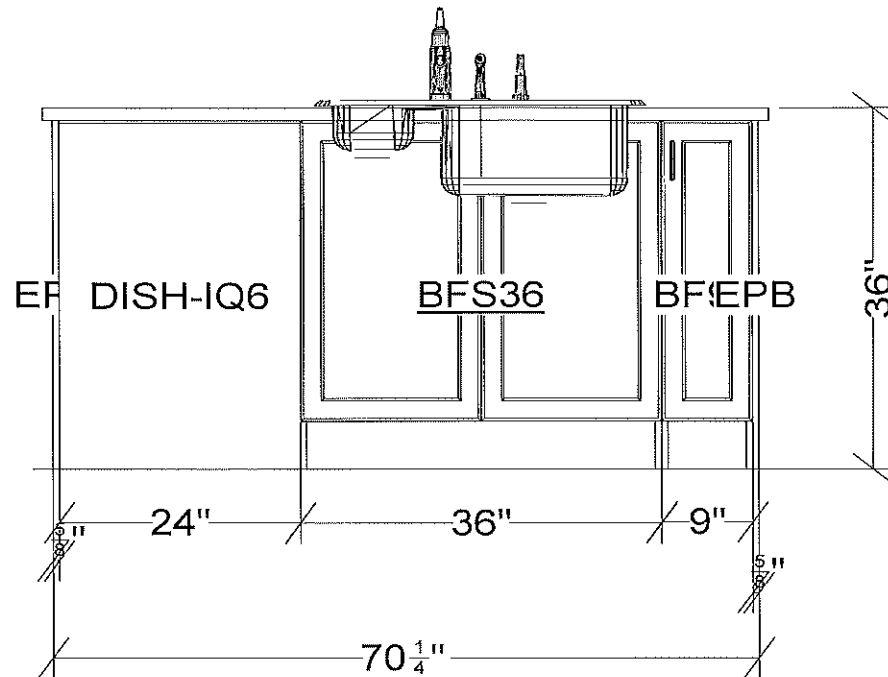


All dimensions size designations given are subject to verification on job site and adjustment to fit job conditions.

2020

This is an original design and must not be released or copied unless applicable fee has been paid or job order placed.

Designed: 5/13/2025
Printed: 5/13/2025

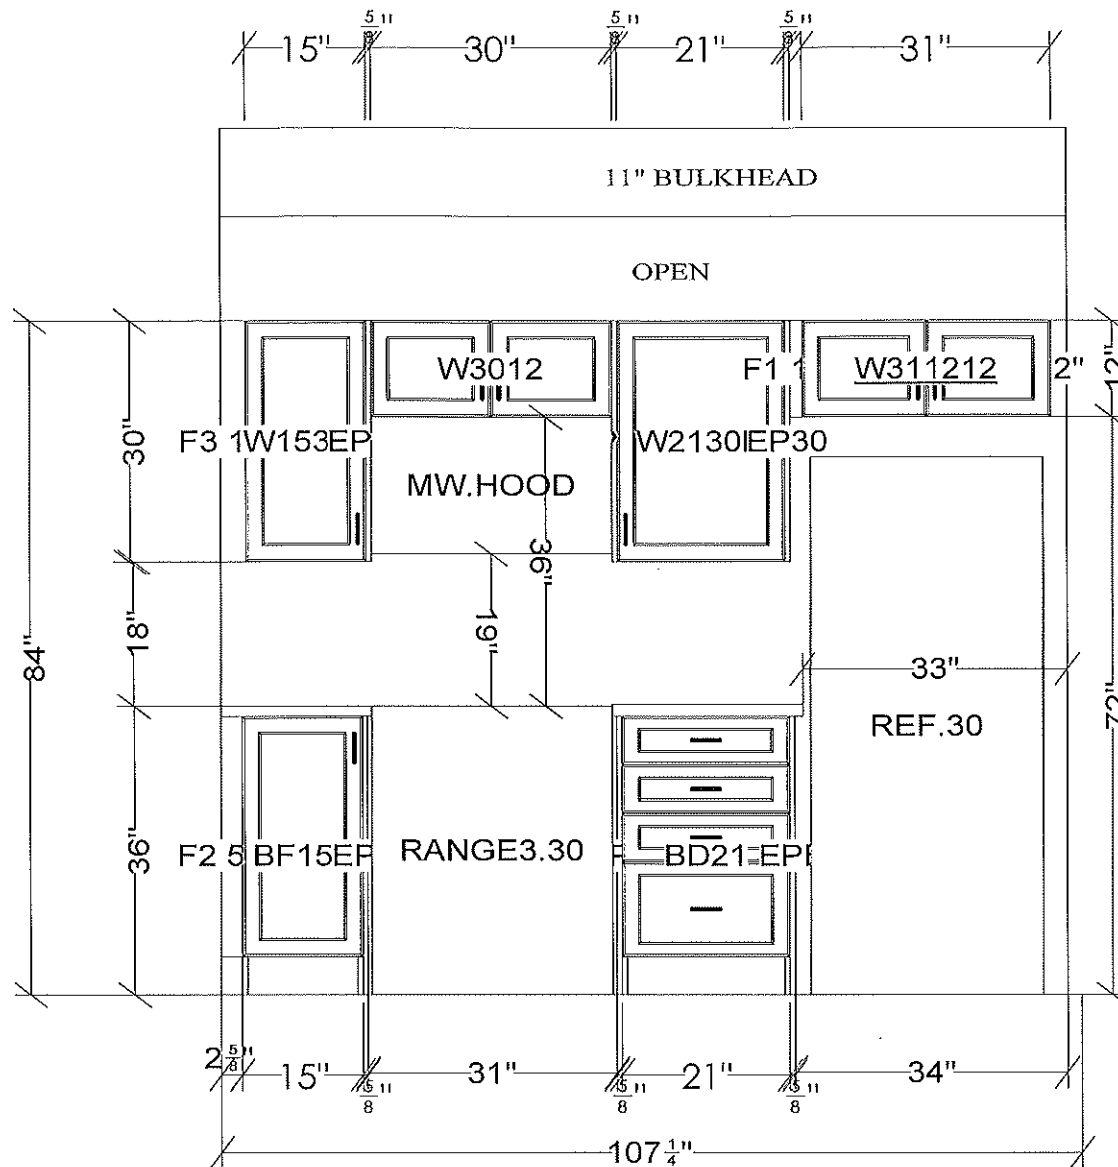

NO CROWN/BUILD UP - NO LIGHT VALANCE

All dimensions size designations given are subject to verification on job site and adjustment to fit job conditions.

2020

This is an original design and must not be released or copied unless applicable fee has been paid or job order placed.

Designed: 5/13/2025
Printed: 5/13/2025

RAYWAL CABINETS

JUN BLD 7 - UNIT 239 - CIVIC 205


AS BUILT - MAY 13 2025

NUVO - POWDER ROOM - UPPER UNIT

DOOR STYLE: RETRO
FINISH: CONCRETE
SPECIES: THERMOFOIL
BOX INTERIOR: WHITE MELAMINE
HINGE: STANDARD

HARDWARE: 142


COUNTERTOP: W4925K-07 WITH
4"H BACKSPLASH

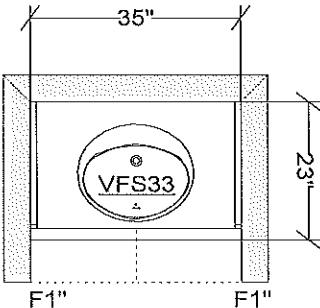

KICKB96 X 1
SCRIBE96 X 1

All dimensions ,size designations given are subject to verification on job site and adjustment to fit job conditions.	2020	This is an original design and must not be released or copied unless applicable fee has been paid or job order placed.	Designed: 5/13/2025 Printed: 5/13/2025	
NUVO- UPPER UNIT (POWDER ROOM)		All	Drawing #: 1	Scale : 0 3/8" 1'

POWDER ROOM

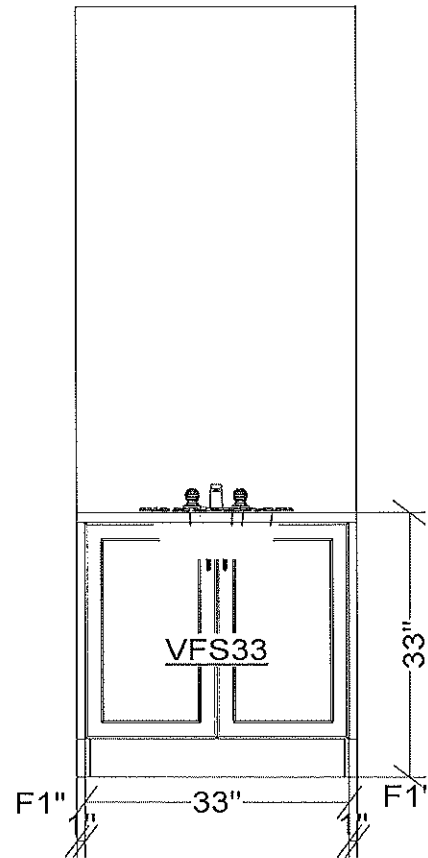

All dimensions _size designations
given are subject to verification on
job site and adjustment to fit job
conditions.

2020

This is an original design and must
not be released or copied unless
applicable fee has been paid or job
order placed.


Designed: 5/13/2025
Printed: 5/13/2025

RAYWAL CABINETS
JUN BLD 7 - UNIT 239 - CIVIC 205
AS BUILT - MAY 13 2025
NUVO - MAIN BATH - UPPER UNIT

DOOR STYLE: RETRO
FINISH: CONCRETE
SPECIES: THERMOFOIL
BOX INTERIOR: WHITE
HINGE: STANDARD

HARDWARE:142

COUNTERTOP: W4925K-07 WITH
4"H BACKSPLASH

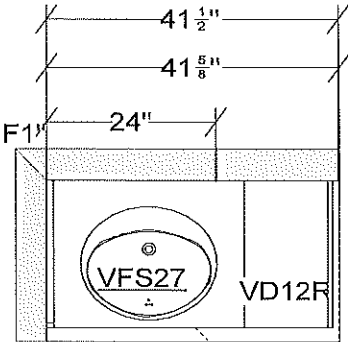

INSTALL 54" OVER TOILET


Surface Medicine Cabinet
VSM15R

EPV

KICKB96 X 1
SCRIBE96 X 1

All dimensions ,size designations given are subject to verification on job site and adjustment to fit job conditions.	2020	This is an original design and must not be released or copied unless applicable fee has been paid or job order placed.	Designed: 5/13/2025 Printed: 5/13/2025	
NUVO- UPPER UNIT (MAIN BATH)		All	Drawing #: 1	Scale : 0 7/16" 1'

MAIN BATH

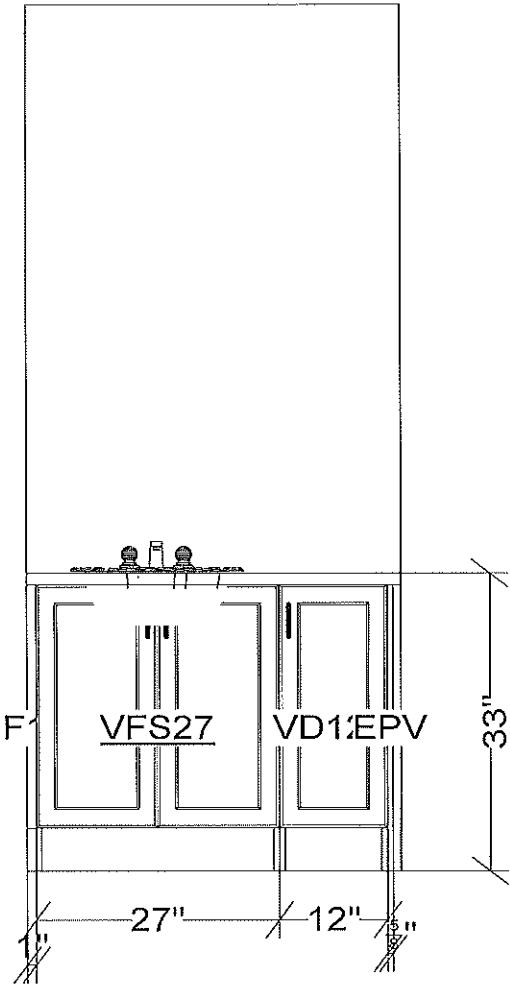

All dimensions size designations given are subject to verification on job site and adjustment to fit job conditions.

2020

This is an original design and must not be released or copied unless applicable fee has been paid or job order placed.

Designed: 5/13/2025
Printed: 5/13/2025

RAYWAL CABINETS

JUN BLD 7 - UNIT 239 - CIVIC 205


AS BUILT - MAY 13 2025

NUVO - ENSUITE - UPPER UNIT


DOOR STYLE: RETRO
FINISH: CONCRETE
SPECIES: THERMOFOIL
BOX INTERIOR: WHITE MELAMINE
HINGE: STANDARD

HARDWARE: 142

COUNTERTOP: W4925K-07
WITH 4" BACKSPLASH

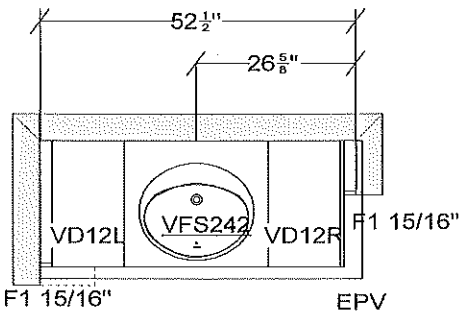

INSTALL 54" OVER TOILET

 Surface Medicine
Cabinet
VSM15R

KICKB96 X 1
SCRIBE96 X 1


All dimensions size designations
given are subject to verification on
job site and adjustment to fit job
conditions.

2020

This is an original design and must
not be released or copied unless
applicable fee has been paid or job
order placed.

Designed: 5/13/2025
Printed: 5/13/2025

ENSUTIE

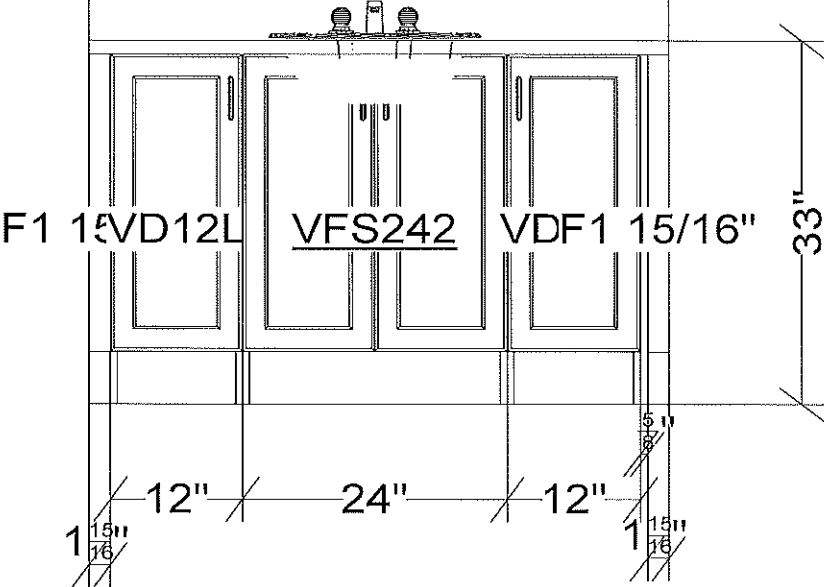

All dimensions _size designations given are subject to verification on job site and adjustment to fit job conditions.	2020	This is an original design and must not be released or copied unless applicable fee has been paid or job order placed.	Designed: 5/13/2025 Printed: 5/13/2025	
NUVO- UPPER UNIT (ENSUITE)		El 1	Drawing #: 1	Scale : 0 11/16" 1'