

RAYWAL CABINETS

JUN BLD 7 - UNIT 238 - CIVIC 2734

AS BUILT - MAY 13 2025

NUVO - KITCHEN - UPPER UNIT

KITCHEN UPpers


DOOR STYLE: RETRO
FINISH: COTTON
SPECIES: THERMOFOIL
BOX INTERIOR: WHITE MELAMINE
HINGE: STANDARD

KITCHEN LOWers AND ISLAND

DOOR STYLE: RETRO
FINISH: DENIM
SPECIES: THERMOFOIL
BOX INTERIOR: WHITE MELAMINE
HINGE: STANDARD

HARDWARE: 116

COUNTERTOP: F6314-58
WITH 4"H BACKSPLASH

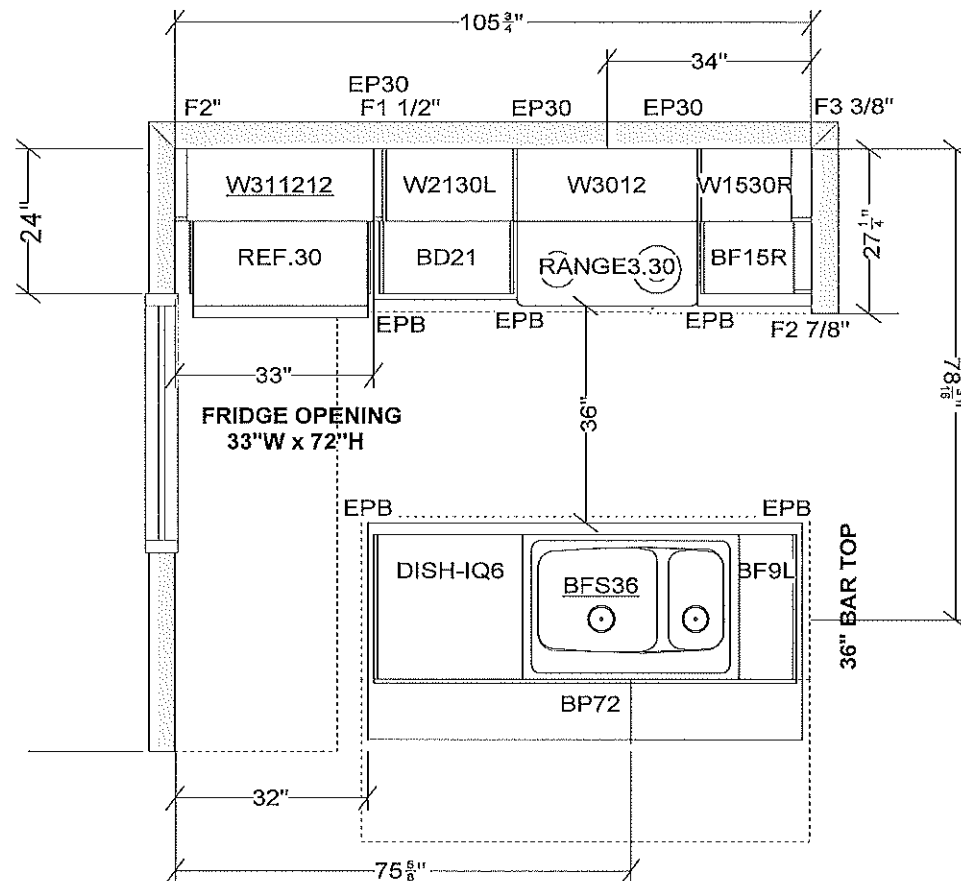

DWKIT X 1
VENT BOX X 1 (12"W x 9"D x 10 3/4")
VENT BOX X 1 (30"W x 12"D x 14"H)

KICKB96 X 2
SCRIBE96 X 3

All dimensions and size designations given are subject to verification on job site and adjustment to fit job conditions.

2020

This is an original design and must not be released or copied unless applicable fee has been paid or job order placed.


Designed: 5/13/2025
Printed: 5/13/2025

NUVO - UPPER UNIT (KITCHEN)

All

Drawing #: 1

Scale : 0 3/8" 1"

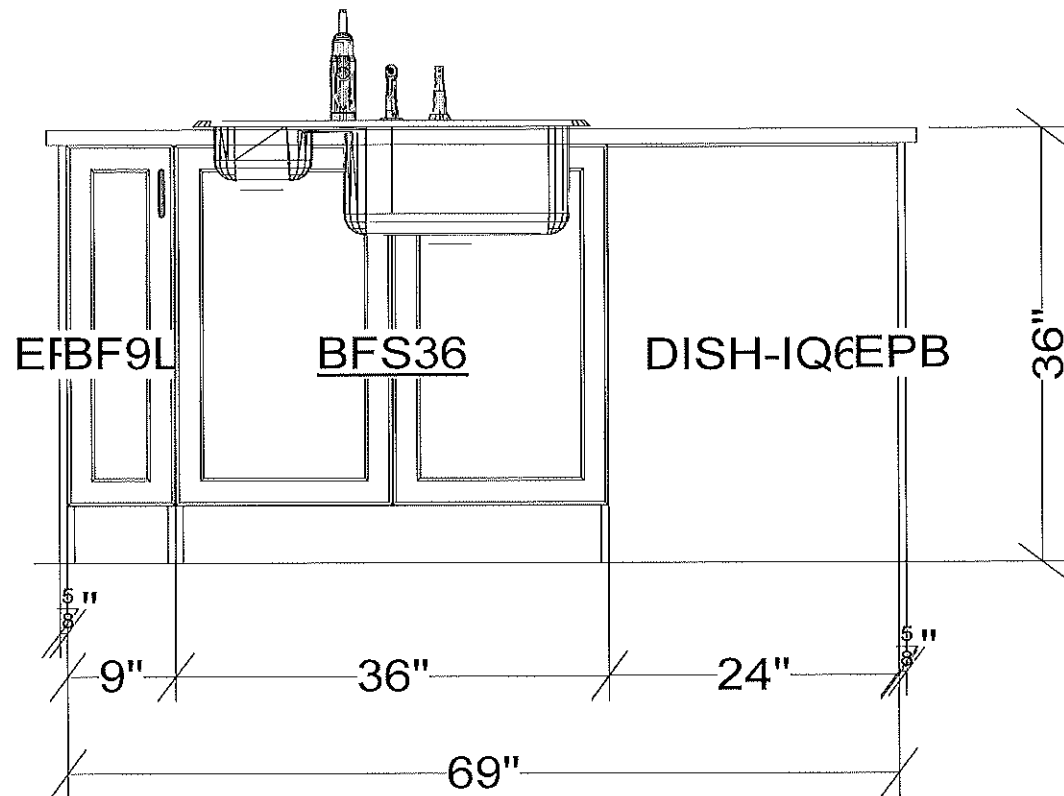


All dimensions .size designations given are subject to verification on job site and adjustment to fit job conditions.

2020

This is an original design and must not be released or copied unless applicable fee has been paid or job order placed.

Designed: 5/13/2025
Printed: 5/13/2025

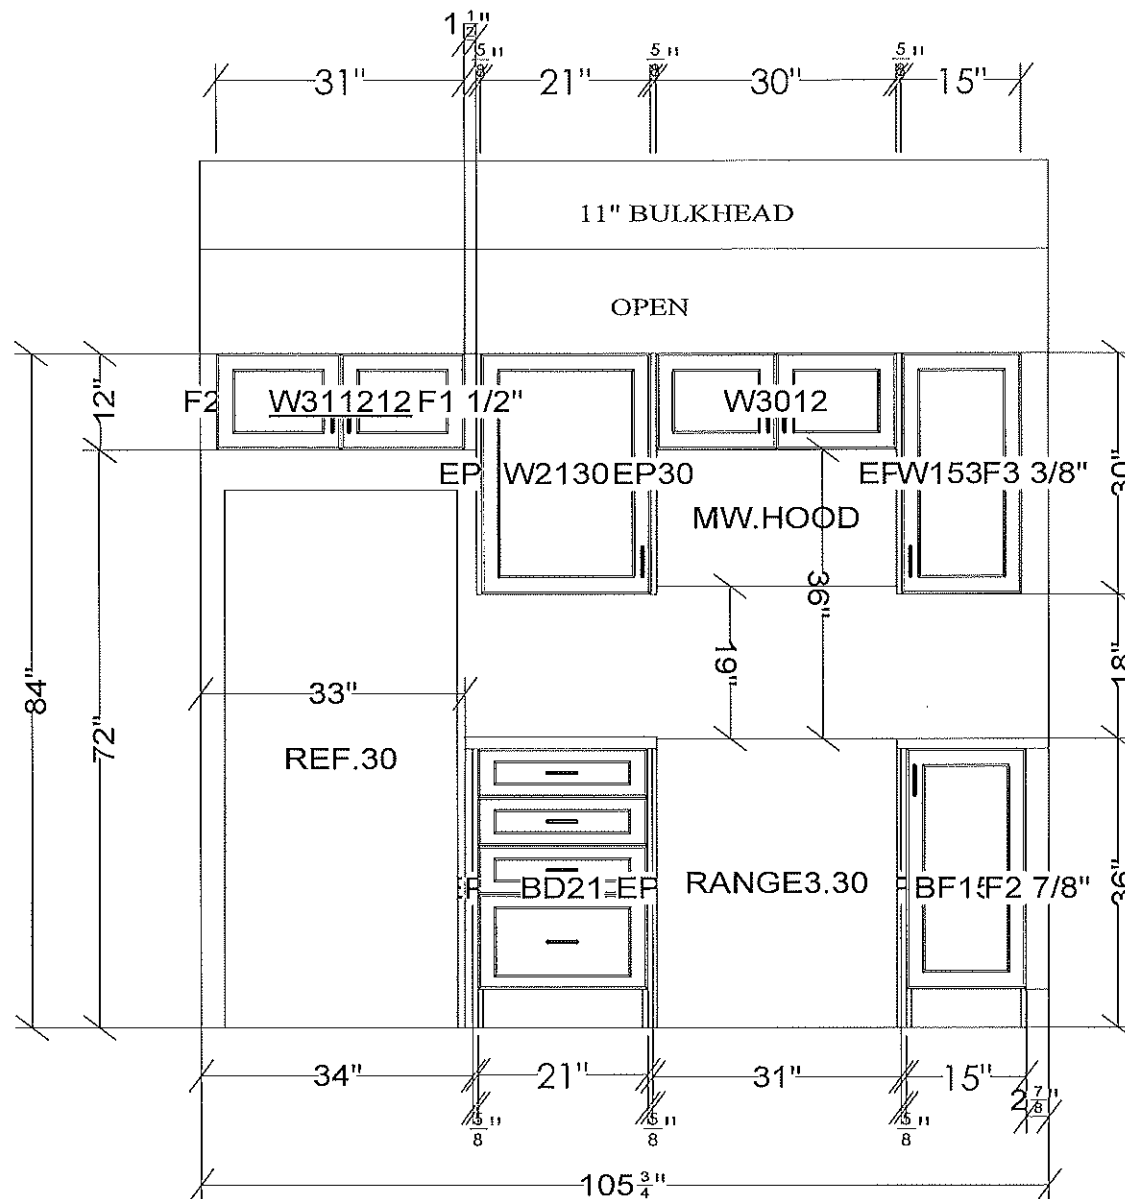

All dimensions .size designations given are subject to verification on job site and adjustment to fit job conditions.

2020

This is an original design and must not be released or copied unless applicable fee has been paid or job order placed.


Designed: 5/13/2025
Printed: 5/13/2025

RAYWAL CABINETS
JUN BLD 7 - UNIT 238 - CIVIC 2734
AS BUILT - MAY 13 2025
NUVO - POWDER ROOM - UPPER UNIT

DOOR STYLE: MANCINI
FINISH: ASHLAND
SPECIES: MELAMINE
BOX INTERIOR: WHITE MELAMINE
HINGE: STANDARD

HARDWARE: 142


COUNTERTOP: W4925K-07 WITH
4"H BACKSPLASH

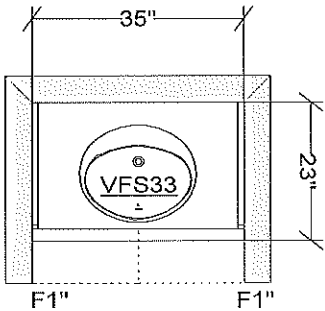

KICKB96 X 1
SCRIBE96 X 1

All dimensions .size designations given are subject to verification on job site and adjustment to fit job conditions.	2020	This is an original design and must not be released or copied unless applicable fee has been paid or job order placed.	Designed: 5/13/2025 Printed: 5/13/2025	
NUVO- UPPER UNIT (POWDER ROOM)		All	Drawing #: 1	Scale : 0 3/8" 1'

POWDER ROOM

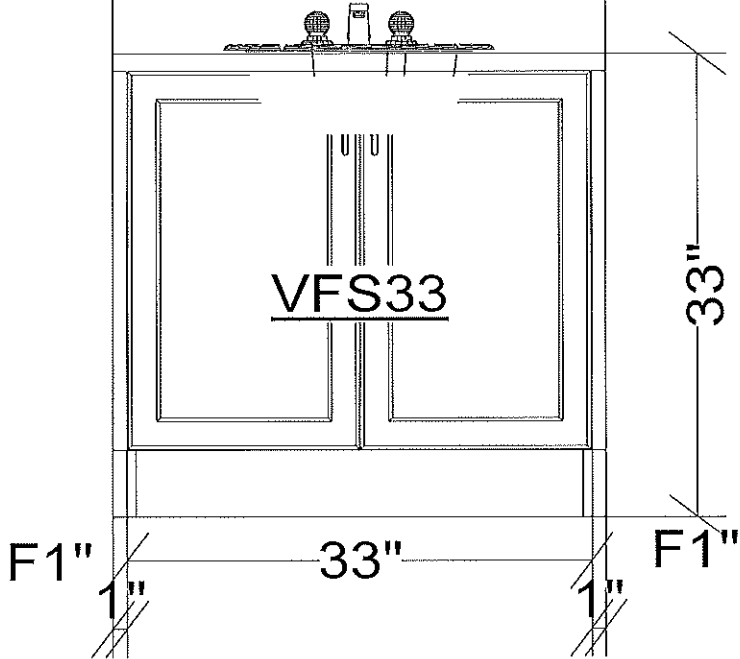

All dimensions ,size designations
given are subject to verification on
job site and adjustment to fit job
conditions.

2020

This is an original design and must
not be released or copied unless
applicable fee has been paid or job
order placed.

Designed: 5/13/2025
Printed: 5/13/2025

RAYWAL CABINETS

JUN BLD 7 - UNIT 238 - CIVIC 2734


AS BUILT - MAY 13 2025

NUVO - MAIN BATH - UPPER UNIT


DOOR STYLE: MANCINI
FINISH: ASHLAND
SPECIES: MELAMINE
BOX INTERIOR: WHITE
HINGE: STANDARD

HARDWARE:142

COUNTERTOP: W4925K-07 WITH
4"H BACKSPLASH

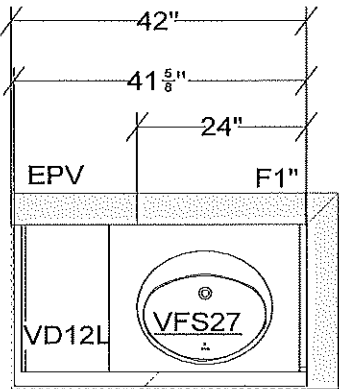

INSTALL 54" OVER TOILET

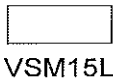


Surface Medicine
Cabinet

KICKB96 X 1
SCRIBE96 X 1

All dimensions .size designations given are subject to verification on job site and adjustment to fit job conditions.	2020	This is an original design and must not be released or copied unless applicable fee has been paid or job order placed.	Designed: 5/13/2025 Printed: 5/13/2025	
NUVO- UPPER UNIT (MAIN BATH)		All	Drawing #: 1	Scale : 0 7/16" 1'

MAIN BATH

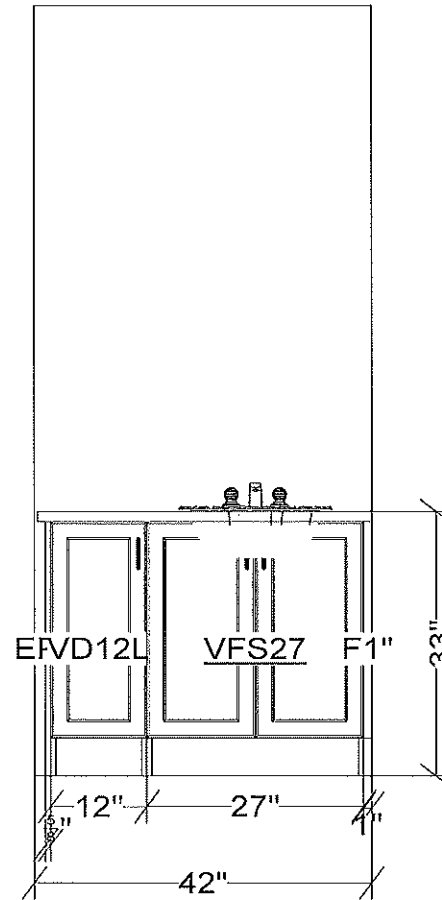

All dimensions size designations given are subject to verification on job site and adjustment to fit job conditions.

2020

This is an original design and must not be released or copied unless applicable fee has been paid or job order placed.

Designed: 5/13/2025
Printed: 5/13/2025

NUVO- UPPER UNIT (MAIN BATH)

EI 1

Drawing #: 1

Scale : 0 1/2" 1'

RAYWAL CABINETS

JUN BLD 7 - UNIT 238 - CIVIC 2734


AS BUILT - MAY 13 2025

NUVO - ENSUITE - UPPER UNIT

DOOR STYLE: MANCINI
FINISH: ASHLAND
SPECIES: MELAMINE
BOX INTERIOR: WHITE MELAMINE
HINGE: STANDARD

HARDWARE: 142

COUNTERTOP: W4925K-07
WITH 4" BACKSPLASH

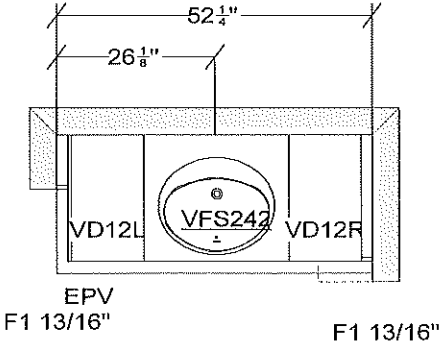

INSTALL 54" OVER TOILET




Surface Medicine
Cabinet

KICKB96 X 1
SCRIBE96 X 1

All dimensions .size designations given are subject to verification on job site and adjustment to fit job conditions.	2020	This is an original design and must not be released or copied unless applicable fee has been paid or job order placed.	Designed: 5/13/2025 Printed: 5/13/2025	
NUVO- UPPER UNIT (ENSUITE)		All	Drawing #: 1	Scale : 0 3/8" 1'

ENSUTIE

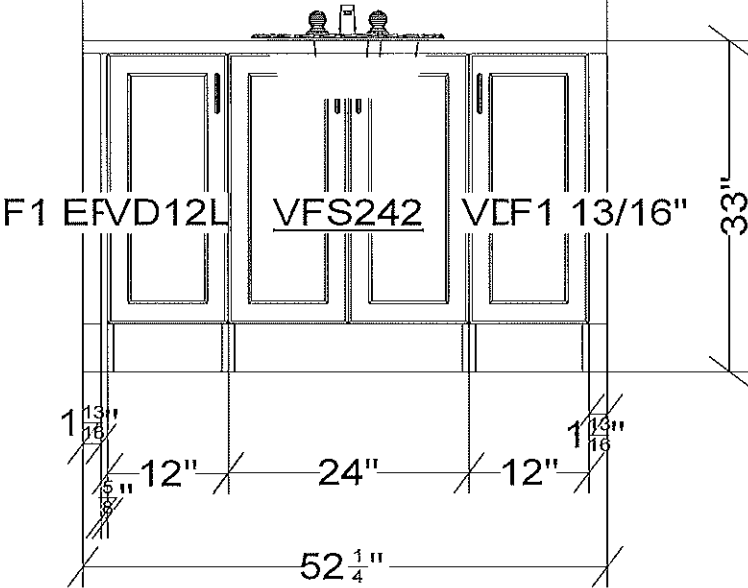

All dimensions size designations given are subject to verification on job site and adjustment to fit job conditions.	2020	This is an original design and must not be released or copied unless applicable fee has been paid or job order placed.	Designed: 5/13/2025 Printed: 5/13/2025	
			NUVO- UPPER UNIT (ENSUITE)	El 1 Drawing #: 1 Scale : 0 5/8" 1'