

RAYWAL CABINETS

JUN BLD 7 - UNIT 240 - CIVIC 203

AS BUILT - MAY 13 2025

NUVO - KITCHEN - UPPER UNIT

KITCHEN UPPERS

DOOR STYLE: RETRO
FINISH: COTTON
SPECIES: THERMOFOIL
BOX INTERIOR: WHITE MELAMINE
HINGE: STANDARD

KITCHEN LOWERS AND ISLAND


DOOR STYLE: RETRO
FINISH: IRON
SPECIES: THERMOFOIL
BOX INTERIOR: WHITE MELAMINE
DRAWER BOX: METABOX
HINGE: STANDARD

HARDWARE:116

COUNTERTOP: F6698-46
WITH 4"H BACKSPLASH

DWKIT X 1
VENT BOX X 1 (12"W x 9"D x 10 3/4")
VENT BOX X 1 (30"W x 12"D x 14"H)

KICKB96 X 2
SCRIBE96 X 3

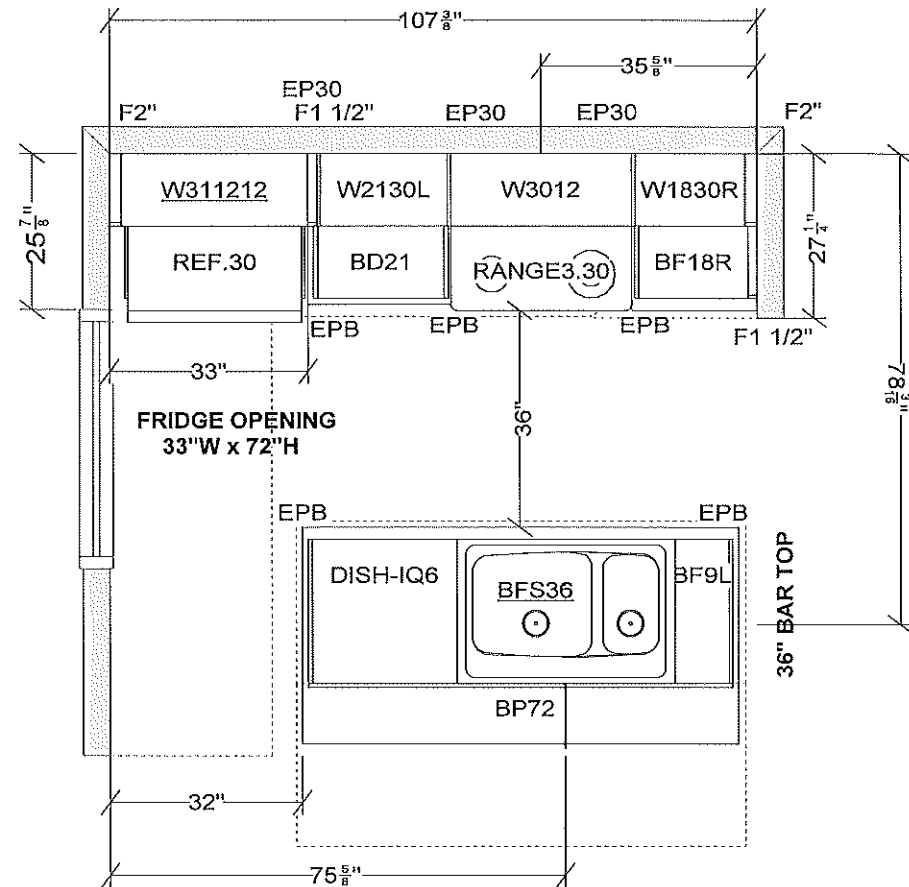

All dimensions size designations given are subject to verification on job site and adjustment to fit job conditions.

2020

This is an original design and must not be released or copied unless applicable fee has been paid or job order placed.


Designed: 5/13/2025
Printed: 5/13/2025

NUVO - UPPER UNIT (KITCHEN)

All


Drawing #: 1

Scale : 0 3/8" 1'

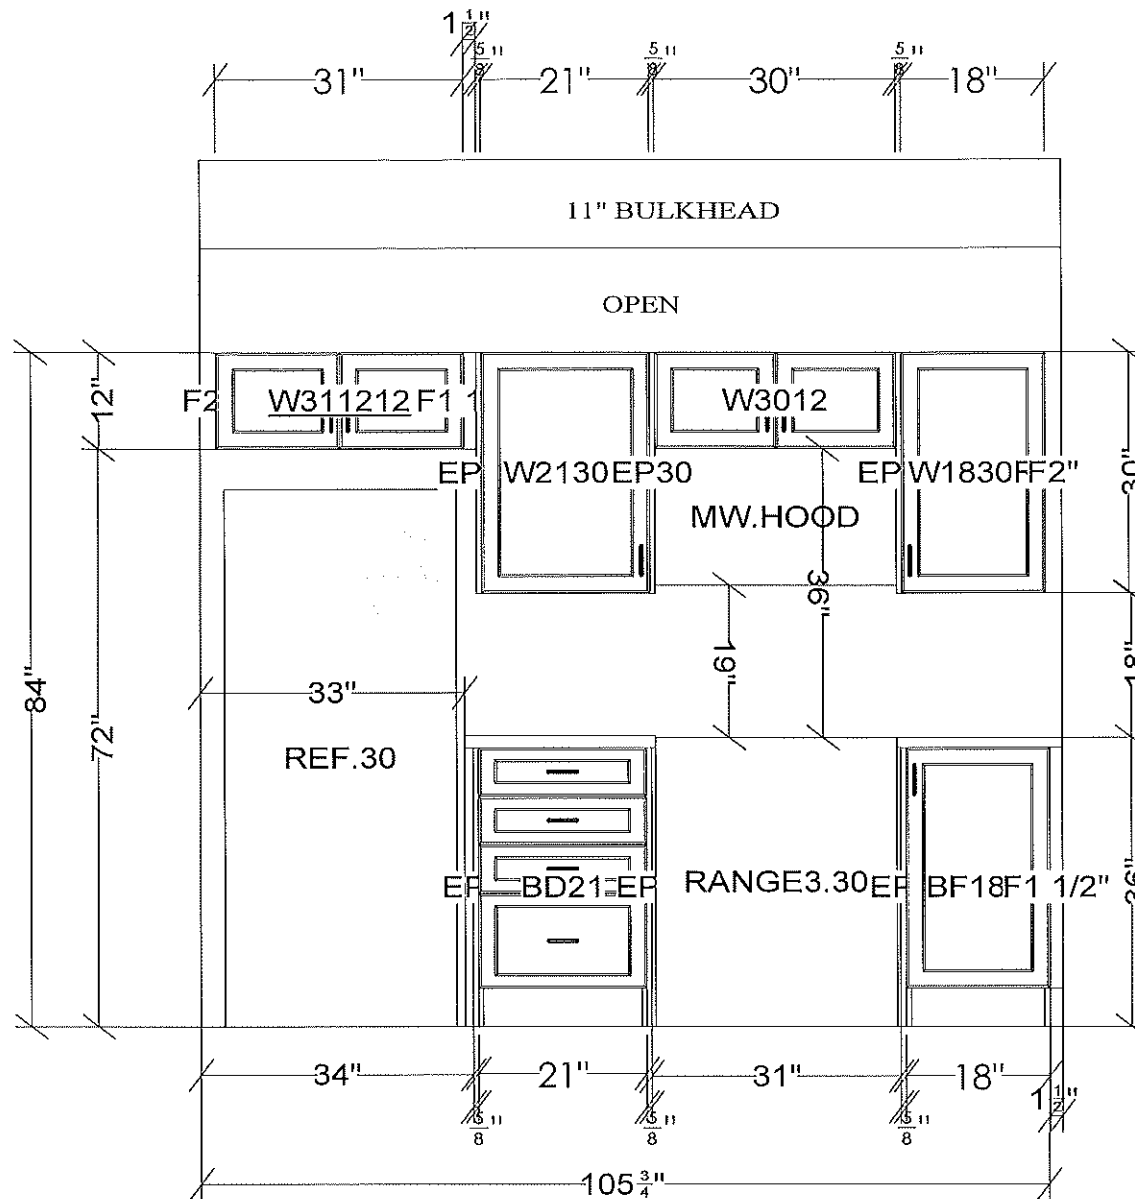

NO CROWN/BUILD UP - NO LIGHT VALANCE

All dimensions size designations given are subject to verification on job site and adjustment to fit job conditions.	2020	This is an original design and must not be released or copied unless applicable fee has been paid or job order placed.	Designed: 5/13/2025 Printed: 5/13/2025	
NUVO - UPPER UNIT (KITCHEN)			E1 1 Drawing #: 1 Scale : 0 1/2" 1'	

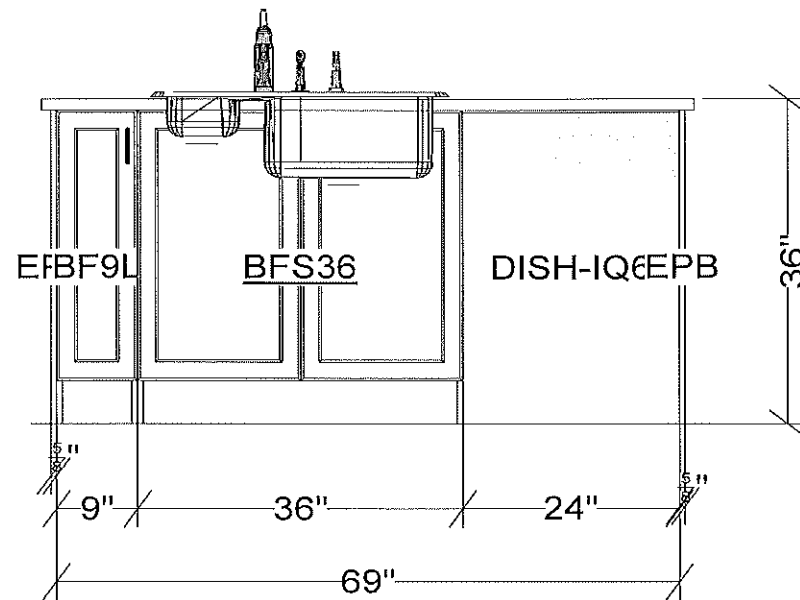


All dimensions and size designations given are subject to verification on job site and adjustment to fit job conditions.	2020	This is an original design and must not be released or copied unless applicable fee has been paid or job order placed.	Designed: 5/13/2025 Printed: 5/13/2025
NUVO - UPPER UNIT (KITCHEN)	El 2	Drawing #: 1	Scale : 0 9/16" 1'

RAYWAL CABINETS
 JUN BLD 7 - UNIT 240 - CIVIC 203
 AS BUILT - MAY 13 2025
 NUVO - POWDER ROOM - UPPER UNIT

DOOR STYLE: RETRO
 FINISH: CONCRETE
 SPECIES: THERMOFOIL
 BOX INTERIOR: WHITE MELAMINE
 HINGE: STANDARD

 HARDWARE: 142


 COUNTERTOP: W4925K-07 WITH
 4"H BACKSPLASH

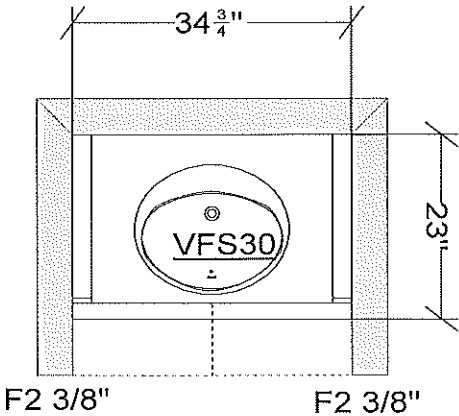

KICKB96 X 1
 SCRIBE96 X 1

All dimensions ,size designations given are subject to verification on job site and adjustment to fit job conditions.	2020	This is an original design and must not be released or copied unless applicable fee has been paid or job order placed.	Designed: 5/13/2025 Printed: 5/13/2025	
NUVO- UPPER UNIT (POWDER ROOM)		All	Drawing #: 1	Scale : 0 1/2" 1'

POWDER ROOM

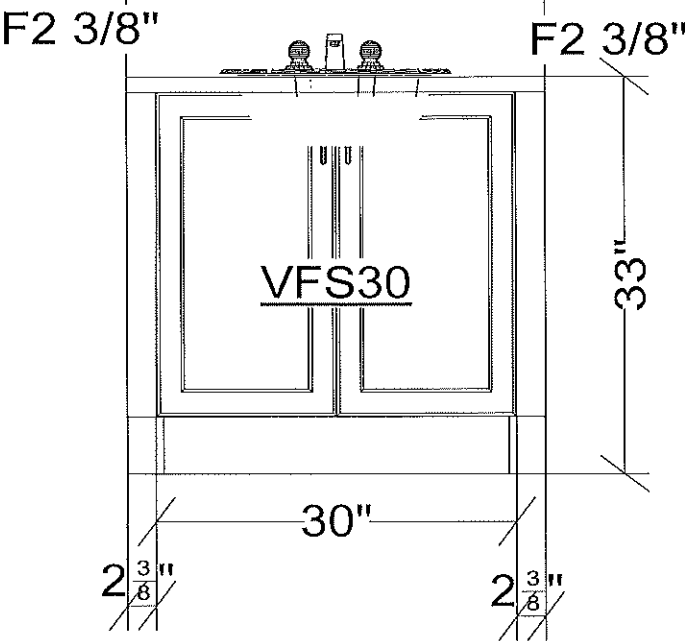

All dimensions _size designations given are subject to verification on job site and adjustment to fit job conditions.	2020	This is an original design and must not be released or copied unless applicable fee has been paid or job order placed.	Designed: 5/13/2025 Printed: 5/13/2025
NUVO- UPPER UNIT (POWDER ROOM)	El 4	Drawing #: 1	Scale : 0 3/4" 1'

RAYWAL CABINETS

JUN BLD 7 - UNIT 240 - CIVIC 203


AS BUILT - MAY 13 2025

NUVO - MAIN BATH - UPPER UNIT

DOOR STYLE: RETRO
FINISH: CONCRETE
SPECIES: THERMOFOIL
BOX INTERIOR: WHITE
HINGE: STANDARD

HARDWARE:142

COUNTERTOP: W4925K-07 WITH
4"H BACKSPLASH

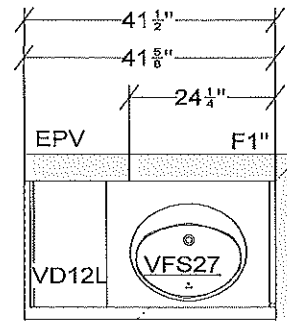

INSTALL 54" OVER TOILET




Surface Medicine
Cabinet

KICKB96 X 1
SCRIBE96 X 1

All dimensions size designations given are subject to verification on job site and adjustment to fit job conditions.	2020	This is an original design and must not be released or copied unless applicable fee has been paid or job order placed.	Designed: 5/13/2025 Printed: 5/13/2025
NUVO- UPPER UNIT (MAIN BATH)	All	Drawing #: 1	Scale : 0 3/8" 1'

MAIN BATH

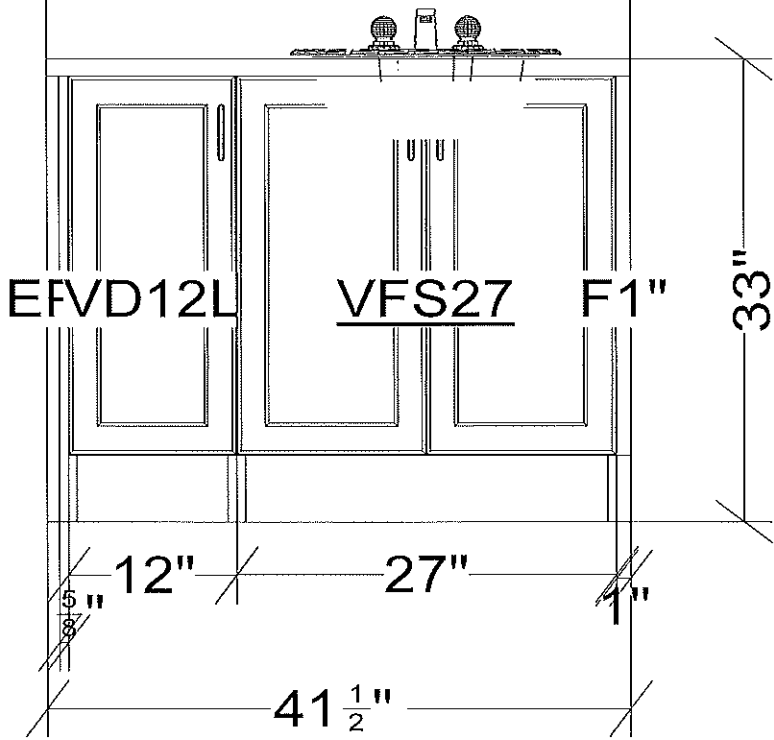

All dimensions _size designations
given are subject to verification on
job site and adjustment to fit job
conditions.

2020

This is an original design and must
not be released or copied unless
applicable fee has been paid or job
order placed.

Designed: 5/13/2025
Printed: 5/13/2025

RAYWAL CABINETS

JUN BLD 7 - UNIT 240 - CIVIC 203


AS BUILT - MAY 13 2025

NUVO - ENSUITE - UPPER UNIT

DOOR STYLE: RETRO
FINISH: CONCRETE
SPECIES: THERMOFOIL
BOX INTERIOR: WHITE MELAMINE
HINGE: STANDARD

HARDWARE: 142

COUNTERTOP: W4925K-07
WITH 4" BACKSPLASH

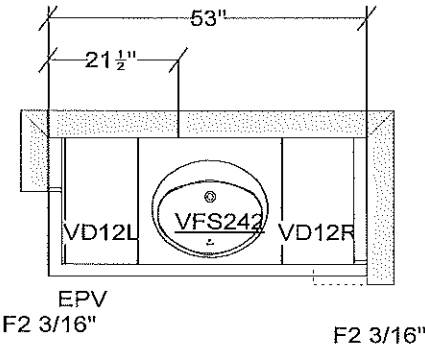

INSTALL 54" OVER TOILET



Surface Medicine
Cabinet

KICKB96 X 1
SCRIBE96 X 1

All dimensions size designations
given are subject to verification on
job site and adjustment to fit job
conditions.

2020

This is an original design and must
not be released or copied unless
applicable fee has been paid or job
order placed.

Designed: 5/13/2025
Printed: 5/13/2025


NUVO- UPPER UNIT (ENSUITE)

All

Drawing #: 1

Scale : 0 3/8" 1'

ENSUTIE

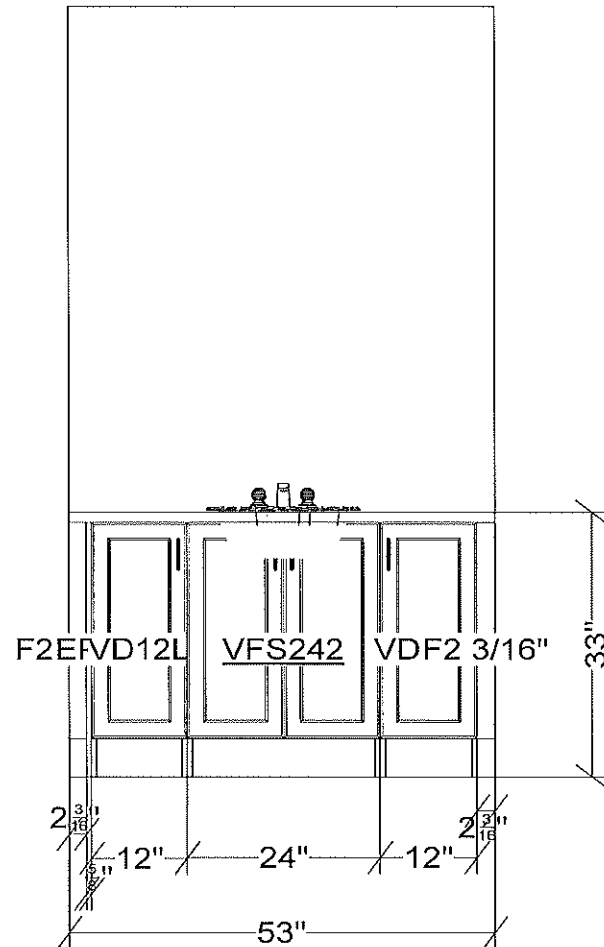

All dimensions _size designations given are subject to verification on job site and adjustment to fit job conditions.

2020

This is an original design and must not be released or copied unless applicable fee has been paid or job order placed.

Designed: 5/13/2025
Printed: 5/13/2025