

RAYWAL CABINETS

JUN BLD7 - UNIT 137 - CIVIC 2730

AS BUILT - MAY 13 2025

NUVO - KITCHEN - LOWER UNIT

KITCHEN UPPERS


DOOR STYLE: RETRO
FINISH: COTTON
SPECIES: THERMOFOIL
BOX INTERIOR: WHITE MELAMINE
DRAWER FRONT: FLAT
DRAWER BOX: METABOX
HINGE: STANDARD

KITCHEN LOWERS + ISLAND

DOOR STYLE: RETRO
FINISH: DENIM
SPECIES: THERMOFOIL
BOX INTERIOR: WHITE MELAMINE
DRAWER FRONT: FLAT
DRAWER BOX: METABOX
HINGE: STANDARD

HARDWARE:116

COUNTERTOP: F6314-58

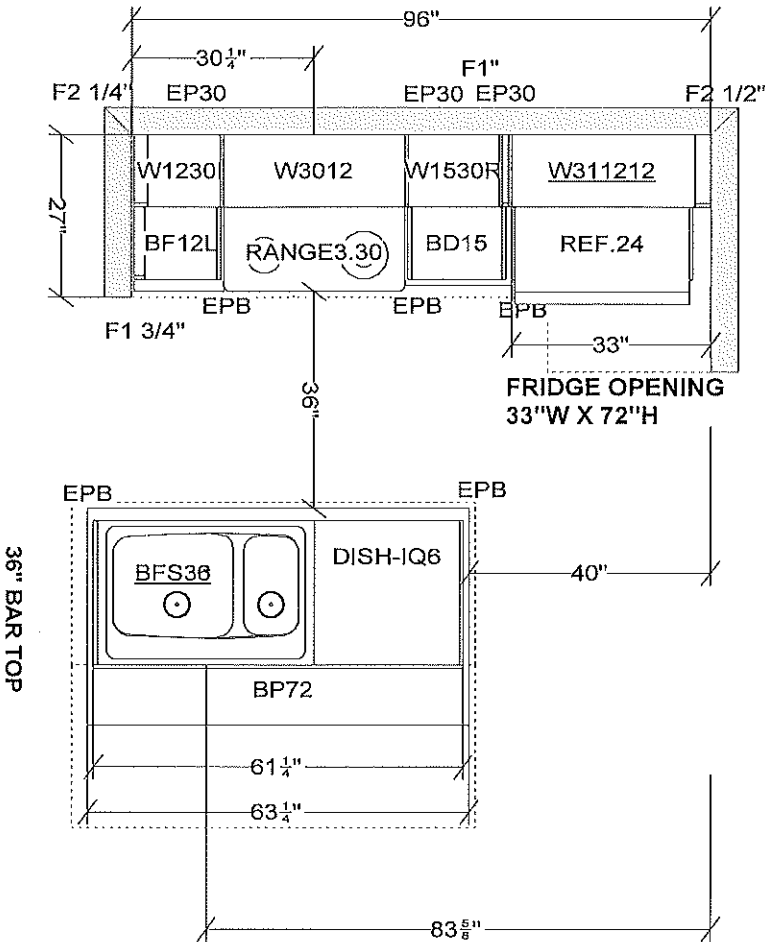

DWKIT X 1
VENT BOX X 1 (12"W x 9"D x 10 3/4")


KICKB96 X 2
SCRIBE96 X 3

All dimensions size designations given are subject to verification on job site and adjustment to fit job conditions.

2020

This is an original design and must not be released or copied unless applicable fee has been paid or job order placed.

Designed: 5/14/2025
Printed: 5/14/2025

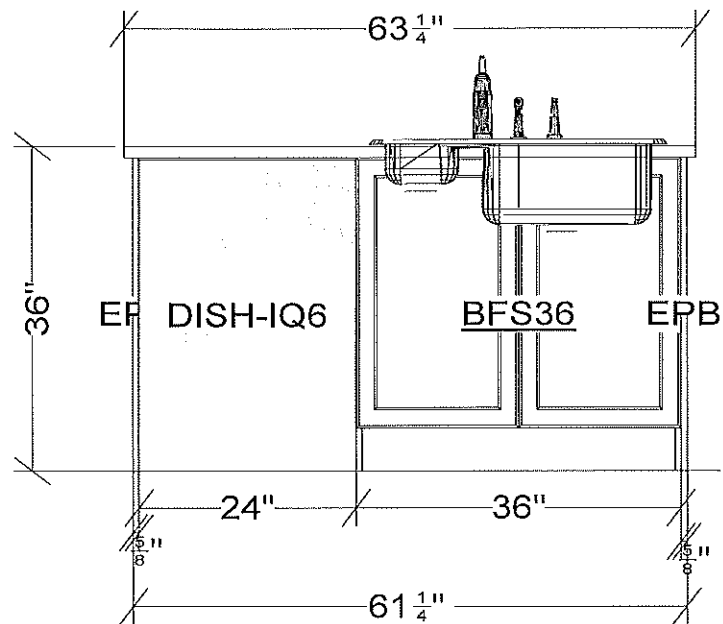


All dimensions _size designations given are subject to verification on job site and adjustment to fit job conditions.

2020

This is an original design and must not be released or copied unless applicable fee has been paid or job order placed.

Designed: 5/14/2025
Printed: 5/14/2025

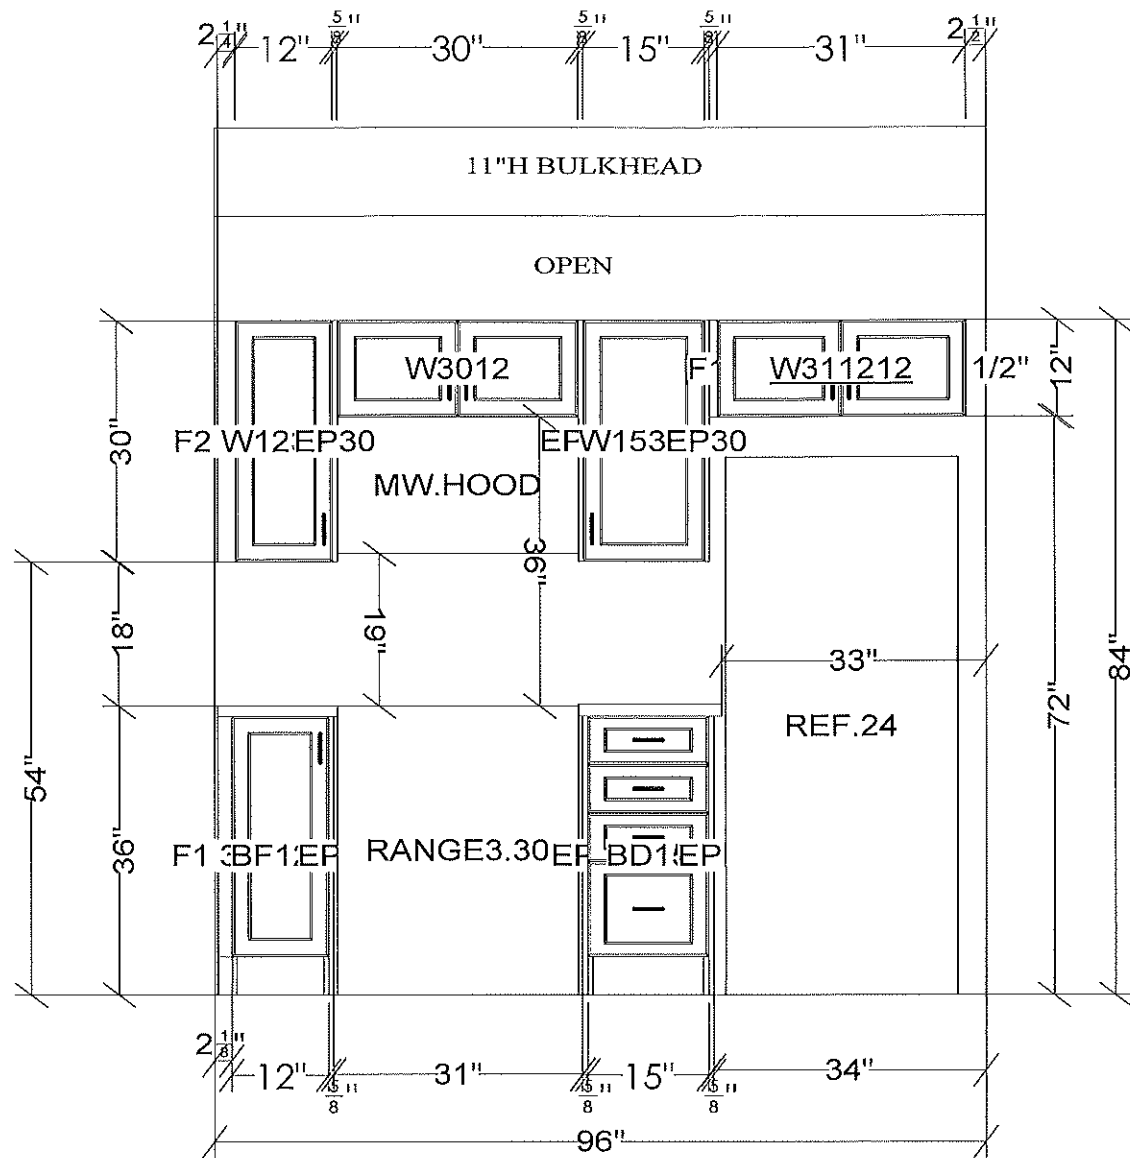

NO LIGHT VALANCE / NO CROWN/BUILD-UP

All dimensions _size designations given are subject to verification on job site and adjustment to fit job conditions.

2020

This is an original design and must not be released or copied unless applicable fee has been paid or job order placed.


Designed: 5/14/2025
Printed: 5/14/2025

RAYWAL CABINETS
JUN BLD 7 - UNIT 137 - CIVIC 2730
AS BUILT - MAY 13 2025
NUVO - POWDER ROOM - LOWER UNIT

DOOR STYLE: MANCINI
FINISH: ASHLAND
SPECIES: MELAMINE
BOX INTERIOR: WHITE MELAMINE
HINGE: STANDARD

HARDWARE:142


COUNTERTOP: W4925K-07
WITH 4" BACKSPLASH

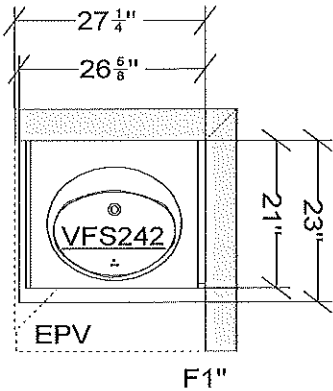

KICKB96 X 1
SCRIBE96 X 1

All dimensions _size designations given are subject to verification on job site and adjustment to fit job conditions.	2020	This is an original design and must not be released or copied unless applicable fee has been paid or job order placed.	Designed: 5/13/2025 Printed: 5/13/2025	
NUVO - LOWER UNIT (POWDER ROOM)		All	Drawing #: 1	Scale : 0 7/16" 1'

POWDER ROOM

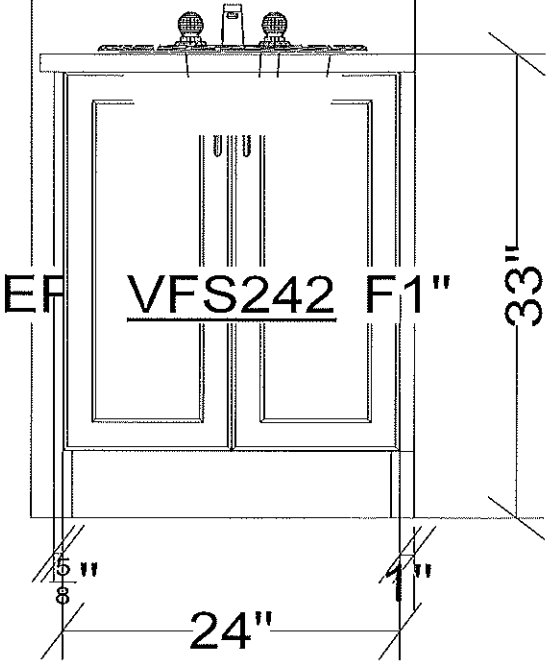

All dimensions _size designations given are subject to verification on job site and adjustment to fit job conditions.	2020	This is an original design and must not be released or copied unless applicable fee has been paid or job order placed.	Designed: 5/13/2025 Printed: 5/13/2025	
NUVO - LOWER UNIT (POWDER ROOM)		EI 1	Drawing #: 1	Scale : 0 7/8" 1'

RAYWAL CABINETS

JUN BLD 7 - UNIT 137- CIVIC 2730


AS BUILT - MAY 13 2025

NUVO - MAIN - LOWER UNIT

DOOR STYLE: MANCINI
FINISH: ASHLAND
SPECIES: MELAMINE
BOX INTERIOR: WHITE MELAMINE
HINGE: STANDARD

HARDWARE:142

COUNTERTOP: W4925K-07

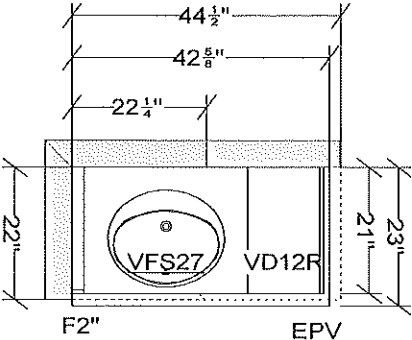


INSTALL 54" OVER TOILET



KICKB96 X 1
SCRIBE96 X 1

All dimensions & size designations given are subject to verification on job site and adjustment to fit job conditions.	2020	This is an original design and must not be released or copied unless applicable fee has been paid or job order placed.	Designed: 5/13/2025 Printed: 5/14/2025	
NUVO- LOWER UNIT (MAIN)		All	Drawing #: 1	Scale : 0 3/8" 1'

MAIN

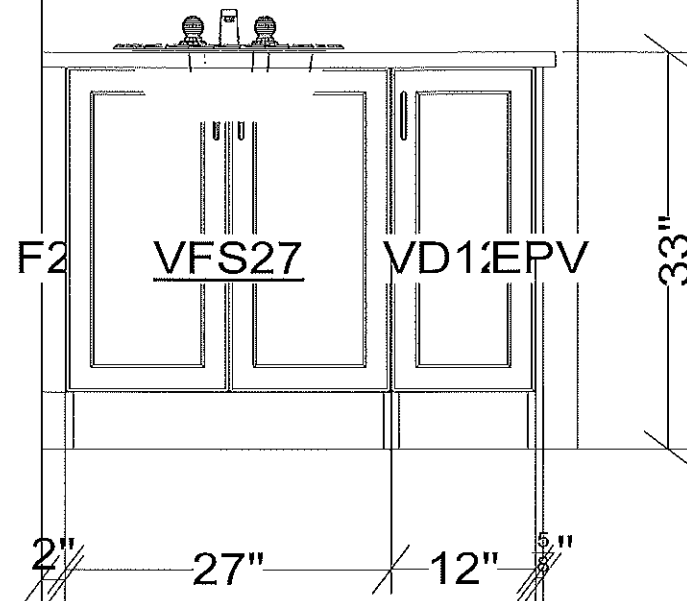

All dimensions and size designations given are subject to verification on job site and adjustment to fit job conditions.

2020

This is an original design and must not be released or copied unless applicable fee has been paid or job order placed.

Designed: 5/13/2025
Printed: 5/13/2025

RAYWAL CABINETS

JUN BLD 7 - UNIT 137 - CIVIC 62730

AS BUILT - MAY 13 2025

NUVO - ENSUITE - LOWER UNIT

DOOR STYLE: MANCINI
FINISH:ASHLAND
SPECIES: MELAMINE
BOX INTERIOR: WHITE MELAMINE
HINGE: STANDARD


HARDWARE:142

COUNTERTOP: W4925K-07

INSTALL 54" OVER TOILET




VSM15L

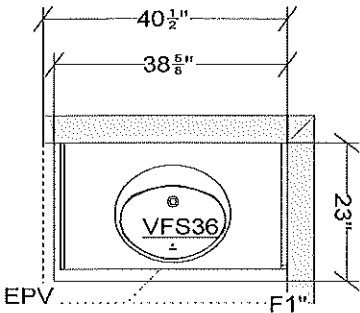

KICKB96 X 1
SCRIBE96 X 1

All dimensions ,size designations given are subject to verification on job site and adjustment to fit job conditions.	2020	This is an original design and must not be released or copied unless applicable fee has been paid or job order placed.	Designed: 5/14/2025 Printed: 5/14/2025	
NUVO- LOWER UNIT (ENSUITE)		All	Drawing #: 1	Scale : 0 3/8" 1'

ENSUITE

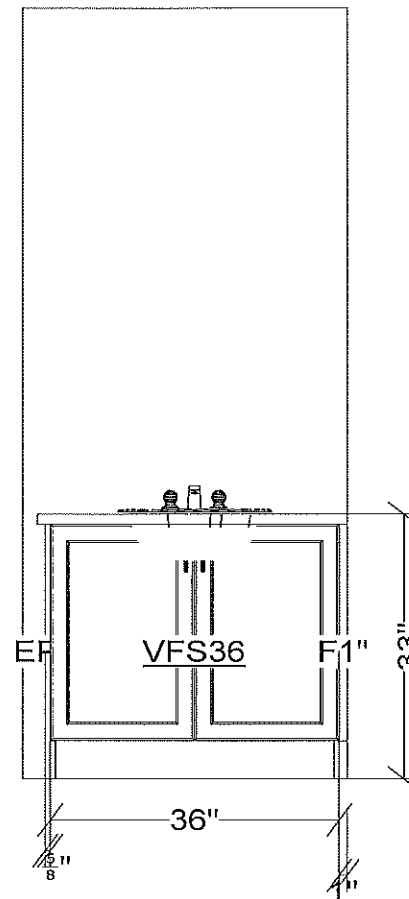

All dimensions and size designations given are subject to verification on job site and adjustment to fit job conditions.

2020

This is an original design and must not be released or copied unless applicable fee has been paid or job order placed.

Designed: 5/14/2025
Printed: 5/14/2025

NUVO- LOWER UNIT (ENSUITE)

El 1

Drawing #: 1

Scale : 0 1/2" 1'