


RAYWAL CABINETS
JUN BLD7 - UNIT 138 - CIVIC 2736
AS BUILT - MAY 13 2025
NUVO - KITCHEN - LOWER UNIT

KITCHEN UPPERS
DOOR STYLE: RETRO
FINISH: COTTON
SPECIES: THERMOFOIL
BOX INTERIOR: WHITE MELAMINE
DRAWER FRONT: FLAT
DRAWER BOX: METABOX
HINGE: STANDARD

KITCHEN LOWERS + ISLAND
DOOR STYLE: RETRO
FINISH: DENIM
SPECIES: THERMOFOIL
BOX INTERIOR: WHITE MELAMINE
DRAWER FRONT: FLAT
DRAWER BOX: METABOX
HINGE: STANDARD


HARDWARE:116
COUNTERTOP: F6314-58

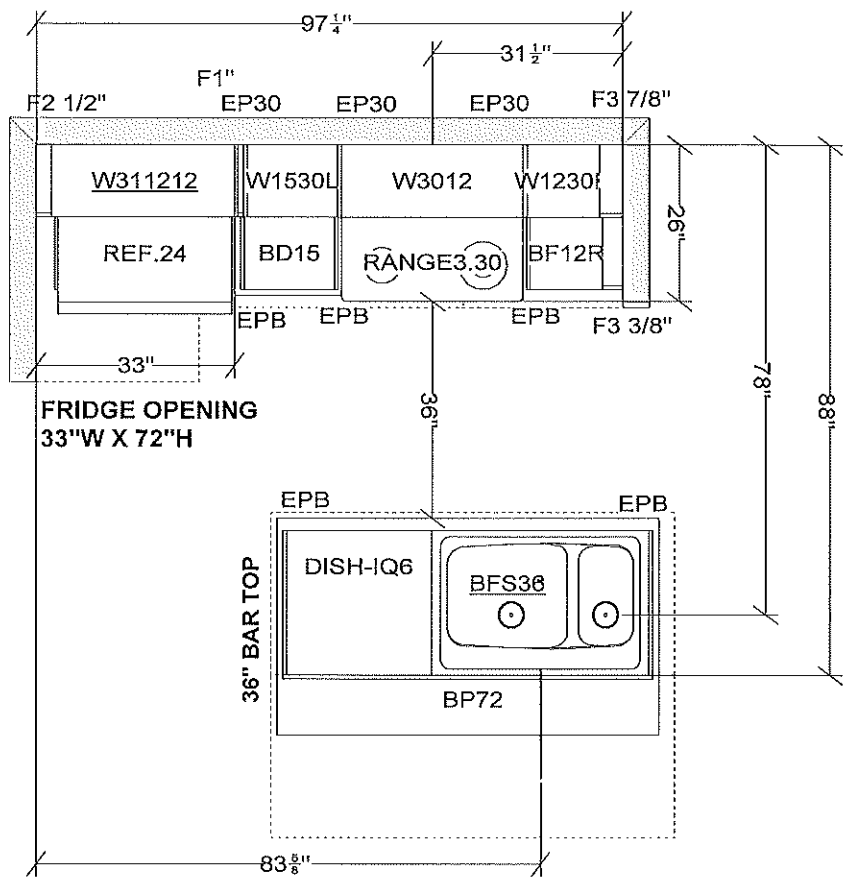

DWKIT X 1
VENT BOX X 1 (12"W x 9"D x 10 3/4")


KICKB96 X 2
SCRIBE96 X 3

All dimensions size designations given are subject to verification on job site and adjustment to fit job conditions.	2020	This is an original design and must not be released or copied unless applicable fee has been paid or job order placed.	Designed: 5/14/2025 Printed: 5/15/2025
NUVO - LOWER UNIT (KITCHEN)	All	Drawing #: 1	Scale: 0 3/8" = 1'

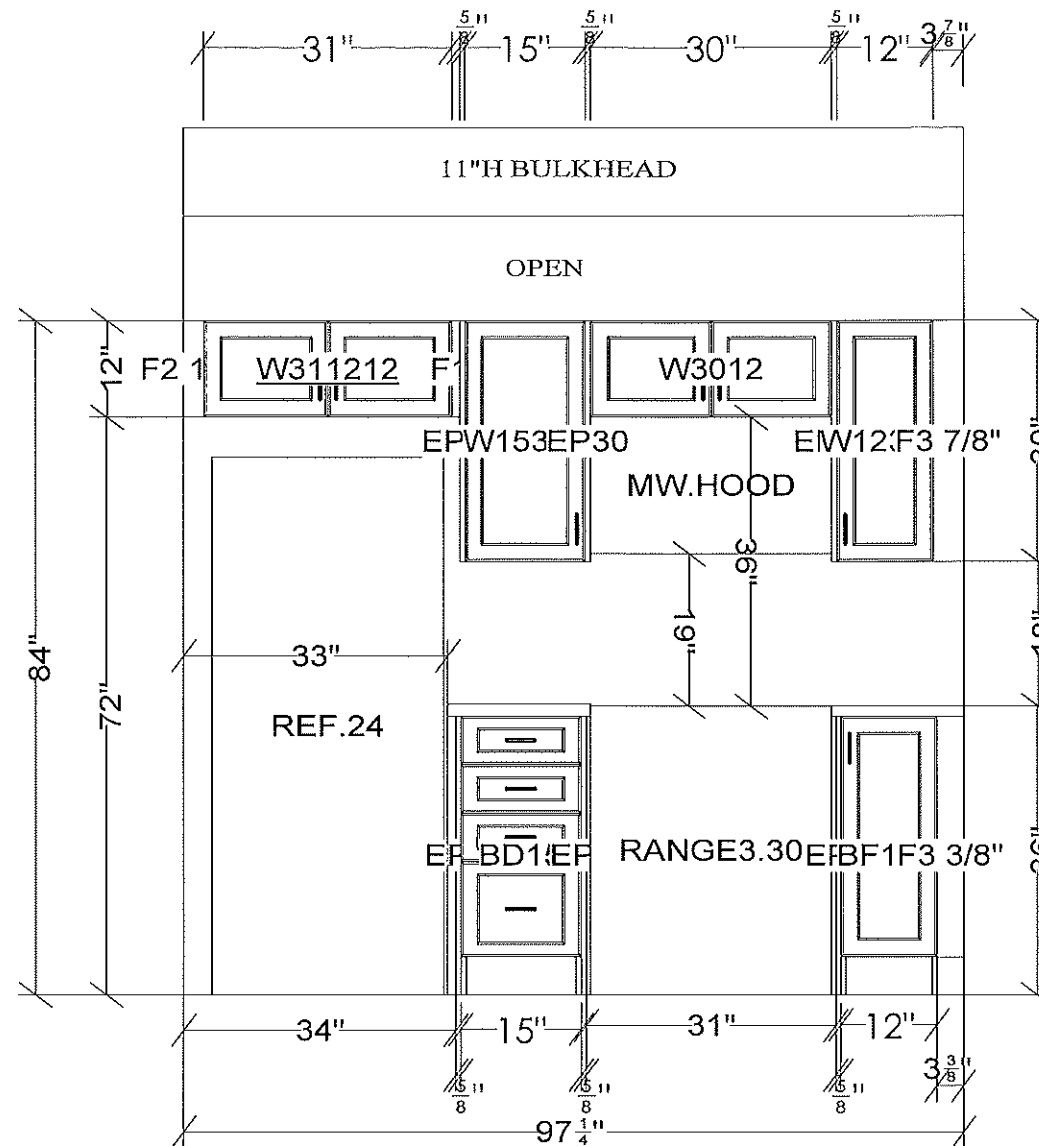

NO LIGHT VALANCE / NO CROWN/BUILD-UP

All dimensions size designations given are subject to verification on job site and adjustment to fit job conditions.	2020	This is an original design and must not be released or copied unless applicable fee has been paid or job order placed.	Designed: 5/14/2025 Printed: 5/15/2025
NIIVO- LOWER UNIT (KITCHEN)			Drawing #: 1 Scale : 0 1/2" = 1'

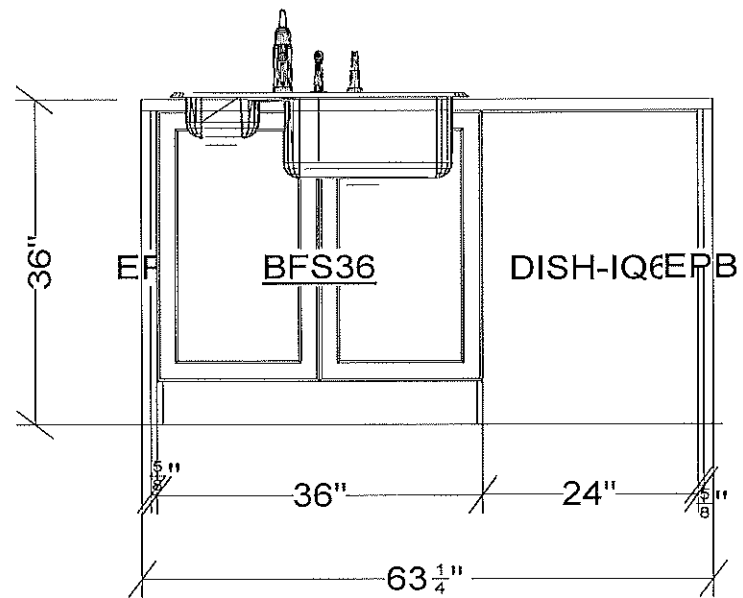

All dimensions & size designations given are subject to verification on job site and adjustment to fit job conditions.	2020	This is an original design and must not be released or copied unless applicable fee has been paid or job order placed.	Designed: 5/14/2025 Printed: 5/15/2025
NIVIO LOWER UNIT (KITCHEN)	FL2	Drawing #: 1	Scale: 0.9/16" = 1"

RAYWAL CABINETS

JUN BLD 7 - UNIT 138- CIVIC 2736


AS BUILT - MAY 13 2025

NUVO - MAIN - LOWER UNIT

DOOR STYLE: MANCINI
FINISH: ASHLAND
SPECIES: MELAMINE
BOX INTERIOR: WHITE MELAMINE
HINGE: STANDARD

HARDWARE:142

COUNTERTOP: W4925K-07
WITH 4" BACKSPLASH

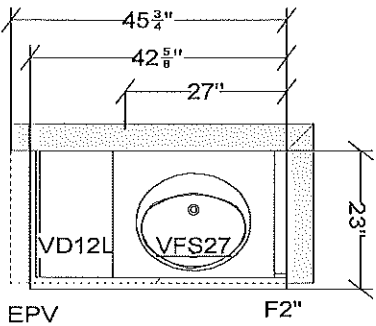


INSTALL 54" OVER TOILET



KICKB96 X 1
SCRIBE96 X 1

All dimensions _size designations given are subject to verification on job site and adjustment to fit job conditions.	2020	This is an original design and must not be released or copied unless applicable fee has been paid or job order placed.	Designed: 5/14/2025 Printed: 5/14/2025	
			NUVO- LOWER UNIT (MAIN)	All Drawing #: 1 Scale : 0 3/8" 1'

MAIN

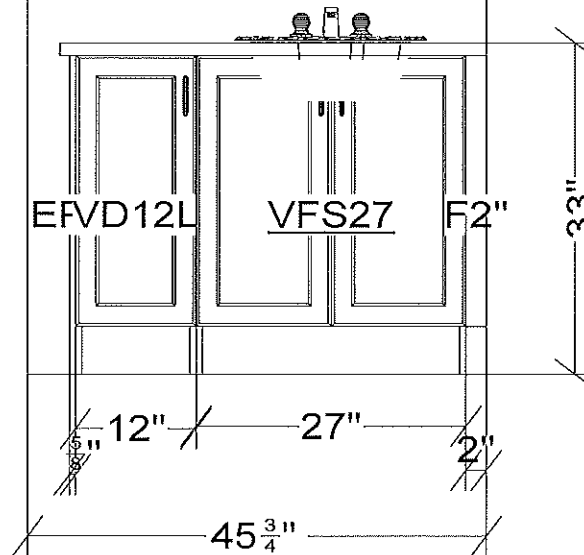

All dimensions size designations given are subject to verification on job site and adjustment to fit job conditions.

2020

This is an original design and must not be released or copied unless applicable fee has been paid or job order placed.


Designed: 5/14/2025
Printed: 5/14/2025


RAYWAL CABINETS
 JUN BLD 7 - UNIT 138 - CIVIC 2736
 AS BUILT - MAY 13 2025
 NUVO - ENSUITE - LOWER UNIT

DOOR STYLE: MANCINI
 FINISH: ASHLAND
 SPECIES: MELAMINE
 BOX INTERIOR: WHITE MELAMINE
 HINGE: STANDARD

 HARDWARE:142

 COUNTERTOP: W4925K-07
 WITH 4" BACKSPLASH

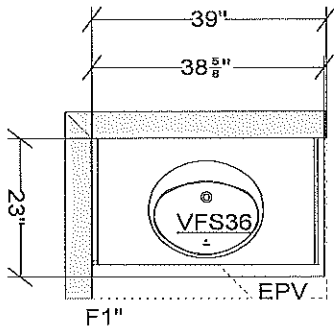


INSTALL 54" OVER TOILET

 VSM15R

KICKB96 X 1
 SCRIBE96 X 1

All dimensions _size designations given are subject to verification on job site and adjustment to fit job conditions.	2020	This is an original design and must not be released or copied unless applicable fee has been paid or job order placed.	Designed: 5/14/2025 Printed: 5/14/2025	

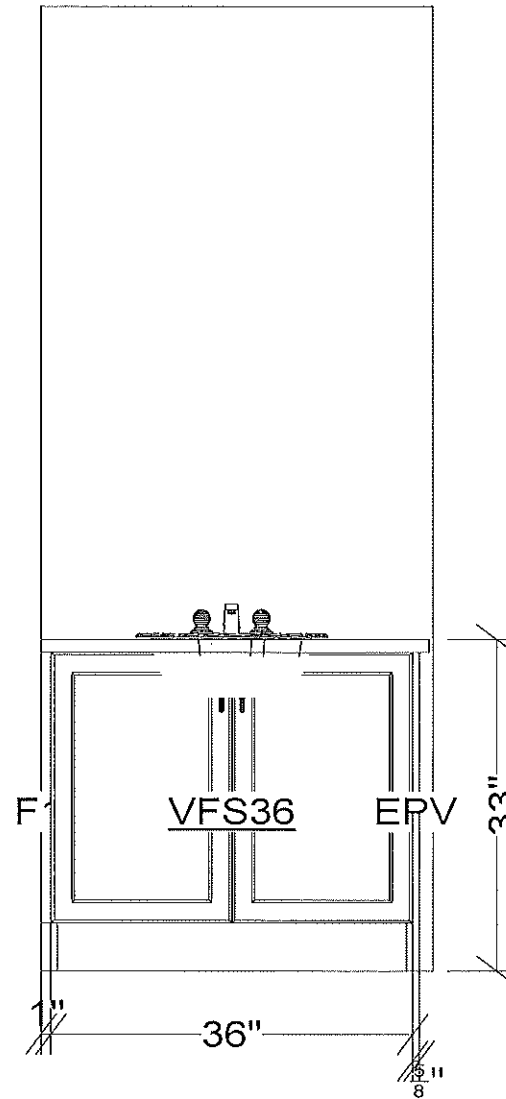ENSUITE



All dimensions _size designations given are subject to verification on job site and adjustment to fit job conditions.

2020

This is an original design and must not be released or copied unless applicable fee has been paid or job order placed.

Designed: 5/14/2025
Printed: 5/14/2025

RAYWAL CABINETS

JUN BLD 7 - UNIT 138 - CIVIC 2736


AS BUILT - MAY 13 2025

NUVO - POWDER ROOM - LOWER UNIT

DOOR STYLE: MANCINI
FINISH: ASHLAND
SPECIES: MELAMINE
BOX INTERIOR: WHITE MELAMINE
HINGE: STANDARD

HARDWARE: 142


COUNTERTOP: W4925K-07
WITH 4" BACKSPLASH

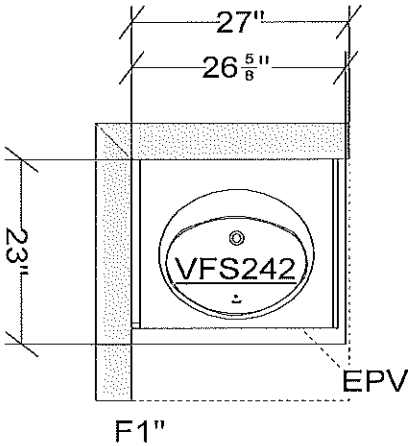

KICKB96 X 1
SCRIBE96 X 1

All dimensions _size designations given are subject to verification on job site and adjustment to fit job conditions.	2020	This is an original design and must not be released or copied unless applicable fee has been paid or job order placed.	Designed: 5/14/2025 Printed: 5/14/2025	
			Drawing #: 1	Scale : 0 1/2" 1'
NUVO - LOWER UNIT (POWDER ROOM)		All	Drawing #: 1	Scale : 0 1/2" 1'

POWDER ROOM

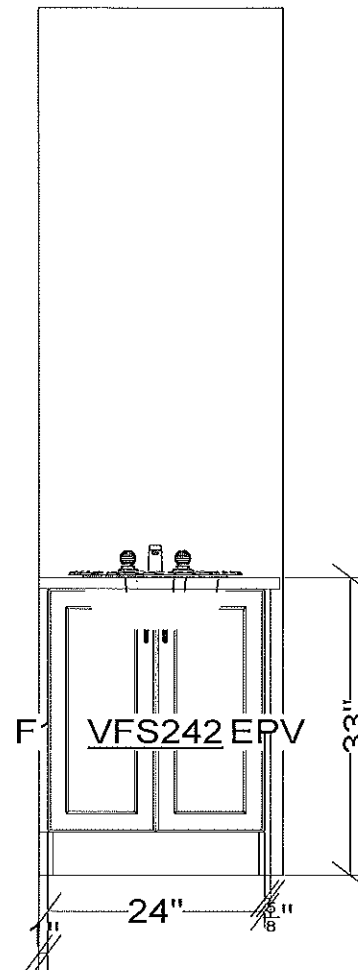

All dimensions & size designations given are subject to verification on job site and adjustment to fit job conditions.

2020

This is an original design and must not be released or copied unless applicable fee has been paid or job order placed.

Designed: 5/14/2025
Printed: 5/14/2025